

OTTAWA COUNTY ENGINEERS OFFICE

REFERENCE NO. 29-7-15-C
NE CORNER POST SEC. 29
CARROLL TWP.
SHEET 1 OF 1.

ROUTE: STATE ROUTE #19

TOWNSHIP: CARROLL

SECTION: 29

T 7 NR 15 E.


PERSONNEL:

M. WITTMAN, P.S.
J. ALLEN
E. KOCH
C. MILLER
S. HUSS - ODOT

NORTHING:

EASTING:

DATUM:

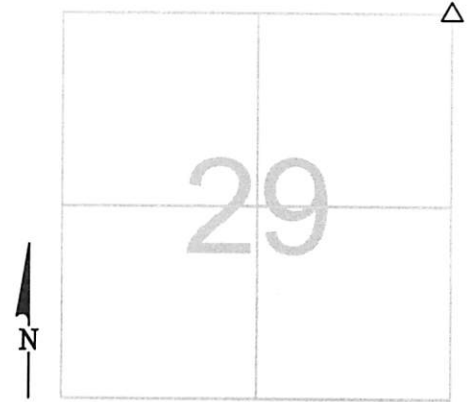


DATE / WEATHER / TEMP:

MARCH 30, 2010
SUNNY - S
66° F

MONUMENT INFORMATION

MONUMENT TYPE: FD. 6"x4" OVAL HARDHEAD
STONE
ON SURFACE - BELOW: 2.46'
LEFT - CL PAV'T - RIGHT: 3.20'

USED CENTER OF STONE

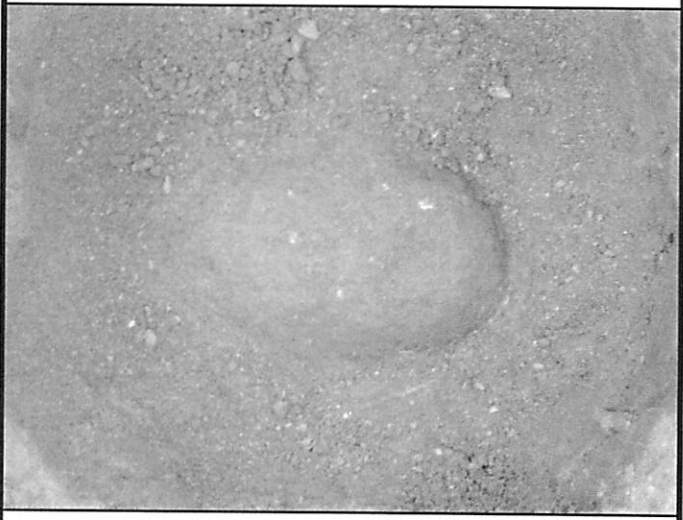

MISC. INFORMATION

FD. ODOT NAIL AND SHINER ON SURFACE WITH 3'-0"
X-TIES. DUG FOR STONE. NAIL AND SHINER WAS
0.22' SOUTH OF CENTER OF STONE.

MARCH 30, 2010

SET 1" SQUARE IRON PIN
IN ROUND ODOT MONUMENT
BOX OVER STONE

