

# OTTAWA COUNTY ENGINEERS OFFICE

**REFERENCE NO.** 29-7-15-D  
 WEST QUARTER POST SEC 29  
 CARROLL TWP.  
**SHEET** 1 OF 1.

**ROUTE:** T-92 TOUSSAINT - PORTAGE RD  
 @ T-97 BIER

**TOWNSHIP:** CARROLL

**SECTION:** 29

**T** 7 **NR** 15 **E.**


**NORTHING:**

**EASTING:**

**DATUM:**


**PERSONNEL:**  
 M. WITTMAN, P.S.  
 J. ALLEN  
 J. LAUBACHER

**DATE / WEATHER / TEMP:**  
 JUNE 24, 2011  
 OUTCAST W-NW  
 65° F

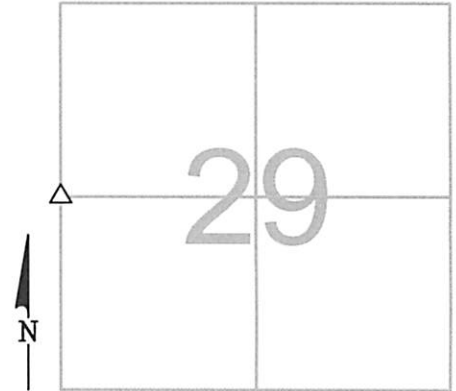

MONUMENT INFORMATION

MONUMENT TYPE: ROUND LIMESTONE W/ DH  
 ON SURFACE - BELOW: 1.91'  
LEFT - CL PAV'T - RIGHT: 4.50'  
 ROUND STONE: 8.5" X 8"

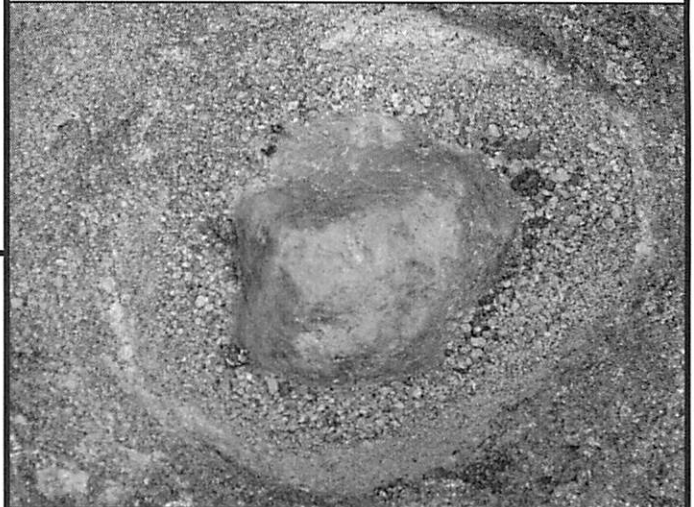

MISC. INFORMATION

FD PK NAIL 0.21' BELOW SURFACE  
 TIED W/ X-TIES & DUG FOR STONE  
 USED DRILL HOLE  
 PK NAIL WAS 0.02' N & 0.01' E OF DRILL HOLE

JUNE 24, 2011

SET 1" SQUARE IRON PIN  
 IN MONUMENT BOX OVER  
 STONE

