

OTTAWA COUNTY ENGINEERS OFFICE

REFERENCE NO. 30-7-15-E
CENTER POST SEC. 30
CARROLL TWP.
SHEET 1 OF 1.

PERSONNEL:
M. WITTMAN, P.S.
J. ALLEN

DATE / WEATHER / TEMP:
MAY 8, 2017
SUNNY - SW
52° F

ROUTE: T-97 BIER RD.

TOWNSHIP: CARROLL


SECTION: 30

T 7 NR 15 E.

NORTHING:

EASTING:

DATUM:

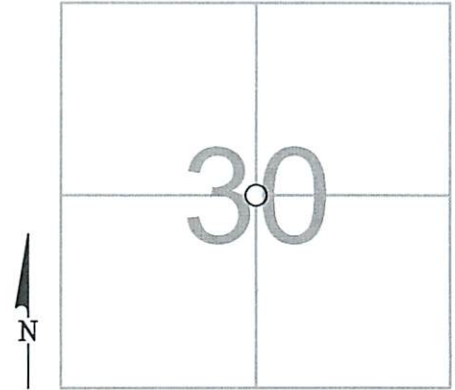

MONUMENT INFORMATION

MONUMENT TYPE: FD. MAG SPIKE
ON SURFACE - BELOW: 0.30'
LEFT - CL PAV'T - RIGHT: 2.85'

NO RECORD OF A STONE, MANY SURVEYS REFER TO A NAIL AND SHINER, PK NAIL OR NAIL SHAFT.



MISC. INFORMATION

DEWITT SURVEY STATES 2623.00' WEST OF EAST 1/4 POST ONLINE TO WEST 1/4 POST. MAG SPIKE WAS 0.11' W AND 0.06' NORTH OF DEWITT POINT. HELD MAG SPIKE LOCATION SINCE IT WAS WITHIN MEASUREMENT TOLERANCE AND IS ONLY PHYSICAL MONUMENT EVIDENCE PER SURVEYS OF RECORD.

MAY 8, 2017

SET 1" SQUARE IRON PIN
IN MONUMENT BOX IN PLACE
OF MAG SPIKE

