

# OTTAWA COUNTY ENGINEERS OFFICE

REFERENCE NO. 30-7-15-1  
SE CORNER POST SECTION 30  
CARROLL TWP.  
SHEET 1 OF 1.

PERSONNEL:  
M. WITTMAN, P.S.  
J. ALLEN  
C. MILLER

DATE / WEATHER / TEMP:  
AUGUST 6, 2009  
SUNNY NW  
75° F

ROUTE: C-98 SALEM-CARROLL RD. @  
T- 92 TOUSSAINT-PORTAGE RD.

TOWNSHIP: CARROLL


SECTION: 30

T 7 NR 15 E.

NORTHING:

EASTING:


DATUM:

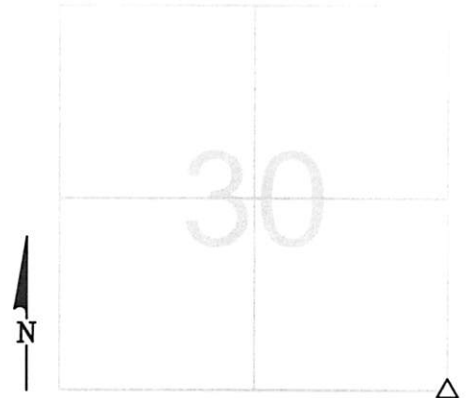

## MONUMENT INFORMATION

MONUMENT TYPE: FD POINTED HARDHEAD STONE  
W/ DRILL HOLE  
ON SURFACE - BELOW: 2.05'  
LEFT - CL PAV'T - RIGHT: 1.91'  
RECTANGULAR STONE: 9" x 7"

USED DRILL HOLE.

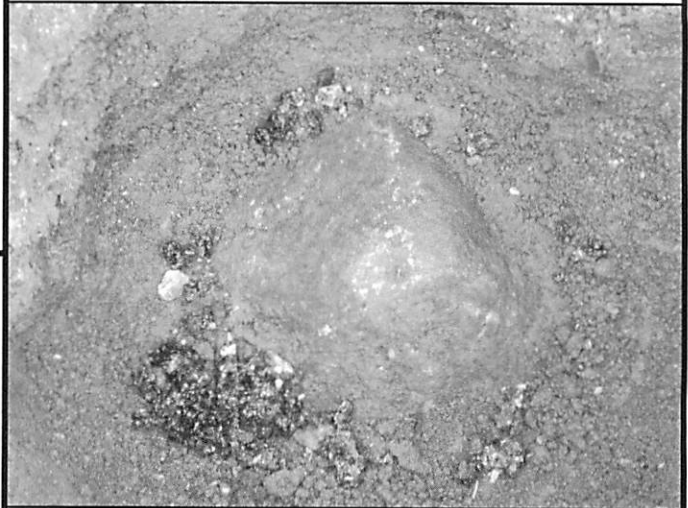

## MISC. INFORMATION

FD RAILROAD SPIKE W/ PUNCH MARK ON SURFACE.  
TIED W/ CROSS TIES AND DUG FOR STONE.  
RAILROAD SPIKE WAS 0.03' NORTH AND 0.02' EAST  
OF DRILL HOLE.

AUGUST 6, 2009

SET 1" SQUARE IRON PIN  
IN MONUMENT BOX OVER  
STONE

