

# OTTAWA COUNTY ENGINEERS OFFICE

REFERENCE NO. 32-8-15-1  
SE CORNER POST SEC. 32  
CARROLL TWP.  
SHEET 1 OF 1.

ROUTE: STATE ROUTE #2

TOWNSHIP: CARROLL

SECTION: 32

T 8 NR 15 E.

**PERSONNEL:**

M. WITTMAN, P.S.  
J. ALLEN  
E. KOCH  
K. BECK


NORTHING:

EASTING:

DATUM:

**DATE / WEATHER / TEMP:**

MAY 10, 2010  
SUNNY - E  
51° F

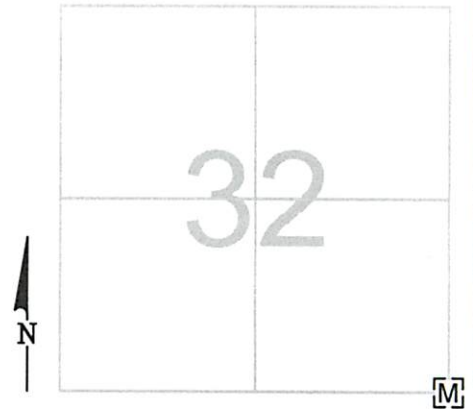

MONUMENT INFORMATION

MONUMENT TYPE: FD. 3/4" Ø IRON PIN IN  
MONUMENT BOX  
ON SURFACE - BELOW:  
LEFT - CL PAV'T - RIGHT: 4.00'



MISC. INFORMATION

