

OTTAWA COUNTY ENGINEERS OFFICE

REFERENCE NO. 5-7-15-D
WEST QUARTER POST SEC. 5
CARROLL TWP.
SHEET 1 OF 1.

ROUTE: T-90 LEMON RD
@ T-234 BODI RD.

TOWNSHIP: CARROLL

SECTION: 5

T 7 NR 15 E.

NORTHING:

EASTING:


DATUM:

PERSONNEL:

M. WITTMAN, P.S.
S. ULLRICH
M. ULLRICH
B. JEFFRIES

DATE / WEATHER / TEMP:

JULY 8, 2008
PTLY SUNNY SW
83° F

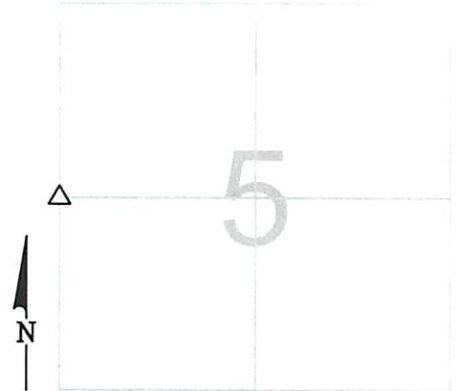

MONUMENT INFORMATION

MONUMENT TYPE: FD LIMESTONE W/ DRILL HOLE
ON SURFACE - BELOW: 1.70'
LEFT - CL PAVT - RIGHT:

RECTANGULAR STONE: 4" x 8"



MISC. INFORMATION

JULY 8, 2008

SET 1" SQUARE IRON PIN
IN MONUMENT BOX OVER
STONE

