

OTTAWA COUNTY ENGINEERS OFFICE


REFERENCE NO. 5-7-15-0
S QUARTER POST NW QUARTER
SECTION 5 CARROLL TWP.
SHEET 1 OF 1.

PERSONNEL:
M. WITTMAN, P.S.
S. ULLRICH
M. ULLRICH
B. JEFFRIES

DATE / WEATHER / TEMP:
JULY 8, 2008
SUNNY SW
80° F

ROUTE: T-234 BODI RD.
TOWNSHIP: CARROLL
SECTION: 5
T 7 NR 15 E.

NORTHING:
EASTING:
DATUM:

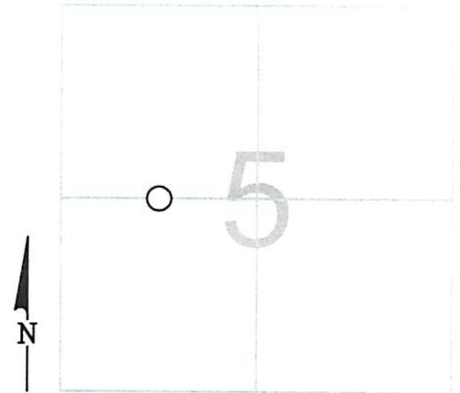

MONUMENT INFORMATION

MONUMENT TYPE: FD 1" SQ IRON PIN
ON SURFACE - BELOW: 0.38'
LEFT - CL PAV'T - RIGHT: TO WEST
LEFT - CL PAV'T - RIGHT: TO NORTH



MISC. INFORMATION

JULY 8, 2008

SET MONUMENT BOX OVER
FD. 1" SQUARE IRON PIN

