

OTTAWA COUNTY ENGINEERS OFFICE

REFERENCE NO. 30-7-15-D
WEST QUARTER POST SEC. 6
CARROLL TWP.
SHEET 1 OF 1.

ROUTE: C-23 BENTON-CARROLL RD.

TOWNSHIP: CARROLL

SECTION: 6

T 7 NR 15 E.


PERSONNEL:

M. WITTMAN, P.S.
J. ALLEN
C. MILLER

NORTHING:

EASTING:

DATUM:

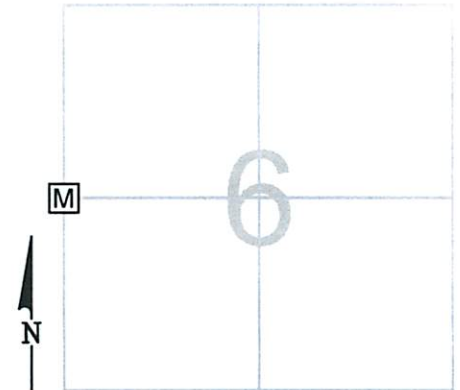


DATE / WEATHER / TEMP:

JUNE 22, 2009
SUNNY HUMID NE
78° F

MONUMENT INFORMATION

MONUMENT TYPE: SET 1" SQ. IRON PIN IN MON. BOX
ON SURFACE - BELOW:
LEFT - CL PAV'T - RIGHT: 7.50'

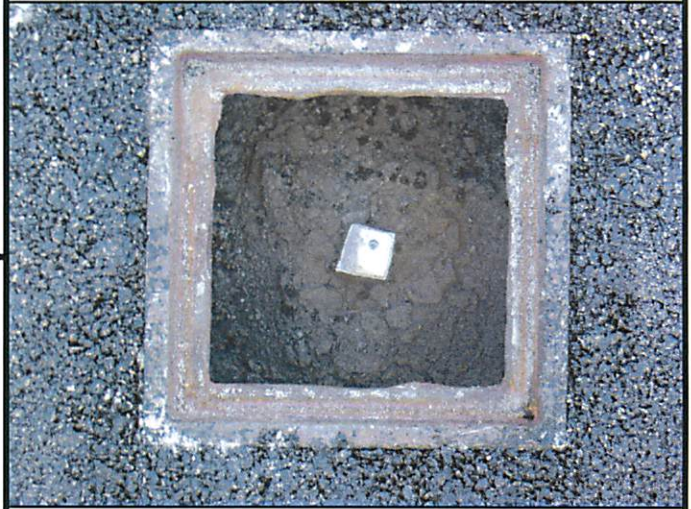

MISC. INFORMATION

ASSISTED BEC ASSOCIATES IN DIG FOR STONE
IN SUMMER 2007, STONE NOT FOUND. POINT
ESTABLISHED AND RESET USING SINGLE
PROPORTIONATE MEASUREMENT.

THIS IS A CLOSING CORNER.

JUNE 22, 2009

SET 1" SQUARE IRON PIN
IN MONUMENT BOX

SET 1" SQ. IP
IN MON. BOX (6-22-09)
E 1/4 POST BENTON 1

