

OTTAWA COUNTY ENGINEERS OFFICE

REFERENCE NO. 6-7-15-I
SE CORNER POST SEC. 6
CARROLL TWP.
SHEET 1 OF 1.

PERSONNEL:
M. WITTMAN, P.S.
J. ALLEN

DATE / WEATHER / TEMP:
APRIL 4, 2013
SUNNY
45° F

ROUTE: T-90 LEMON RD.
@ T-91 ZENSER RD.

TOWNSHIP: CARROLL


SECTION: 6

T 7 NR 15 E.

NORTHING:


EASTING:

DATUM:

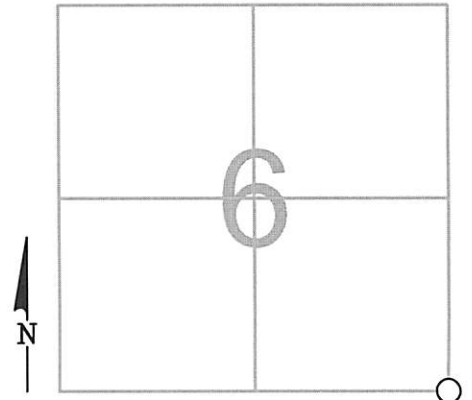

MONUMENT INFORMATION

MONUMENT TYPE: FD. 7/8" Ø IRON PIN
ON SURFACE - BELOW: 0.33'
LEFT - CL PAV'T - RIGHT: 2.30'

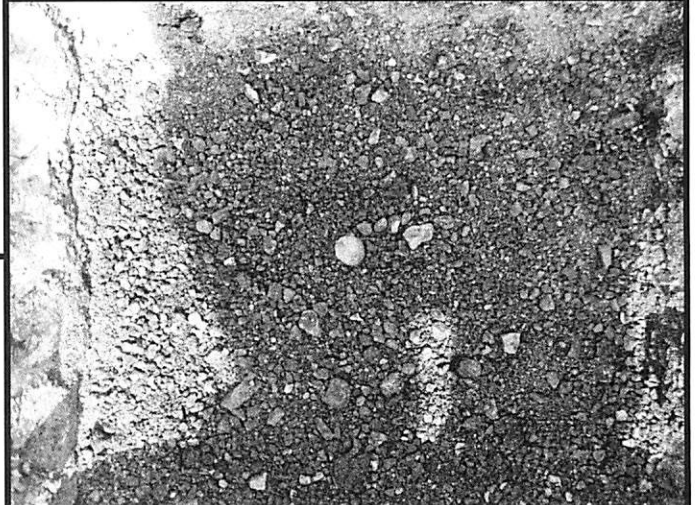

MISC. INFORMATION

IRON PIN IN IRON PIPE SET BY C.A. STEVENSON IN
1954 SEE CARROLL SURVEY BOOK MISC. 1 PAGE 33
DID NOT FIND IRON PIPE

MARCH 4, 2013

SET MONUMENT BOX OVER
IRON PIN

ZENSER RD., T.R. #91

