OTTAWA COUNTY ENGINEERS OFFICE

REFERENCE NO. 7-7-15-A

NORTHWEST CORNER SEC. 7

CARROLL TWP.

SHEET 1 OF 1.

ROUTE: C-23 BENTON-CARROLL RD.

TOWNSHIP: CARROLL

SECTION: 7

T 7 NR 15 E.

PERSONNEL:

M. WITTMAN, P.S.

J. ALLEN E. KOCH

NORTHING:

EASTING:

DATE / WEATHER / TEMP:

JUNE 30, 2009 OVERCAST W 66° F DATUM:



M

MONUMENT INFORMATION

MONUMENT TYPE: SET 1" SQ. IRON PIN IN MON. BOX

ON SURFACE - BELOW:


LEFT - CL PAV'T - RIGHT: 2.15'



MISC. INFORMATION

ASSISTED BEC ASSOCIATES IN DIG FOR STONE IN SUMMER 2007, STONE NOT FOUND. POINT ESTABLISHED BY HOLDING RECORD DISTANCE OF 1.90 CHAINS ON LINE BETWEEN NE CORNER BENTON 12 AND EAST 1/4 POST BENTON 12.

THIS IS A CLOSING CORNER.

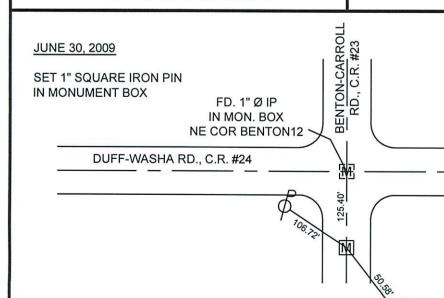

ZENZER RD., T.R. #91