

# OTTAWA COUNTY ENGINEERS OFFICE

REFERENCE NO. 7-7-15-C  
NE CORNER POST SEC. 7  
CARROLL TWP.  
SHEET 1 OF 1.

PERSONNEL:  
M. WITTMAN, P.S.  
J. ALLEN

DATE / WEATHER / TEMP:  
APRIL 4, 2013  
SUNNY  
45° F

ROUTE: T-90 LEMON RD.  
@ T-91 ZENSER RD.

TOWNSHIP: CARROLL


SECTION: 7

T 7 NR 15 E.

NORTHING:

EASTING:

DATUM:

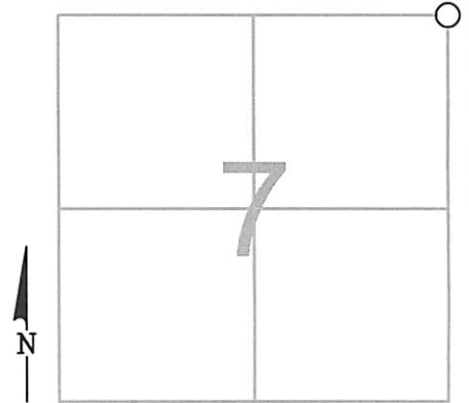

## MONUMENT INFORMATION

MONUMENT TYPE: FD. 7/8" Ø IRON PIN  
ON SURFACE - BELOW: 0.33'  
LEFT - CL PAV'T - RIGHT: 2.30'

## MISC. INFORMATION

IRON PIN IN IRON PIPE SET BY C.A. STEVENSON IN  
1954 SEE CARROLL SURVEY BOOK MISC. 1 PAGE 33  
DID NOT FIND IRON PIPE



MARCH 4, 2013

SET MONUMENT BOX OVER  
IRON PIN

