

# OTTAWA COUNTY ENGINEERS OFFICE

**REFERENCE NO.** 8-7-15-G  
SW CORNER POST SECTION 8  
CARROLL TWP.  
**SHEET** 1 OF 1.

**ROUTE:** T-92 TOUSSAINT PORTAGE RD.

**TOWNSHIP:** CARROLL

**SECTION:** 8

**T** 7 **NR** 15 **E.**

**PERSONNEL:**

M. WITTMAN, P.S.  
J. BARNES  
A. WEIRICH, P.S. - BEC  
P. SEGAARD, P.S. - BEC


**NORTHING:**

**EASTING:**

**DATUM:**

**DATE / WEATHER / TEMP:**

MARCH 13, 2007  
SUNNY SW  
56° F

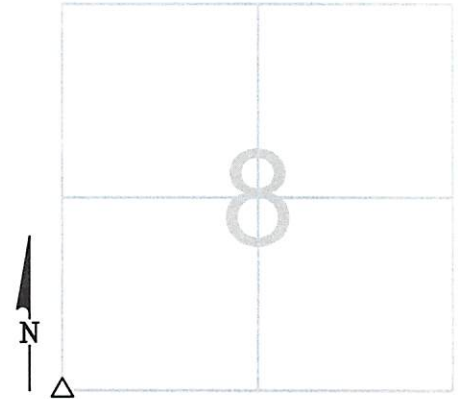

MONUMENT INFORMATION

MONUMENT TYPE: FD LIMESTONE  
ON SURFACE - BELOW: 1.05'  
LEFT - CL PAV'T - RIGHT:  
RECTANGULAR STONE: 6" N-S x 7 1/2" E-W



MISC. INFORMATION

FD 1/2" IRON PIN SET BY D.A. BRUNKHORST IN  
1981. FOUND STONE 4 3/4" W AND 1" N OF IRON  
PIN. SET 1" SQ. IRON PIN OVER STONE.  
REMOVED 1/2" IRON PIN.

MARCH 13, 2007

FIBERGLASS WITNESS POST 0.95' N

SET 1" SQUARE IRON PIN  
OVER STONE

