

# OTTAWA COUNTY ENGINEERS OFFICE

REFERENCE NO. 8-7-15-H  
SOUTH QUARTER POST SEC. 8  
CARROLL TWP.  
SHEET 1 OF 1.

ROUTE: T-92 TOUSSAINT-PORTAGE RD.

TOWNSHIP: CARROLL

SECTION: 8

T 7 NR 15 E.

PERSONNEL:  
M. WITTMAN, P.S.  
J. ALLEN


NORTHING:

EASTING:

DATUM:

DATE / WEATHER / TEMP:

APRIL 4, 2012  
SUNNY  
50° F

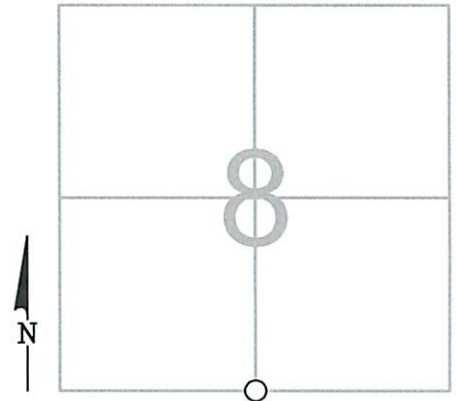

## MONUMENT INFORMATION

MONUMENT TYPE: FD RAILROAD SPIKE  
ON SURFACE - BELOW: 0.35'  
LEFT - CL PAV'T - RIGHT: 2.40'



## MISC. INFORMATION

REPLACED RAILROAD SPIKE WITH 1" SQ. IRON PIN  
IN MONUMENT BOX

APRIL 4, 2012

SET 1" SQUARE IRON PIN  
IN MONUMENT BOX

