


Car 2-4-1

3-4-1

PLAT OF A SURVEY FOR
LES BOWYER
IN SECTION 2, T7N, R15E
CARROLL TOWNSHIP
OTTAWA COUNTY, OHIO
1978

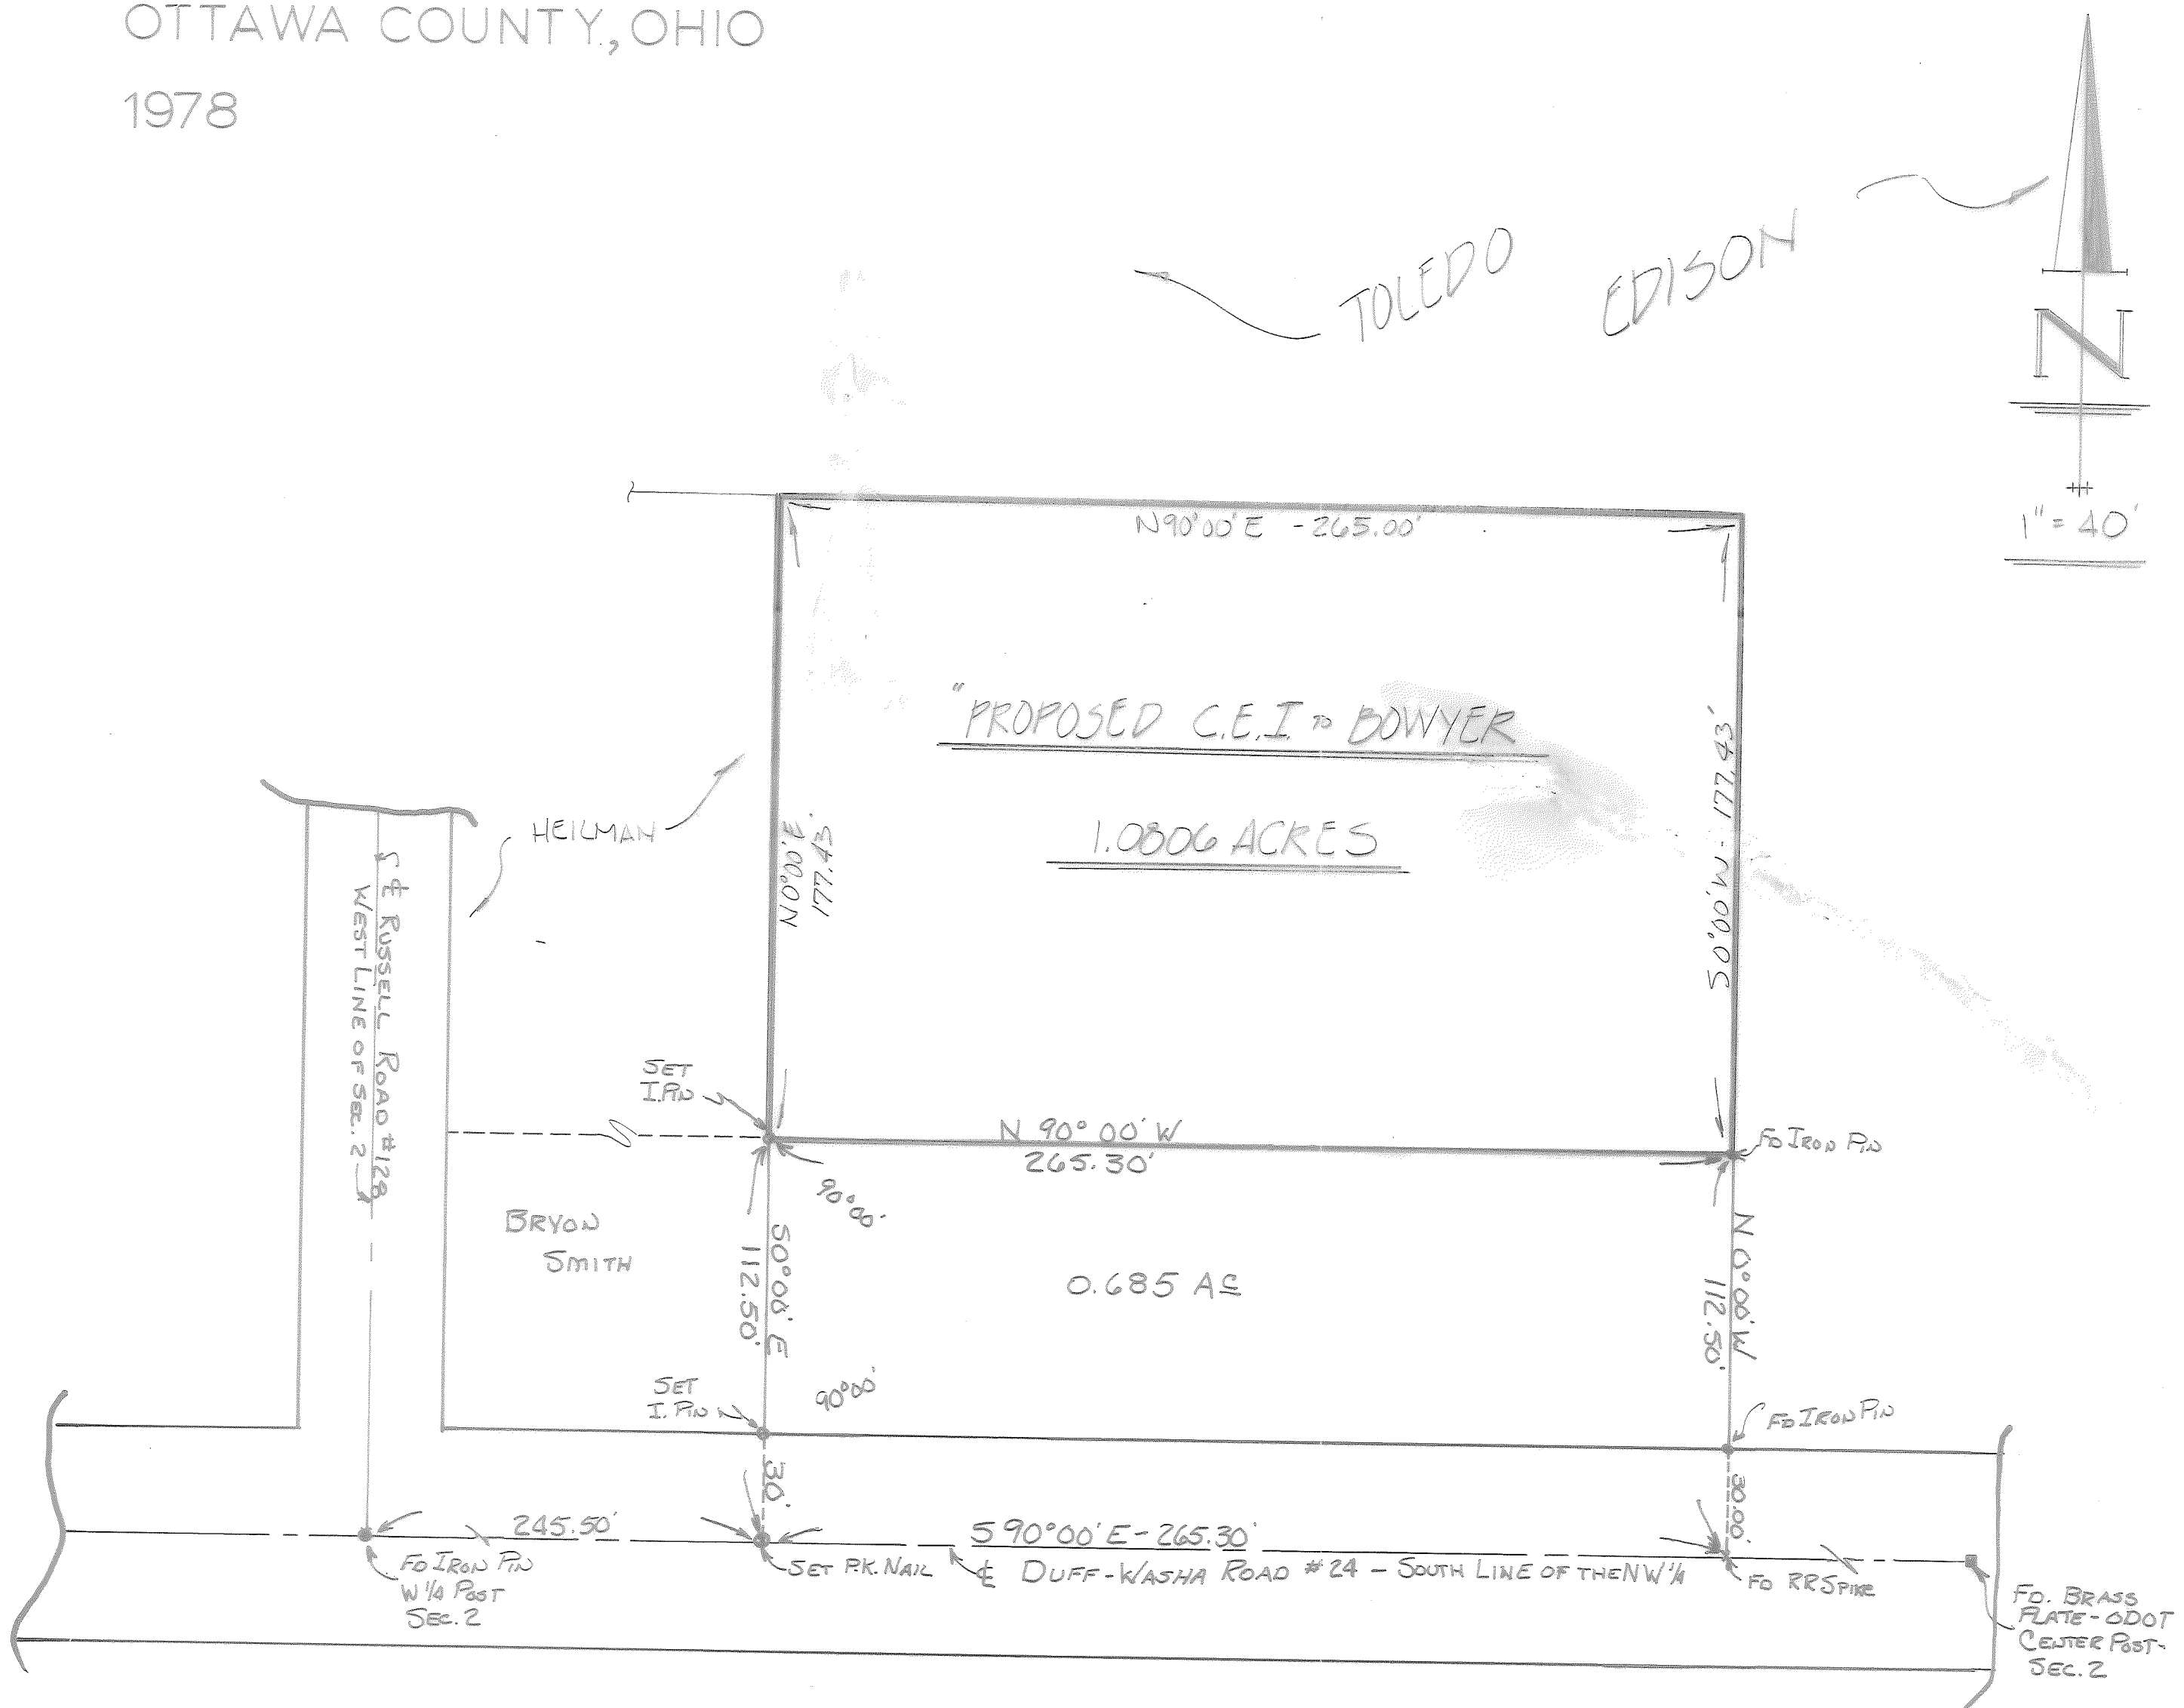

THE ABOVE PLAT IS A TRUE AND CORRECT REPRESENTATION
OF A SURVEY MADE BY ME ON APRIL 29, 1978 FOR AND
AT THE INSTANCE OF MR. LES BOWYER.

David J. Dunkle
REGISTERED SURVEYOR # 6314

REVISED 3-3-85