



MAP B-2

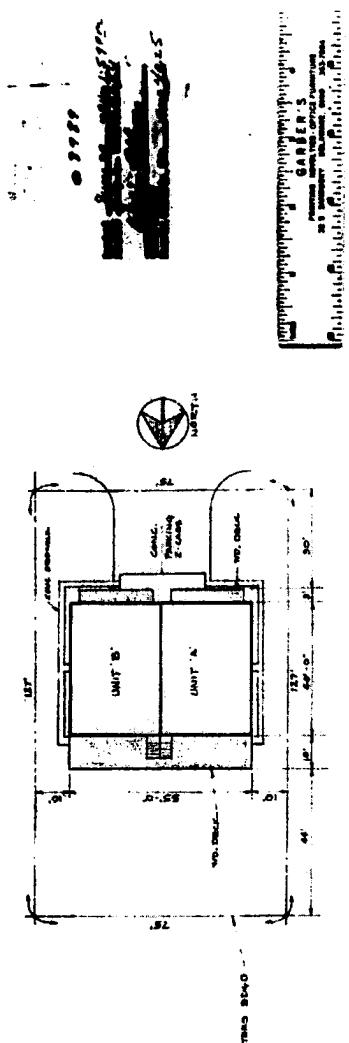

B & V CONDOMINI

SITE PLAN

NOTE: Dimensions indicated above show THE Space as it is now contracted.

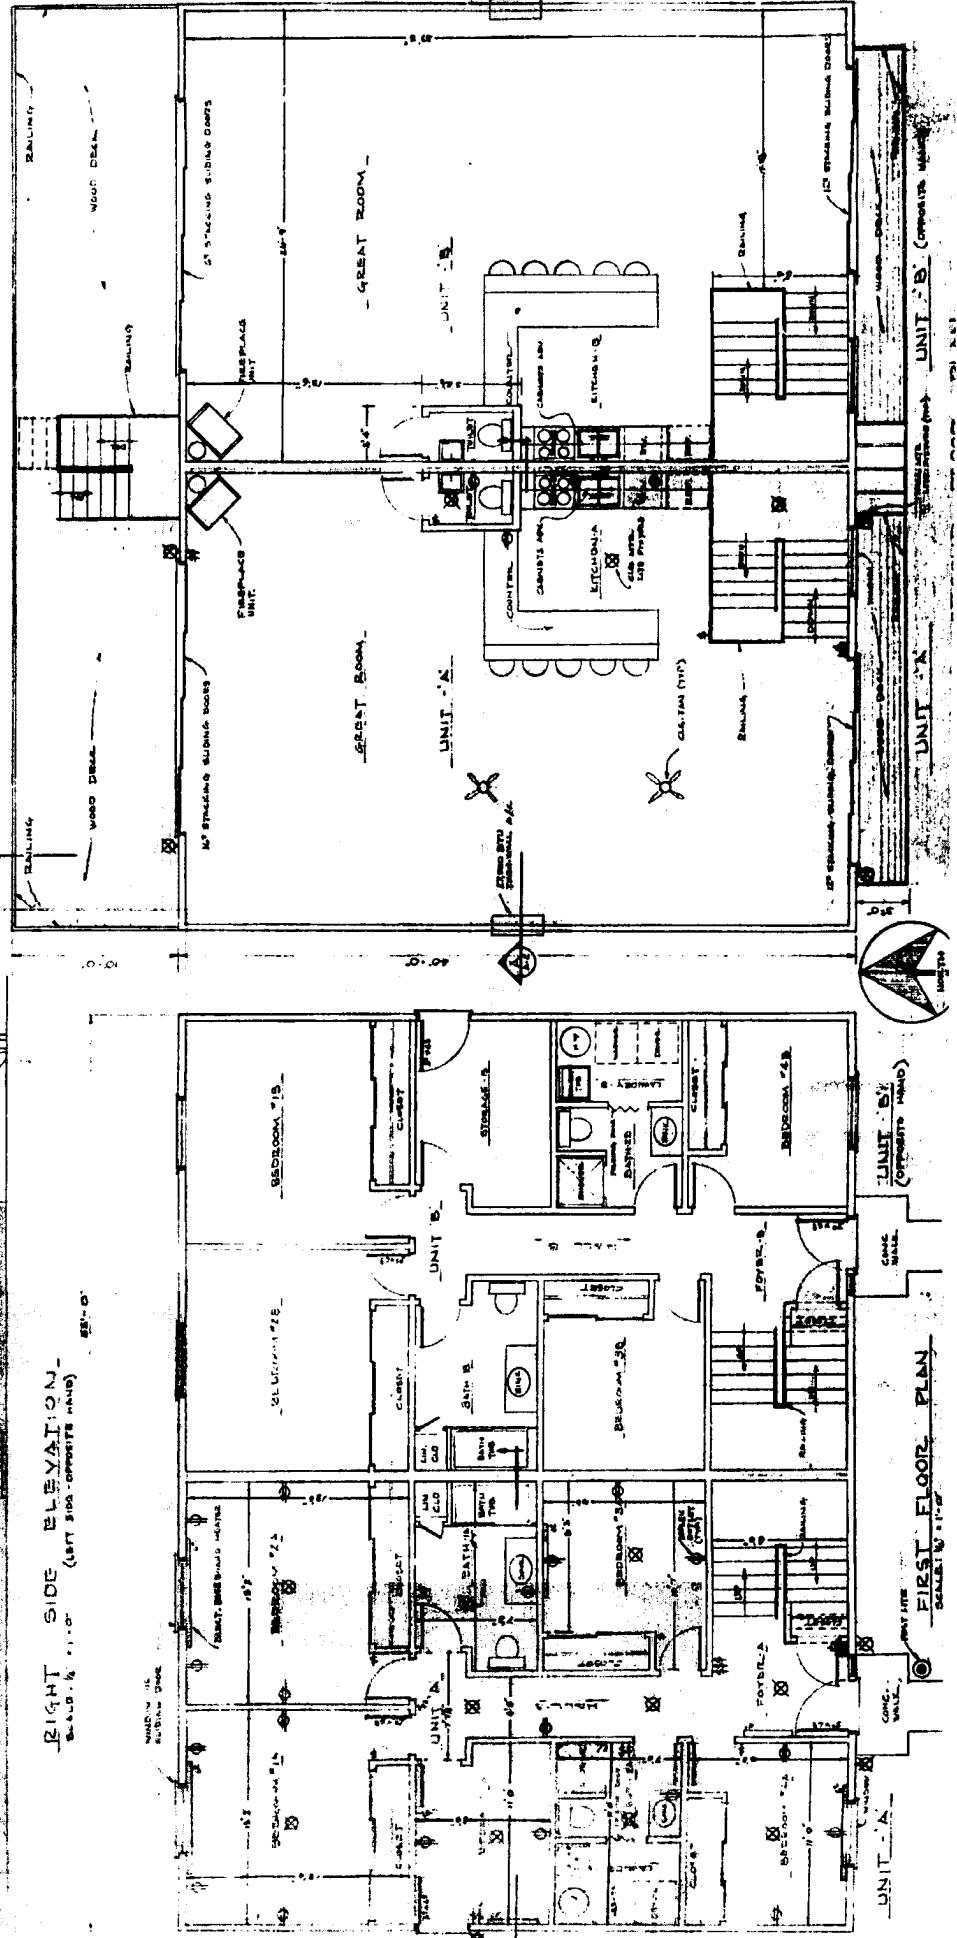


UNIT A - 21A

UNIT A - 21 (continued)


FINISH SCHEDULE

Room	Floor	Surface	Color	Material	Finish	Comments
KITCHEN	1	WALL	WHITE	WOOD	PAINT	PAINTED
HALL	1	FLOOR	WHITE	WOOD	PAINT	PAINTED
BEDROOM 1	1	FLOOR	WHITE	WOOD	PAINT	PAINTED
BEDROOM 2	1	FLOOR	WHITE	WOOD	PAINT	PAINTED
BEDROOM 3	1	FLOOR	WHITE	WOOD	PAINT	PAINTED
BATH 1	1	FLOOR	WHITE	WOOD	PAINT	PAINTED
BATH 2	1	FLOOR	WHITE	WOOD	PAINT	PAINTED
LAUNDRY	1	FLOOR	WHITE	WOOD	PAINT	PAINTED
STAIRS	1	FLOOR	WHITE	WOOD	PAINT	PAINTED
CLOSETS	1	FLOOR	WHITE	WOOD	PAINT	PAINTED
TOILET	1	FLOOR	WHITE	WOOD	PAINT	PAINTED
DRESSER	1	FLOOR	WHITE	WOOD	PAINT	PAINTED
CHART	1	FLOOR	WHITE	WOOD	PAINT	PAINTED

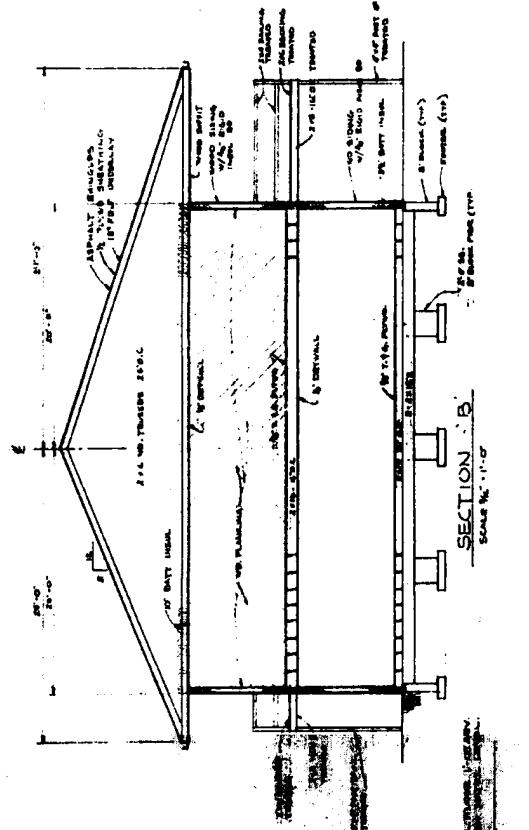


SECTION B

Scale 1:100
NOTES:
1. Dimensions indicated shown true.
2. Units on sketch as constructed.

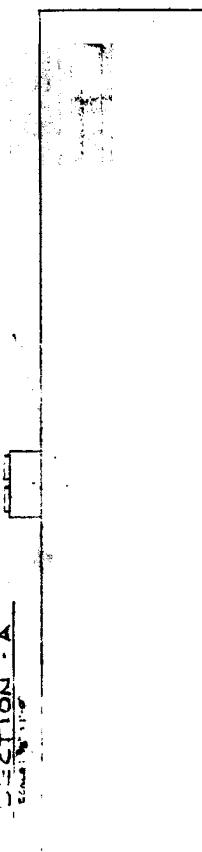

SECTION A

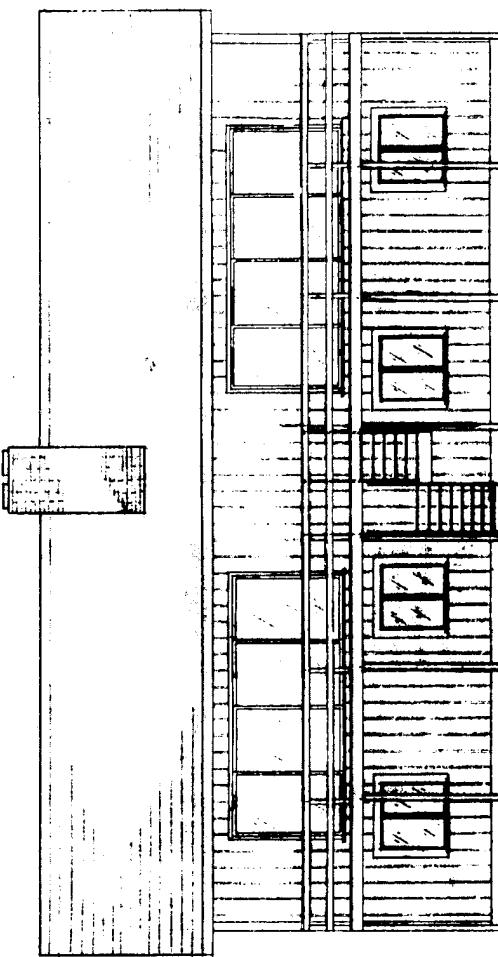

FRONT ELEVATION

ITEM	DESCRIPTION	DATE
1	PROPOSED COFFEE	
2	LINN BUNTE	
3	WALL PAINT	

REAR ELEVATION

