



PLAT OF
CATAWBA ISLAND CLUB
CONDOMINIUM NO. FOUR
 IN CATAWBA ISLAND TOWNSHIP
 OTTAWA COUNTY, OHIO

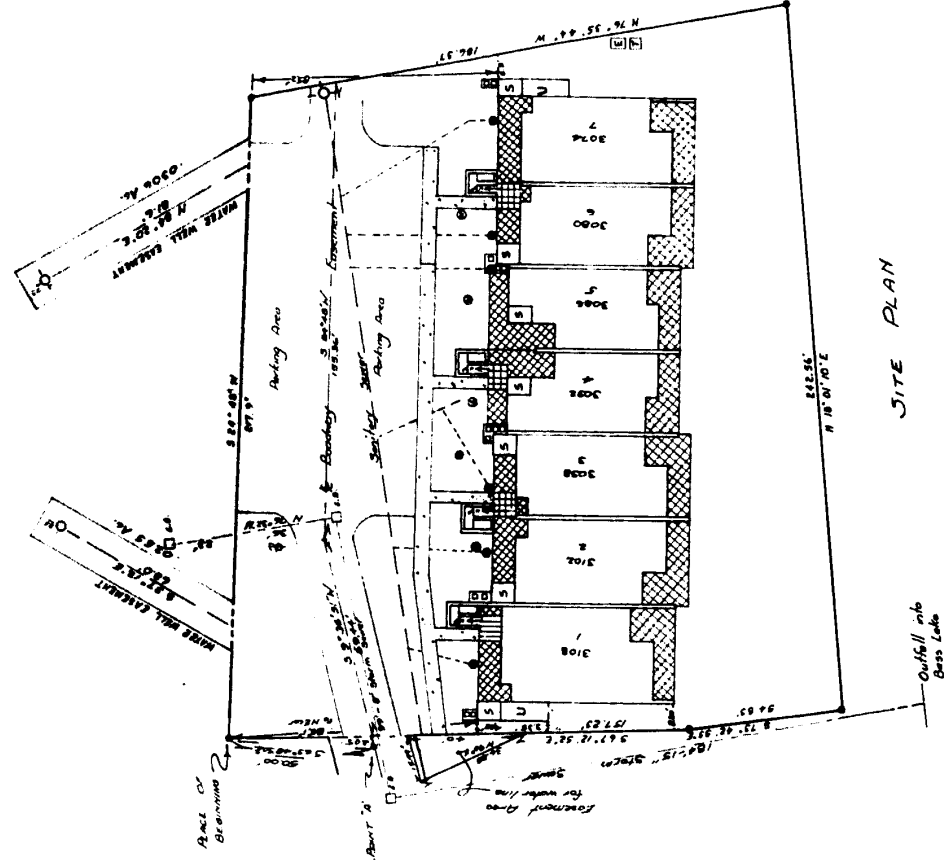

LEGEND

- LCA Limited Common Area
- LCA for adjacent unit
- First Floor - LCA, 4 units - 2nd floor unit and the two units on second floor - LCA, two units - concrete wall - Common Area
- LCA - air conditioning units
- First Floor - LCA, 2 units - 1st and 2nd unit directly above unit
- Sewer Man
- Gas Catch Basin
- Mannich
- Sewer Cleanout
- Waterstop
- LCA - Storage - two story unit - concrete unit involved
- Electric Meter
- Electric Transformer Enclosure
- Telephone
- Sewer Lateral
- Iron Pin
- Storm Sewer
- Utility & Service Heating

SITE PLAN

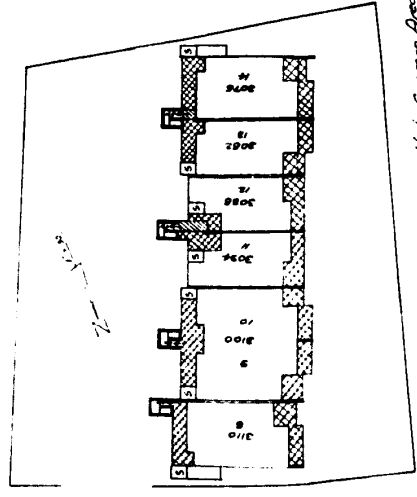

Detail of 2nd & 3rd Floor Limited Common Area and Unit No. 1 indicates go floor balcony

I hereby certify that this set of drawings accurately shows the building or buildings as constructed.

Richard D. Buehler
 Reg. Engineer No. 5300
 Reg. Expt. No. 15995
 2/15/68



#195518
 Prepared by
 Checked by
 Date