



# CATAWBA SHORES CONDOMINIUM PHASE 4

## LOT 13, SECTION 3, CATAWBA ISLAND TOWNSHIP, OTTAWA COUNTY

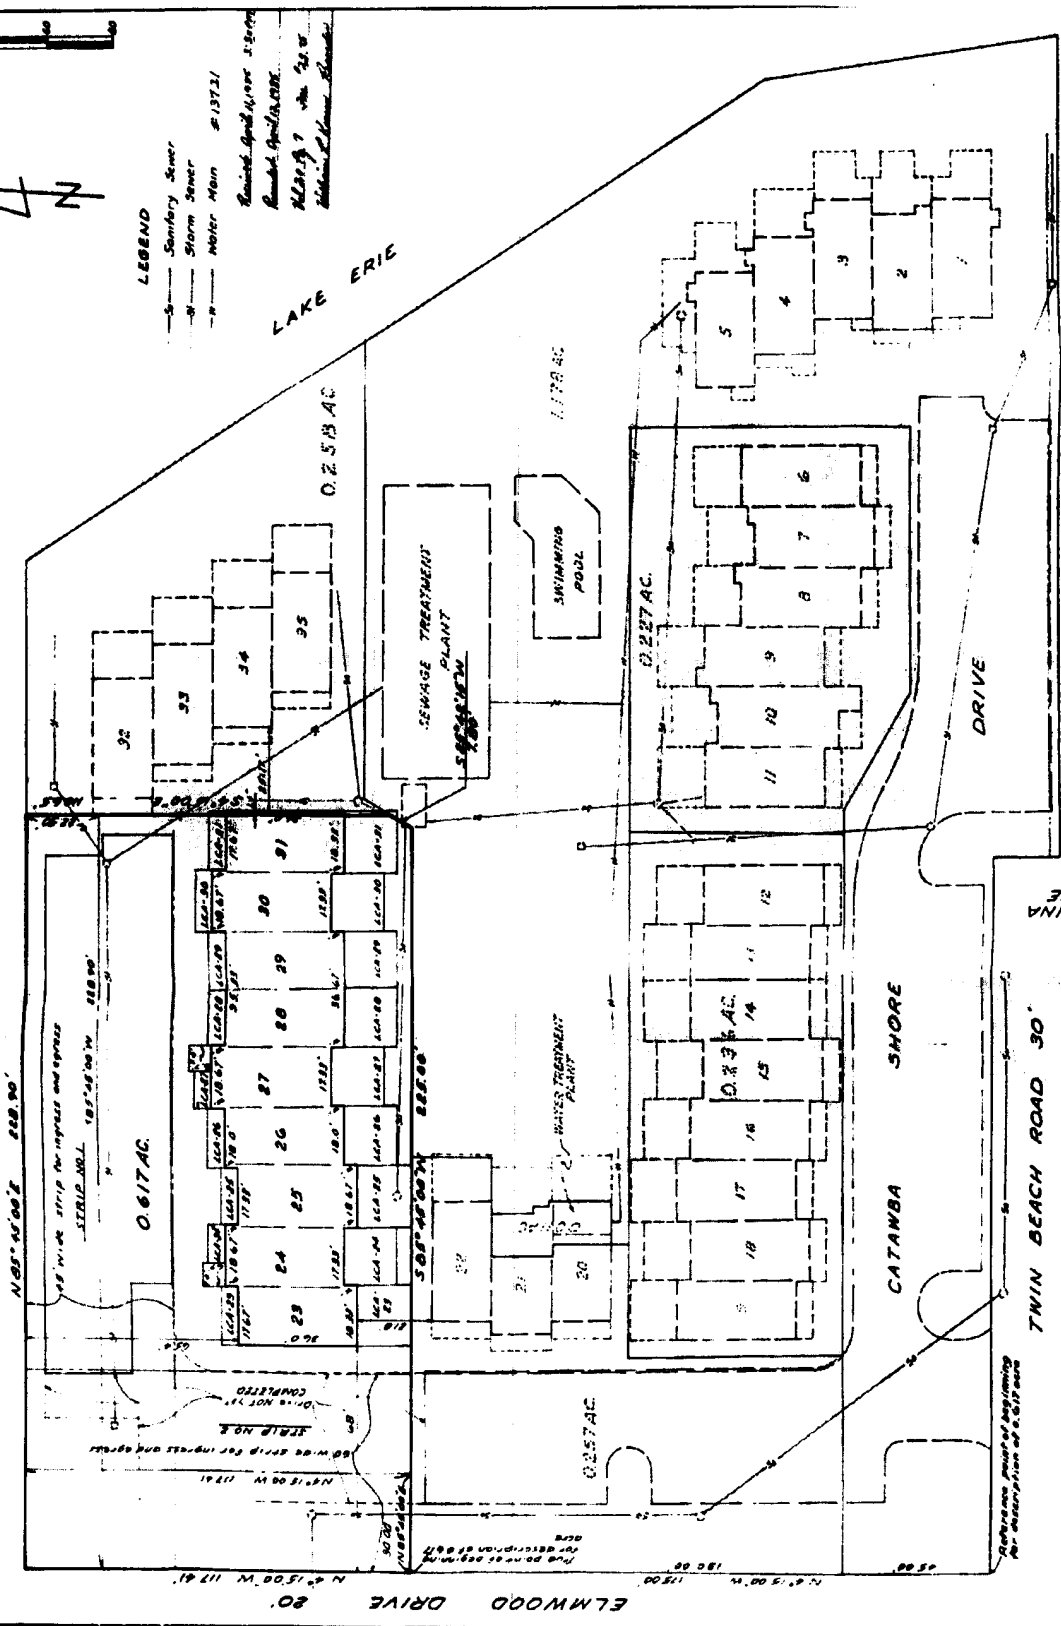

**LEGEND**  
 - - - Sanitary Sewer  
 - - - Storm Sewer  
 - - - WATER MAIN #13731  
 Revised April 14, 1988 J.S.G.  
 Plotted April 14, 1988  
 M.S.P. 7 in. 24" W  
 Minimum 2' Minimum Spacing

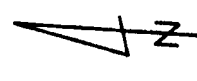

- NOTES:
- 1) Certain Easement Shown on this plan are for information only and are not to be construed as a grant of any interest in the land.
  - 2) These easements are shown for information only and are not to be construed as a grant of any interest in the land.
  - 3) All other easements shown on this plan are for information only and are not to be construed as a grant of any interest in the land.


BRUER, DAVIDSON & MERCHANT, INC.  
 CONSULTING ENGINEERS  
 2607 1/2 North High Street  
 Columbus, Ohio 43202  
 August 22, 1988

No fees by, certify that the attached drawing accurately shows the boundaries of Catawba Shores Condominium Phase 4 as constructed.

By: *William F. Merchant*  
 William F. Merchant  
 Consulting Engineer  
 2607 1/2 North High Street  
 Columbus, Ohio 43202




# 13721  
 Revised April 14, 1928  
 Revised April 14, 1928  
 City of ...  
 William P. Hume, Engineer

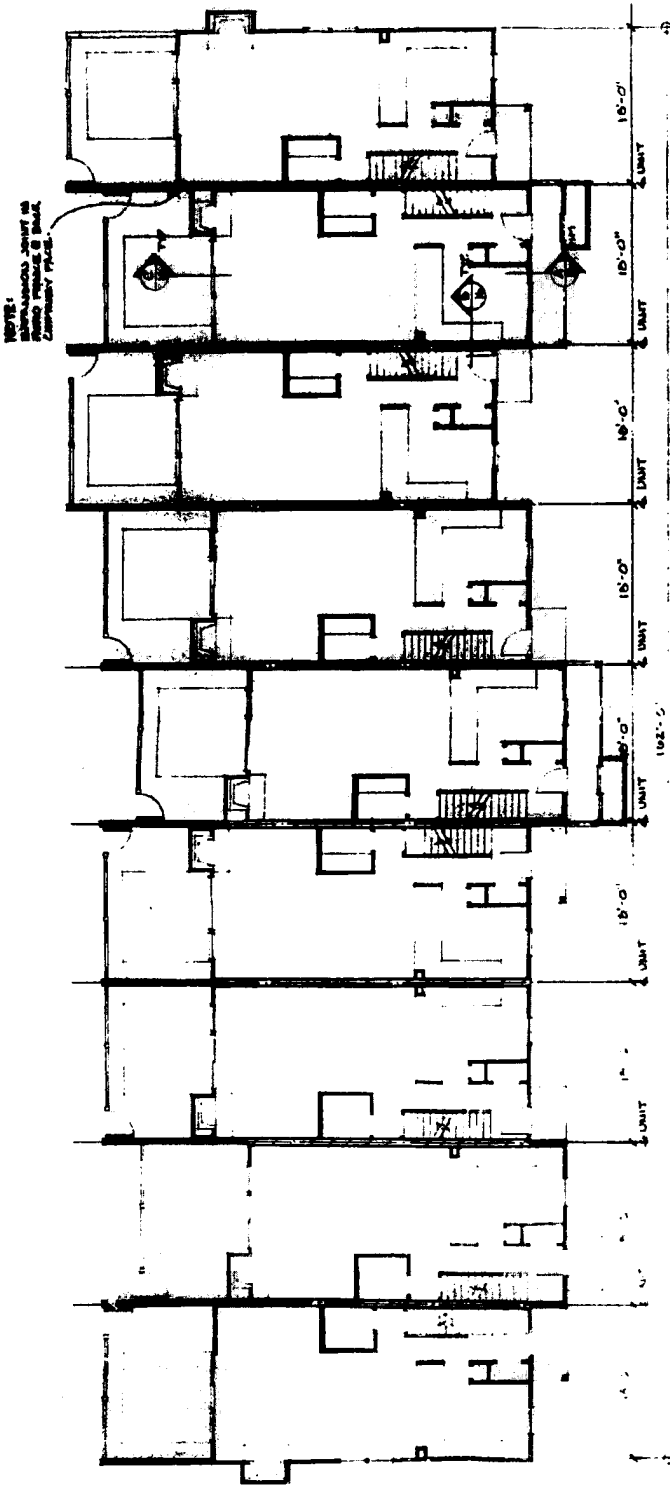

**first floor plan**

SEE BLDG. PLANS, SHEET 1 FOR  
 TYPICAL FINISH NOTES AND  
 SECTION COTE.

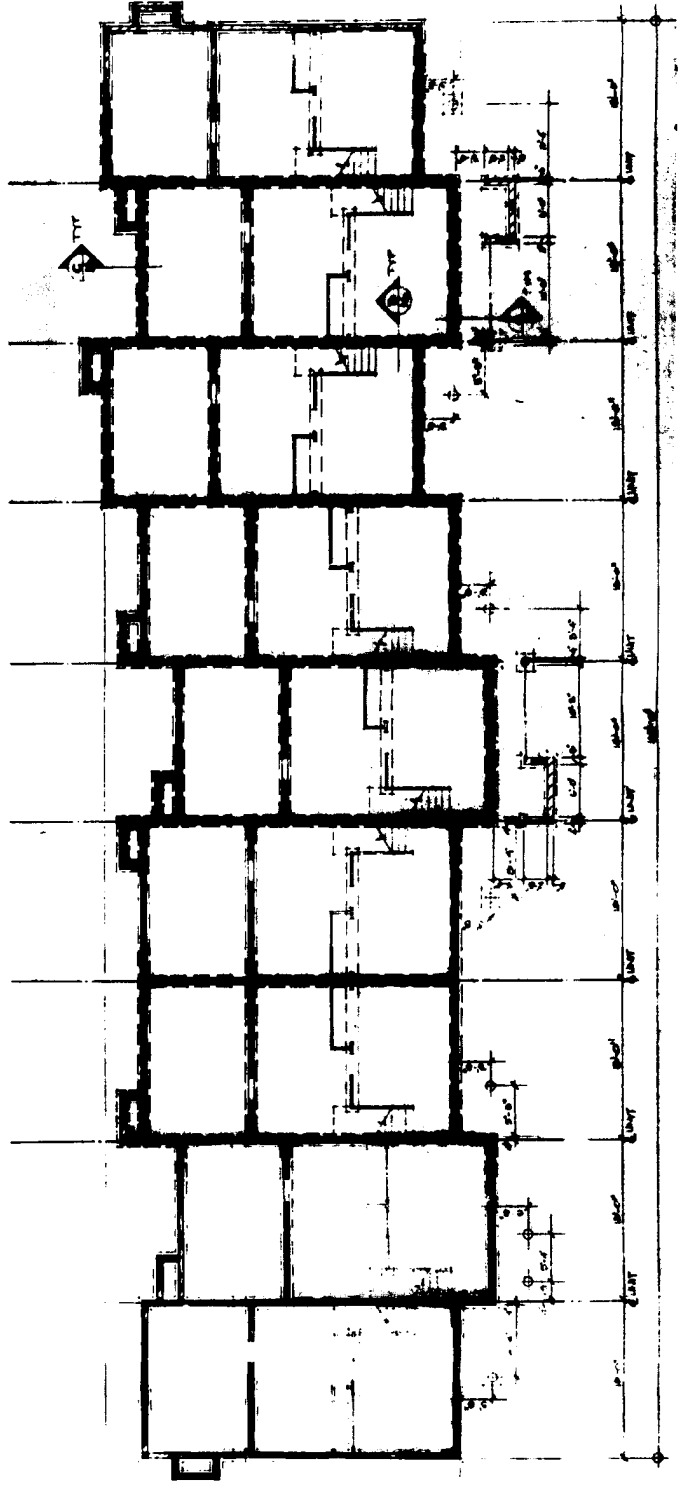


10  
11  
12  
7B



# 11721  
William R. Linn  
Professional Engineer  
State of South Carolina  
License No. 11721

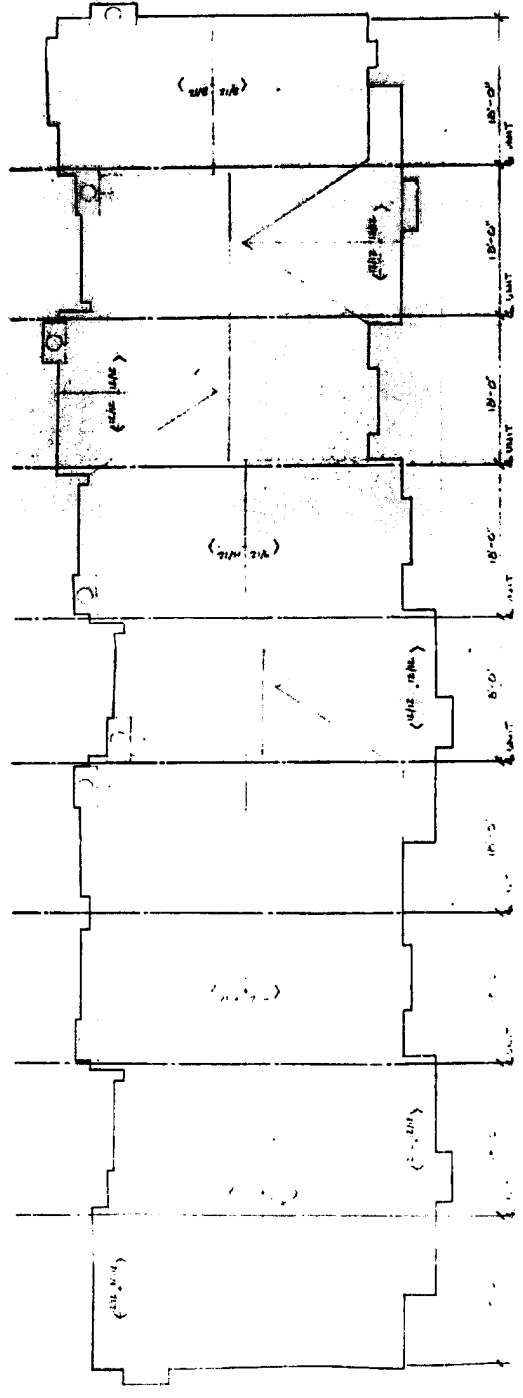


roof plan  
SEE SHEET 7B FOR  
ELECTRICAL SYMBOLS

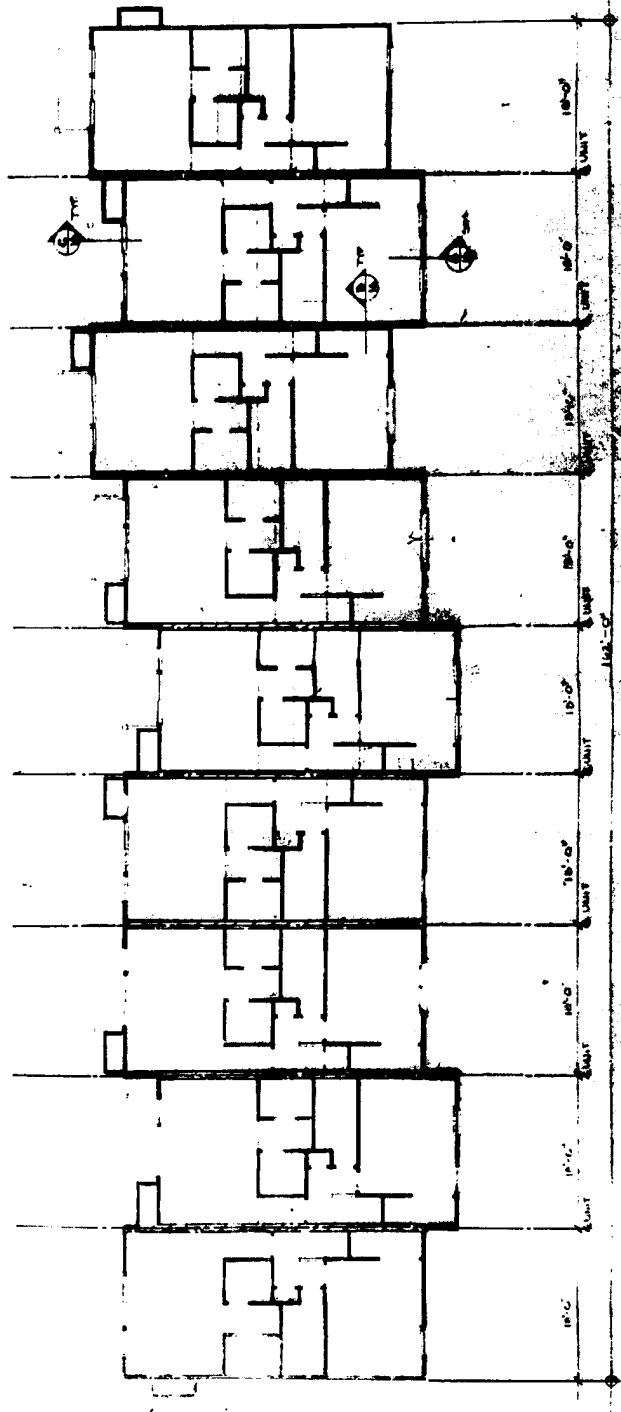


second floor plan


Architectural Firm  
GARDNER

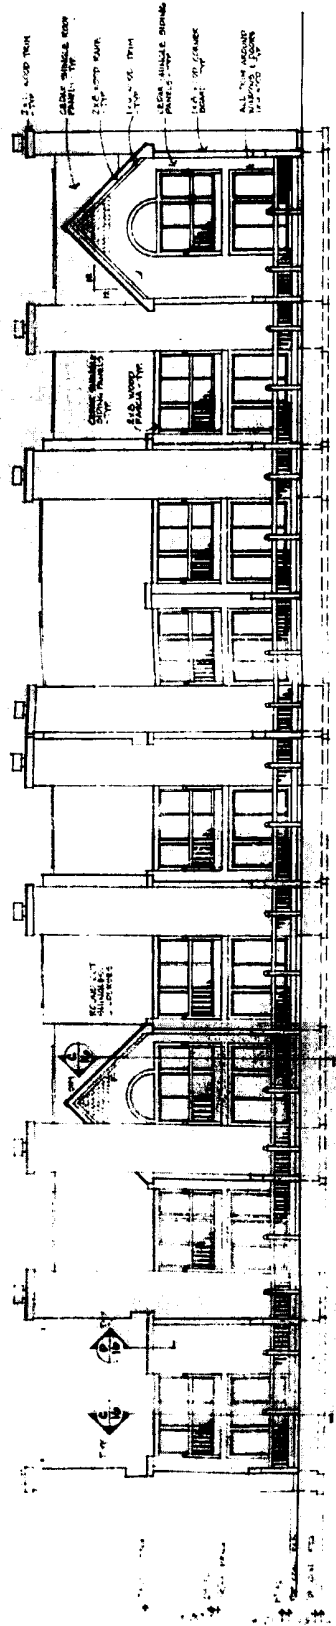

South elevation  
1/8" = 1'-0"

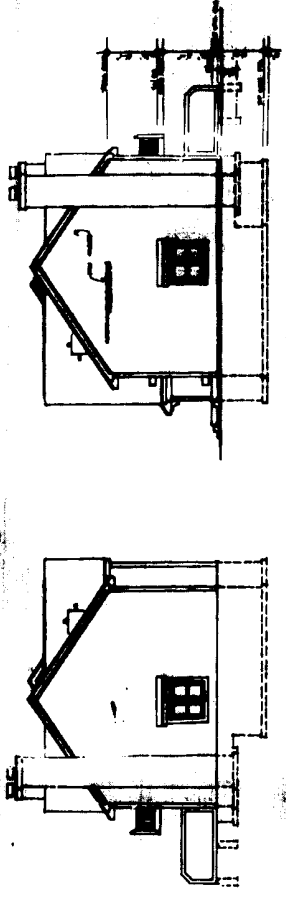

# 18721  
 Revised Specifications  
 Revised April 19, 1928  
 Edited by J. C. ...  
 Wm. R. ...

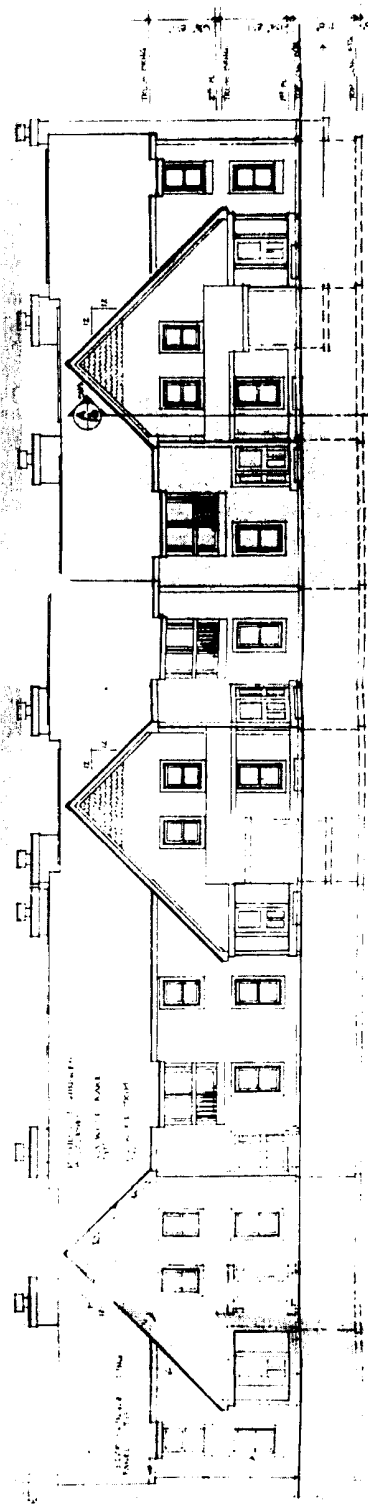

North elevation  
1/8" = 1'-0"



Printed and Published by  
 GARDNER  
 111 N. ...  
 Columbus, Ohio