

PLAT FOR COME SAIL AWAY CONDOMINIUM PHASE II AND MARINA PHASE I

Platted in the Township of Catawba Island, County of Ottawa and State of Ohio

Known as and being a parcel of land located in Section 3, Lot 1, Firelands Survey, Catawba Island Township, Ottawa County, Ohio, and being more particularly described as follows:

Commencing at the intersection of the south line of Section 3, Lot 1, Firelands Survey, Catawba Island Township, Ottawa County, Ohio, with the centerline of State Route 451, thence proceeding North 31 degrees 49 minutes 00 seconds East on the centerline of said State Route 451 a distance of 131.74 feet to a point; thence proceeding South 70 degrees 30 minutes 30 seconds East a distance of 202.70 feet to a point; thence proceeding North 21 degrees 20 minutes 00 seconds East a distance of 121.17 feet to a point; thence proceeding North 88 degrees 16 minutes 30 seconds East a distance of 127.78 feet to a point; thence proceeding North 89 degrees 34 minutes 15 seconds East a distance of 187.60 feet to a point; thence proceeding North 14 degrees 15 minutes 00 seconds East a distance of 80.00 feet to the point and place of beginning of the parcel herein described; thence proceeding North 14 degrees 15 minutes 00 seconds East a distance of 121.89 feet to a point; thence proceeding South 55 degrees 45 minutes 00 seconds East a distance of 122.16 feet to a point; thence proceeding North 34 degrees 15 minutes 00 seconds East a distance of 115.30 feet to a point; thence proceeding North 14 degrees 15 minutes 00 seconds East a distance of 121.89 feet to a point; thence proceeding South 55 degrees 45 minutes 00 seconds East a distance of 122.16 feet to a point; thence proceeding North 34 degrees 15 minutes 00 seconds East a distance of 115.30 feet to a point; thence proceeding North 14 degrees 15 minutes 00 seconds East a distance of 121.89 feet to a point; thence proceeding South 55 degrees 45 minutes 00 seconds East a distance of 122.16 feet to a point; thence proceeding North 34 degrees 15 minutes 00 seconds East a distance of 115.30 feet to the point and place of beginning. Said parcel contains 2.4017 acres of land of which 0.4872 acres is dry land and 1.9145 acres is submerged land.

Commencing at the intersection of the south line of Section 3, Lot 1, Firelands Survey, Catawba Island Township, Ottawa County, Ohio, with the centerline of State Route 451; thence proceeding North 31 degrees 49 minutes 00 seconds East on the centerline of said State Route 451 a distance of 131.74 feet to a point; thence proceeding South 70 degrees 30 minutes 30 seconds East a distance of 202.70 feet to a point; thence proceeding North 21 degrees 20 minutes 00 seconds East a distance of 121.17 feet to a point; thence proceeding North 88 degrees 16 minutes 30 seconds East a distance of 127.78 feet to a point; thence proceeding North 89 degrees 34 minutes 15 seconds East a distance of 187.60 feet to a point; thence proceeding North 14 degrees 15 minutes 00 seconds East a distance of 80.00 feet to the point and place of beginning of the parcel herein described; thence proceeding North 14 degrees 15 minutes 00 seconds East a distance of 121.89 feet to a point; thence proceeding South 55 degrees 45 minutes 00 seconds East a distance of 122.16 feet to a point; thence proceeding North 34 degrees 15 minutes 00 seconds East a distance of 115.30 feet to a point; thence proceeding North 14 degrees 15 minutes 00 seconds East a distance of 121.89 feet to a point; thence proceeding South 55 degrees 45 minutes 00 seconds East a distance of 122.16 feet to a point; thence proceeding North 34 degrees 15 minutes 00 seconds East a distance of 115.30 feet to the point and place of beginning. Said parcel contains 2.4017 acres of land of which 0.4872 acres is dry land and 1.9145 acres is submerged land.

The above legal description was prepared by David A. Bruchhorst, Registered Surveyor 68114 and is based on the assumption that the East line of Section 3, Lot 1, Firelands Survey, Catawba Island Township, Ottawa County, Ohio, bears South 70 degrees 00 minutes East.

DECLARATION OF PREPARATION
The undersigned David A. Bruchhorst, Registered Surveyor 68114 and Robert K. McMillan, Registered Surveyor 68114, certify that the foregoing description correctly represents the "Come Sail Away Condominium Phase II"


Witnesses: *David A. Bruchhorst* signed *David A. Bruchhorst*
Robert K. McMillan signed *Robert K. McMillan*

Before me, a Notary Public in and for said County, appeared David A. Bruchhorst, Registered Surveyor 68114 and Robert K. McMillan who acknowledged the signing of the foregoing instrument to be their voluntary act and in view whereof I have affixed my official seal this 22nd day of May 1988.

Witnessed May 22, 1988 - 7:00
Notarized May 16, 1988
John S. Carroll, Attorney at Law



Witnessed May 22, 1988 - 7:00
Notarized May 16, 1988
John S. Carroll, Attorney at Law

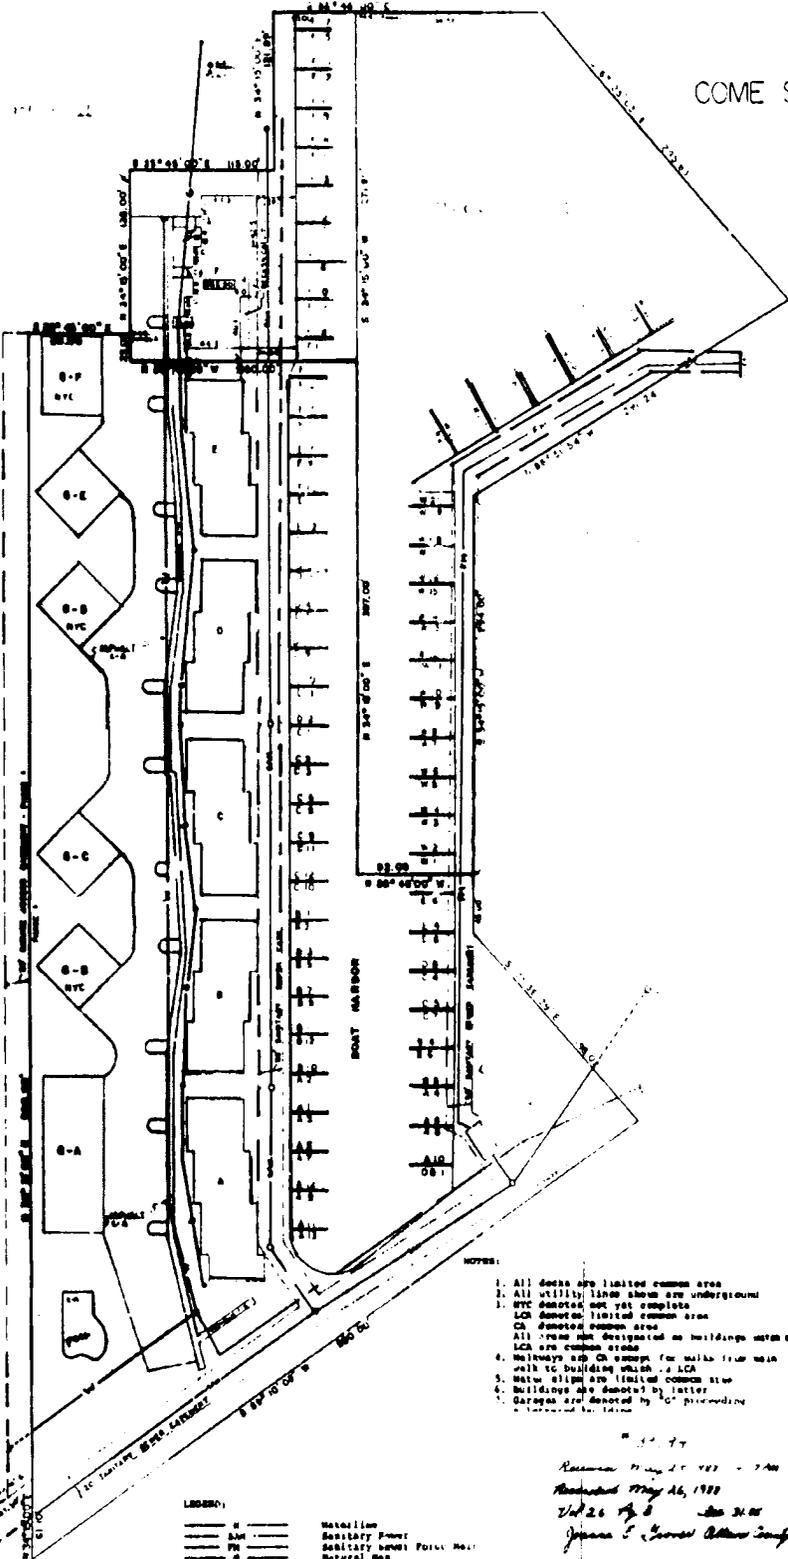

LEGEND:

—	Wall	—	Waterline
—	Slab	—	Sanitary Power
—	Roof	—	Sanitary Sewer
—	Foundation	—	Water
—	—	—	Fire Alarm
—	—	—	First Floor Elevation

We hereby certify that the attached drawings correctly show the exterior elevations of the buildings including type of wall finish, windows, doors, and roof profiles as constructed.

John S. Carroll, AIA
Registered Architect 1499