



# East Pointe at Catawba Bay Condominium Eleventh Amendment

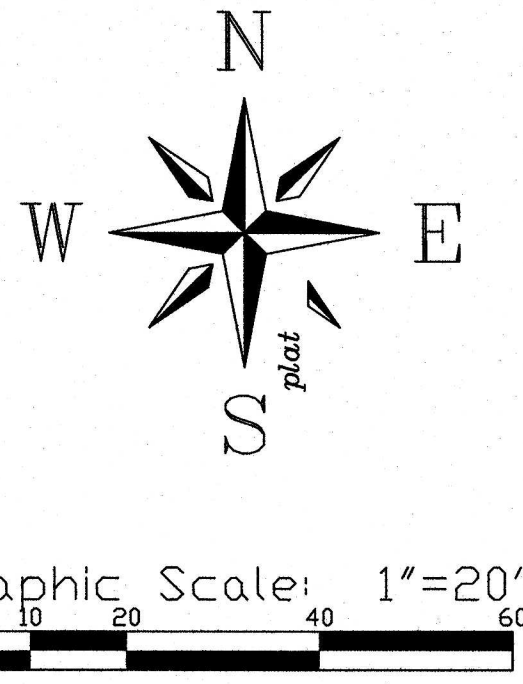


CURVE	Delta	LENGTH	RADIUS	Ch Bearing	Chord
C1	45°57'02"	24.06	30.00	S 50°03'43" E	23.42
C2	87°28'35"	15.27	10.00	S 70°49'30" E	13.83

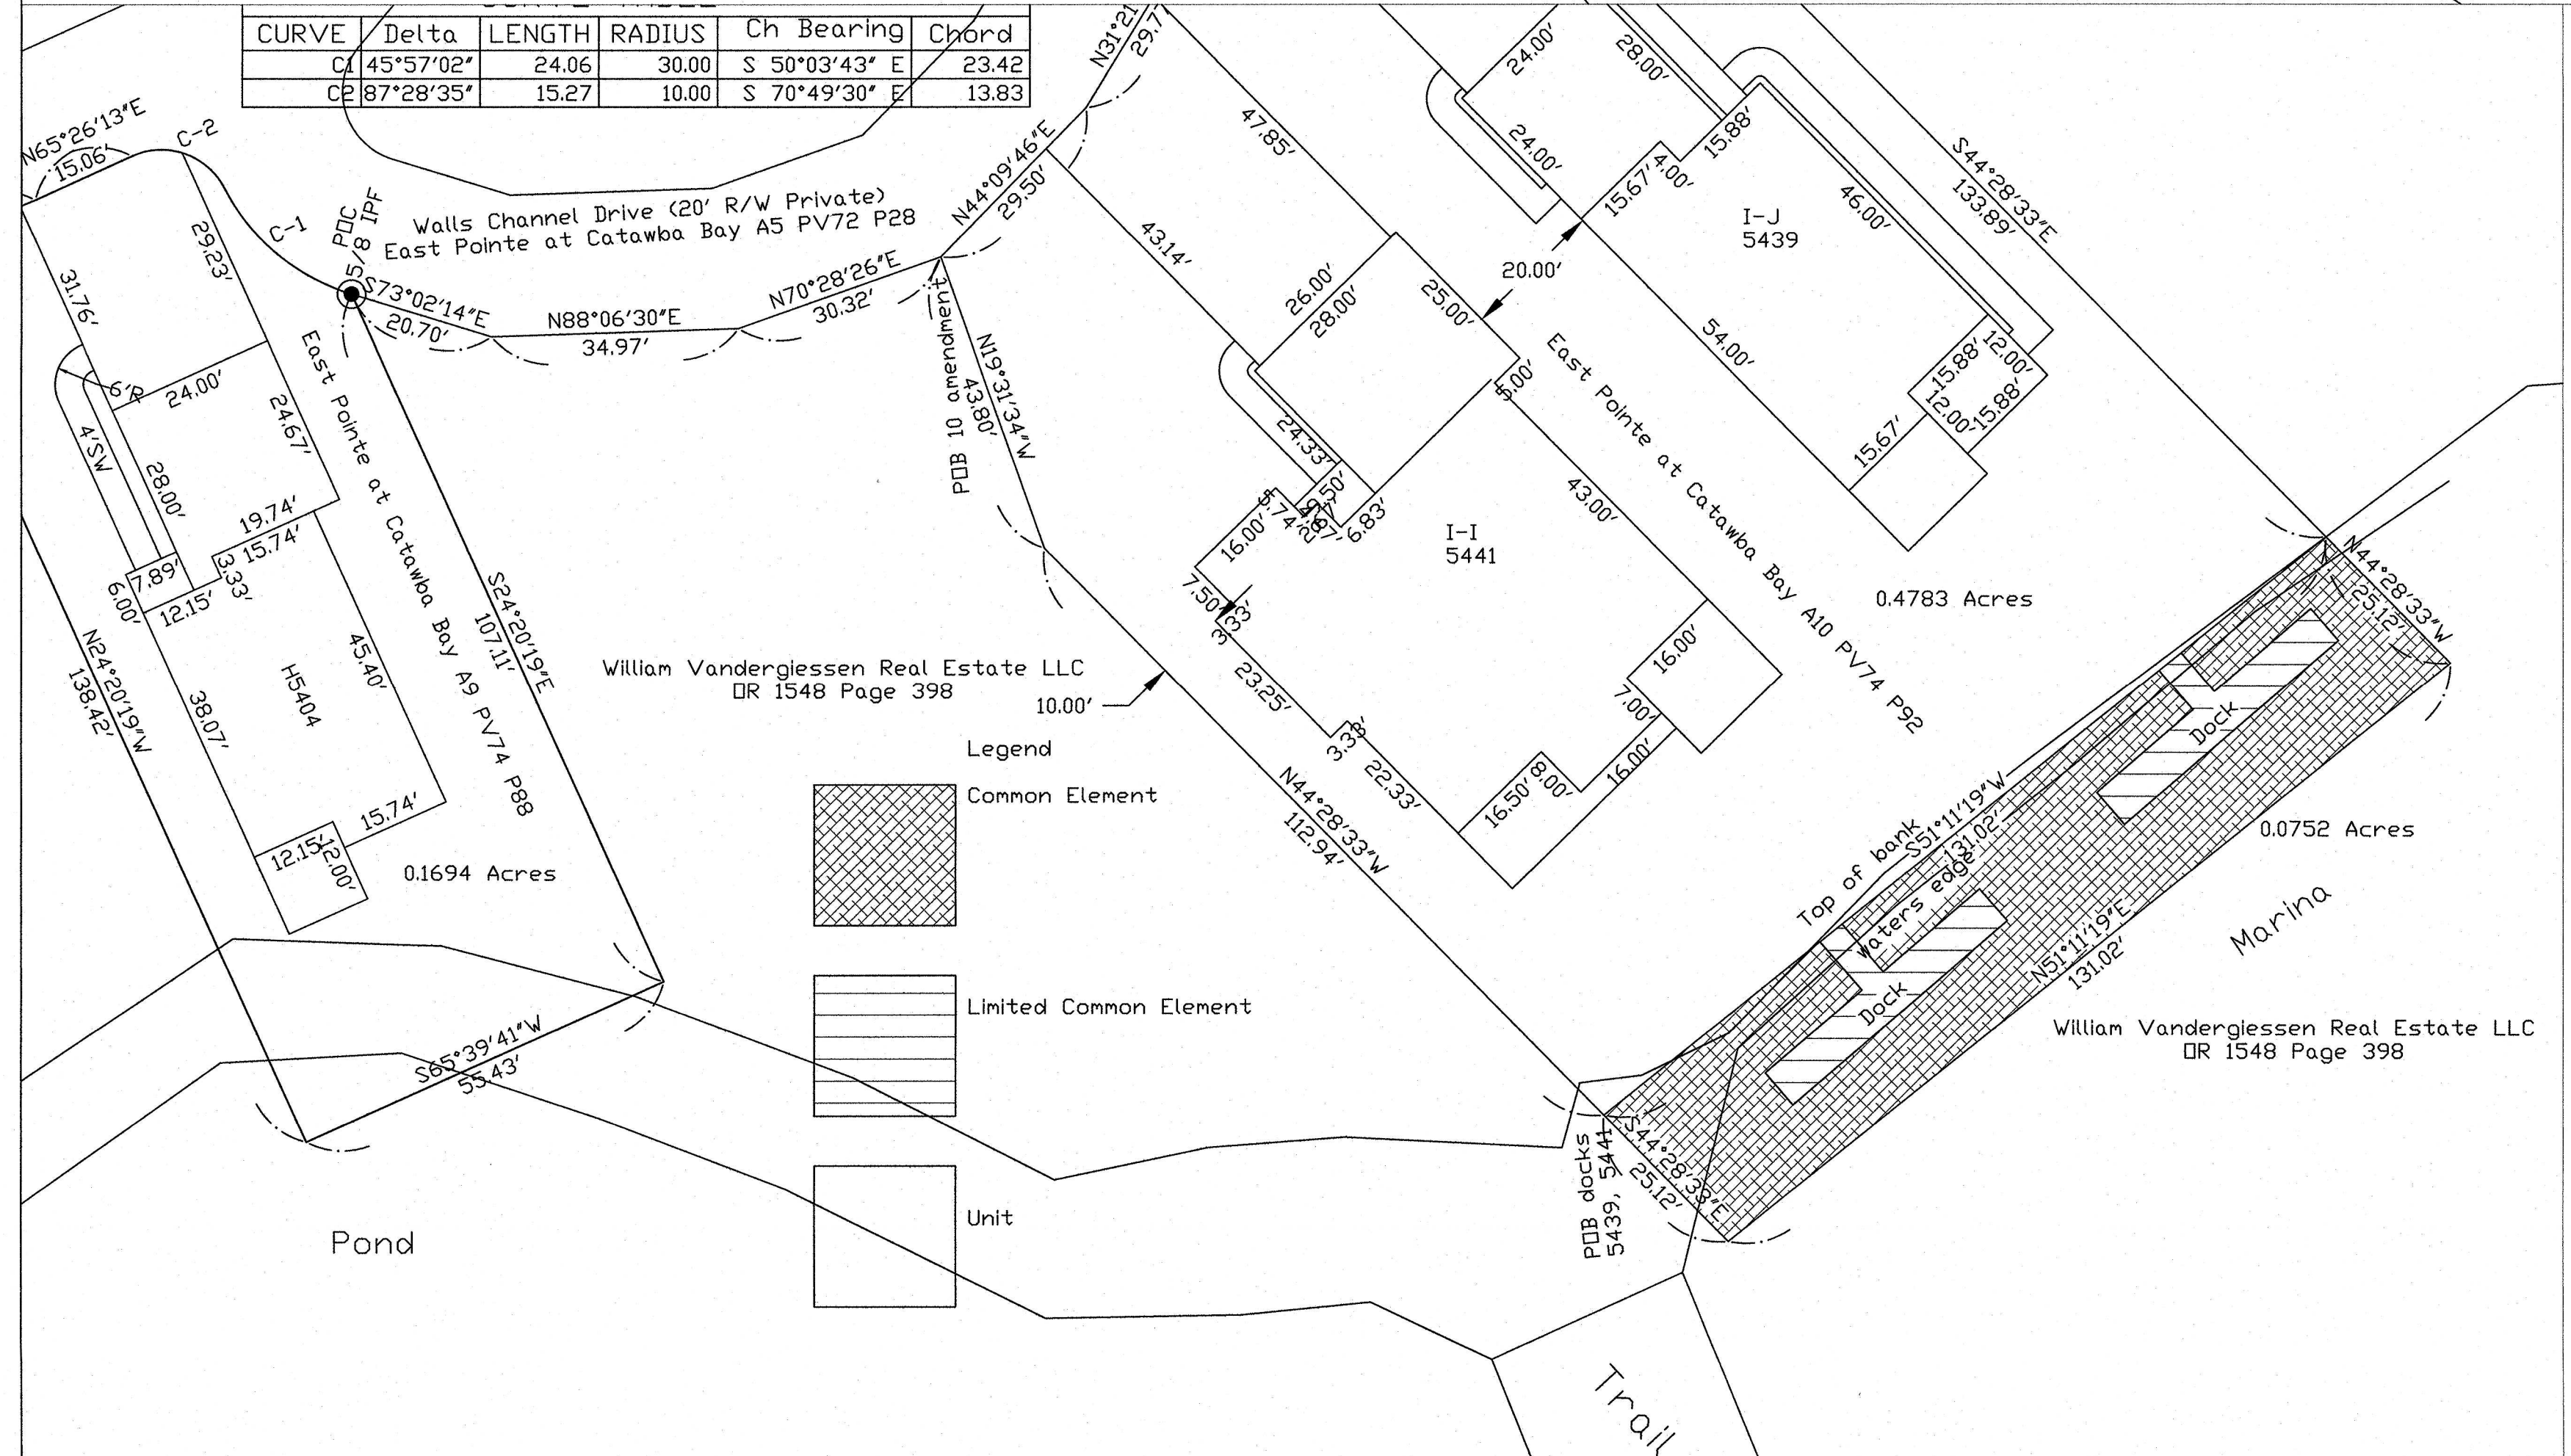

Surveyor's Certification  
I hereby declare that the drawing accurately reflects the location of improvements and recorded easements to the best of my knowledge and belief.

Engineer's Certification  
I hereby declare that the drawing accurately shows each building as built to the best of my knowledge and belief.

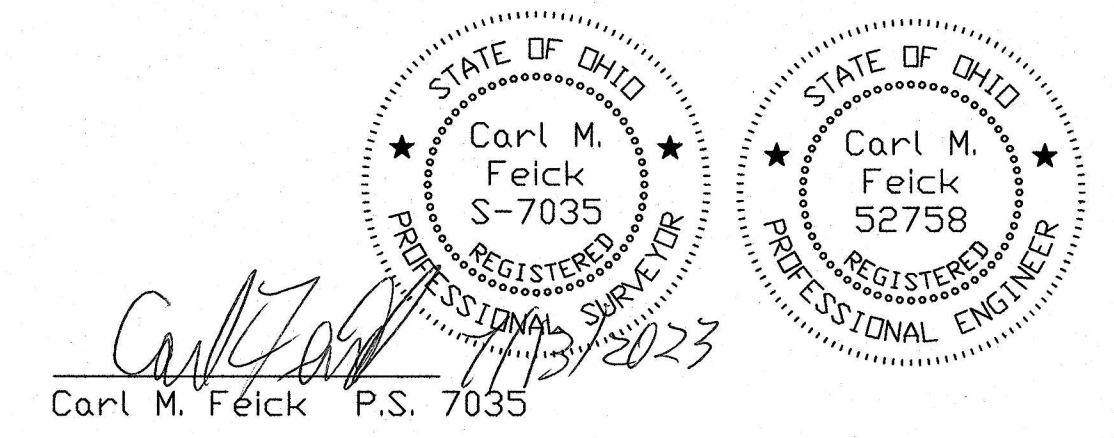

Transferred this 11<sup>th</sup> Day of August 2023.  
 J. Widmer, Ottawa County Auditor  
 Recorded this 18<sup>th</sup> Day of August 2023.  
 Nathan J. Daniels, Ottawa County Recorder

**CARL M FEICK, P.E. P.S.**  
 712 Bardwell Road, Castalia, Ohio 44824, 419-656-3016  
 DRAWN BY: CMF DATE: 07/12/2023  
 JOB NO.: EPACB SHEET 1 OF 2  
**Eleventh Amendment**  
 East Pointe at Catawba Bay Condominium  
 5411 Walls Channel Drive  
 Section 3 Lot 1 Firelands  
 Catawba Island Twp, Ottawa Co, Ohio