


East Pointe at Catawba Bay Condominium Sixth Amendment

Green space

VOL 74 PG 9

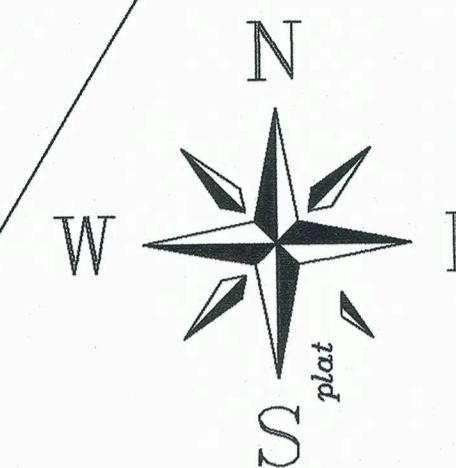

Graphic Scale: 1"=20'
0 10 20 40 60

Legend

- Common Element
- Limited Common Element
- Unit

V-V
5379
5381

U-U
5389
5391

T-T
5399
5401

I-I
5441

H-H
5400
5404

Clubhouse

William Vandergiesen Real Estate LLC
OR 1548 Page 398

G-G
5390
5394

Pond

William Vandergiesen Real Estate LLC
OR 1548 Page 398

E-E
5370
5374

Surveyor's Certification
I hereby declare that the drawing accurately reflects the location of improvements and recorded easements to the best of my knowledge and belief.

Engineer's Certification
I hereby declare that the drawing accurately shows each building as built to the best of my knowledge and belief.



Carl M. Feick P.S. 7035

C-C
5350
5354

Transferred this 19th Day of January, 2022.
J. Widmer / K. Foust Dep.
Ottawa County Auditor

Recorded this 19th Day of January, 2022.
Malinda J. Daniels
Ottawa County Recorder

Inst# 2022-314510
v 74 pg 9-11
#247.80 11:45am

CARL M FEICK, P.E. P.S.
712 Bardwell Road, Castalia, Ohio 44824, 419-656-3016

DRAWN BY: CMF DATE: 1/6/2022
JOB NO.: EPACB SHEET 1 OF 1

Sixth Amendment

East Pointe at Catawba Bay Condominium
5380, 5384 Pintail Drive
Section 3 Lot 1 Firelands
Catawba Island Twp, Ottawa Co, Ohio

