
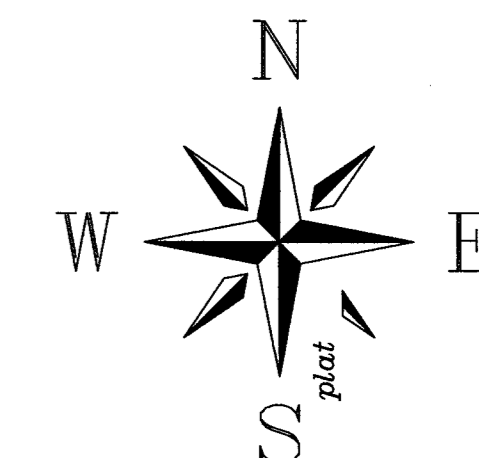



East Pointe at Catawba Bay Condominium Seventh Amendment

VOL 74 PG 24

Legend

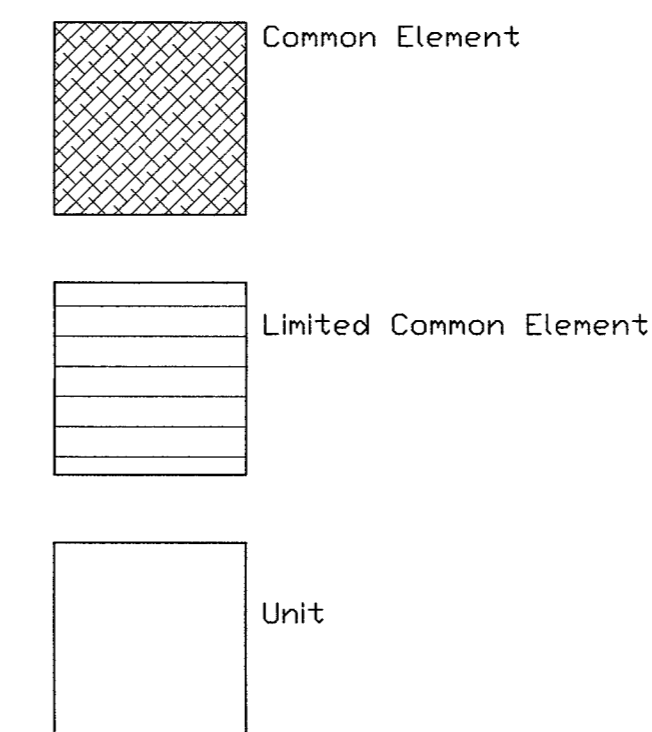

Graphic Scale: 1"=20'
0 10 20 40 60

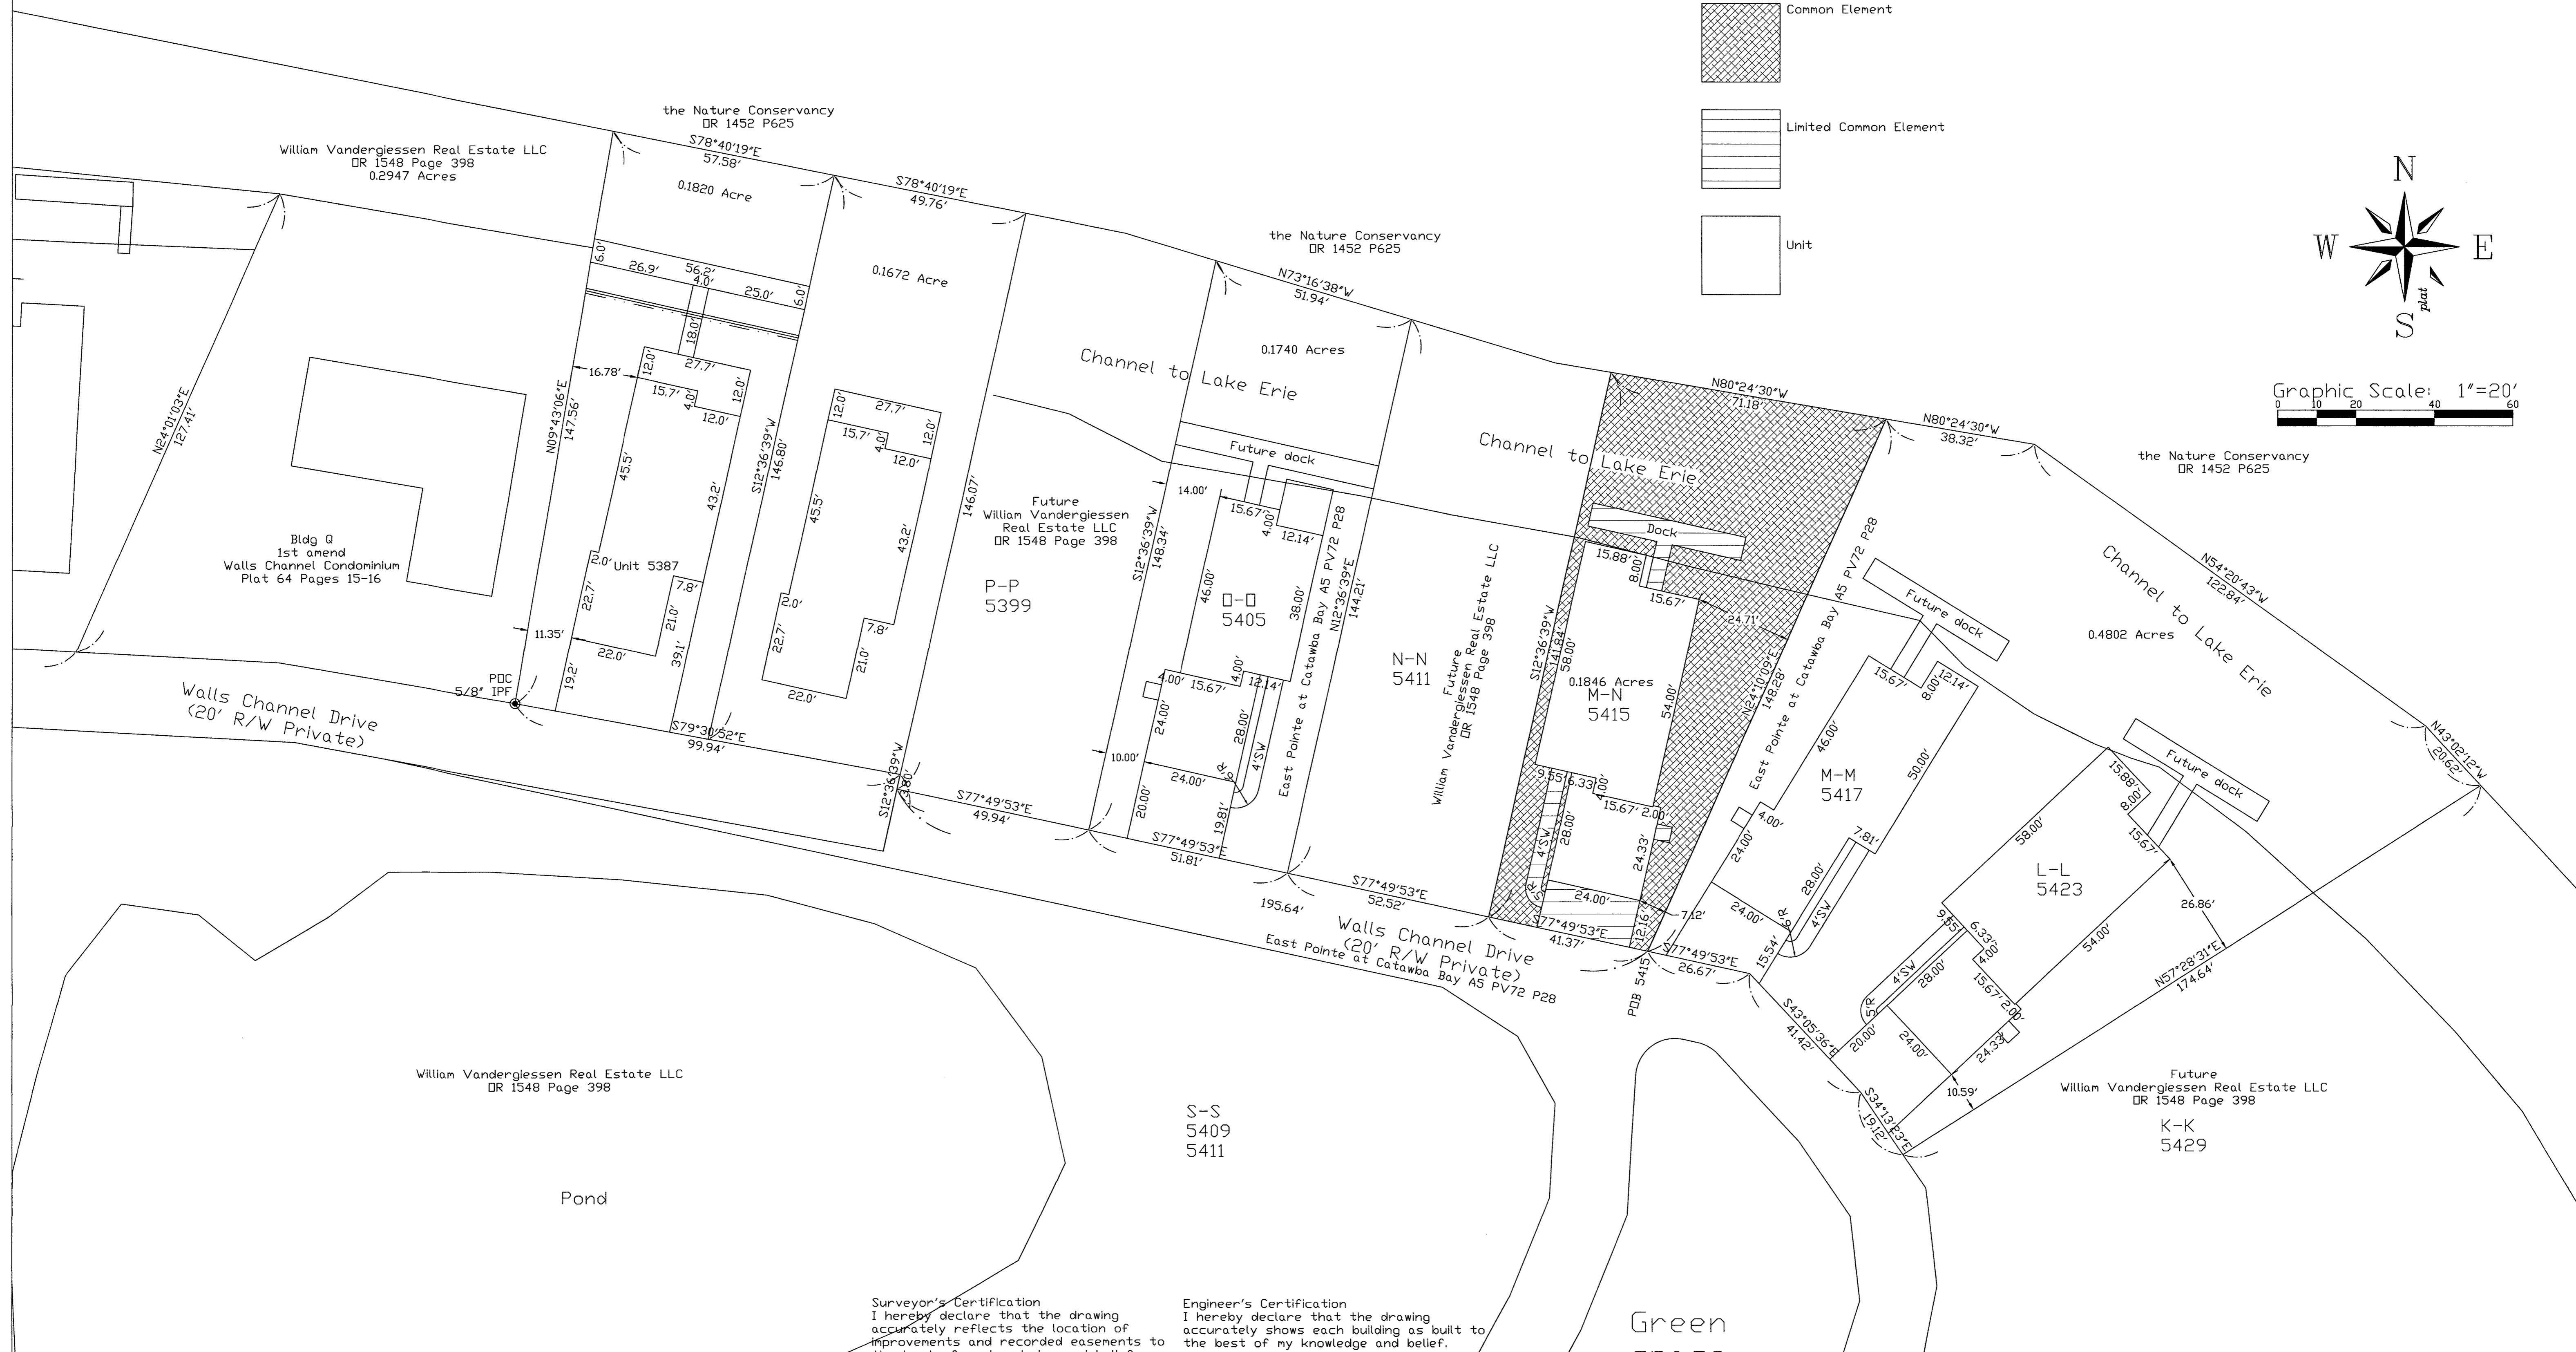

Surveyor's Certification
I hereby declare that the drawing accurately reflects the location of improvements and recorded easements to the best of my knowledge and belief.

Engineer's Certification
I hereby declare that the drawing accurately shows each building as built to the best of my knowledge and belief.

STATE OF OHIO
Carl M. Feick
S-7035
REGISTERED PROFESSIONAL SURVEYOR

STATE OF OHIO
Carl M. Feick
52758
REGISTERED PROFESSIONAL ENGINEER

Carl M. Feick P.S. 7035

Transferred this 2nd Day of June 2022.
J. Widmer/K. Fouat
Ottawa County Auditor

Recorded this 2nd Day of June 2022.
Inst # 2022-318093
PL vol 74 pg 24-25
12:11:43 PM #148.50
Ottawa County Recorder

CARL M FEICK, P.E. P.S.
712 Bardwell Road, Castalia, Ohio 44824, 419-656-3016

DRAWN BY: CMF DATE: 5/19/2022
JOB NO.: EPACB SHEET 1 OF 1

Seventh Amendment
East Pointe at Catawba Bay Condominium
5415 Pintail Drive
Section 3 Lot 1 Firelands
Catawba Island Twp, Ottawa Co, Ohio