
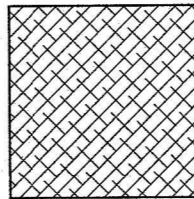
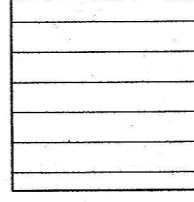
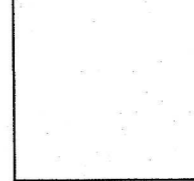


# East Pointe at Catawba Bay Condominium Eighth Amendment

**VOL 74 PG 31**

**Legend**

-  Common Element
-  Limited Common Element
-  Unit


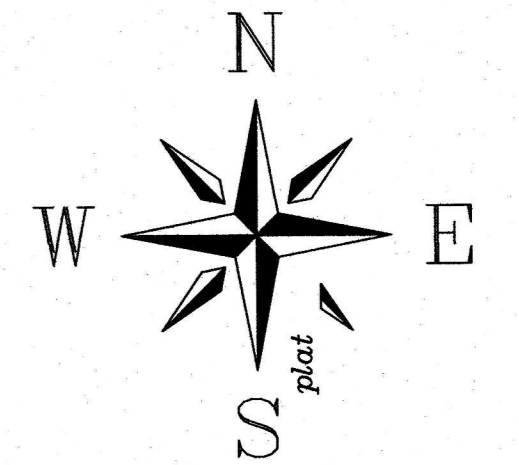


Graphic Scale: 1"=20'  
0 10 20 40 60



Surveyor's Certification  
I hereby declare that the drawing accurately reflects the location of improvements and recorded easements to the best of my knowledge and belief.

Engineer's Certification  
I hereby declare that the drawing accurately shows each building as built to the best of my knowledge and belief.

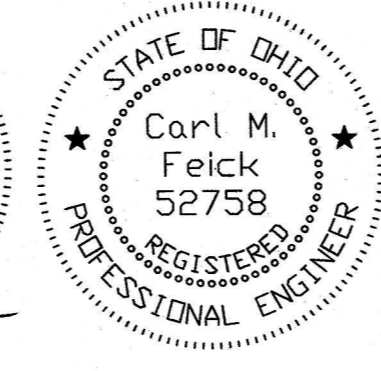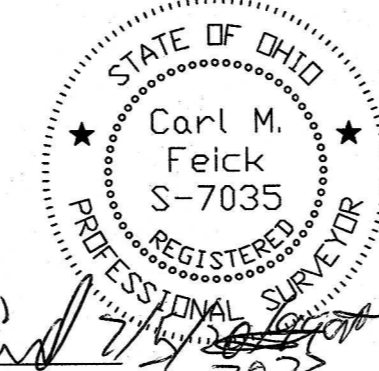

Carl M. Feick P.S. 7035 2022

Transferred this 12<sup>th</sup> Day of July 2022.  
*Jennifer Williams*  
 Ottawa County Auditor  
 Recorded this 12<sup>th</sup> Day of July 2022.  
*Nathaniel Davis*  
 Ottawa County Recorder  
 #319097  
 2:39pm \$145.00  
 v74 pg 31-32

**CARL M FEICK, P.E. P.S.**  
 712 Barclay Road, Castalia, Ohio 44824, 419-656-3016

DRAWN BY: CMF DATE: 6/27/2022  
 JOB NO.: EPACB SHEET 1 OF 1

**Eighth Amendment**  
 East Pointe at Catawba Bay Condominium  
 5415 Pintail Drive  
 Section 3 Lot 1 Firelands  
 Catawba Island Twp, Ottawa Co, Ohio