




Foundation Plan

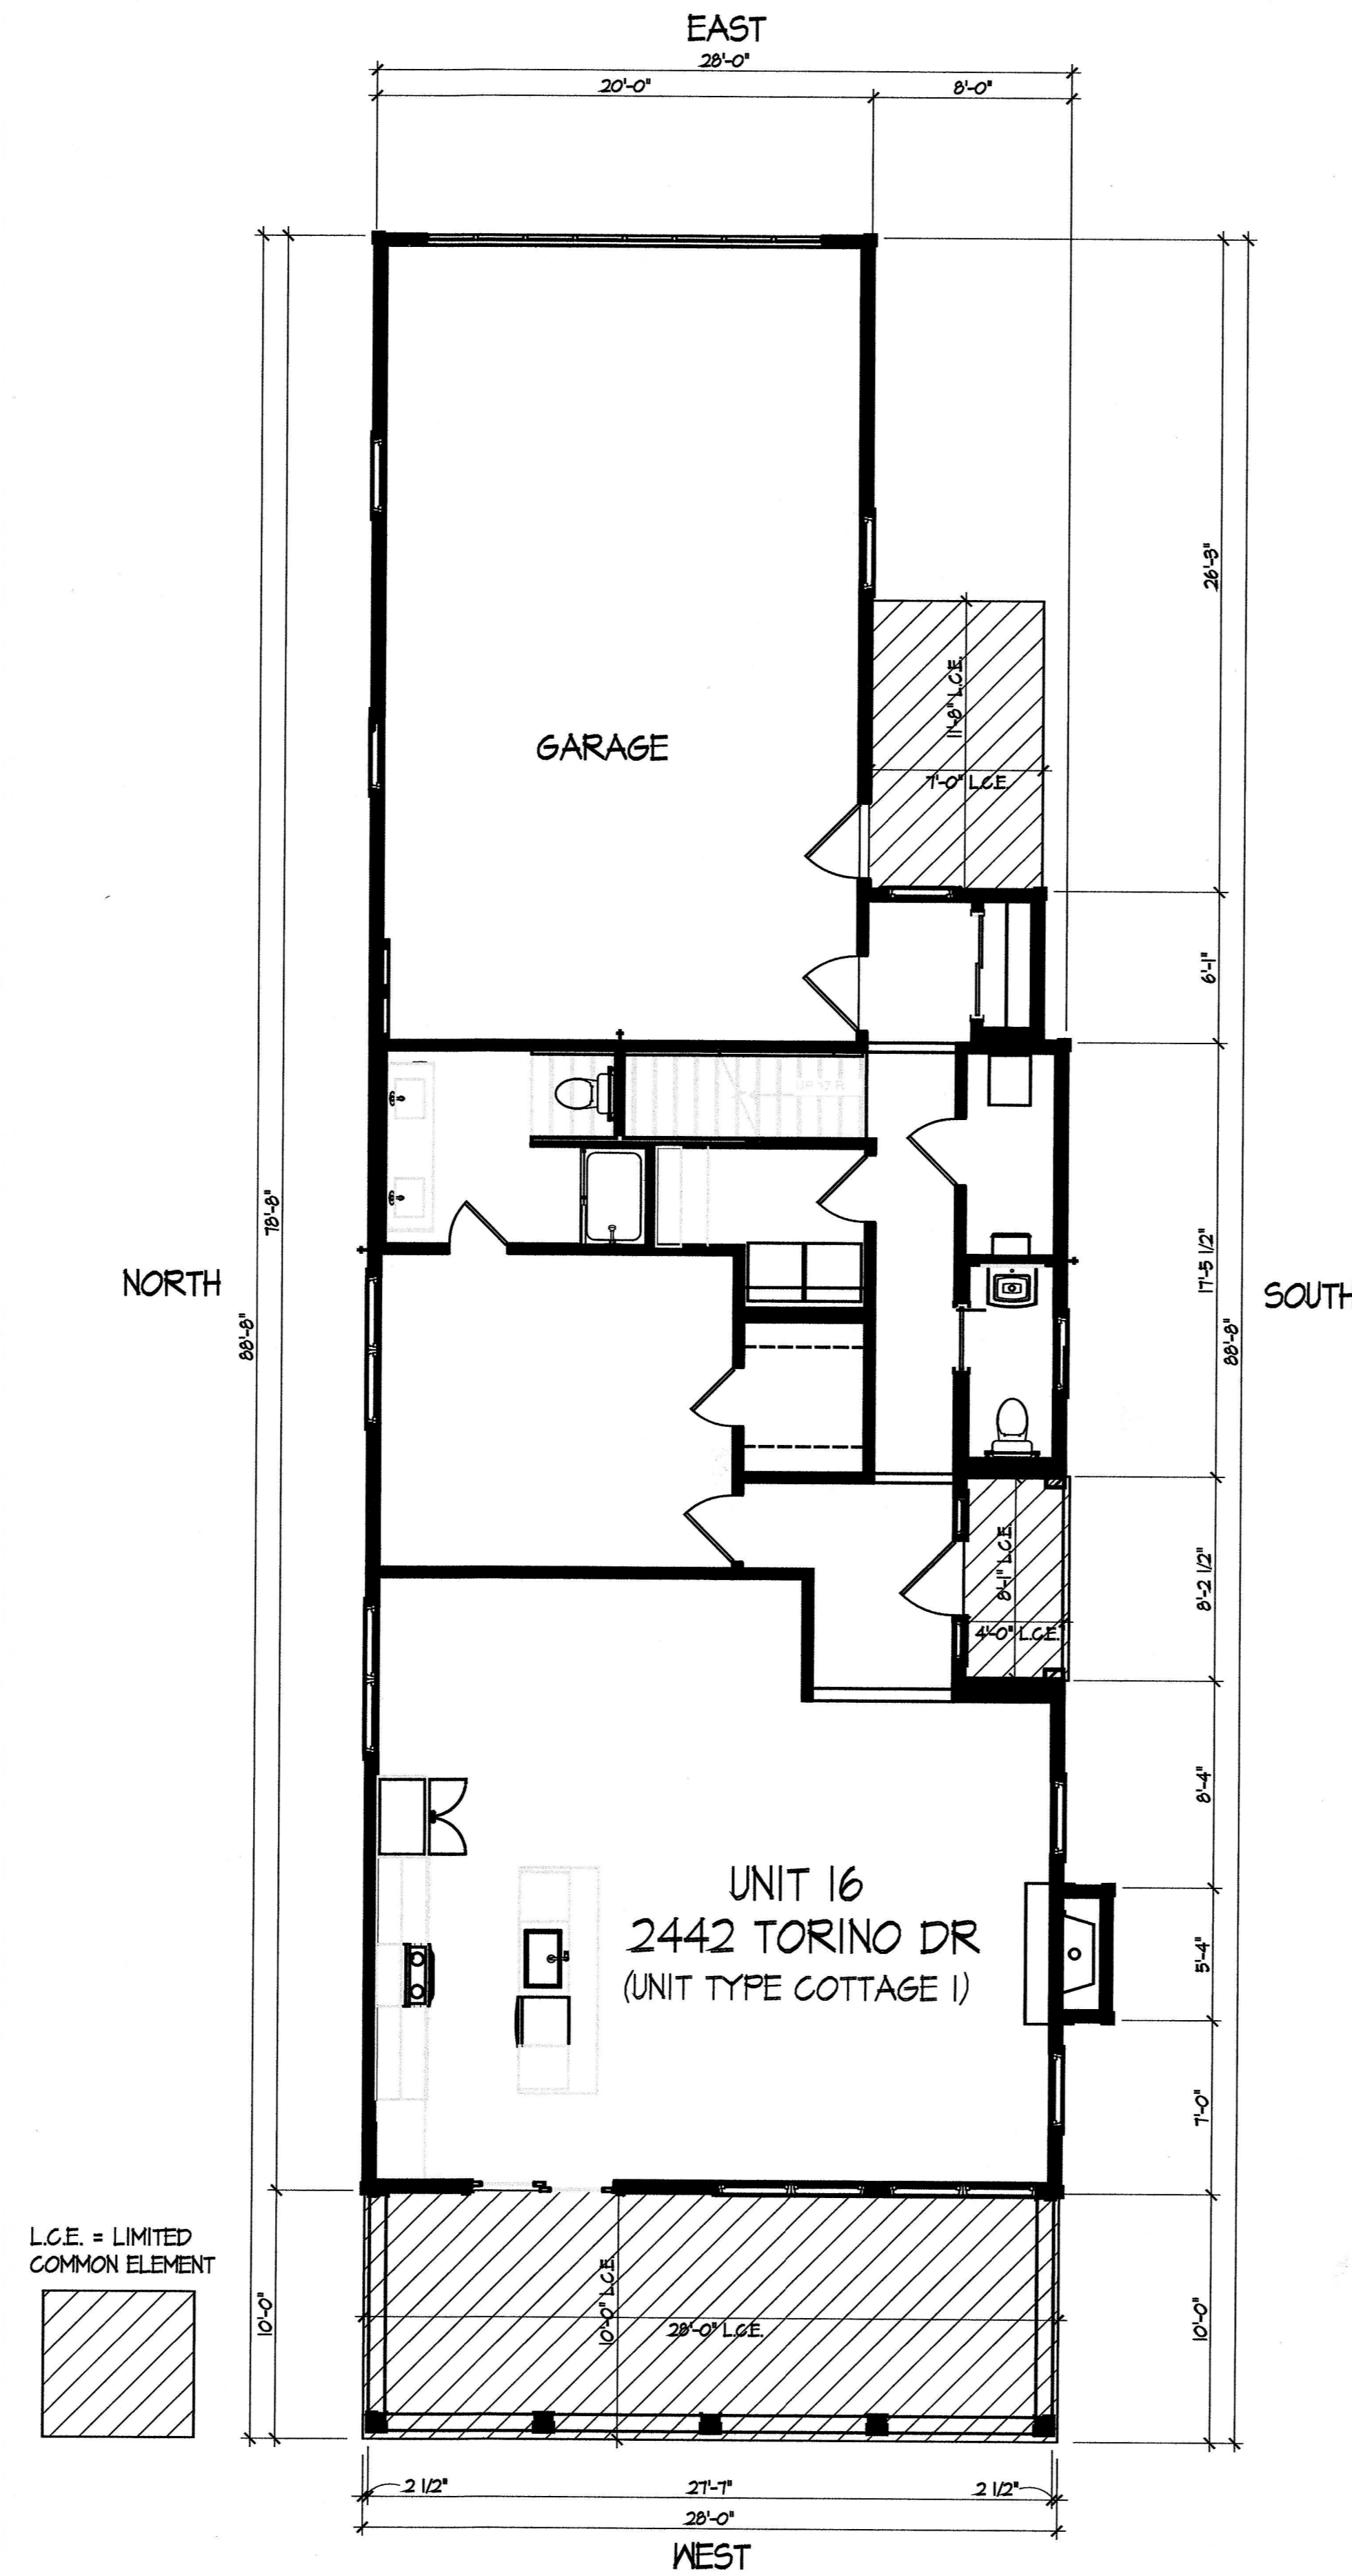

First Floor Plan

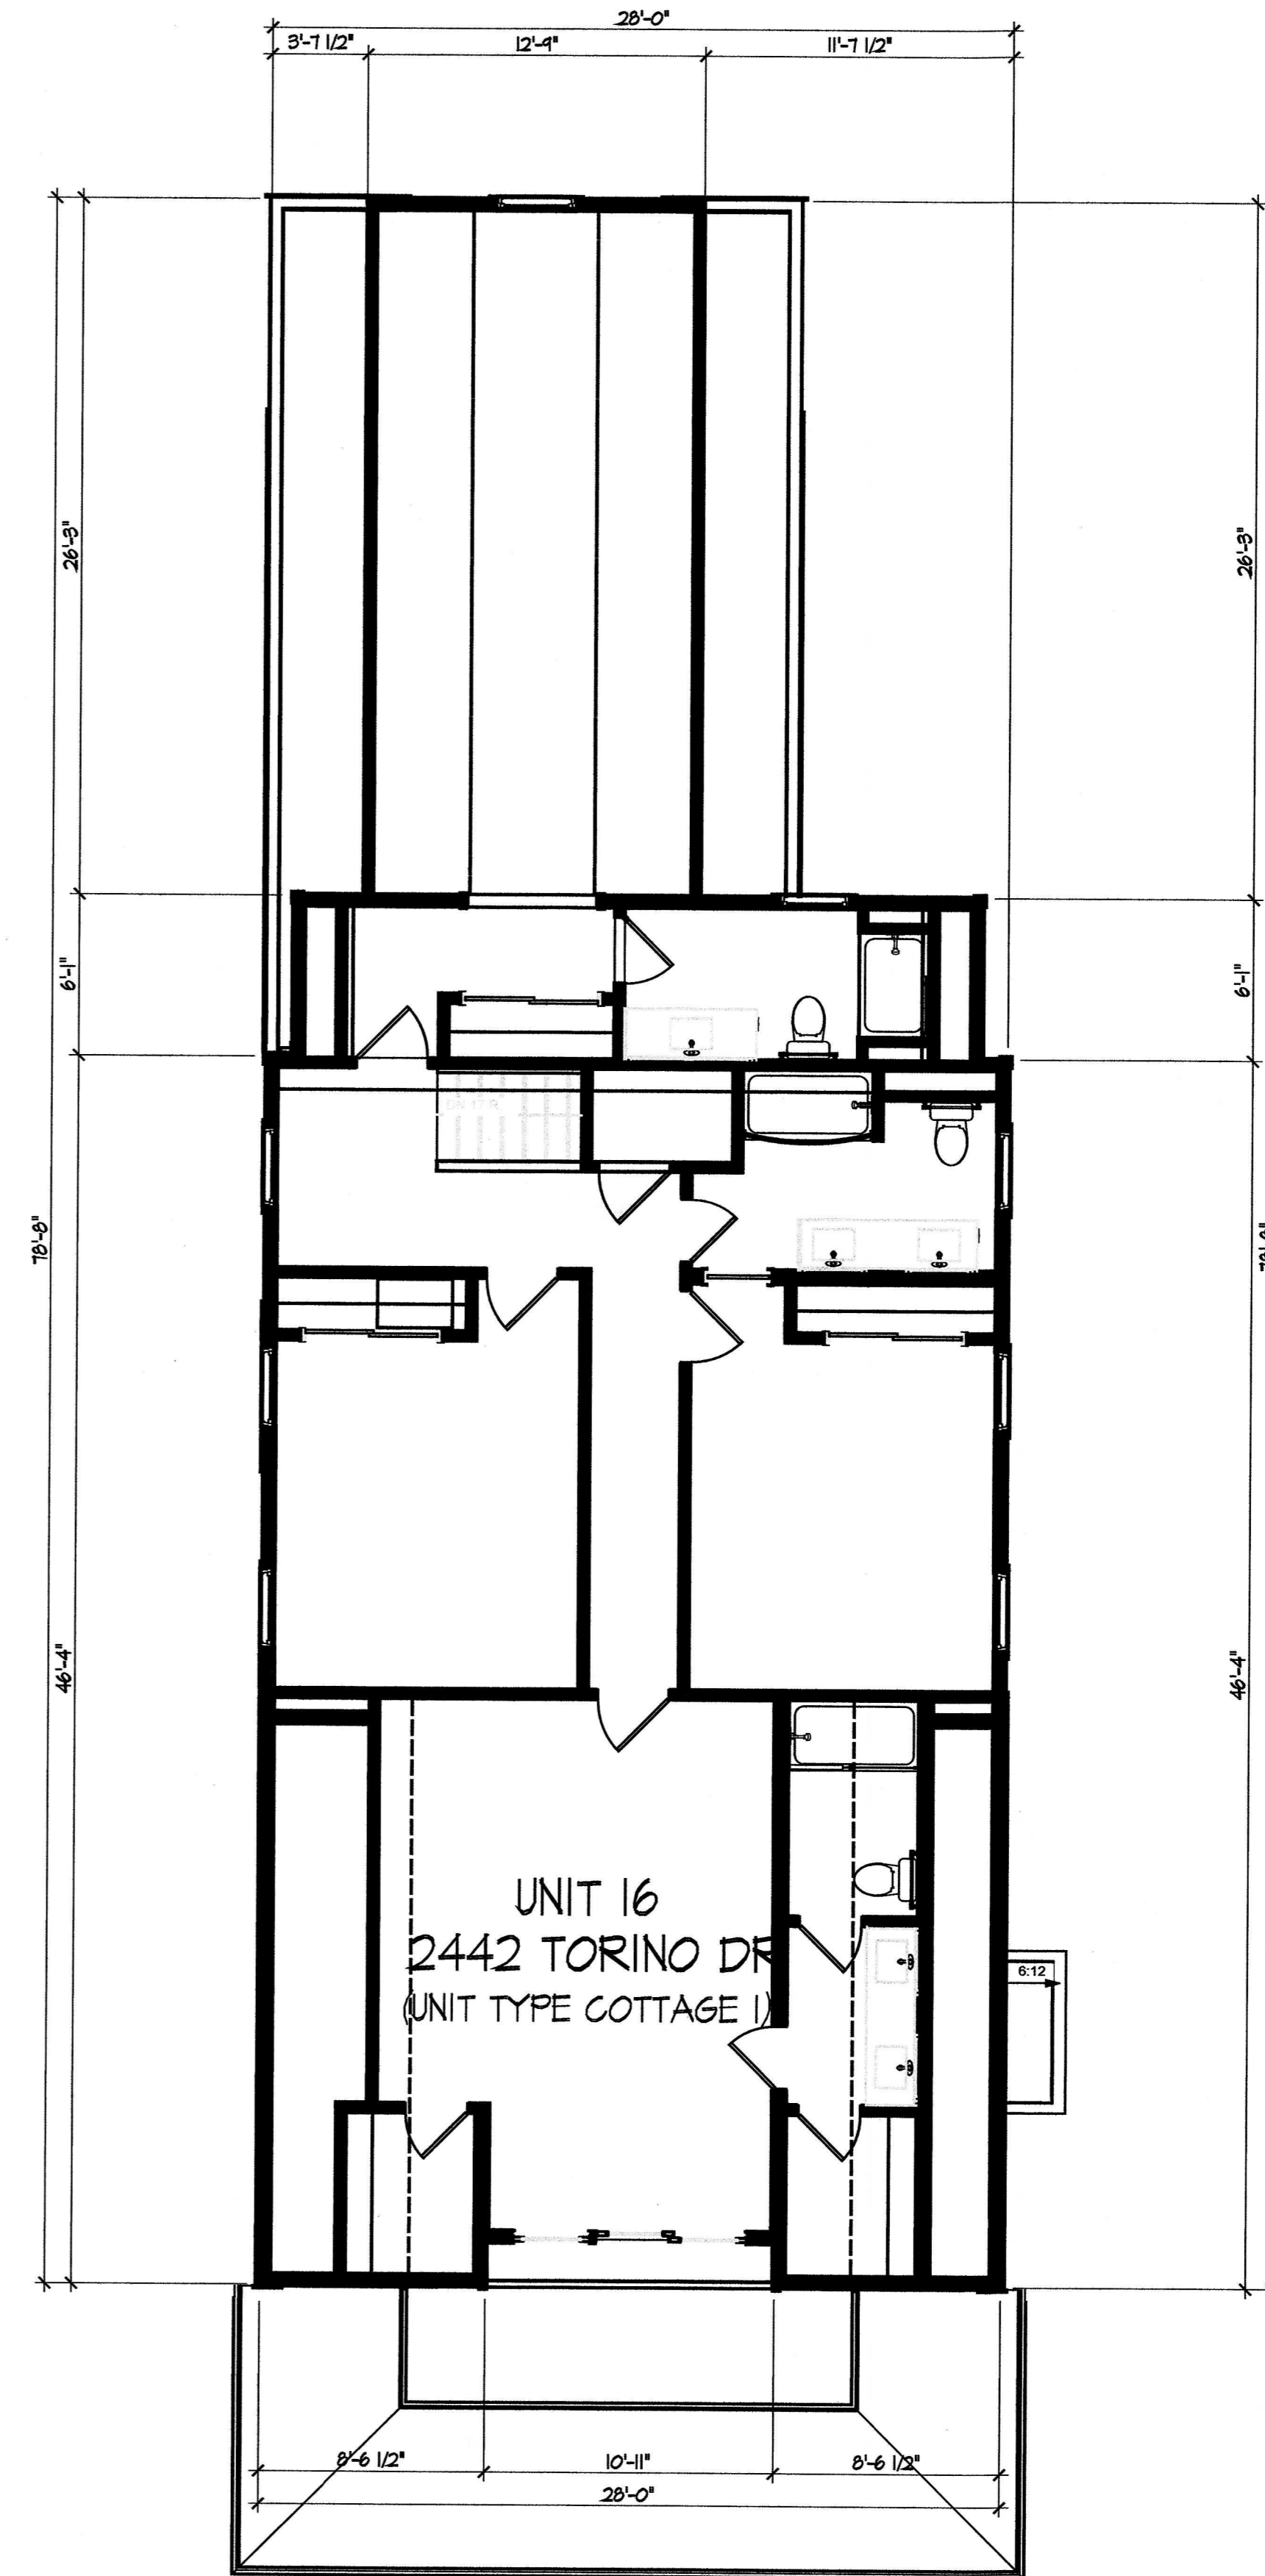

Second Floor Plan

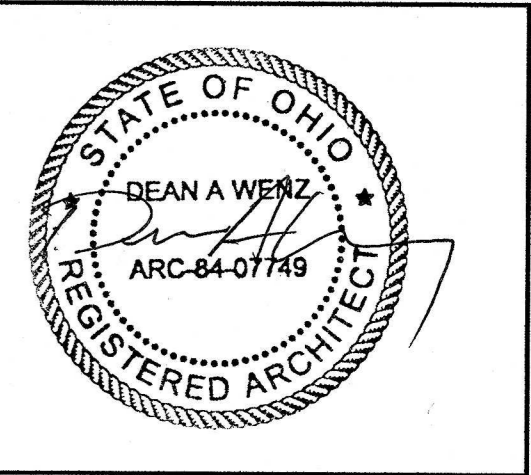

DEAN A. WENZ
ARCHITECTS

2463 E. MAIN STREET
BEXLEY, OHIO 43209
(614) 239-6868
FAX (614) 239-9868

Fairway Cottages at Catawba Island Club
Documentation Drawings
Second Amendment

Architect Project Number
2020-046A

Sheet Number
3 of 14



EAST

- 2nd Flr Ceiling Ht
18'-9"
- 2nd Flr Window Ht
17'-7 7/8"
- Second Floor
10'-7 7/8"
- 1st Flr Ceiling Ht
9'-1 1/8"
- 1st Flr Window Ht
7'-0"
- First Floor
0'-0"



UNIT 16
2442 TORINO DR
(UNIT TYPE COTTAGE 1)

- Bedrm 5 Clg. Ht
17'-5"
- Bedroom 5 Flr
9'-3 7/8"
- 1st Flr Entry/Garage Clg Ht
8'-1 1/8"
- 1st Flr Window Ht
7'-0"
- First Floor
0'-0"



WEST



NORTH

Elevations


DEAN A. WENZ
ARCHITECTS

2463 E. MAIN STREET
BEXLEY, OHIO 43209
(614) 239-6868
FAX (614) 239-9868


Fairway Cottages at Catawba Island Club
Documentation Drawings
Second Amendment

Architect Project Number
2020-046A


Sheet Number
4 of 14

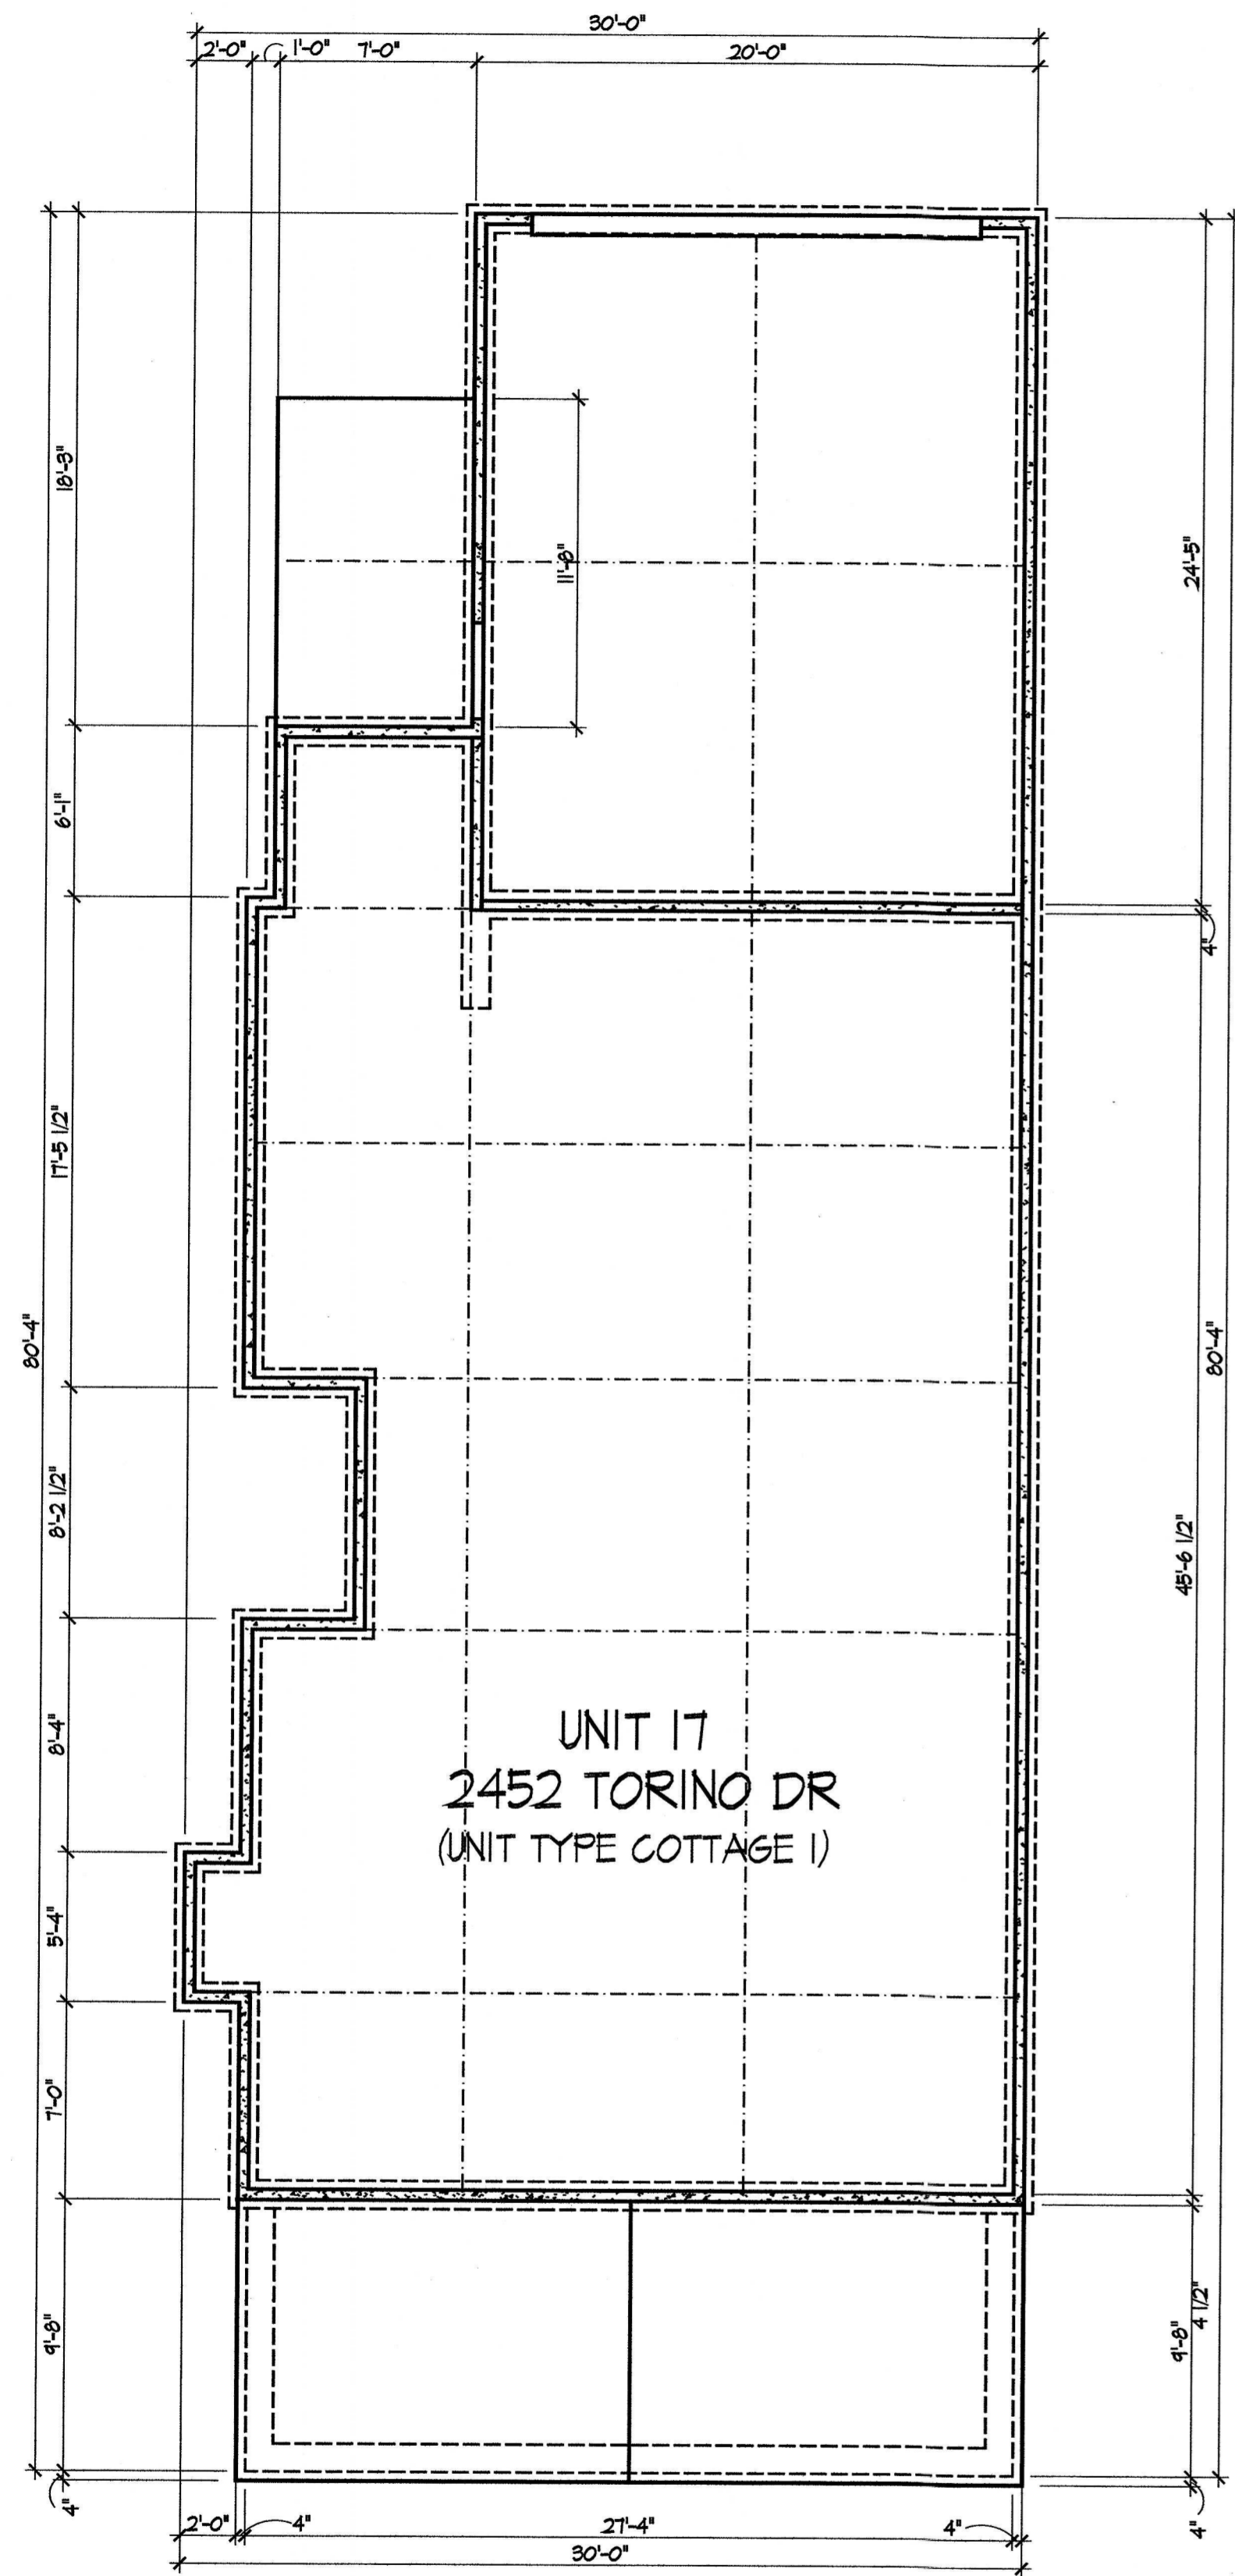


Foundation Plan

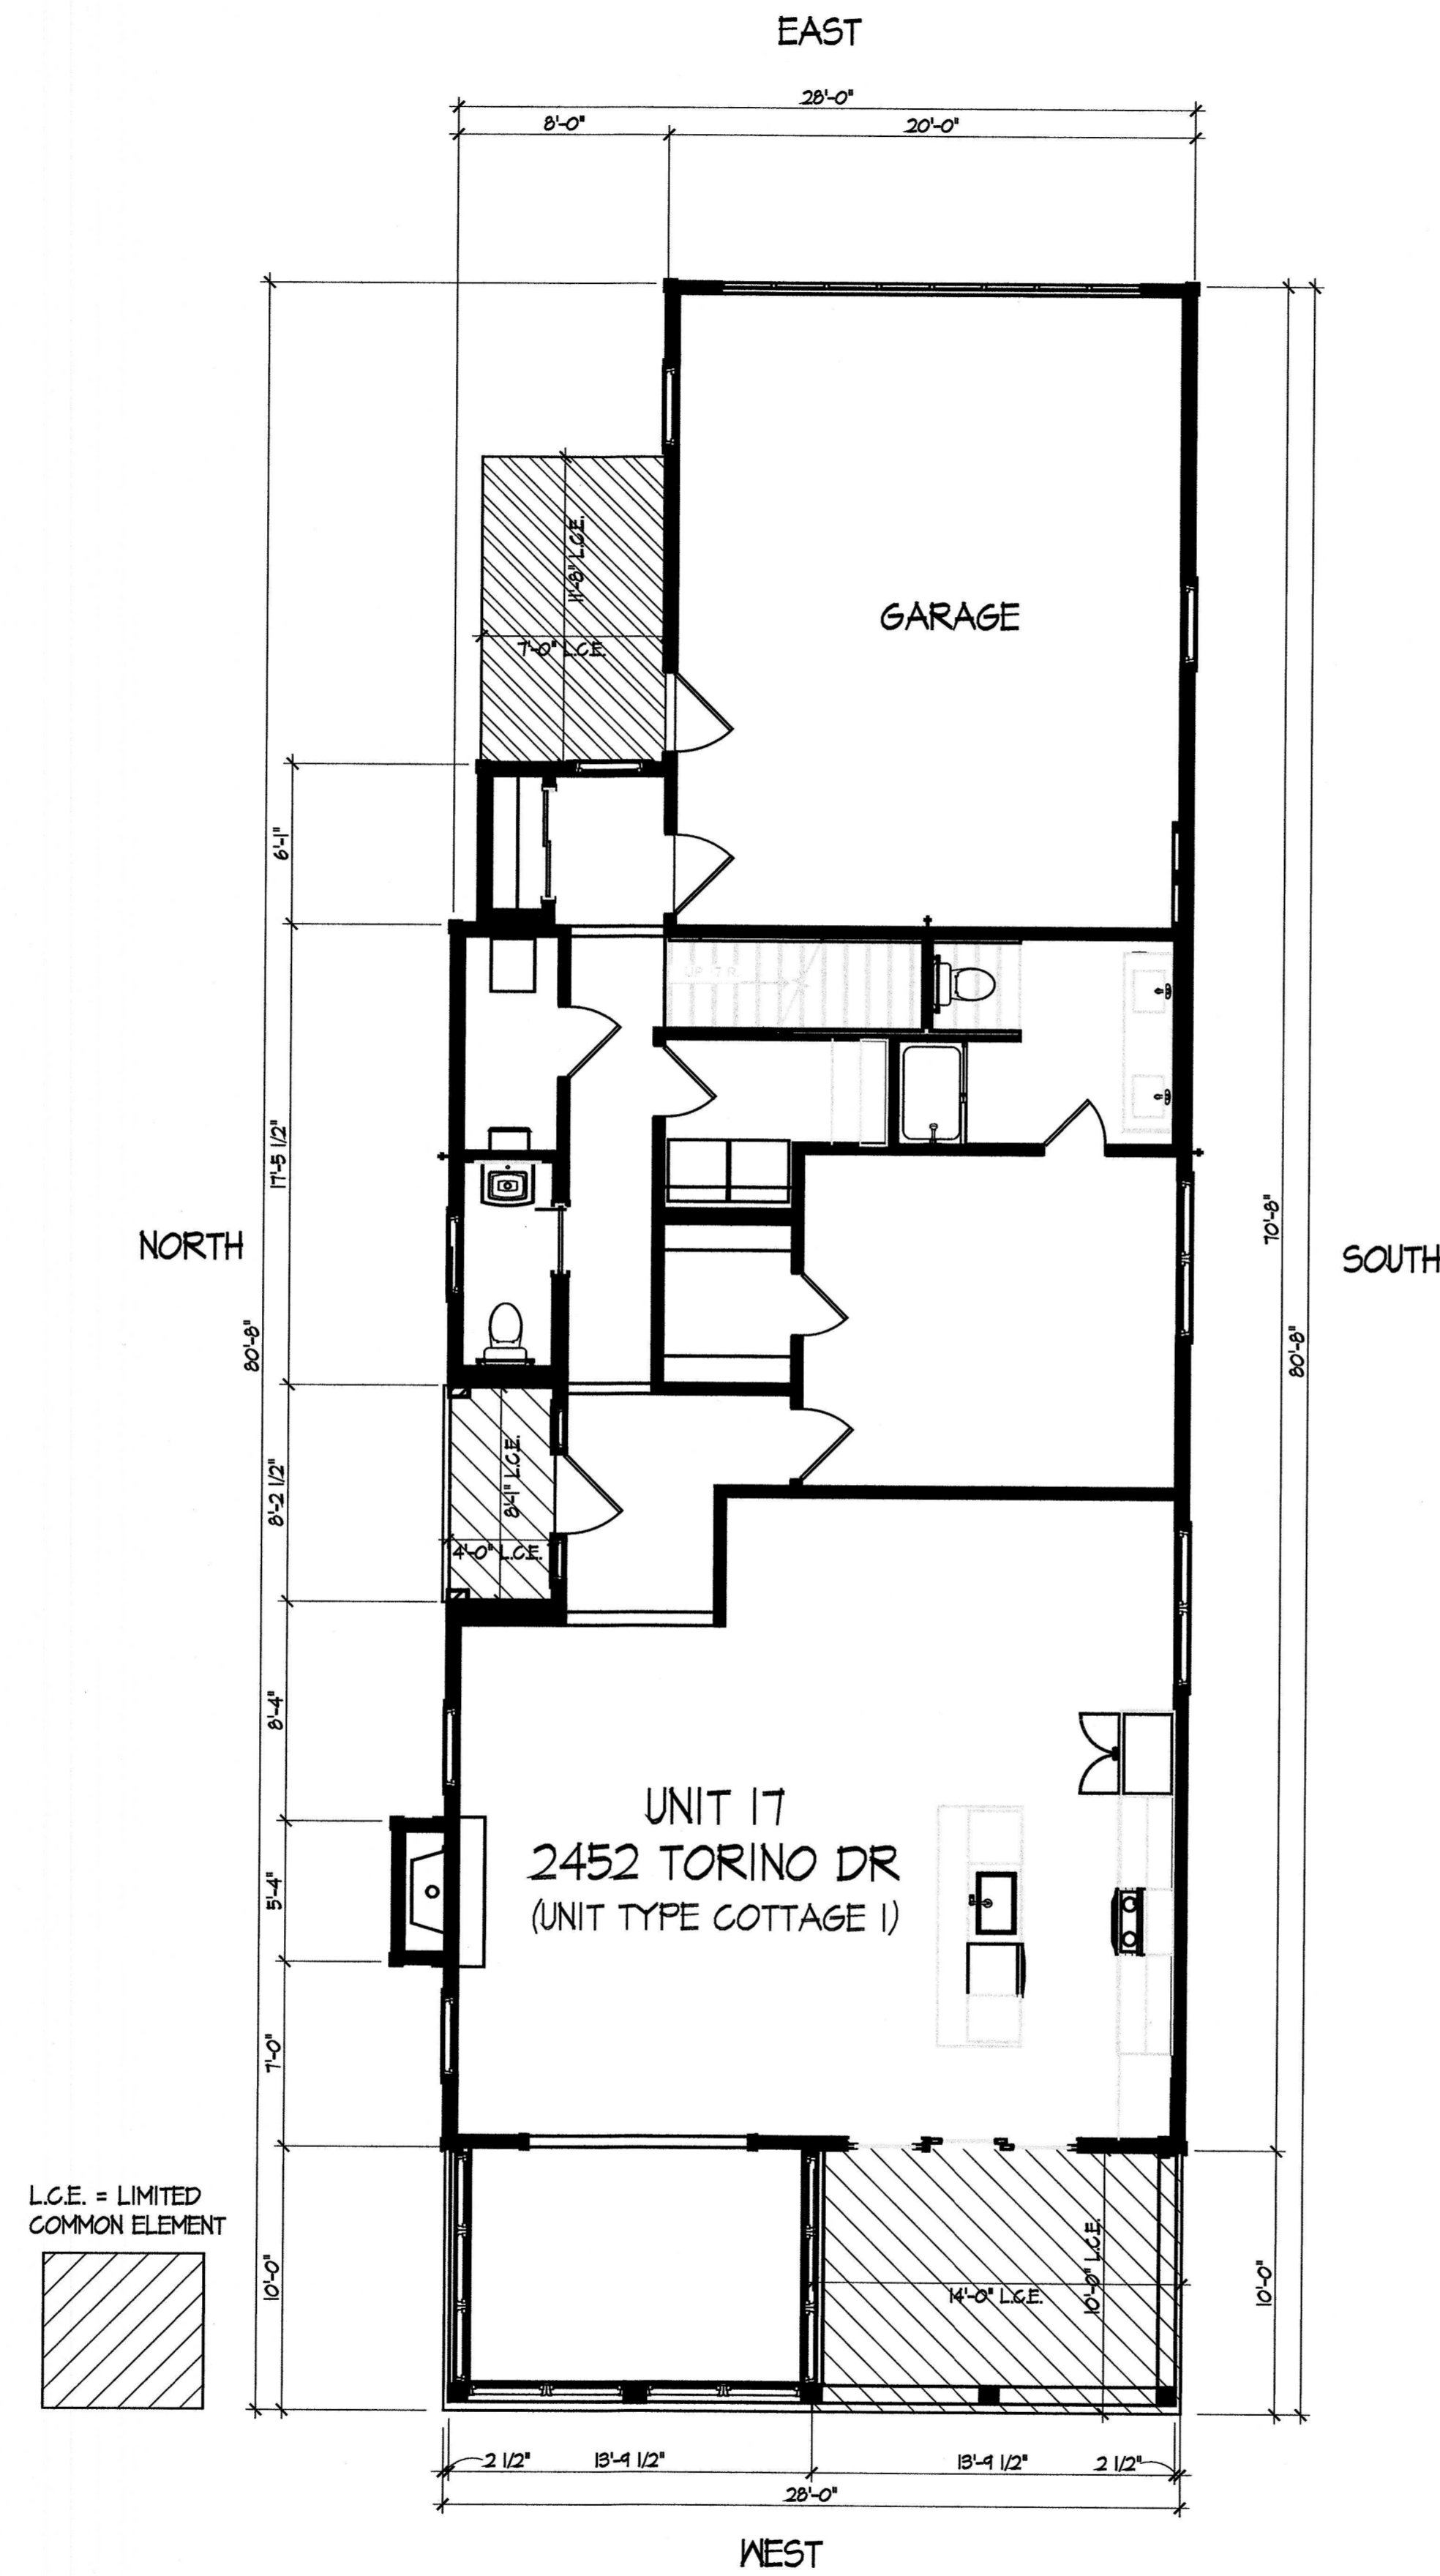

First Floor Plan

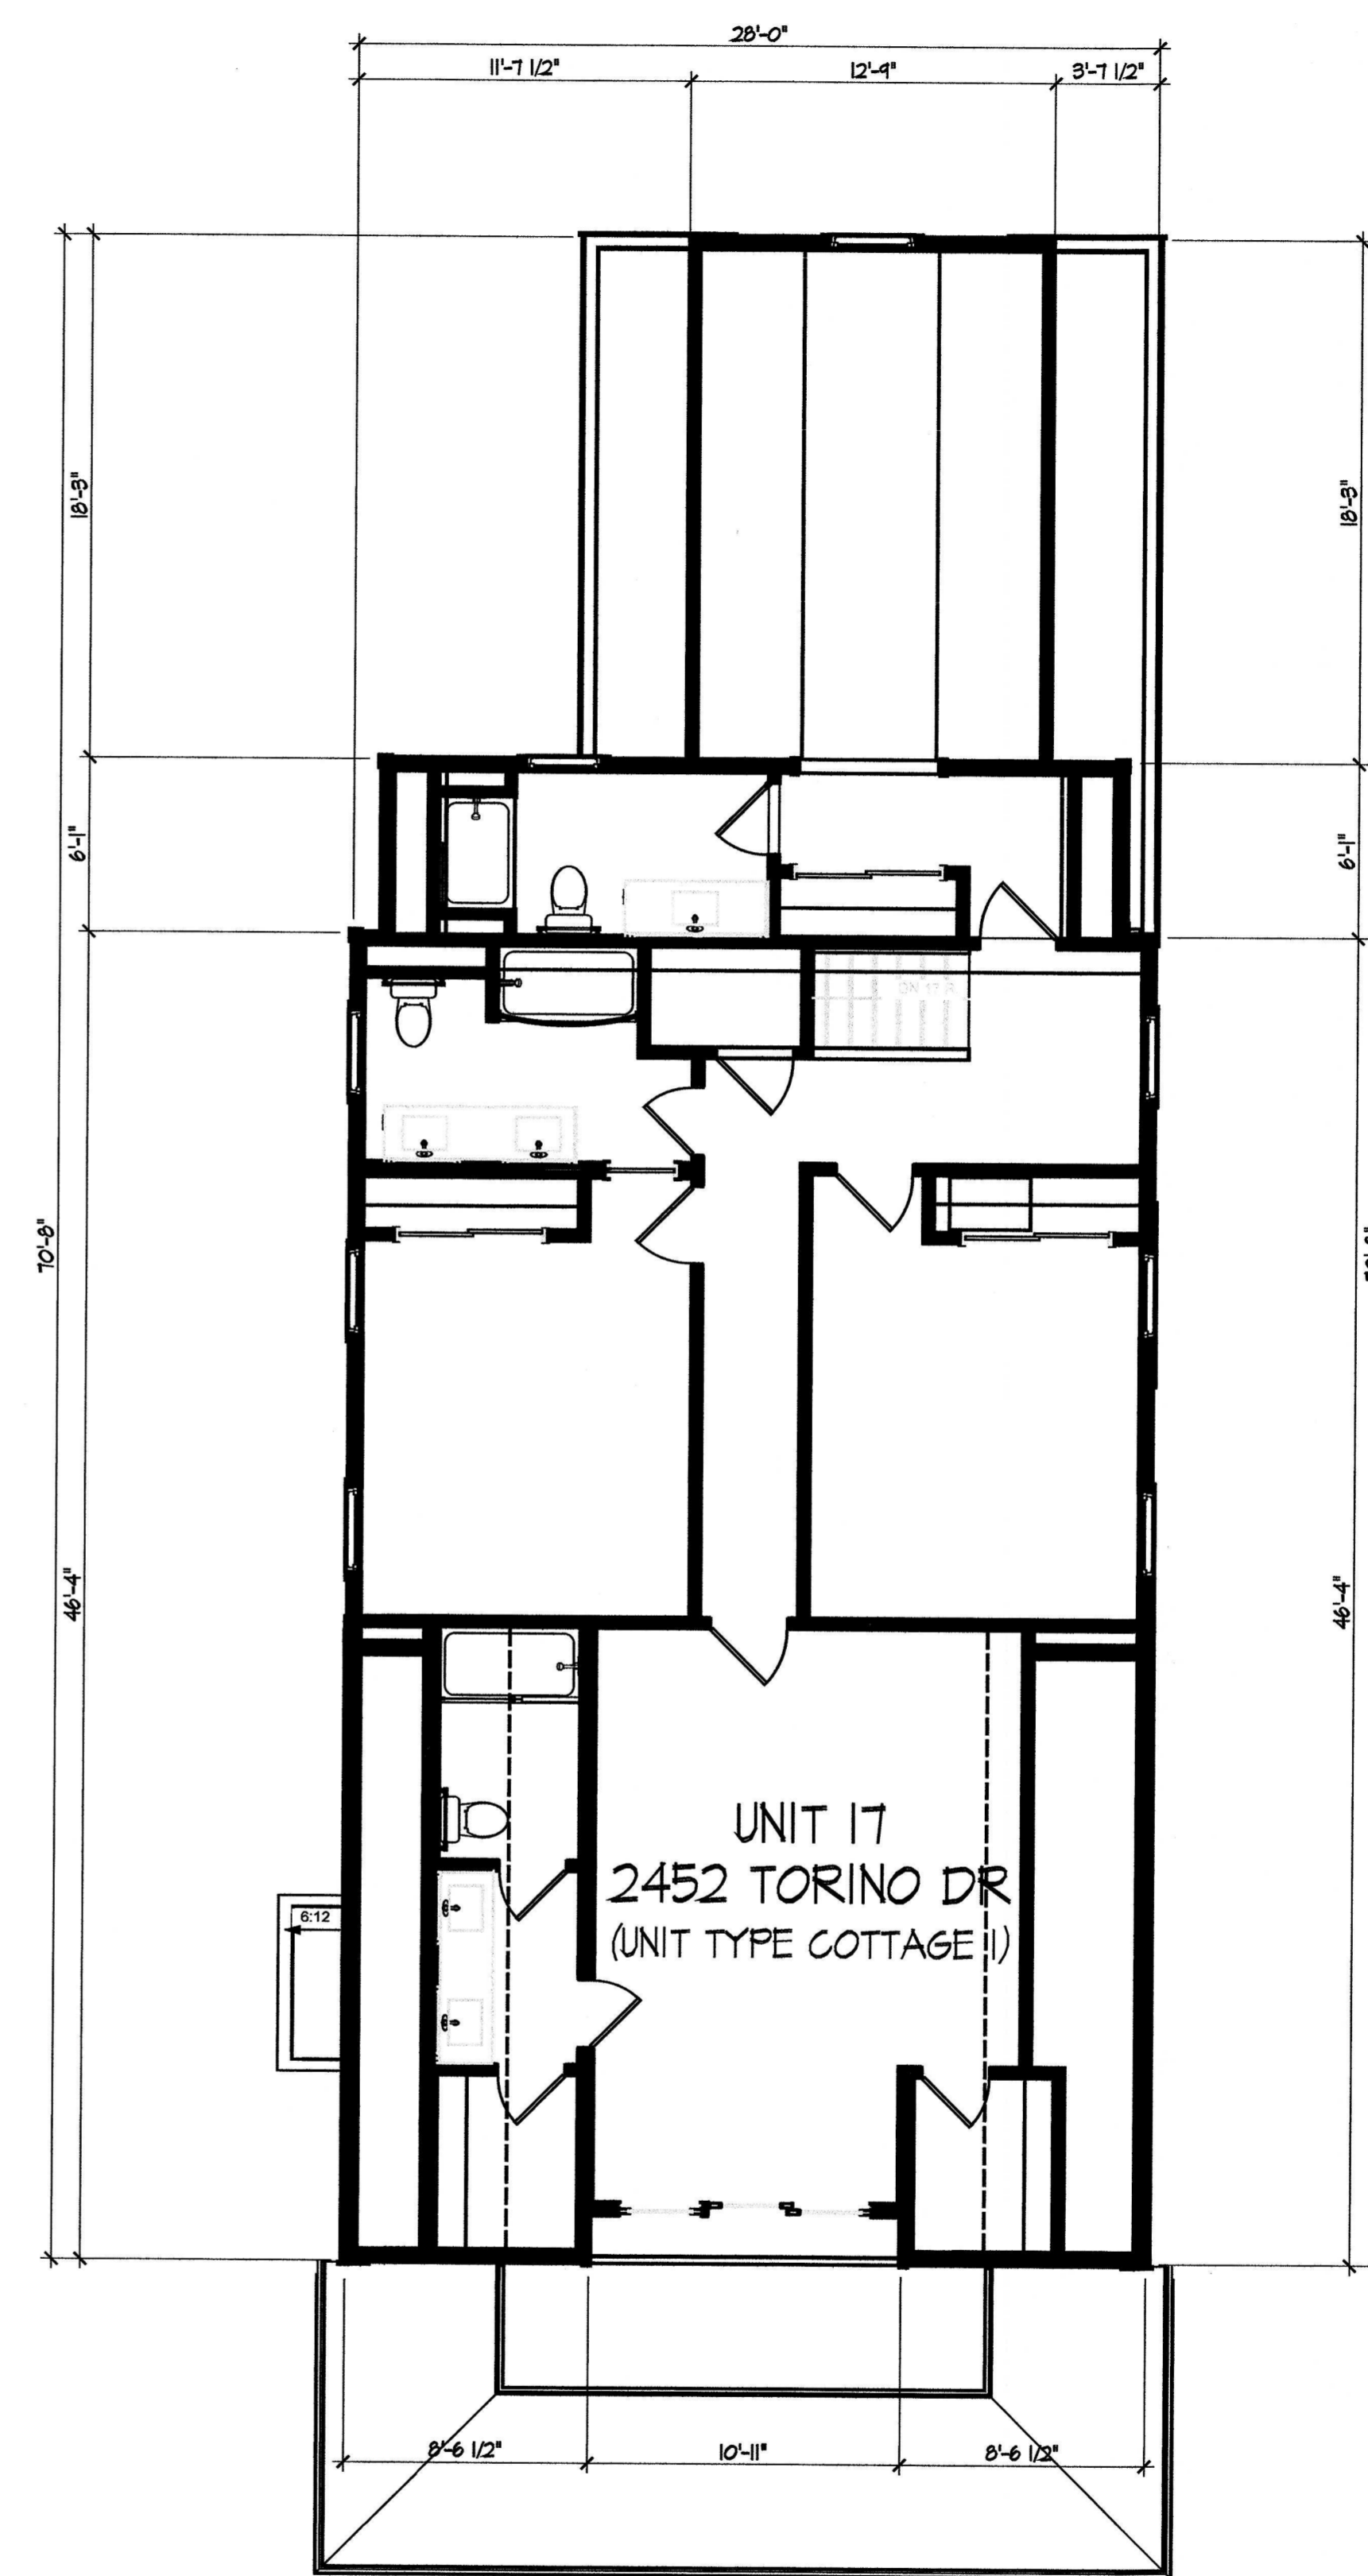

Second Floor Plan

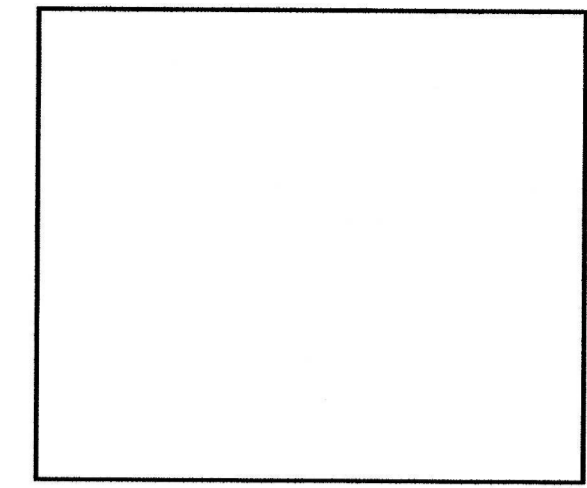


DEAN A. WENZ
ARCHITECTS
2463 E. MAIN STREET
BEXLEY, OHIO 43209
(614) 239-6868
FAX (614) 239-9868

Fairway Cottages at Catawba Island Club
Documentation Drawings
Second Amendment

Architect Project Number
2020-046A

Sheet Number
5 of 14

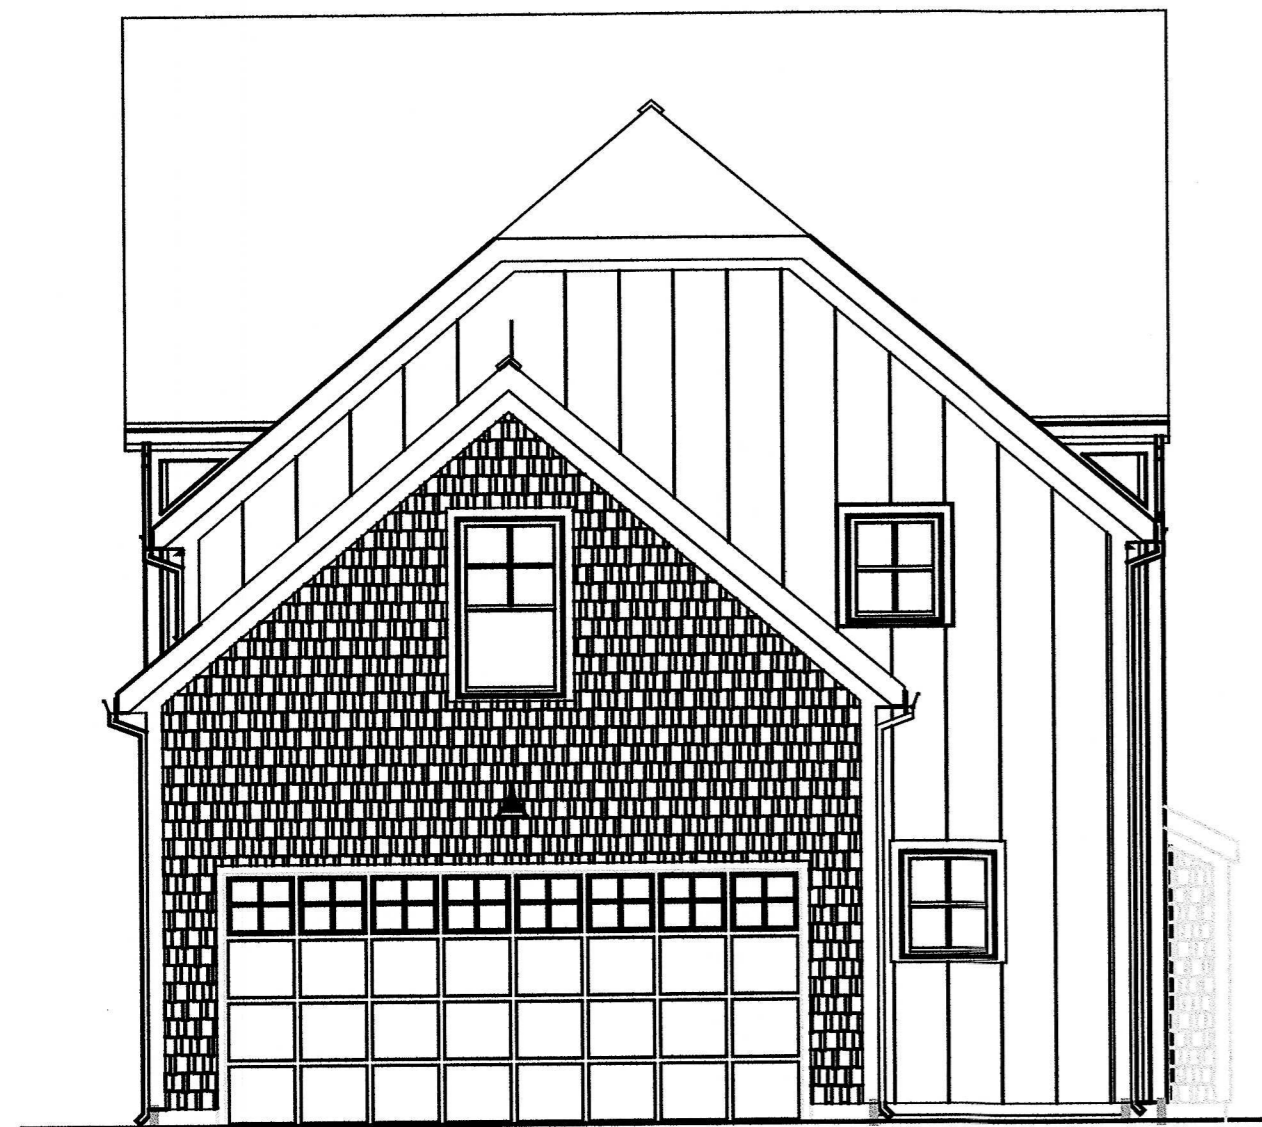

EAST

- Bedroom 5 Clg. Ht
17'-5"
- Bedroom 5 Flr
9'-3 7/8"
- 1st Flr Entry/Garage Clg Ht
8'-1 1/8"
- 1st Flr Window Ht
7'-0"
- First Floor
0'-0"



NORTH
UNIT 17
2452 TORINO DR
(UNIT TYPE COTTAGE 1)

- 2nd Flr Ceiling Ht
19'-0"
- 2nd Flr Window Ht
17'-7 7/8"
- Second Floor
10'-7 7/8"
- 1st Flr Ceiling Ht
9'-1 1/8"
- 1st Flr Window Ht
7'-0"
- First Floor
0'-0"



WEST



SOUTH

Elevations


DEAN A. WENZ
ARCHITECTS

2463 E. MAIN STREET
BEXLEY, OHIO 43209
(614) 239-6868
FAX (614) 239-9868


Fairway Cottages at Catawba Island Club
Documentation Drawings
Second Amendment

Architect Project Number
2020-046A


Sheet Number
6 of 14

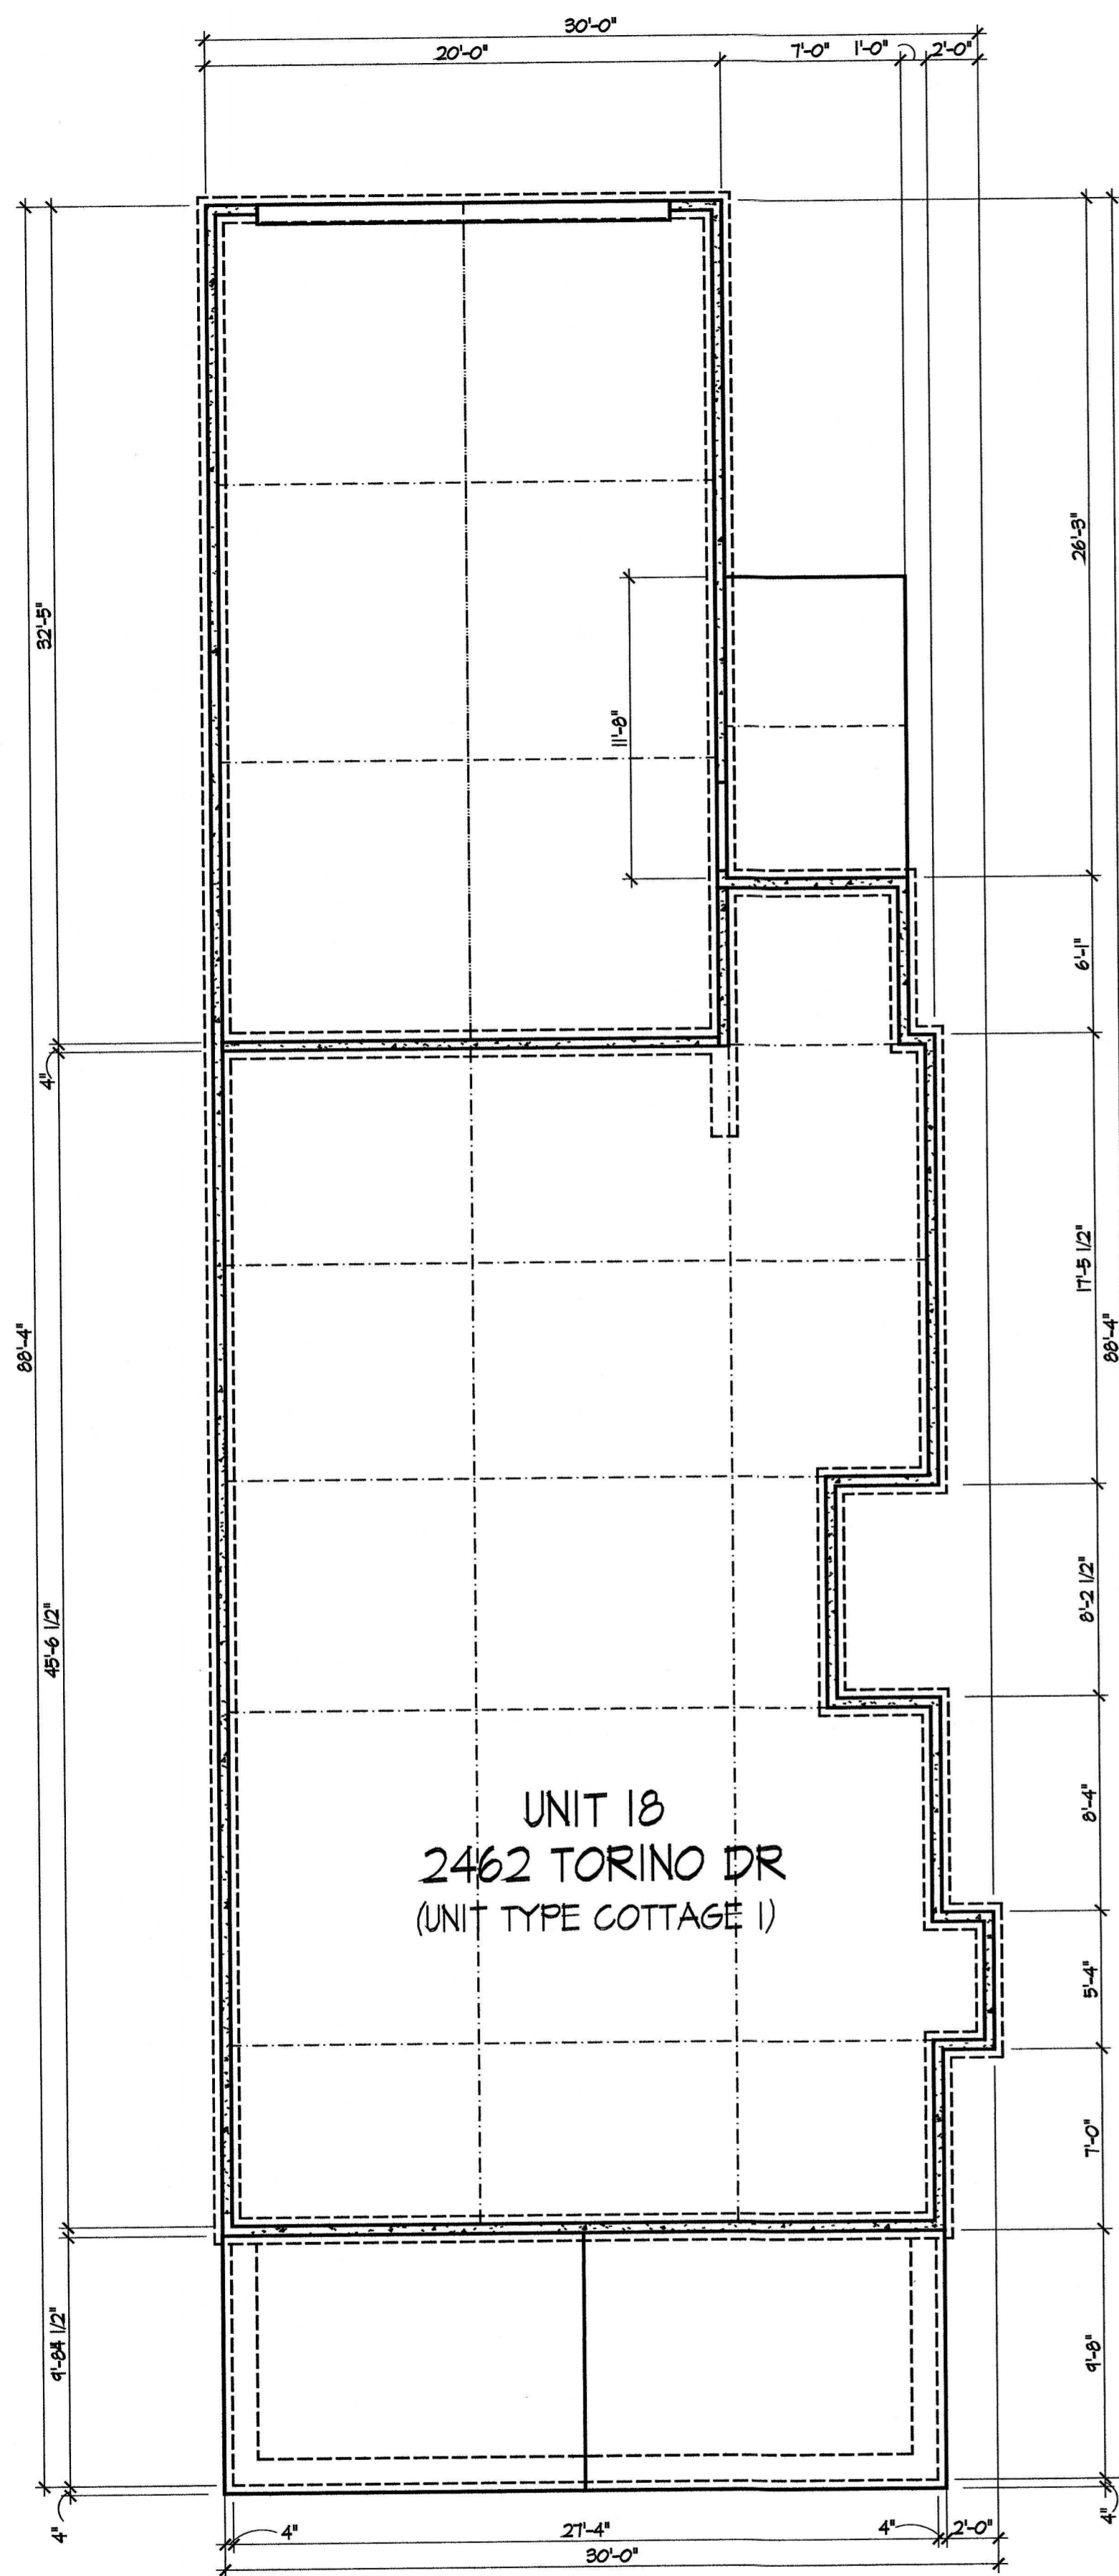

Foundation Plan

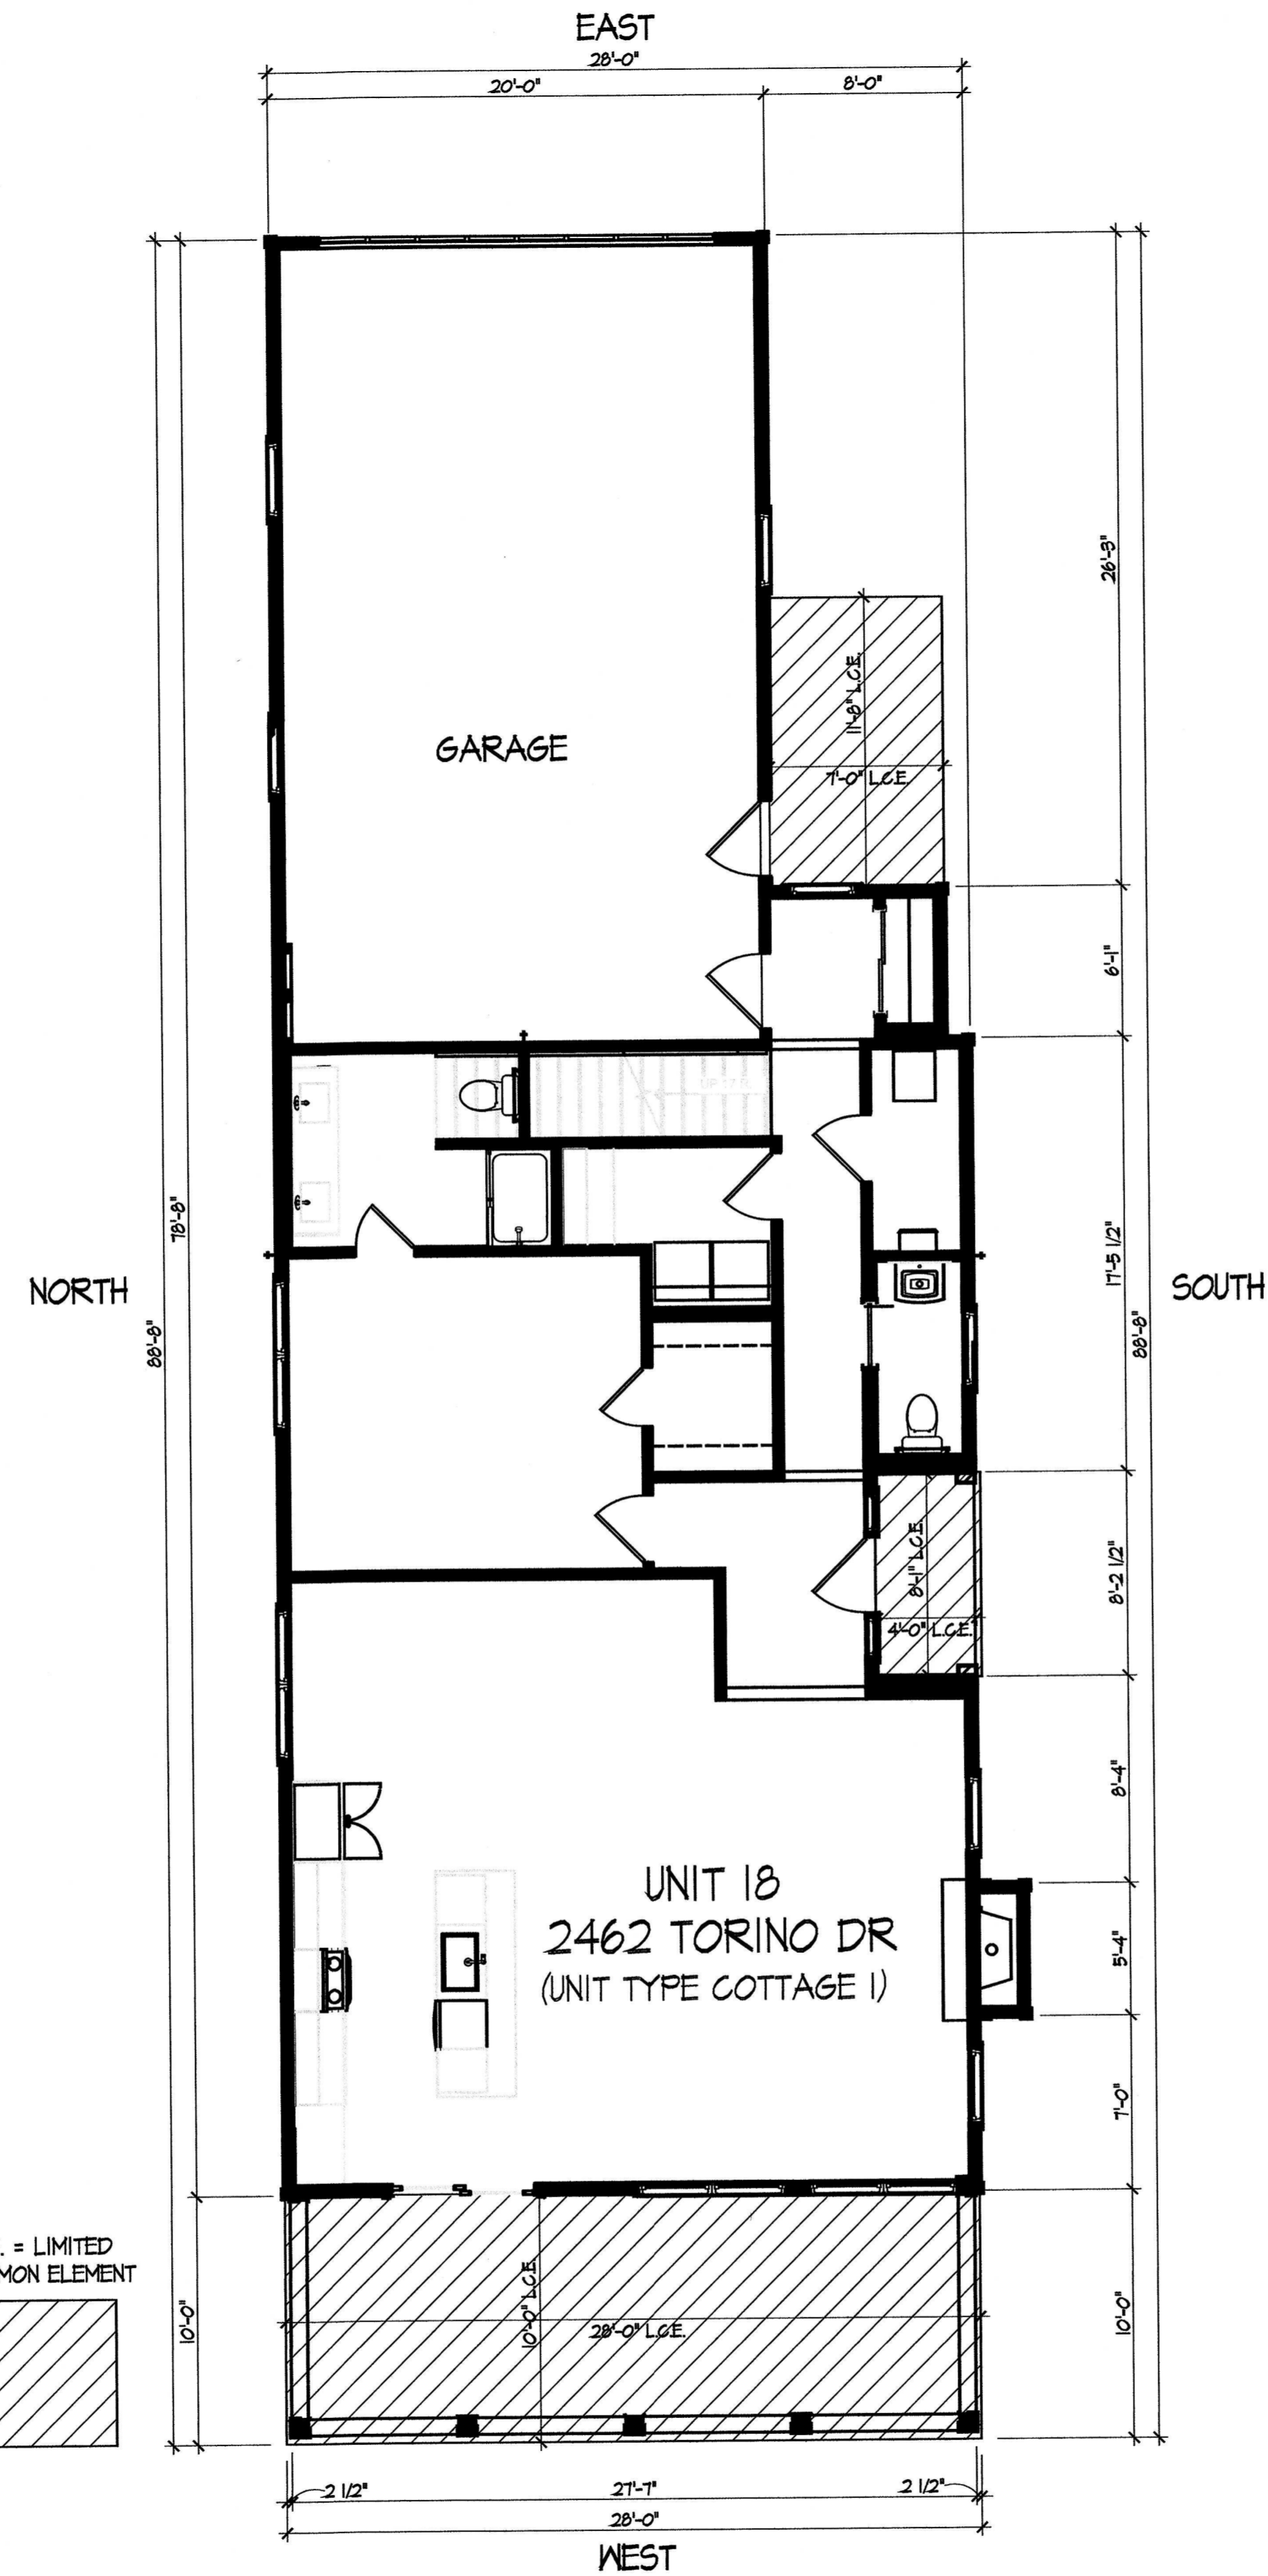

First Floor Plan

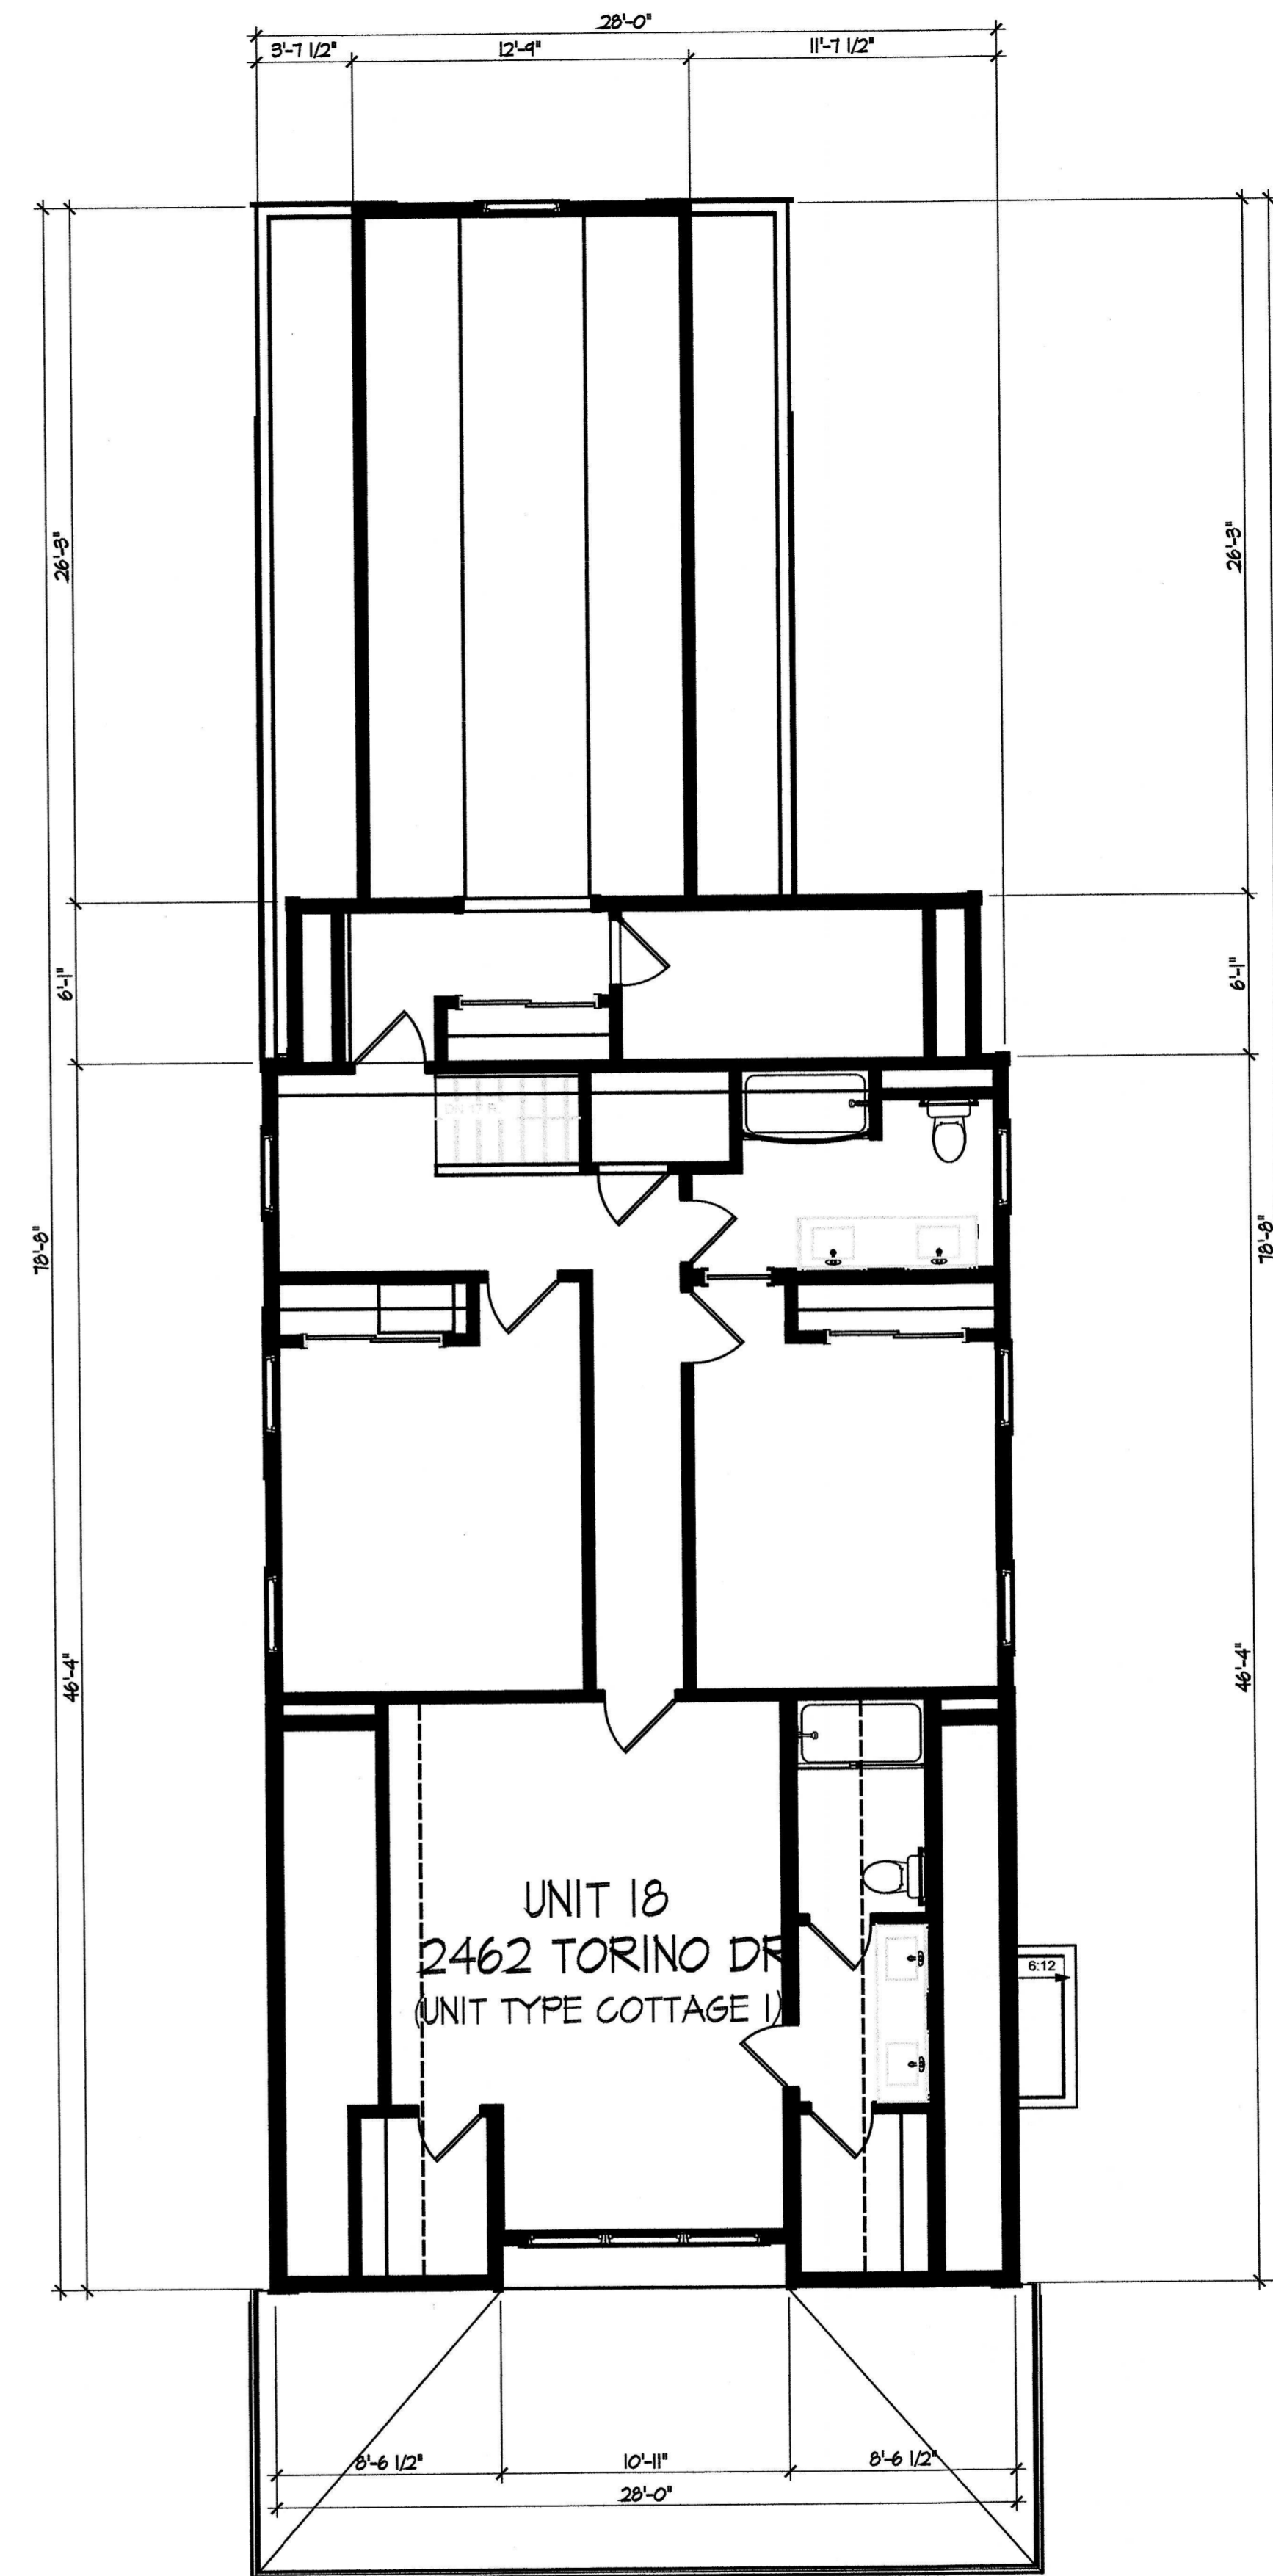

Second Floor Plan

DEAN A. WENZ
ARCHITECTS

2463 E. MAIN STREET
BEXLEY, OHIO 43209
(614) 239-6868
FAX (614) 239-9868


Fairway Cottages at Catawba Island Club
Documentation Drawings
Second Amendment

Architect Project Number
2020-046A


Sheet Number
7 of 14



- 2nd Flr Ceiling Ht
19'-9"
- 2nd Flr Window Ht
17'-7 7/8"
- Second Floor
10'-7 7/8"
- 1st Flr Ceiling Ht
9'-1 1/8"
- 1st Flr Window Ht
7'-0"
- First Floor
0'-0"

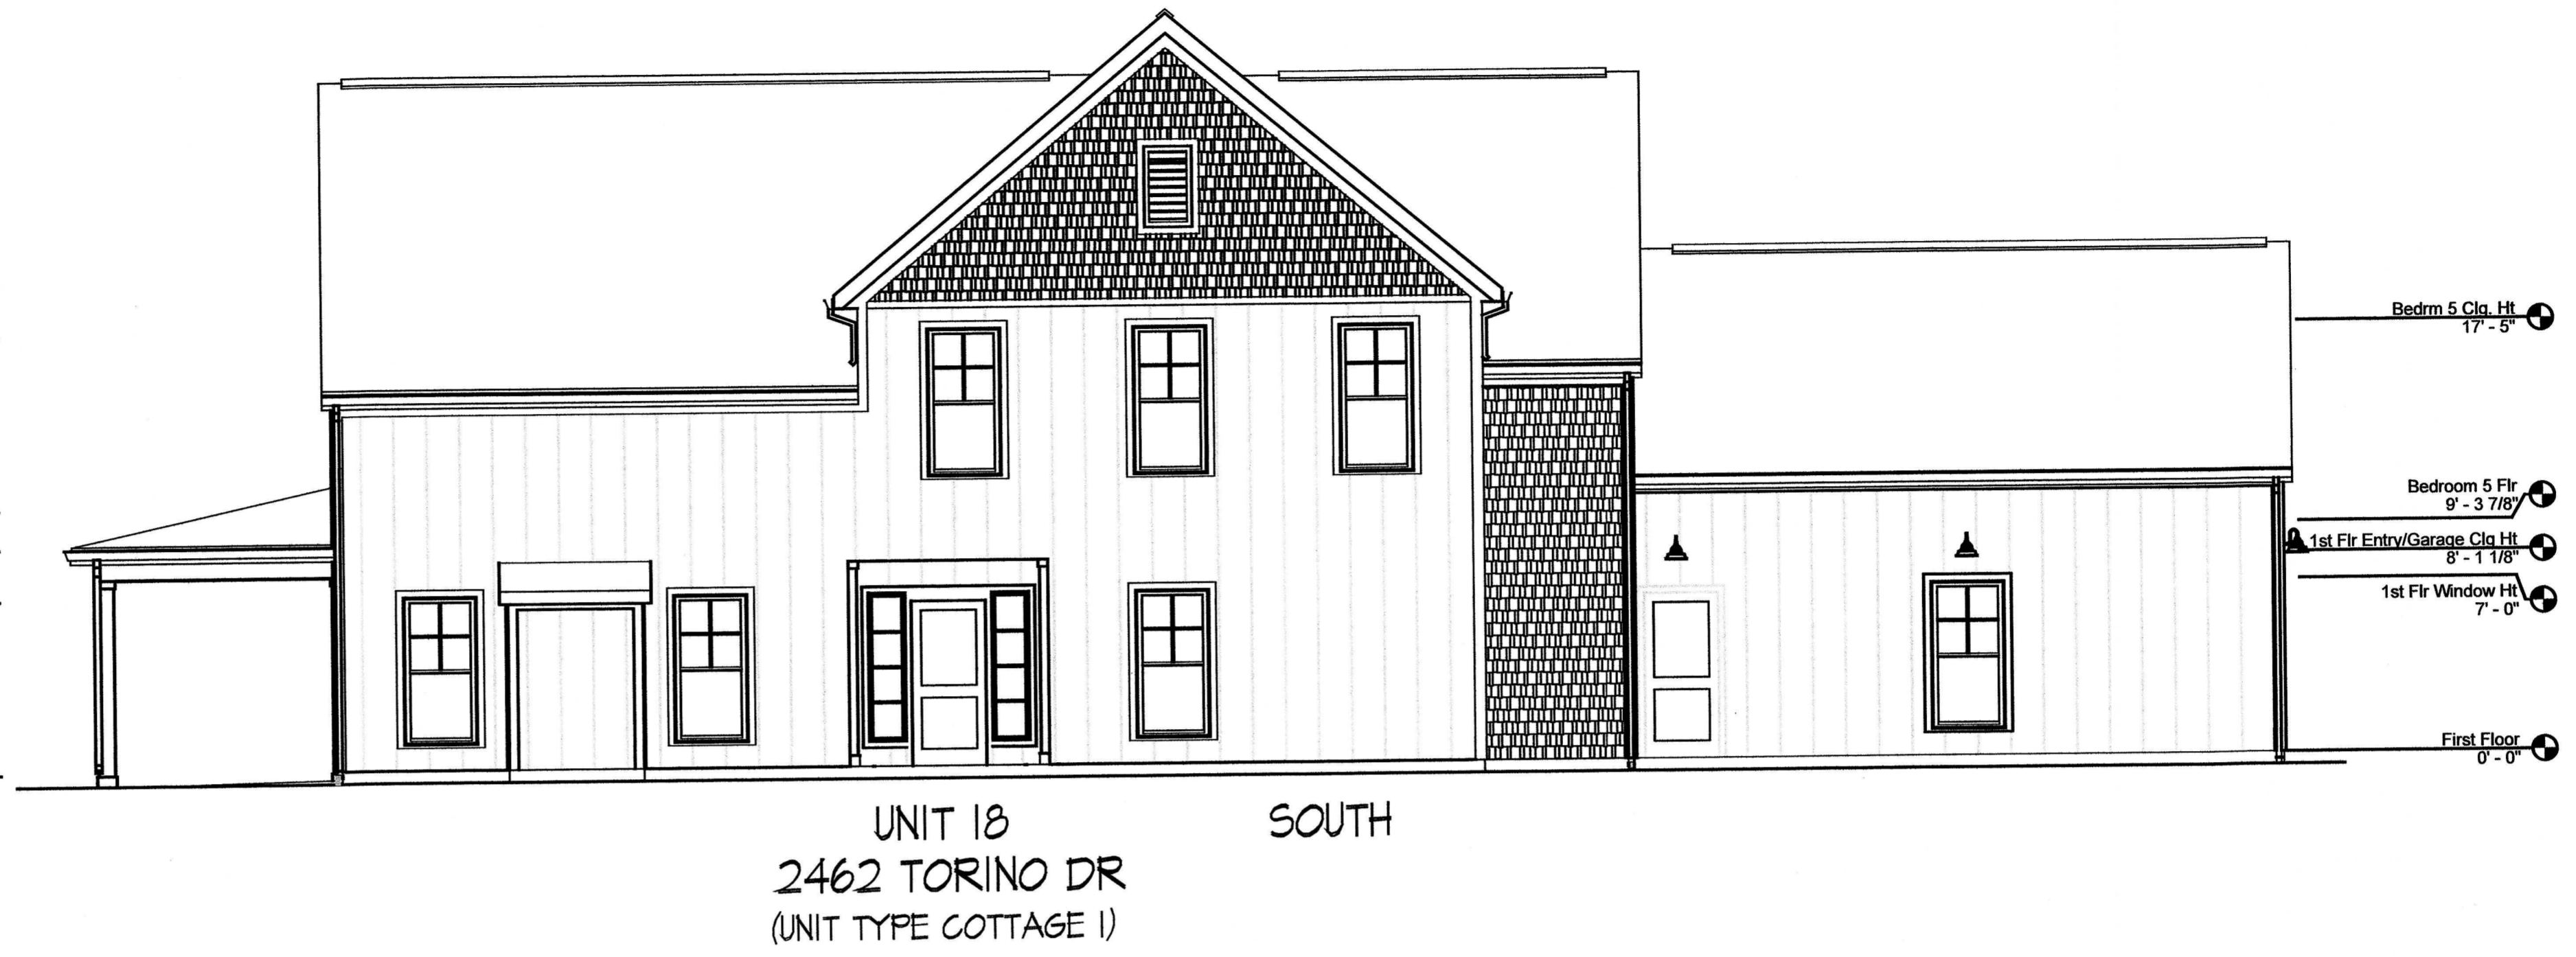

- Bedrm 5 Clg. Ht
17'-5"
- Bedroom 5 Flr
9'-3 7/8"
- 1st Flr Entry/Garage Clg Ht
8'-1 1/8"
- 1st Flr Window Ht
7'-0"
- First Floor
0'-0"

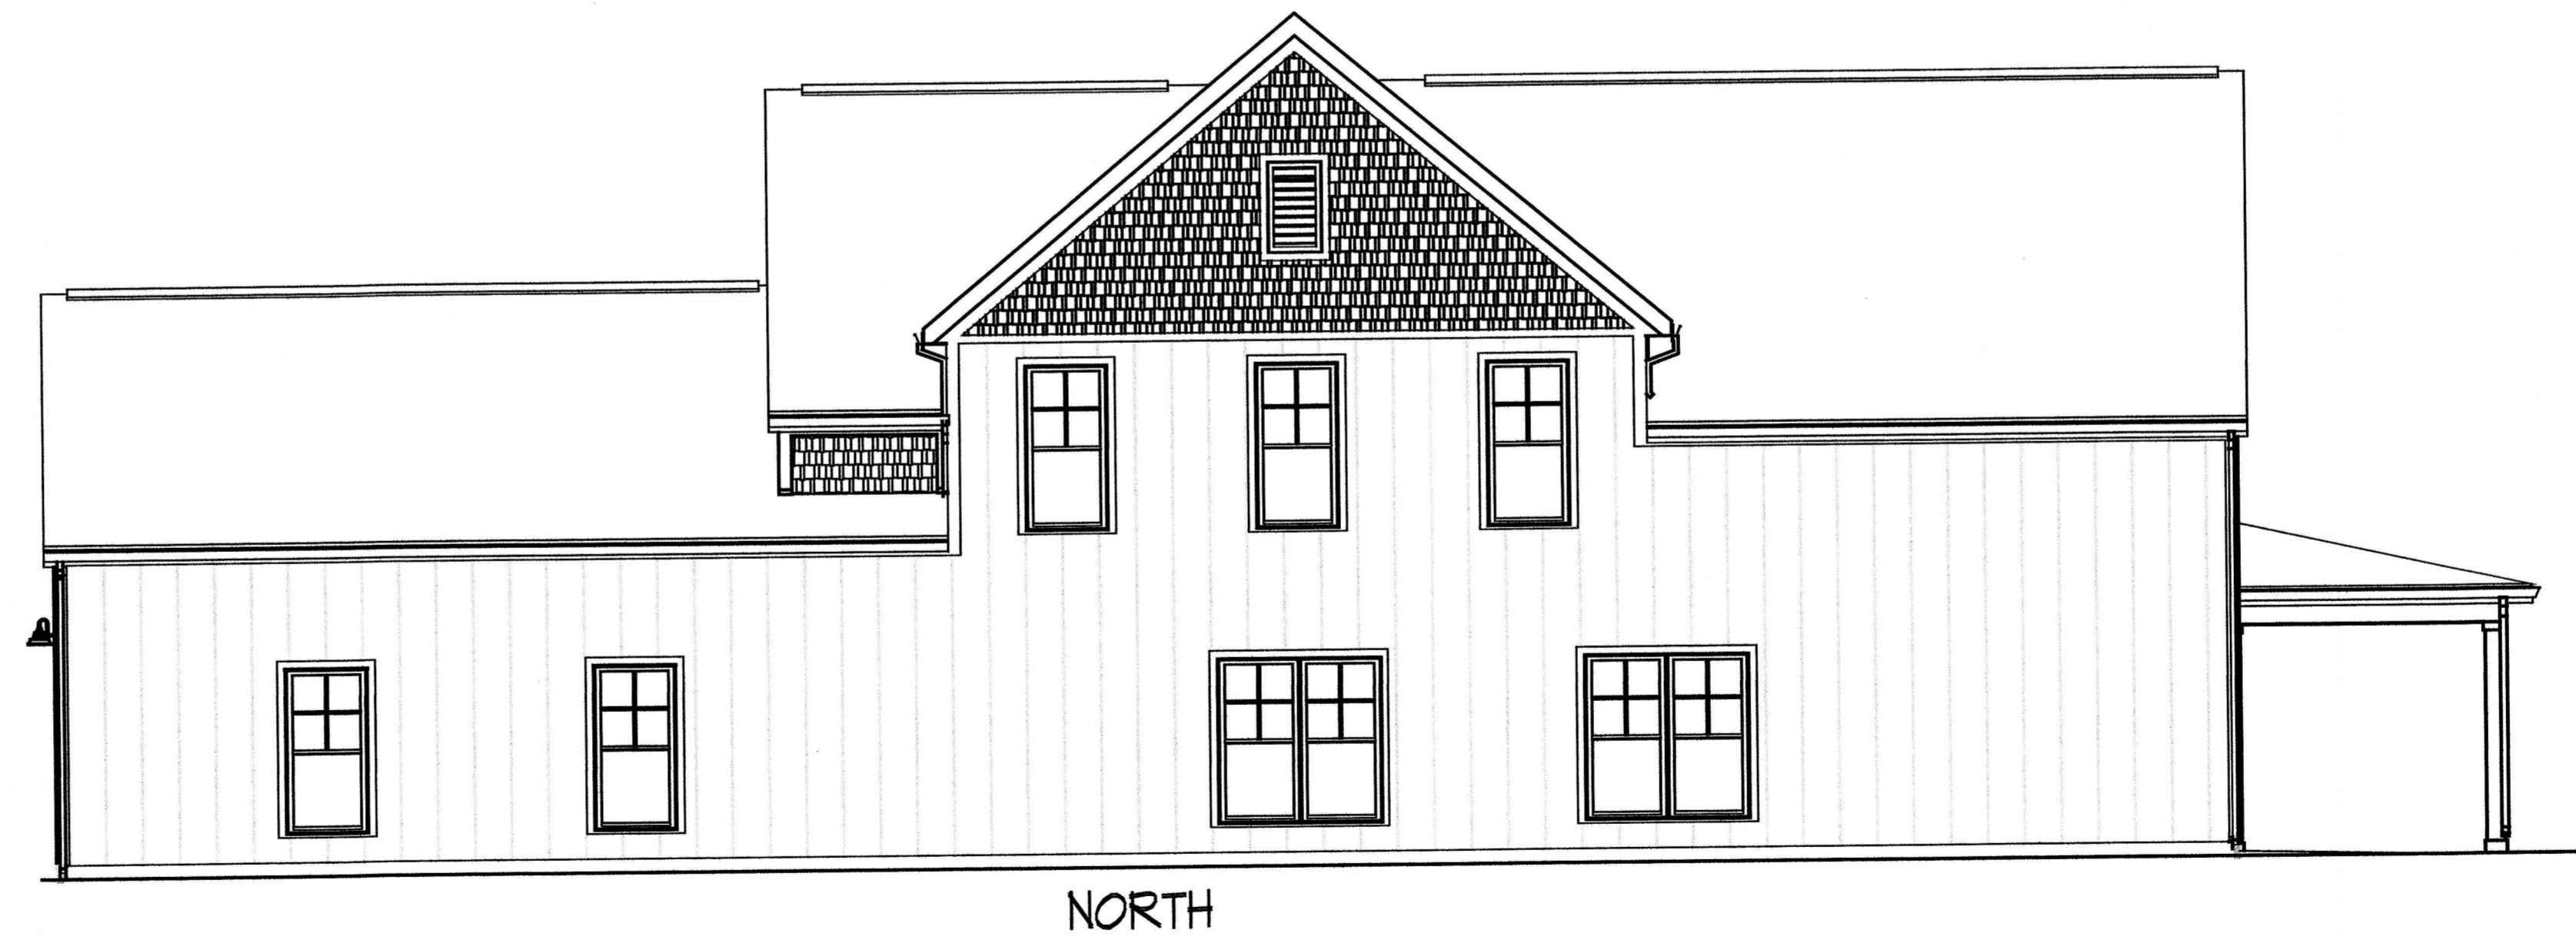

Elevations

DEAN A. WENZ
ARCHITECTS

2463 E. MAIN STREET
BEXLEY, OHIO 43209
(614) 239-6868
FAX (614) 239-9868

Fairway Cottages at Catawba Island Club
Documentation Drawings
Second Amendment

Architect Project Number
2020-046A

Sheet Number
8 of 14