




Foundation Plan

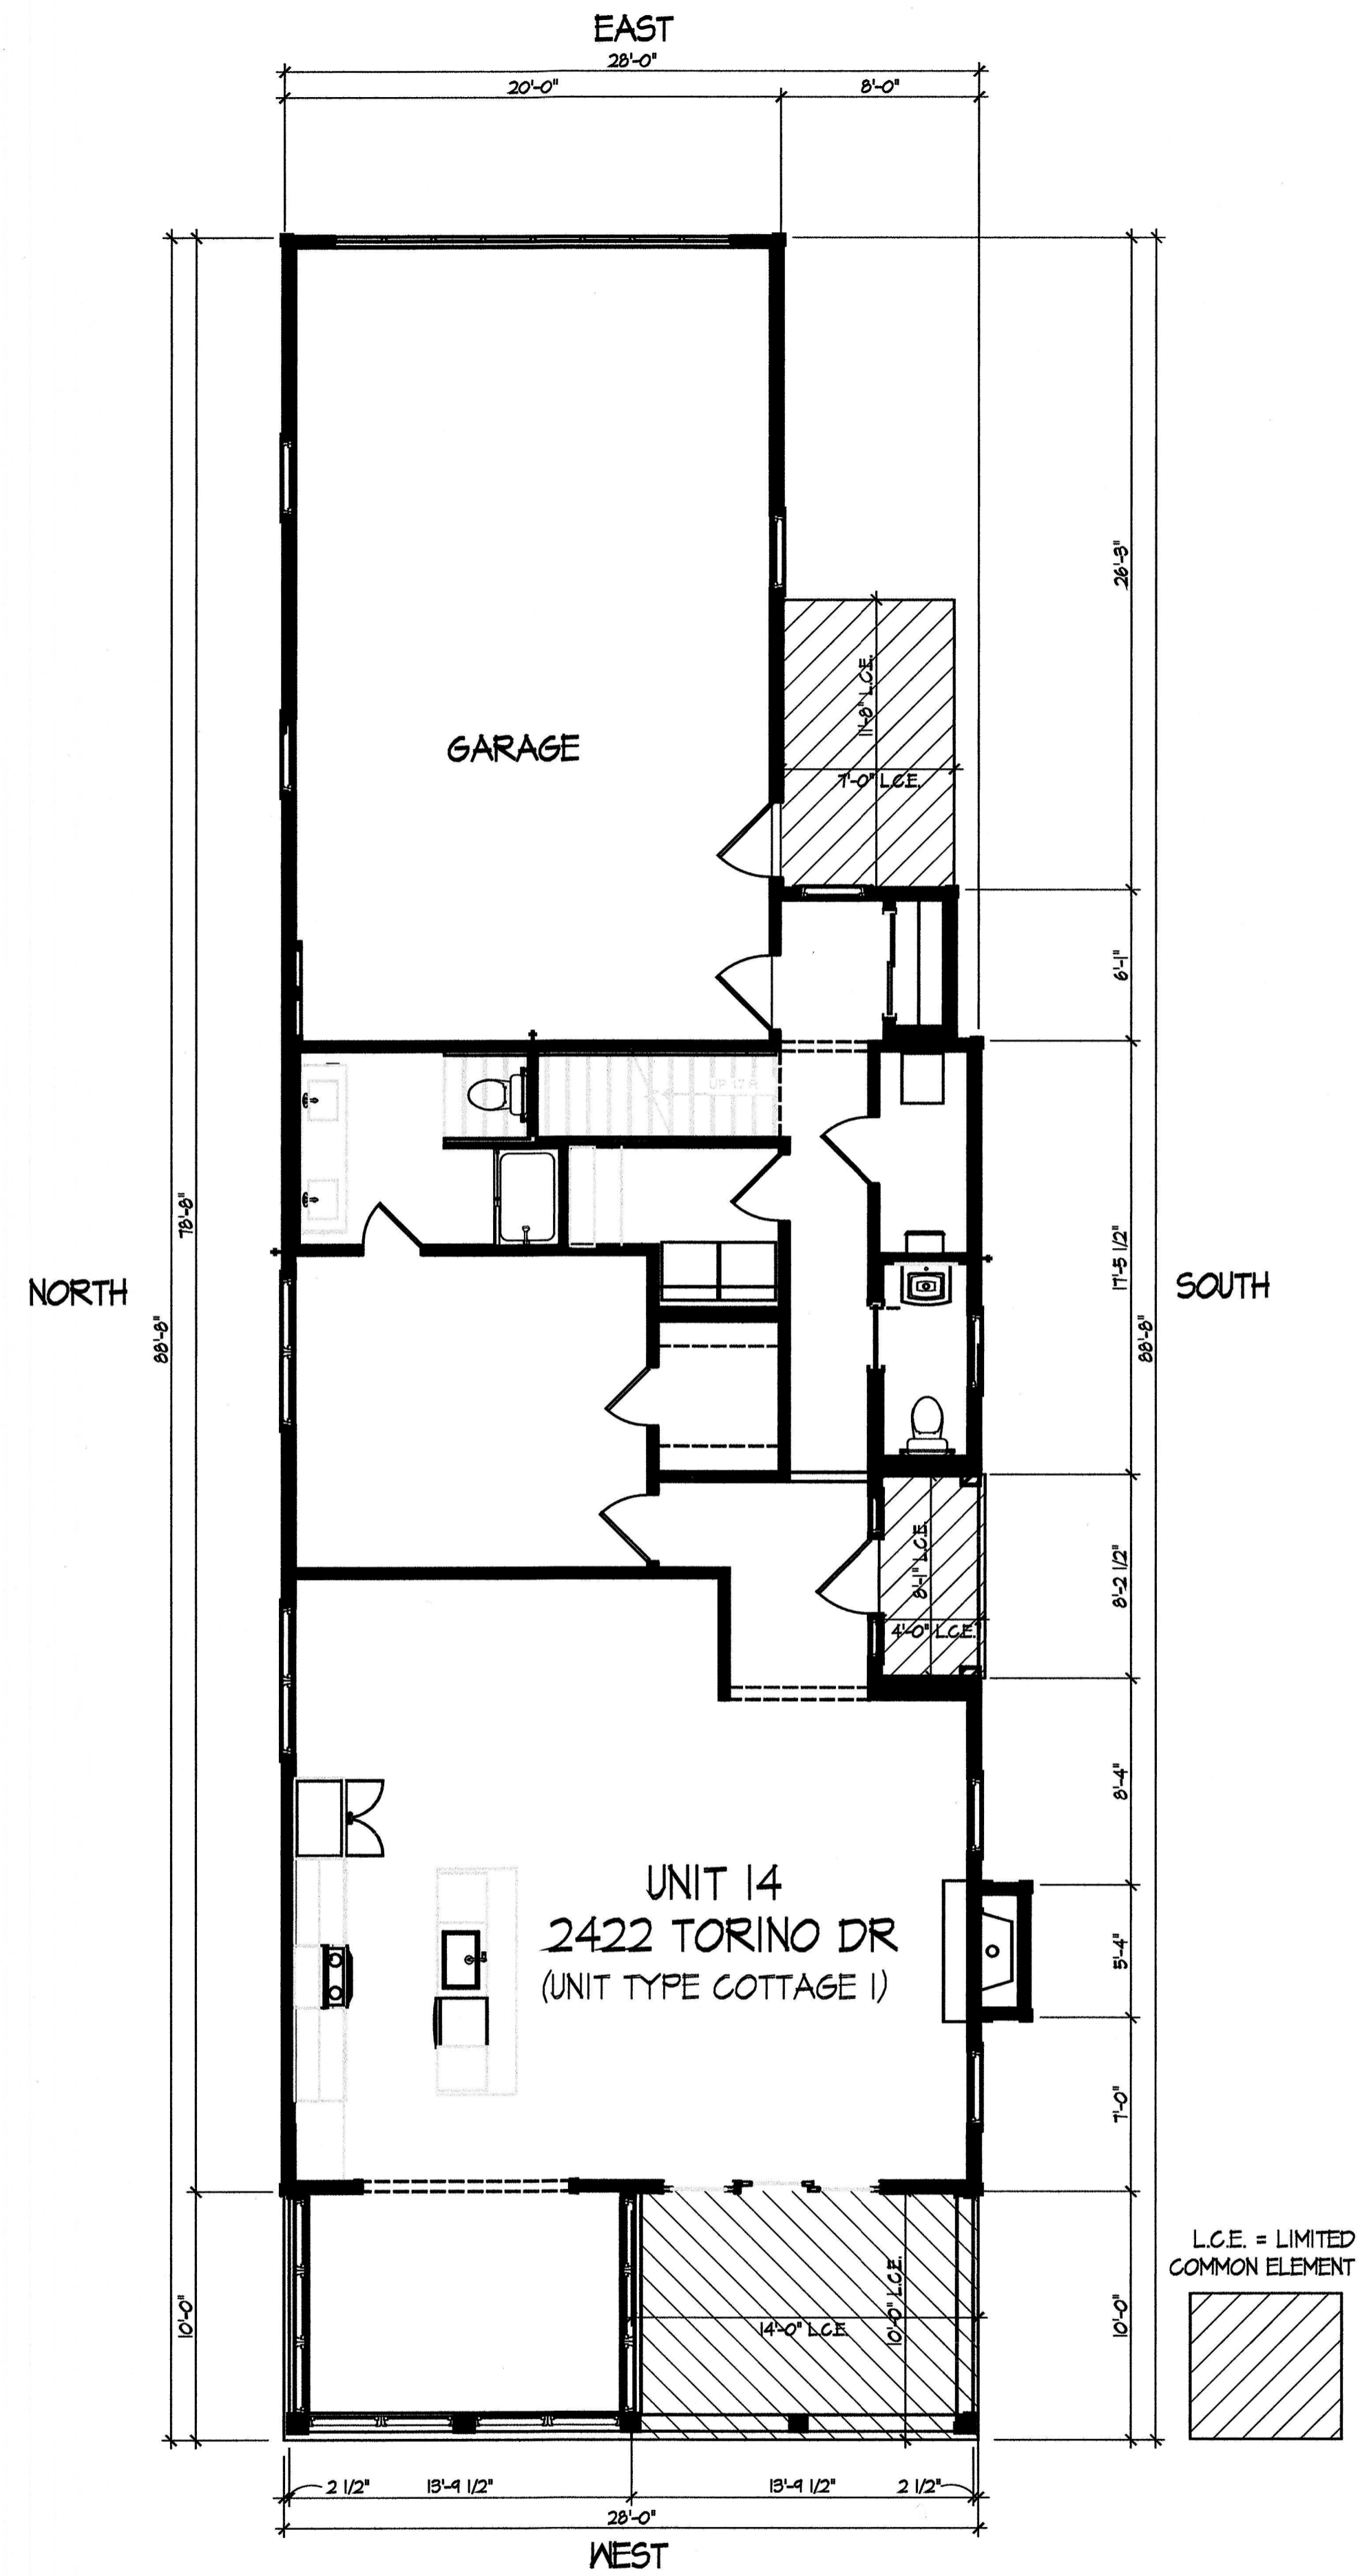

First Floor Plan

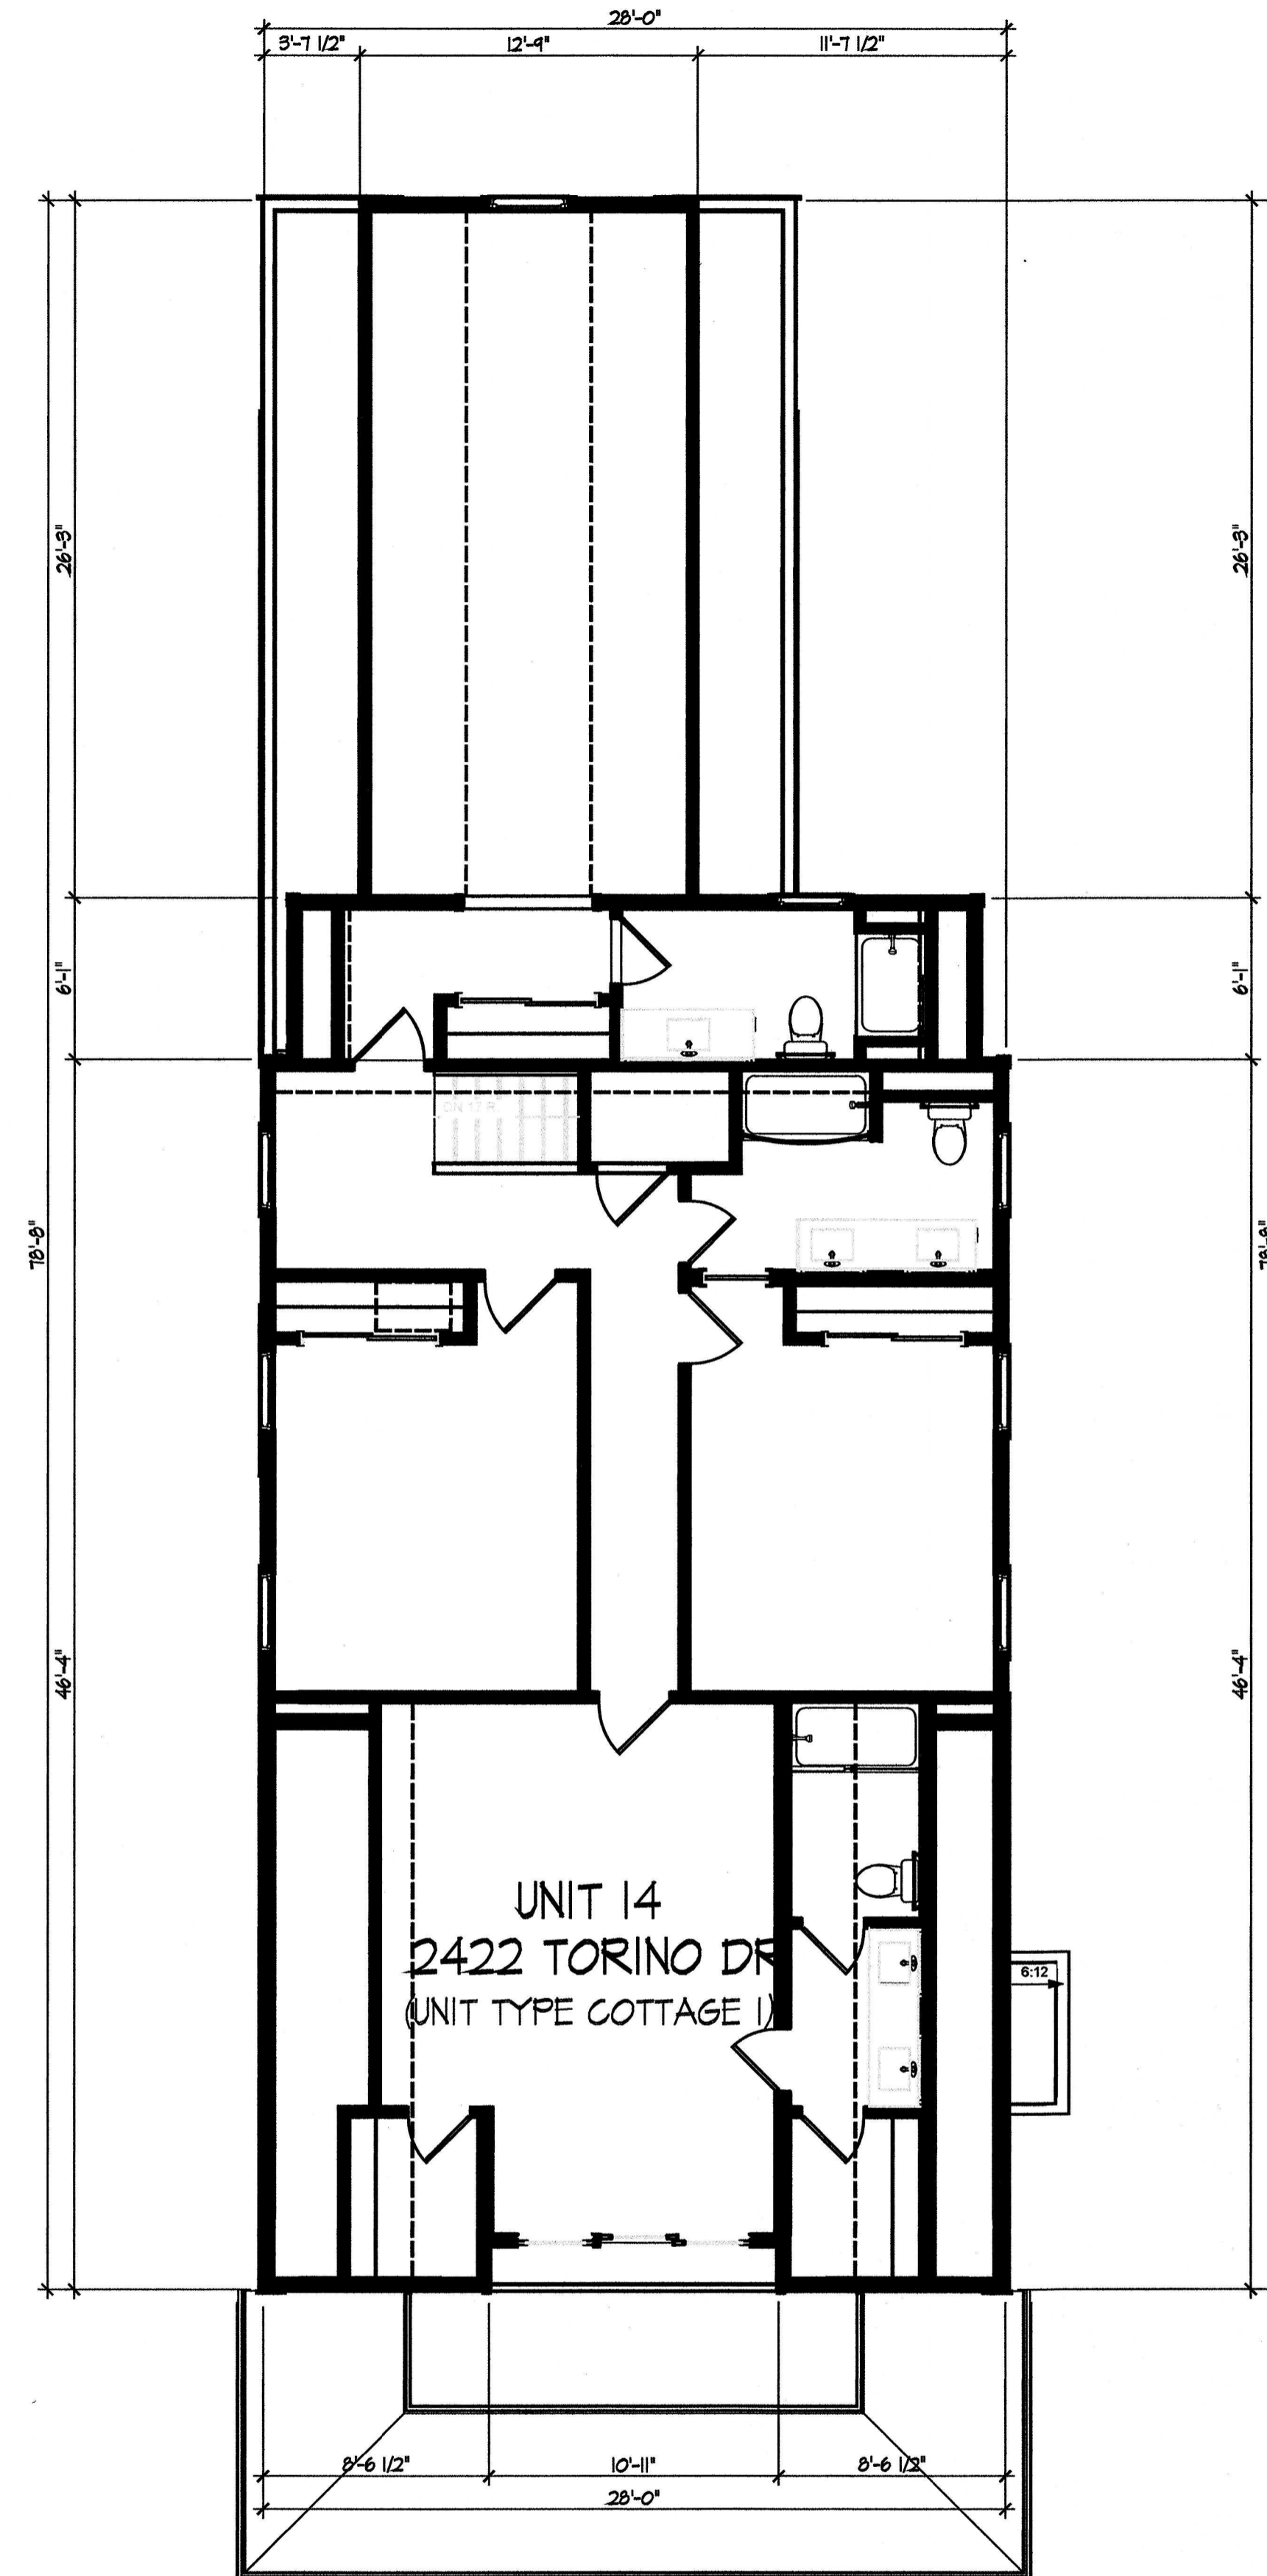

Second Floor Plan

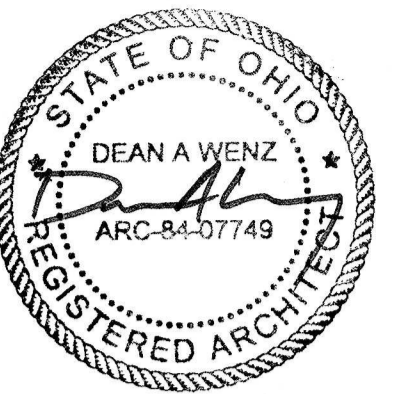


DEAN A. WENZ
ARCHITECTS

2463 E. MAIN STREET
BEXLEY, OHIO 43209
(614) 239-6868
FAX (614) 239-9868

Fairway Cottages at Catawba Island Club
Documentation Drawings
Third Amendment

Architect Project Number
2020-046A

Sheet Number
3 of 10

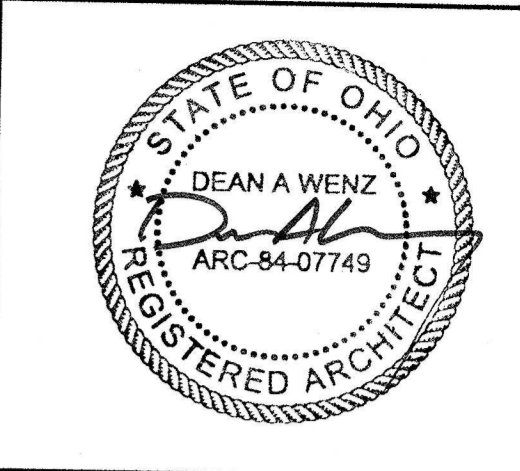

DEAN A. WENZ
ARCHITECTS

2463 E. MAIN STREET
BEXLEY, OHIO 43209
(614) 239-6868
FAX (614) 239-9868

Fairway Cottages at Catawba Island Club
Documentation Drawings
Third Amendment

Architect Project Number
2020-046A

Sheet Number
4 of 10



EAST

- 2nd Flr Ceiling Ht
19'-0"
- 2nd Flr Window Ht
17'-7 7/8"
- Second Floor
10'-7 7/8"
- 1st Flr Ceiling Ht
9'-1 1/8"
- 1st Flr Window Ht
7'-0"
- First Floor
0'-0"



SOUTH

- Bedrm 5 Clg Ht
17'-5"
- Bedroom 5 Flr
9'-3 7/8"
- 1st Flr Entry/Garage Clg Ht
8'-1 1/8"
- 1st Flr Window Ht
7'-0"
- First Floor
0'-0"

UNIT 14
2422 TORINO DR
(UNIT TYPE COTTAGE 1)




WEST




NORTH


Elevations

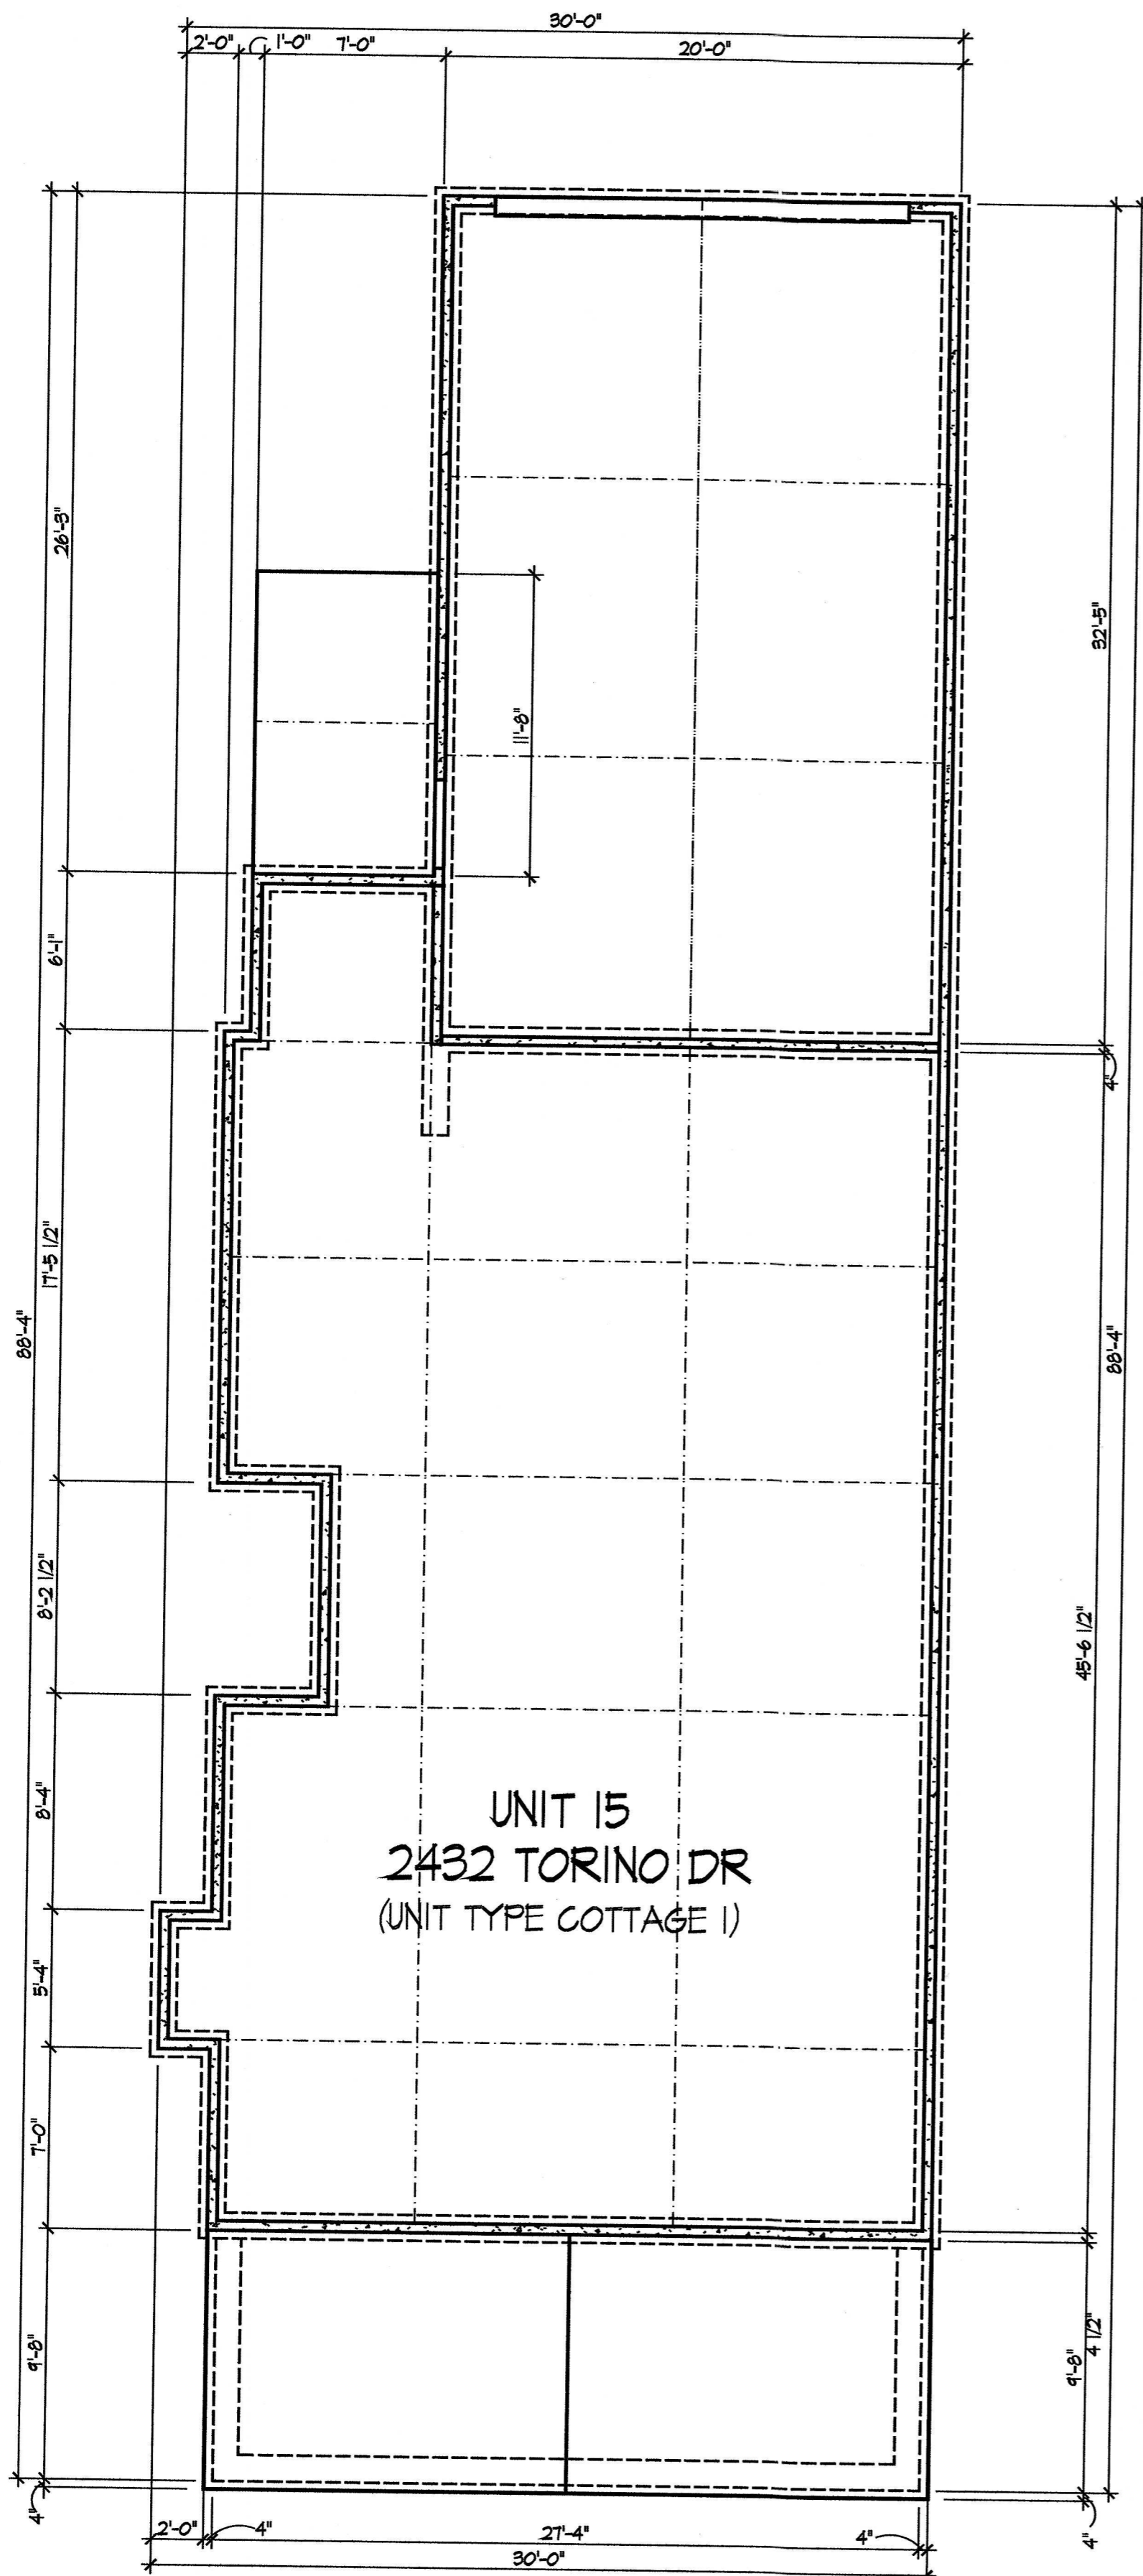

Foundation Plan

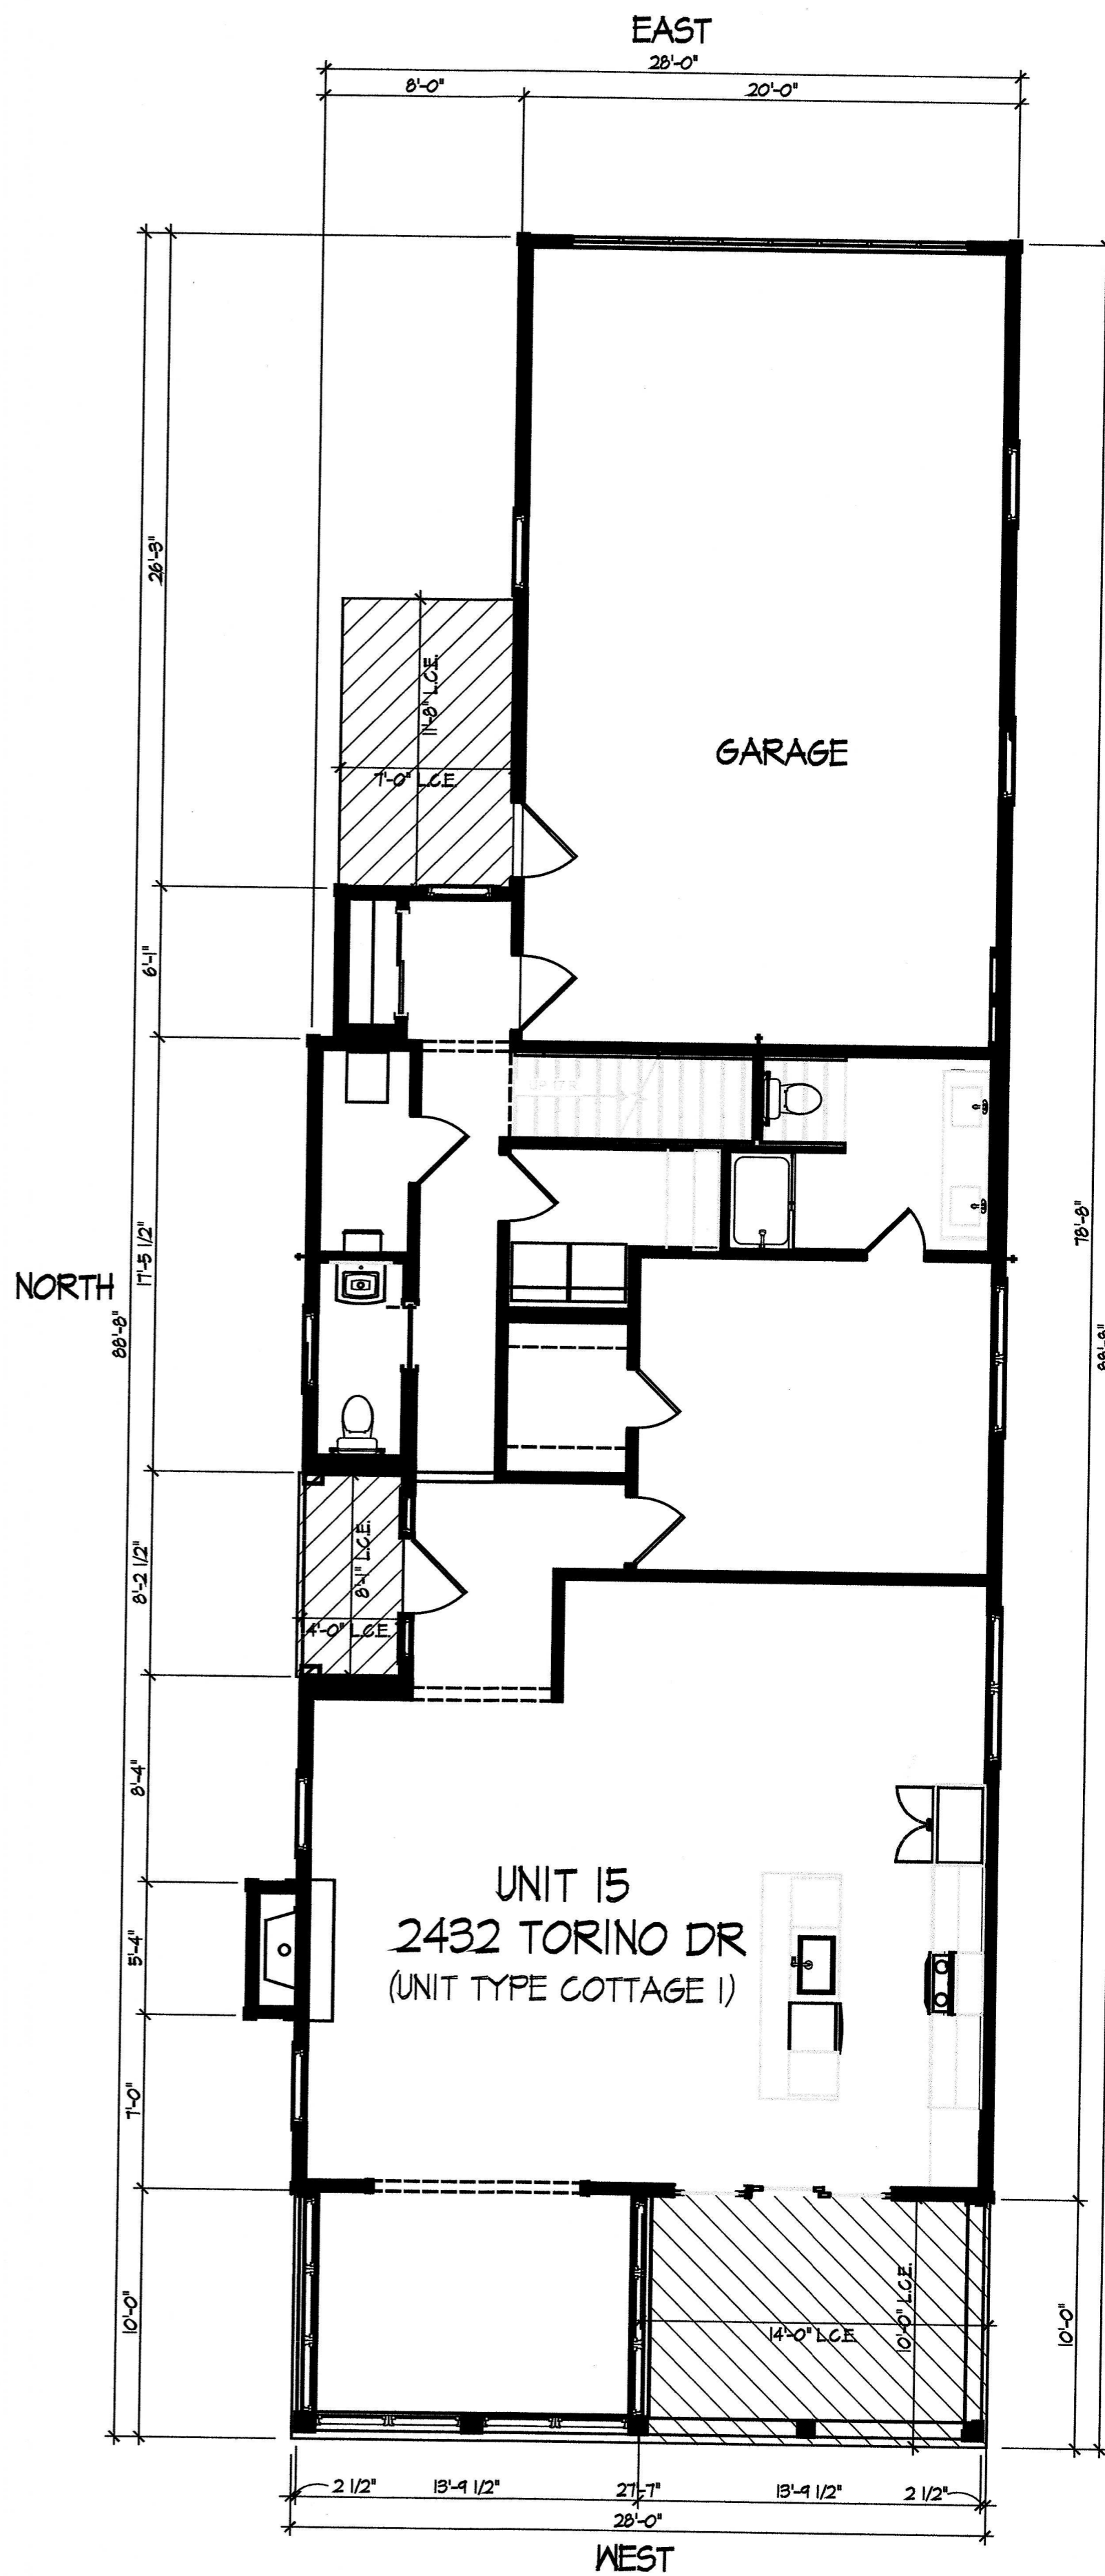

First Floor Plan

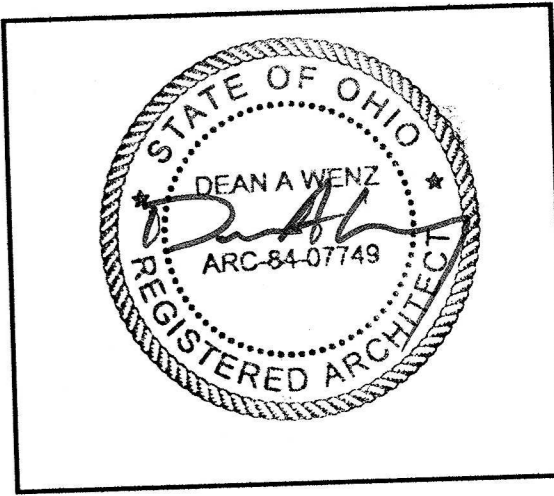


DEAN A. WENZ
ARCHITECTS

2463 E. MAIN STREET
BEXLEY, OHIO 43209
(614) 239-6868
FAX (614) 239-9868

Fairway Cottages at Catawba Island Club
Documentation Drawings
Third Amendment



EAST

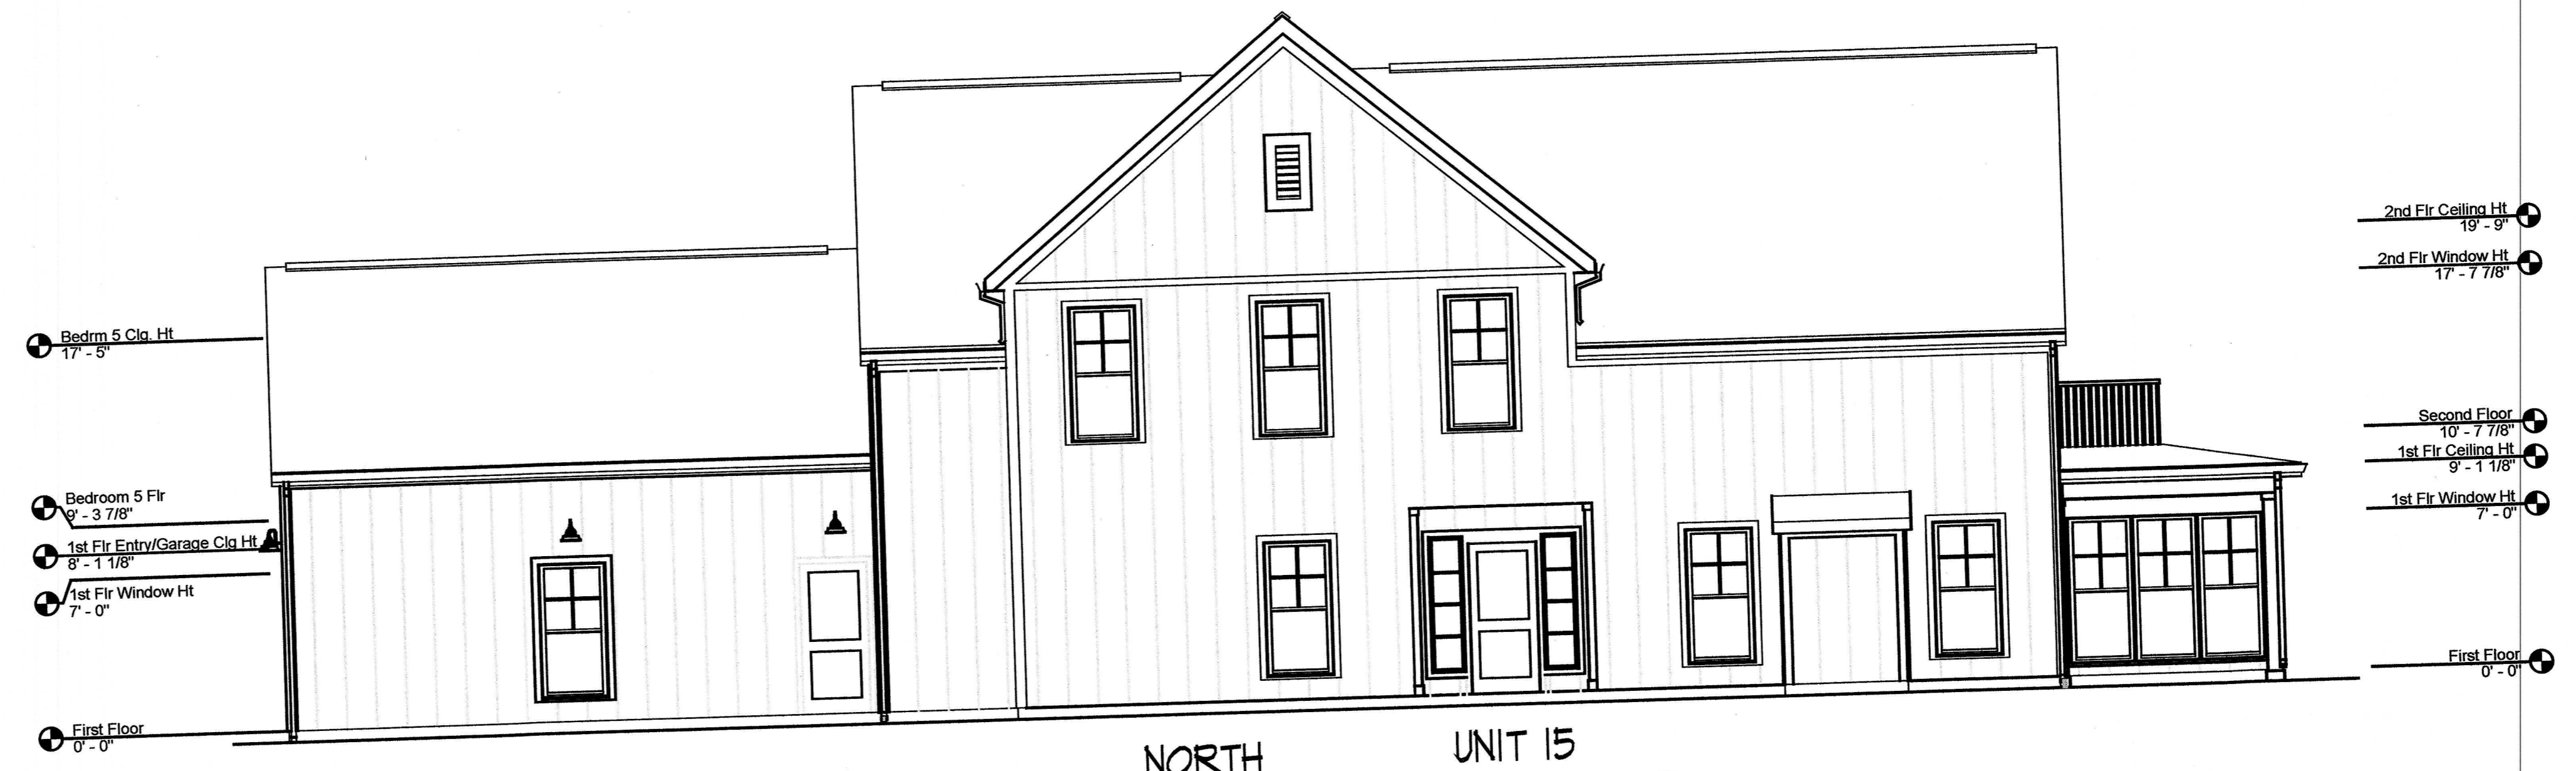

NORTH
UNIT 15
2432 TORINO DR
(UNIT TYPE COTTAGE 1)

- Bedrm 5 Cln. Ht
17'-0"
- Bedroom 5 Flr
12'-3 7/8"
- 1st Flr. Entry/Garage Cln. Ht
8'-1 1/8"
- 1st Flr Window Ht
7'-0"
- First Floor
0'-0"

- 2nd Flr Ceiling Ht
19'-9"
- 2nd Flr Window Ht
17'-7 7/8"
- Second Floor
10'-7 7/8"
- 1st Flr Ceiling Ht
9'-1 1/8"
- 1st Flr Window Ht
7'-0"
- First Floor
0'-0"



WEST




SOUTH


Elevations

Architect Project Number
2020-046A


Sheet Number
6 of 10

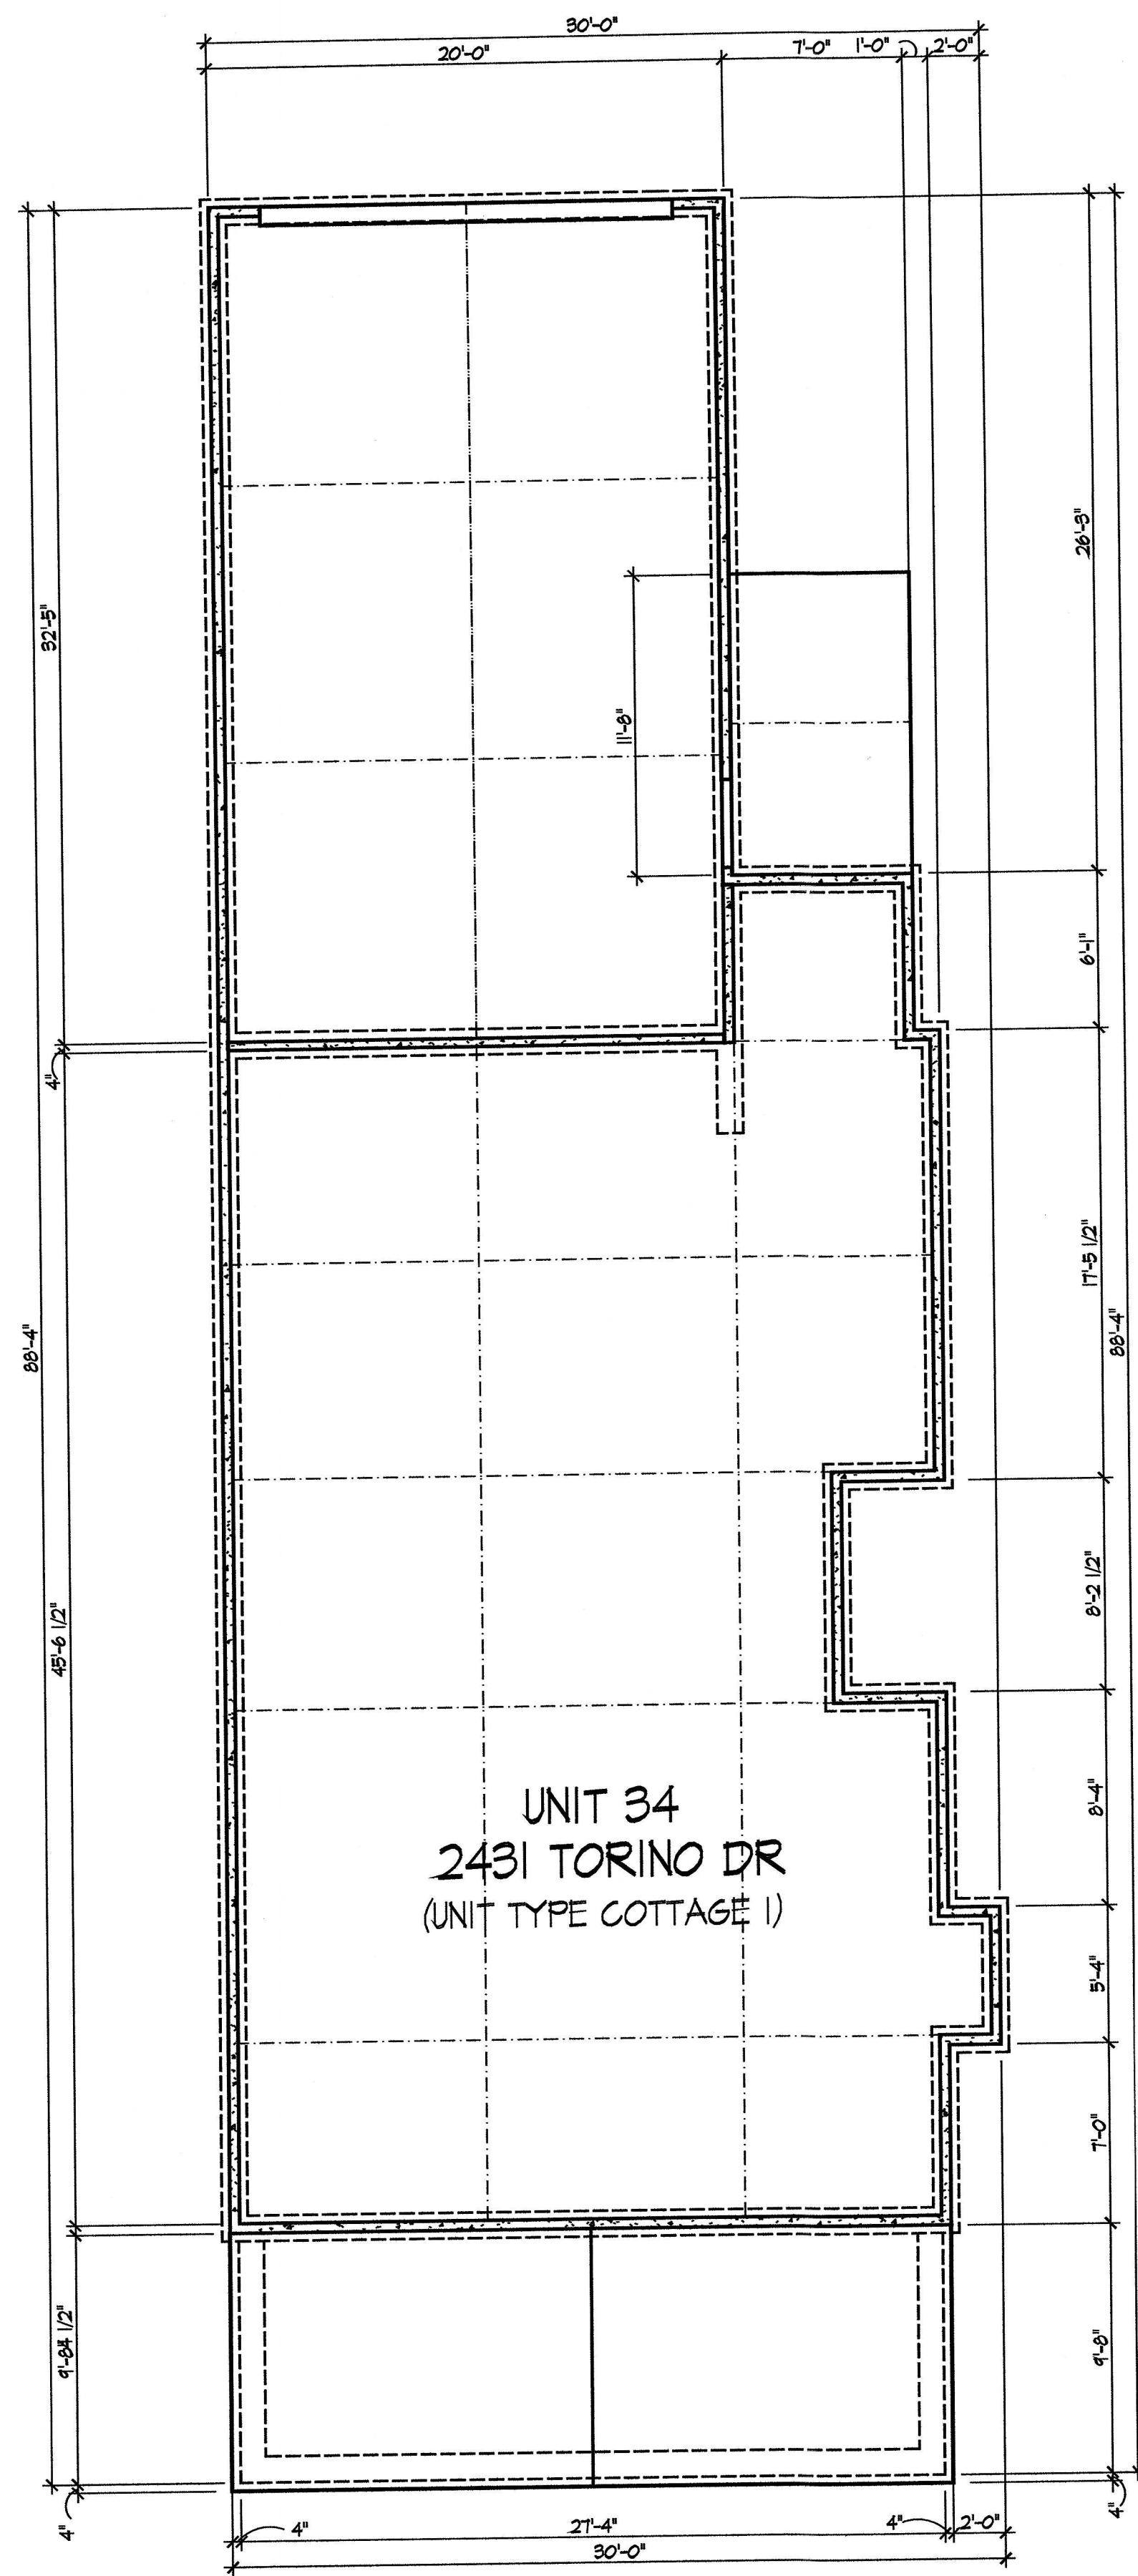


Foundation Plan

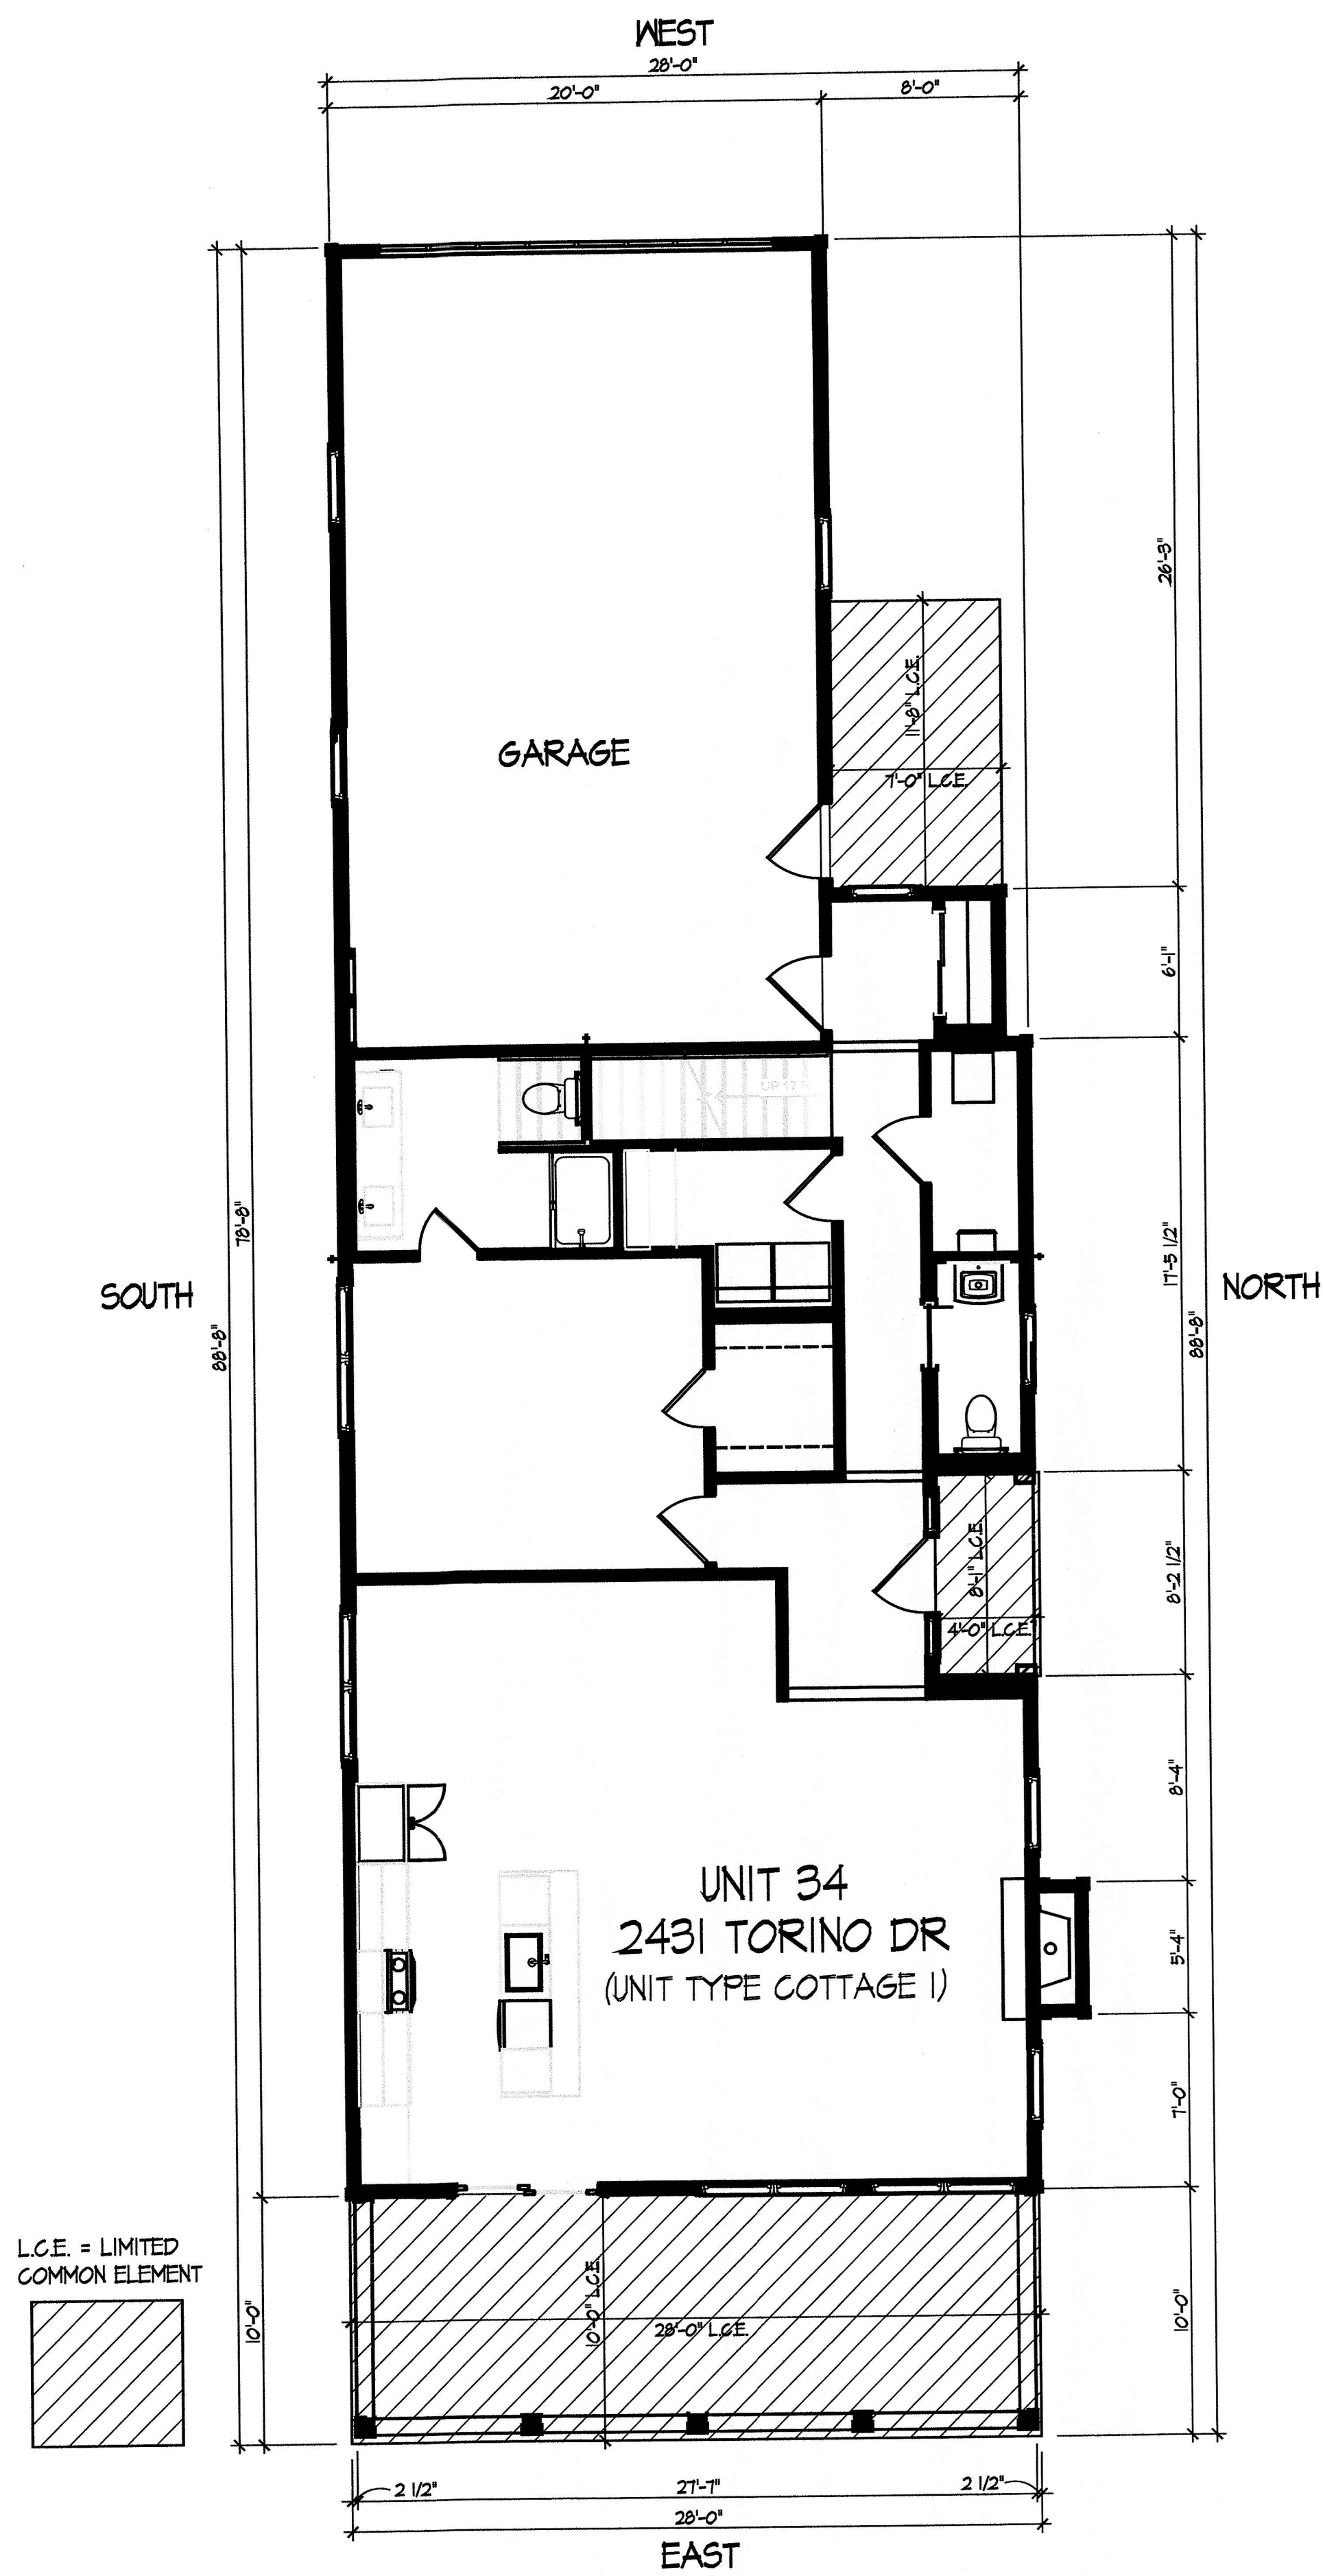

First Floor Plan

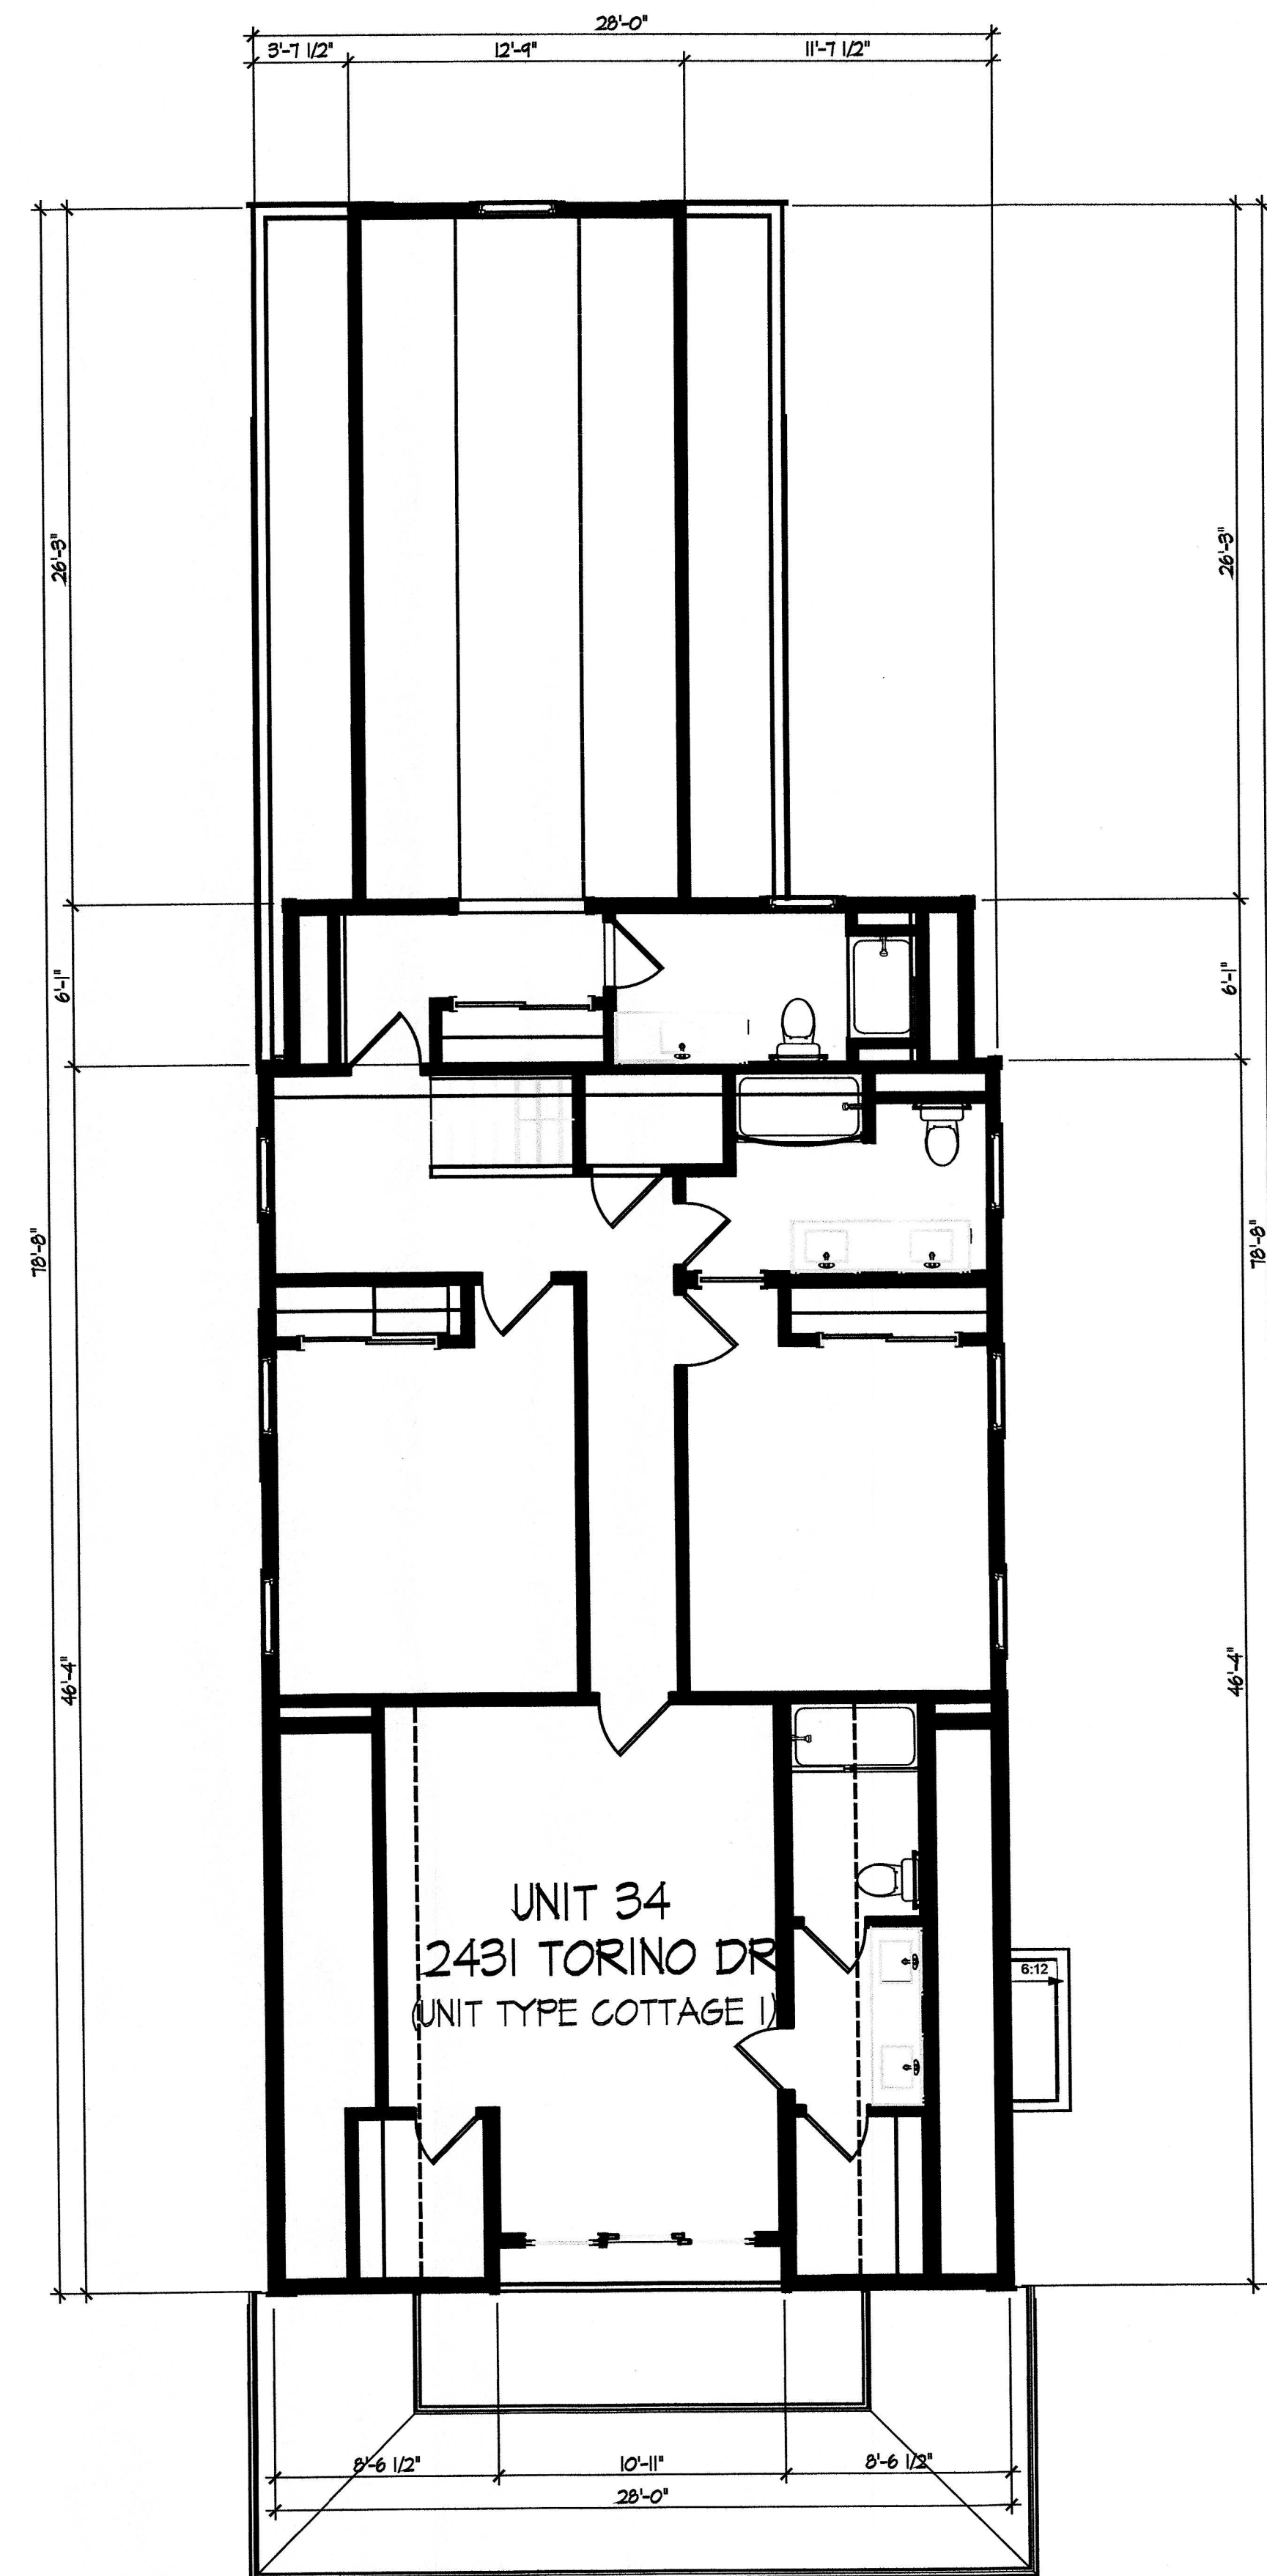

Second Floor Plan

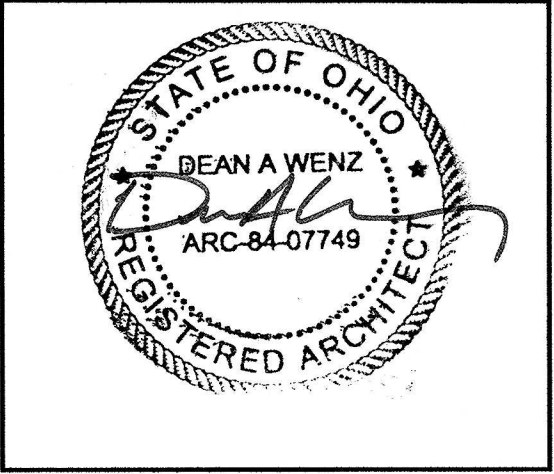

DEAN A. WENZ
ARCHITECTS

2463 E. MAIN STREET
BEXLEY, OHIO 43209
(614) 239-6868
FAX (614) 239-9868

Fairway Cottages at Catawba Island Club
Documentation Drawings
Third Amendment



DEAN A. WENZ
ARCHITECTS

2463 E. MAIN STREET
BEXLEY, OHIO 43209
(614) 239-6868
FAX (614) 239-9868

Fairway Cottages at Catawba Island Club
Documentation Drawings
Third Amendment



WEST

- 2nd Flr Ceiling Ht 19'-9"
- 2nd Flr Window Ht 17'-7 7/8"
- Second Floor 10'-7 7/8"
- 1st Flr Ceiling Ht 9'-1 1/8"
- 1st Flr Window Ht 7'-0"
- First Floor 0'-0"



- Bedrm 5 Clg Ht 17'-5"
- Bedroom 5 Flr 9'-3 7/8"
- 1st Flr Entry/Garage Clg Ht 8'-1 1/8"
- 1st Flr Window Ht 7'-0"
- First Floor 0'-0"

UNIT 34
2431 TORINO DR
(UNIT TYPE COTTAGE 1)

NORTH




EAST



SOUTH

Elevations

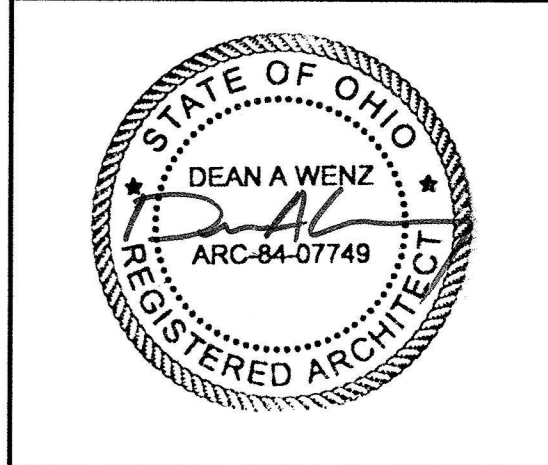


DEAN A. WENZ
ARCHITECTS

2463 E. MAIN STREET
BEXLEY, OHIO 43209
(614) 239-6868
FAX (614) 239-9868


Fairway Cottages at Catawba Island Club
Documentation Drawings
Third Amendment

Architect Project Number
2020-046A


Sheet Number
9 of 10

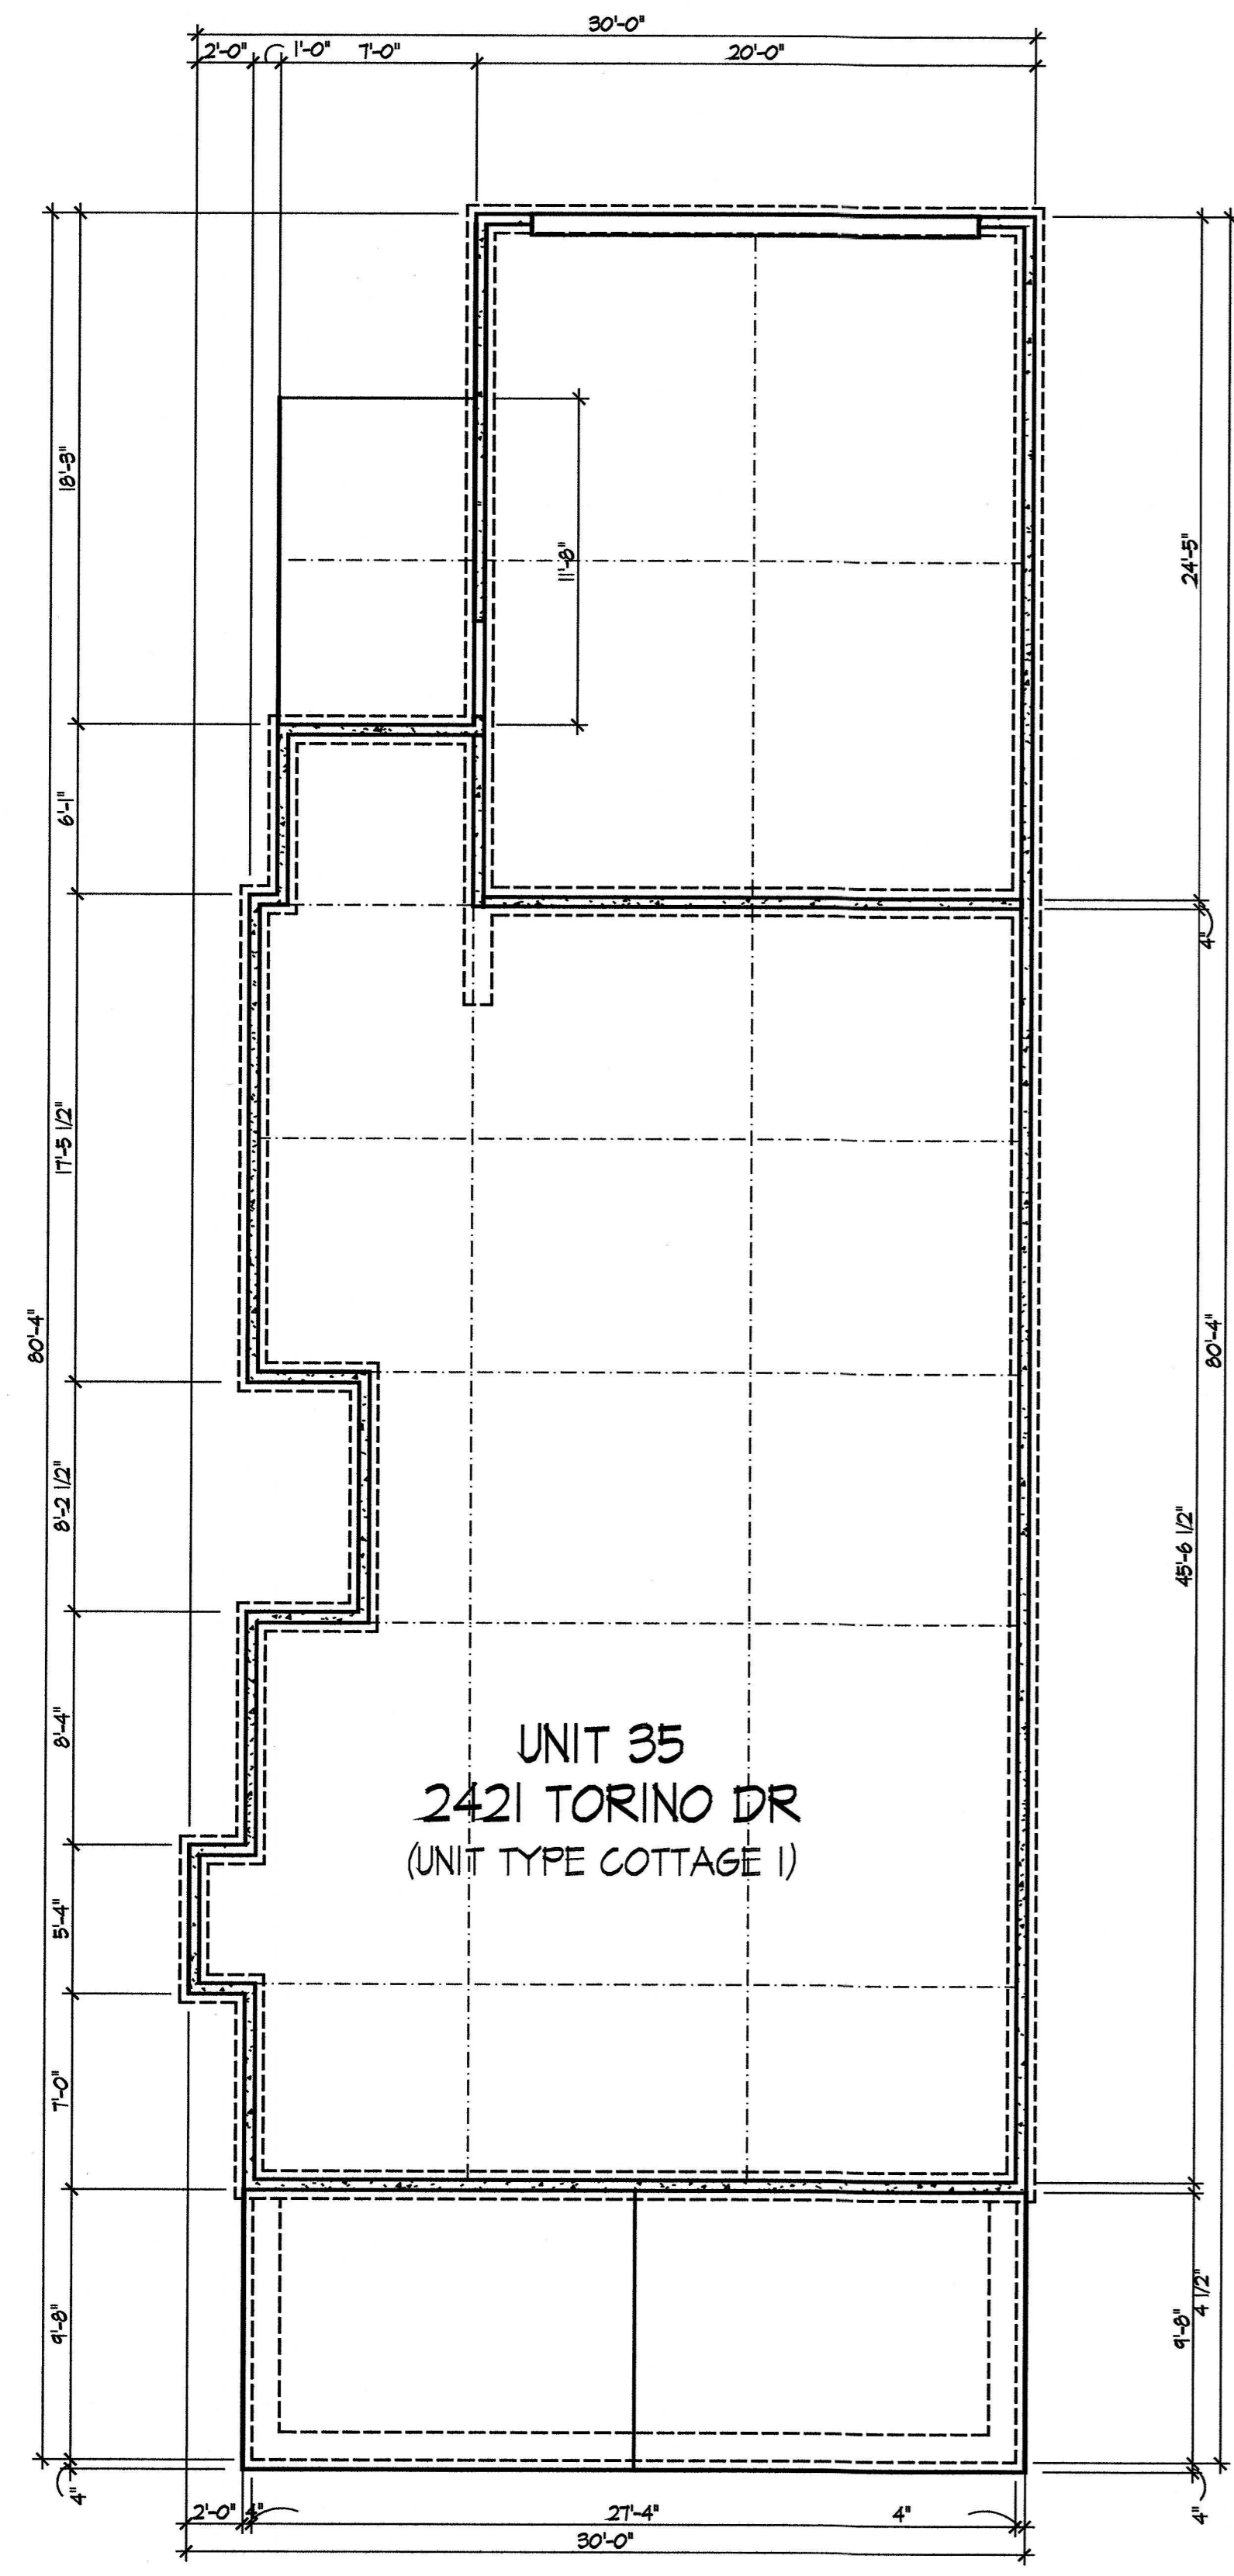


Foundation Plan

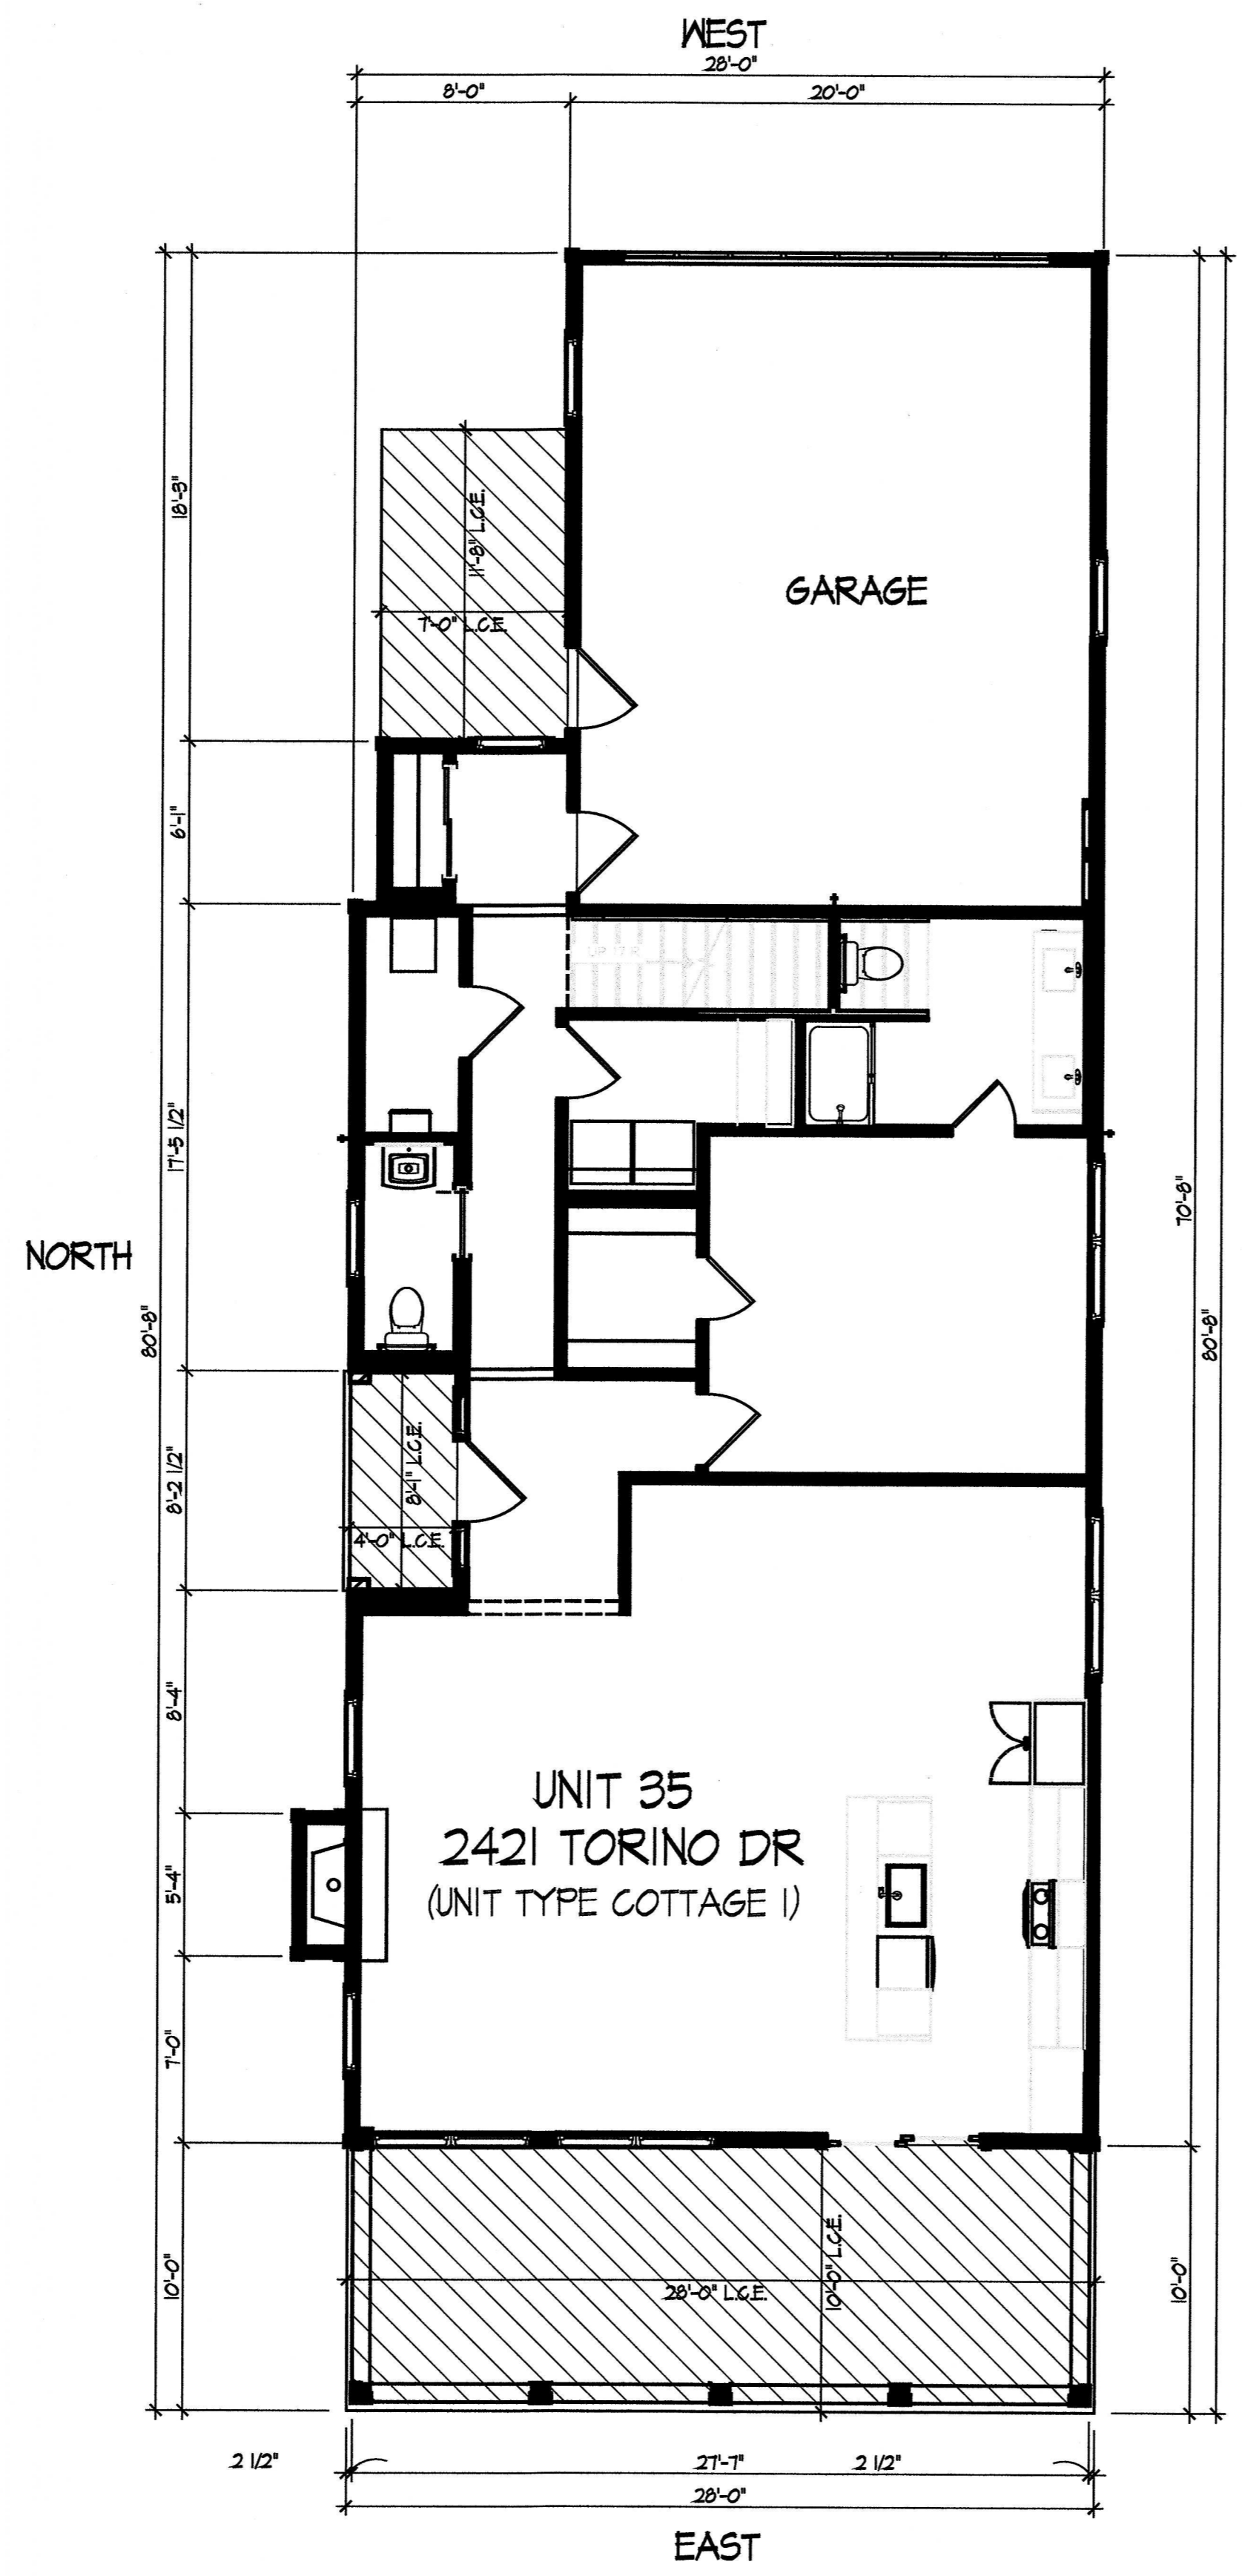

First Floor Plan

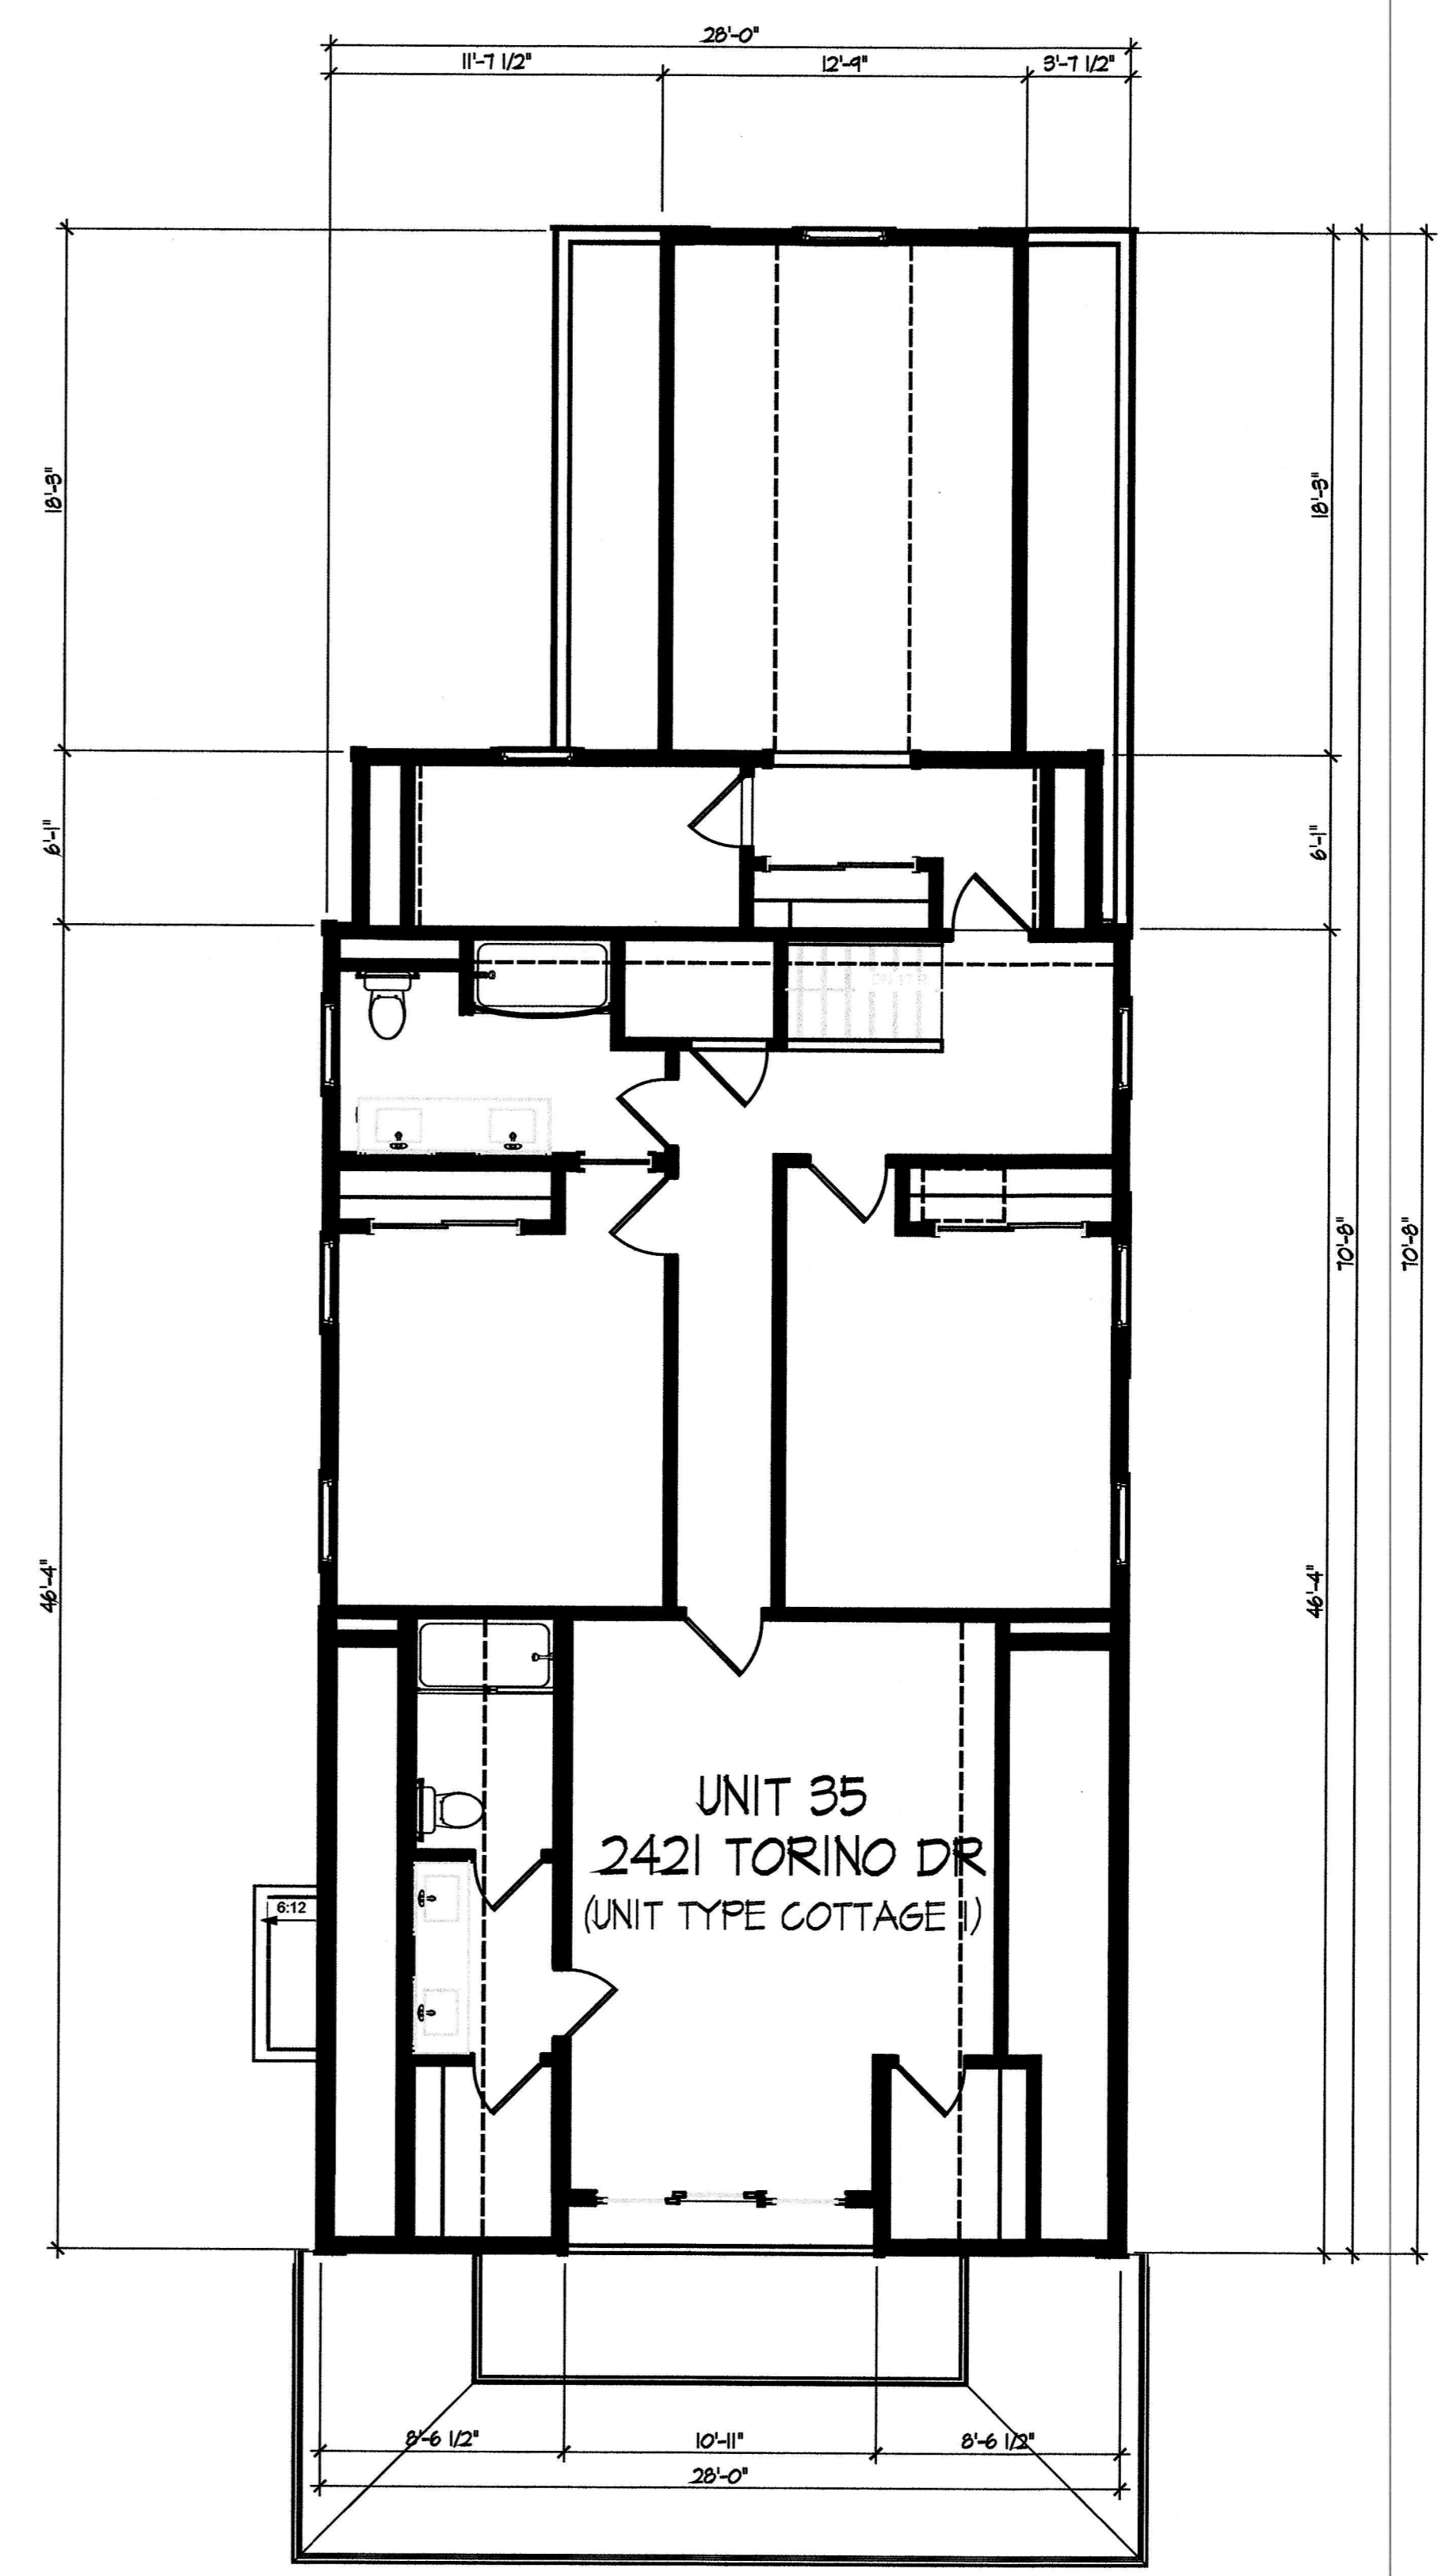


Second Floor Plan

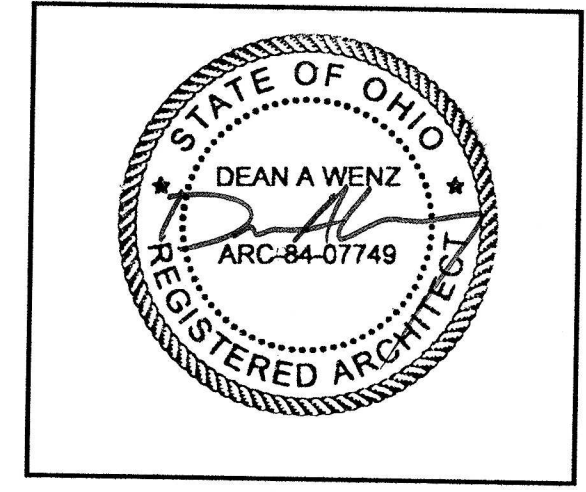

DEAN A. WENZ
ARCHITECTS

2463 E. MAIN STREET
BEXLEY, OHIO 43209
(614) 239-6868
FAX (614) 239-9868

Fairway Cottages at Catawba Island Club
 Documentation Drawings
 Third Amendment

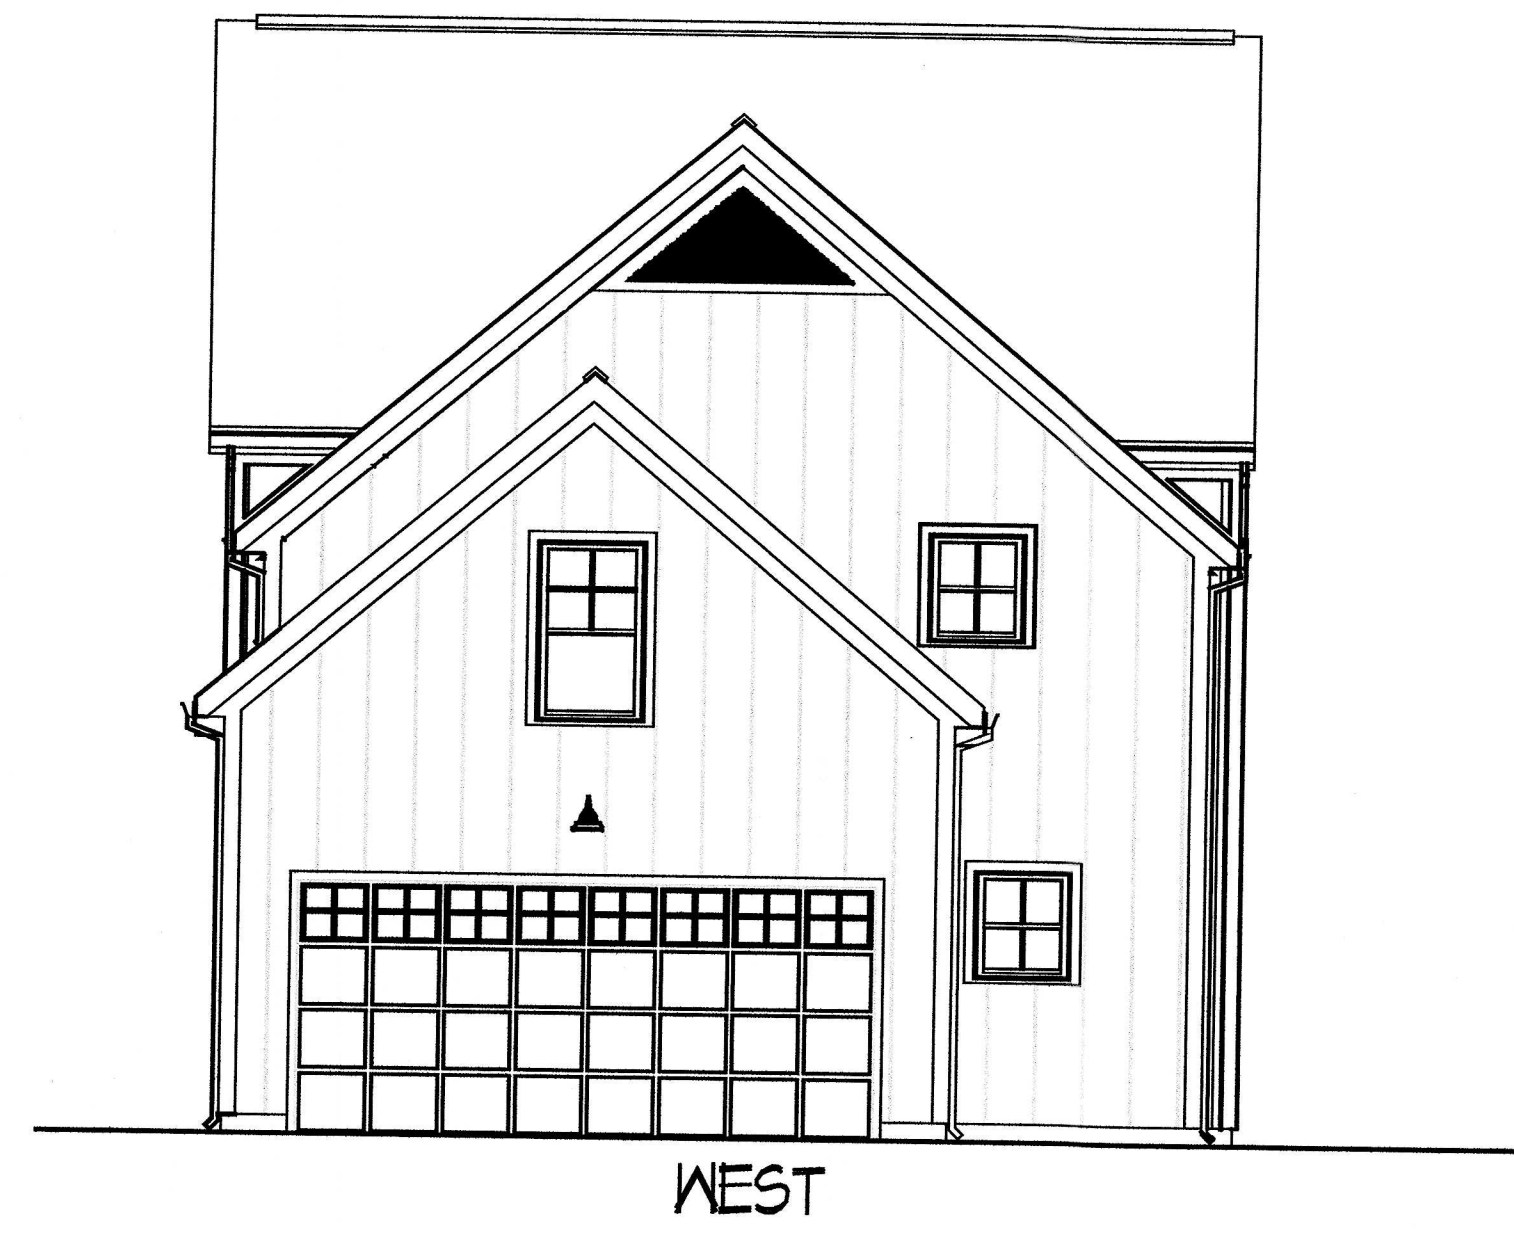

WEST



NORTH

UNIT 35
2421 TORINO DR
(UNIT TYPE COTTAGE I)

- Bedrm 5 Clg. Ht
17'-3"
- Bedroom 5 Fir
9'-3 7/8"
- 1st Fir Entry/Garage Clg Ht
8'-1 1/8"
- 1st Fir Window Ht
7'-0"
- First Floor
0'-0"

- 2nd Fir Ceiling Ht
19'-9"
- 2nd Fir Window Ht
17'-7 7/8"
- Second Floor
10'-7 7/8"
- 1st Fir Ceiling Ht
9'-1 1/8"
- 1st Fir Window Ht
7'-0"
- First Floor
0'-0"



EAST



SOUTH

Elevations

HARTUNG TITLE

Inst #20240004883

Architect Project Number
2020-046A

Sheet Number
10 of 10