



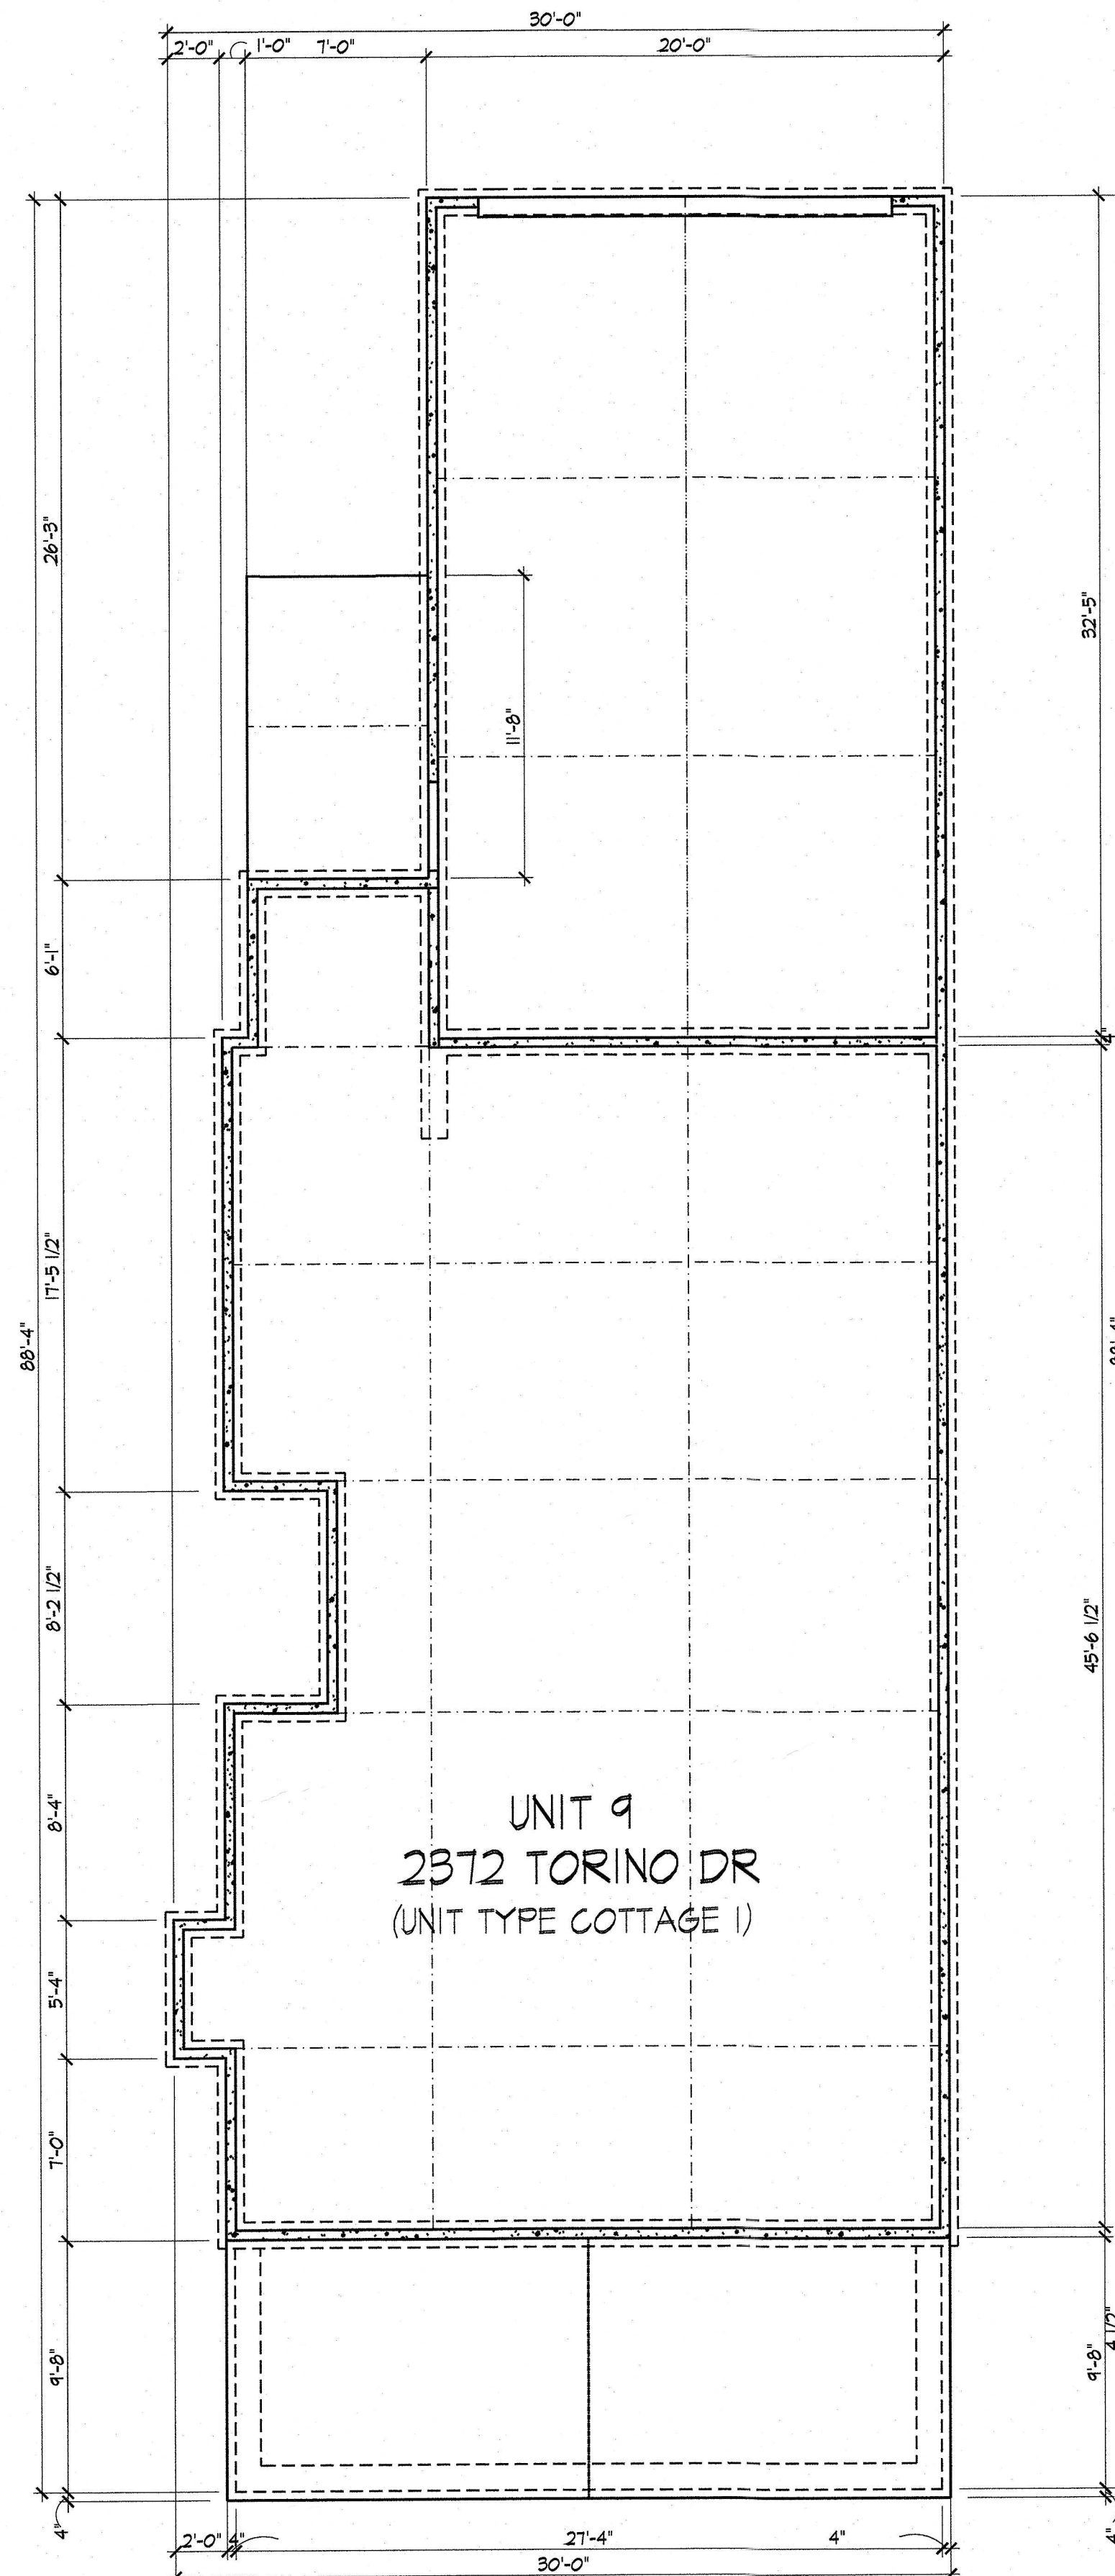


Foundation Plan



First Floor Plan

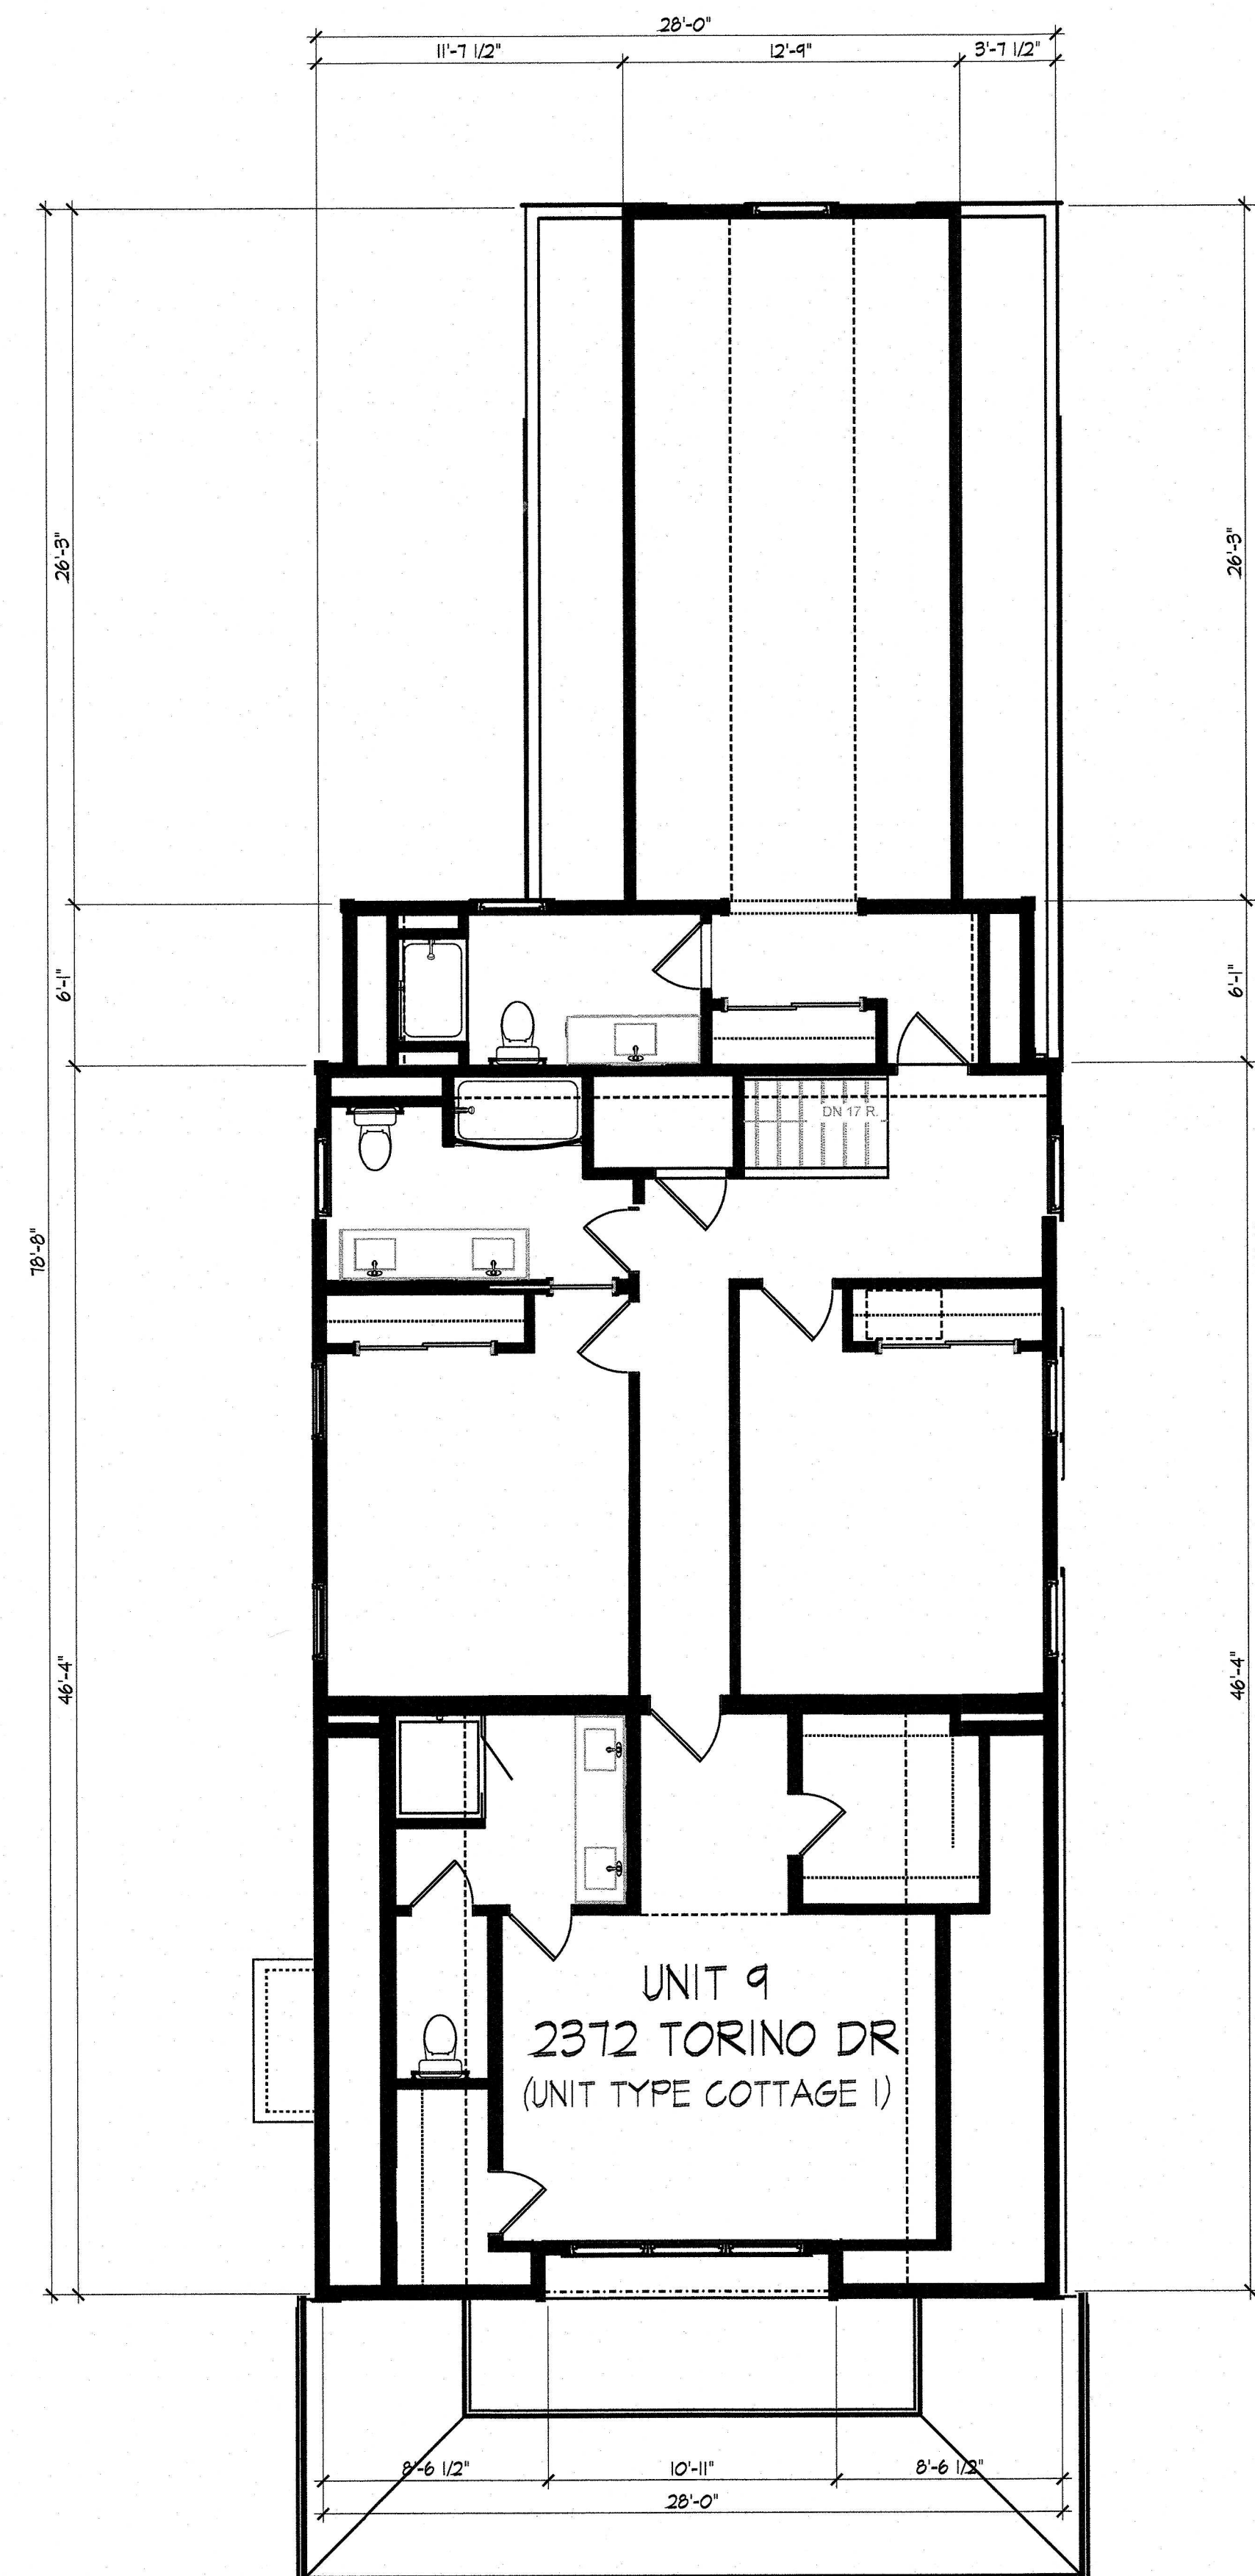

Second Floor Plan

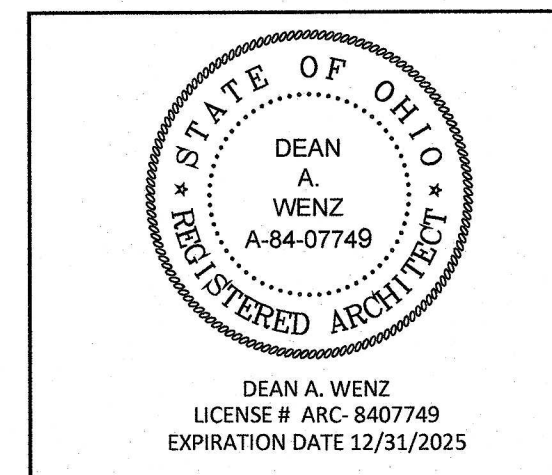

I certify that this drawing, consisting of 12 sheets (PAGES 4-15), accurately shows each building at FAIRWAY COTTAGES AT CATAWBA ISLAND CLUB UNIT OWNERS ASSOCIATION INC., as constructed with respect to the property shown on this drawing, for the sole purpose of complying with ORC 950.07.

By *Dean A. Wenz* Date 3.27.25
Dean A. Wenz - Registered Architect No. A-84-07749

DEAN A. WENZ
ARCHITECTS

323 N ARDMORE ROAD
BEXLEY, OHIO 43209
(614) 239-6868
FAX (614) 239-9868

Fairway Cottages at Catawba Island Club
Unit Owners Association, Inc.
Documentation Drawings
Fifth Amendment

Architect Project Number
2020-046A

Sheet Number
4 of 15



NORTHEAST



NORTHWEST

UNIT 9
2312 TORINO DR
(UNIT TYPE COTTAGE I)



SOUTHWEST



SOUTHEAST

Elevations

DEAN A. WENZ
ARCHITECTS


323 N ARDMORE ROAD
BEXLEY, OHIO 43209
(614) 239-6868
FAX (614) 239-9868

Fairway Cottages at Catawba Island Club
Unit Owners Association, Inc.
Documentation Drawings
Fifth Amendment


Architect Project Number
2020-046A

Sheet Number


5 of 15

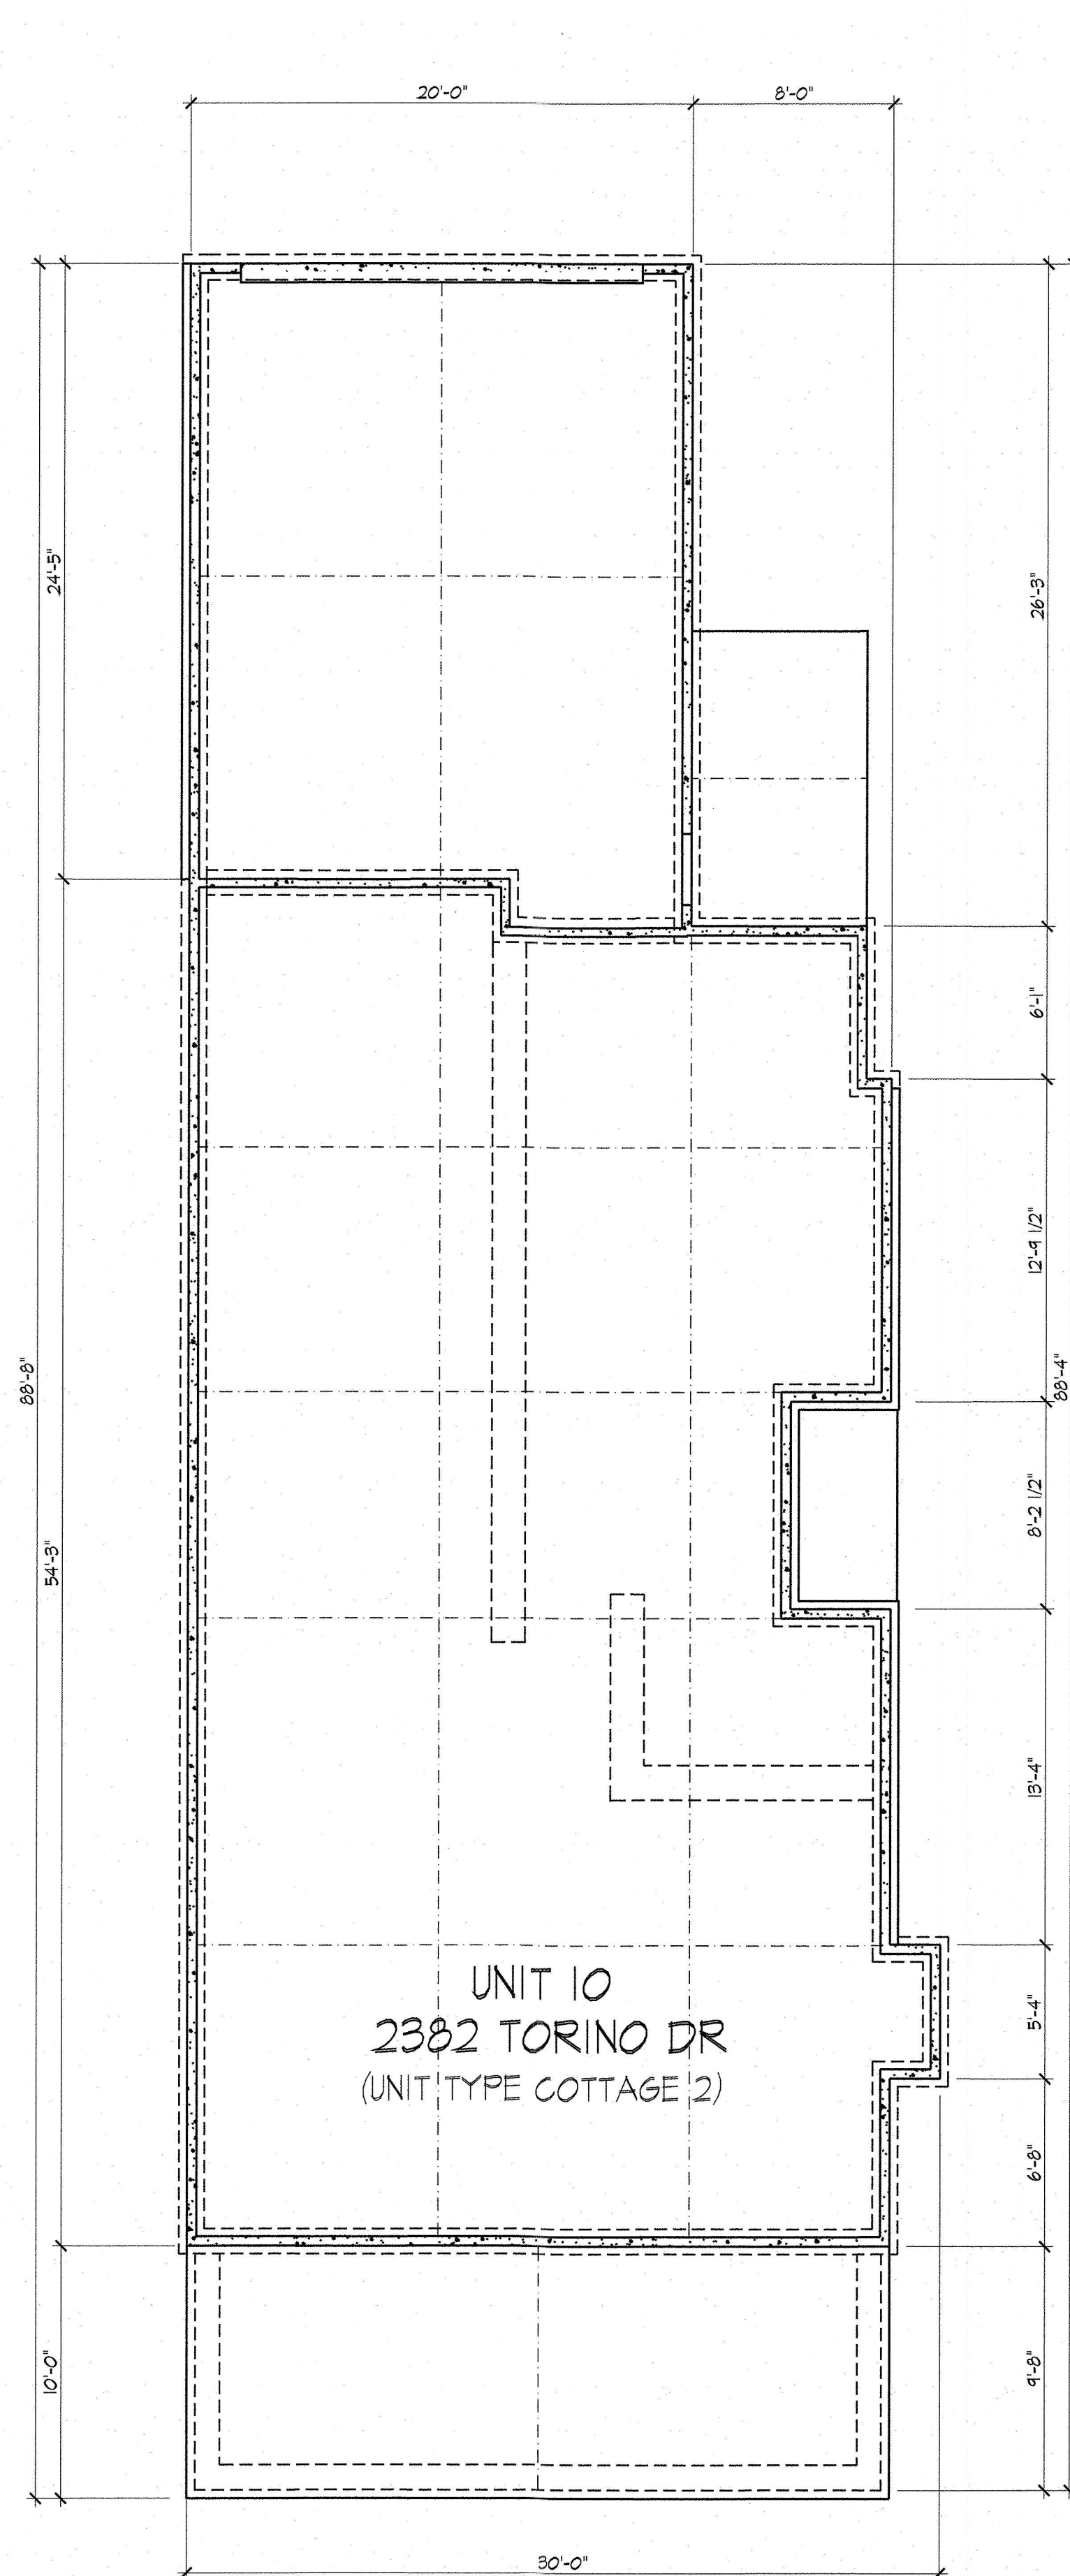

Foundation Plan

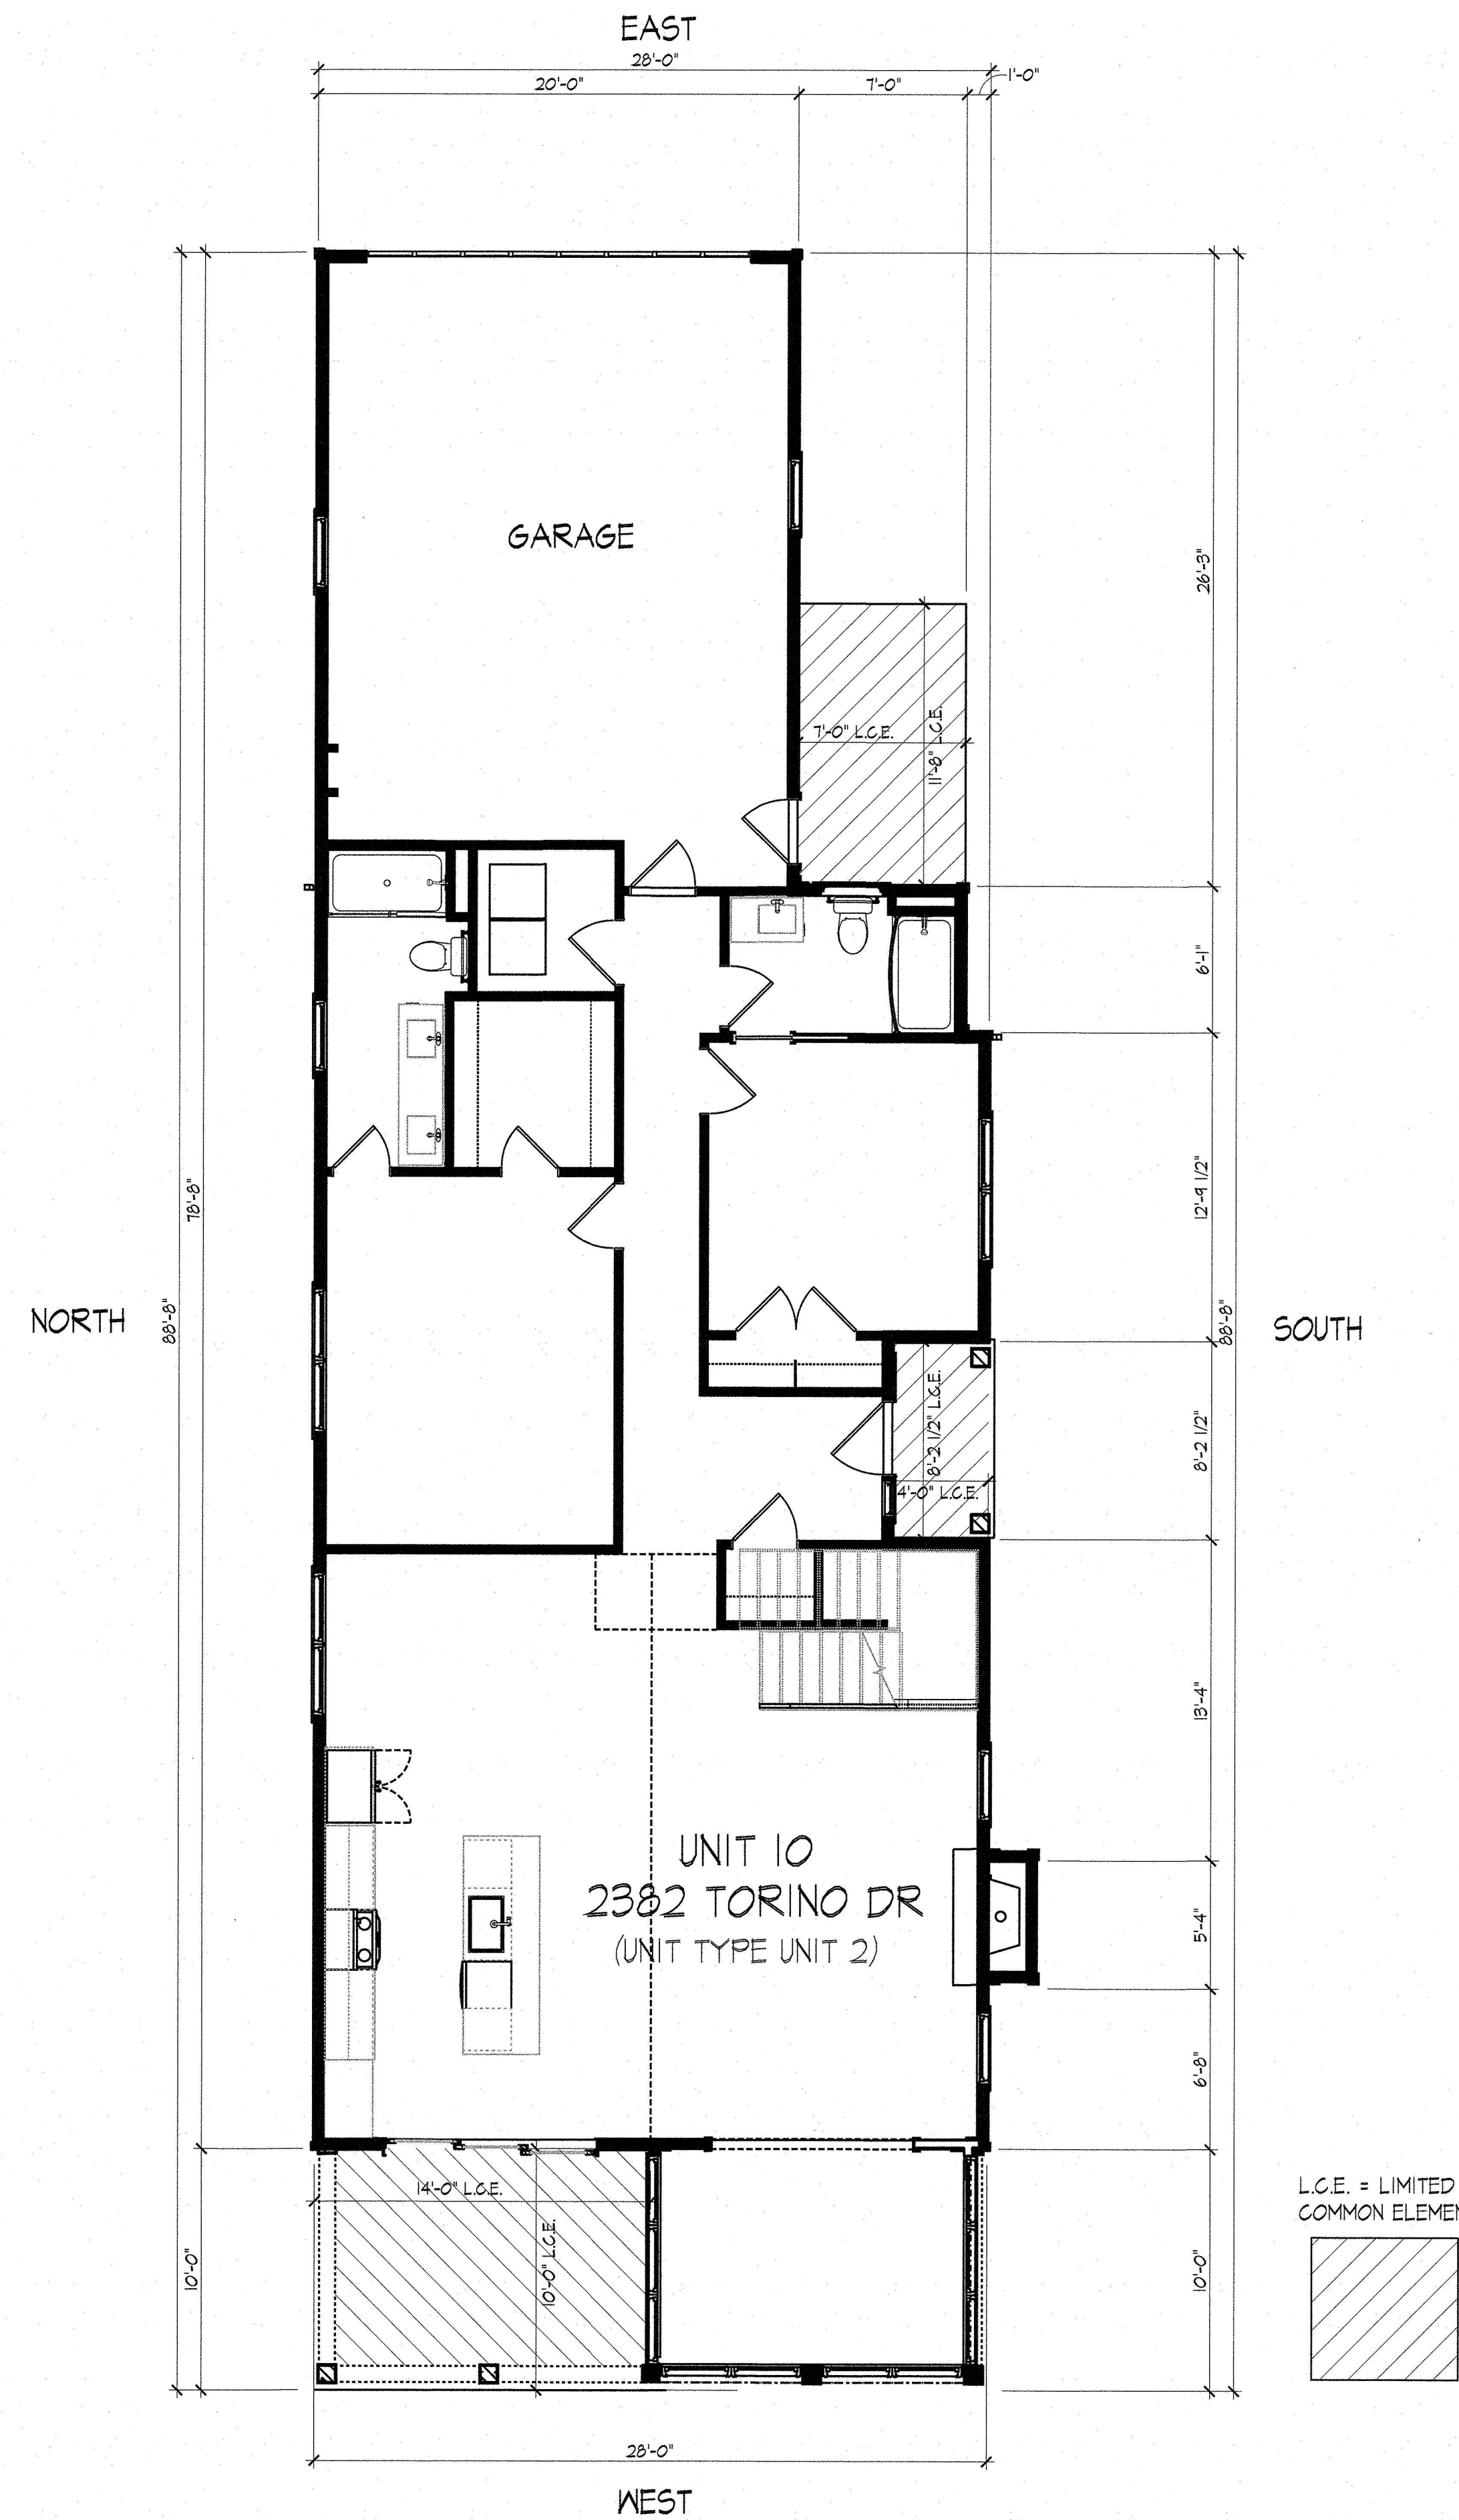

First Floor Plan

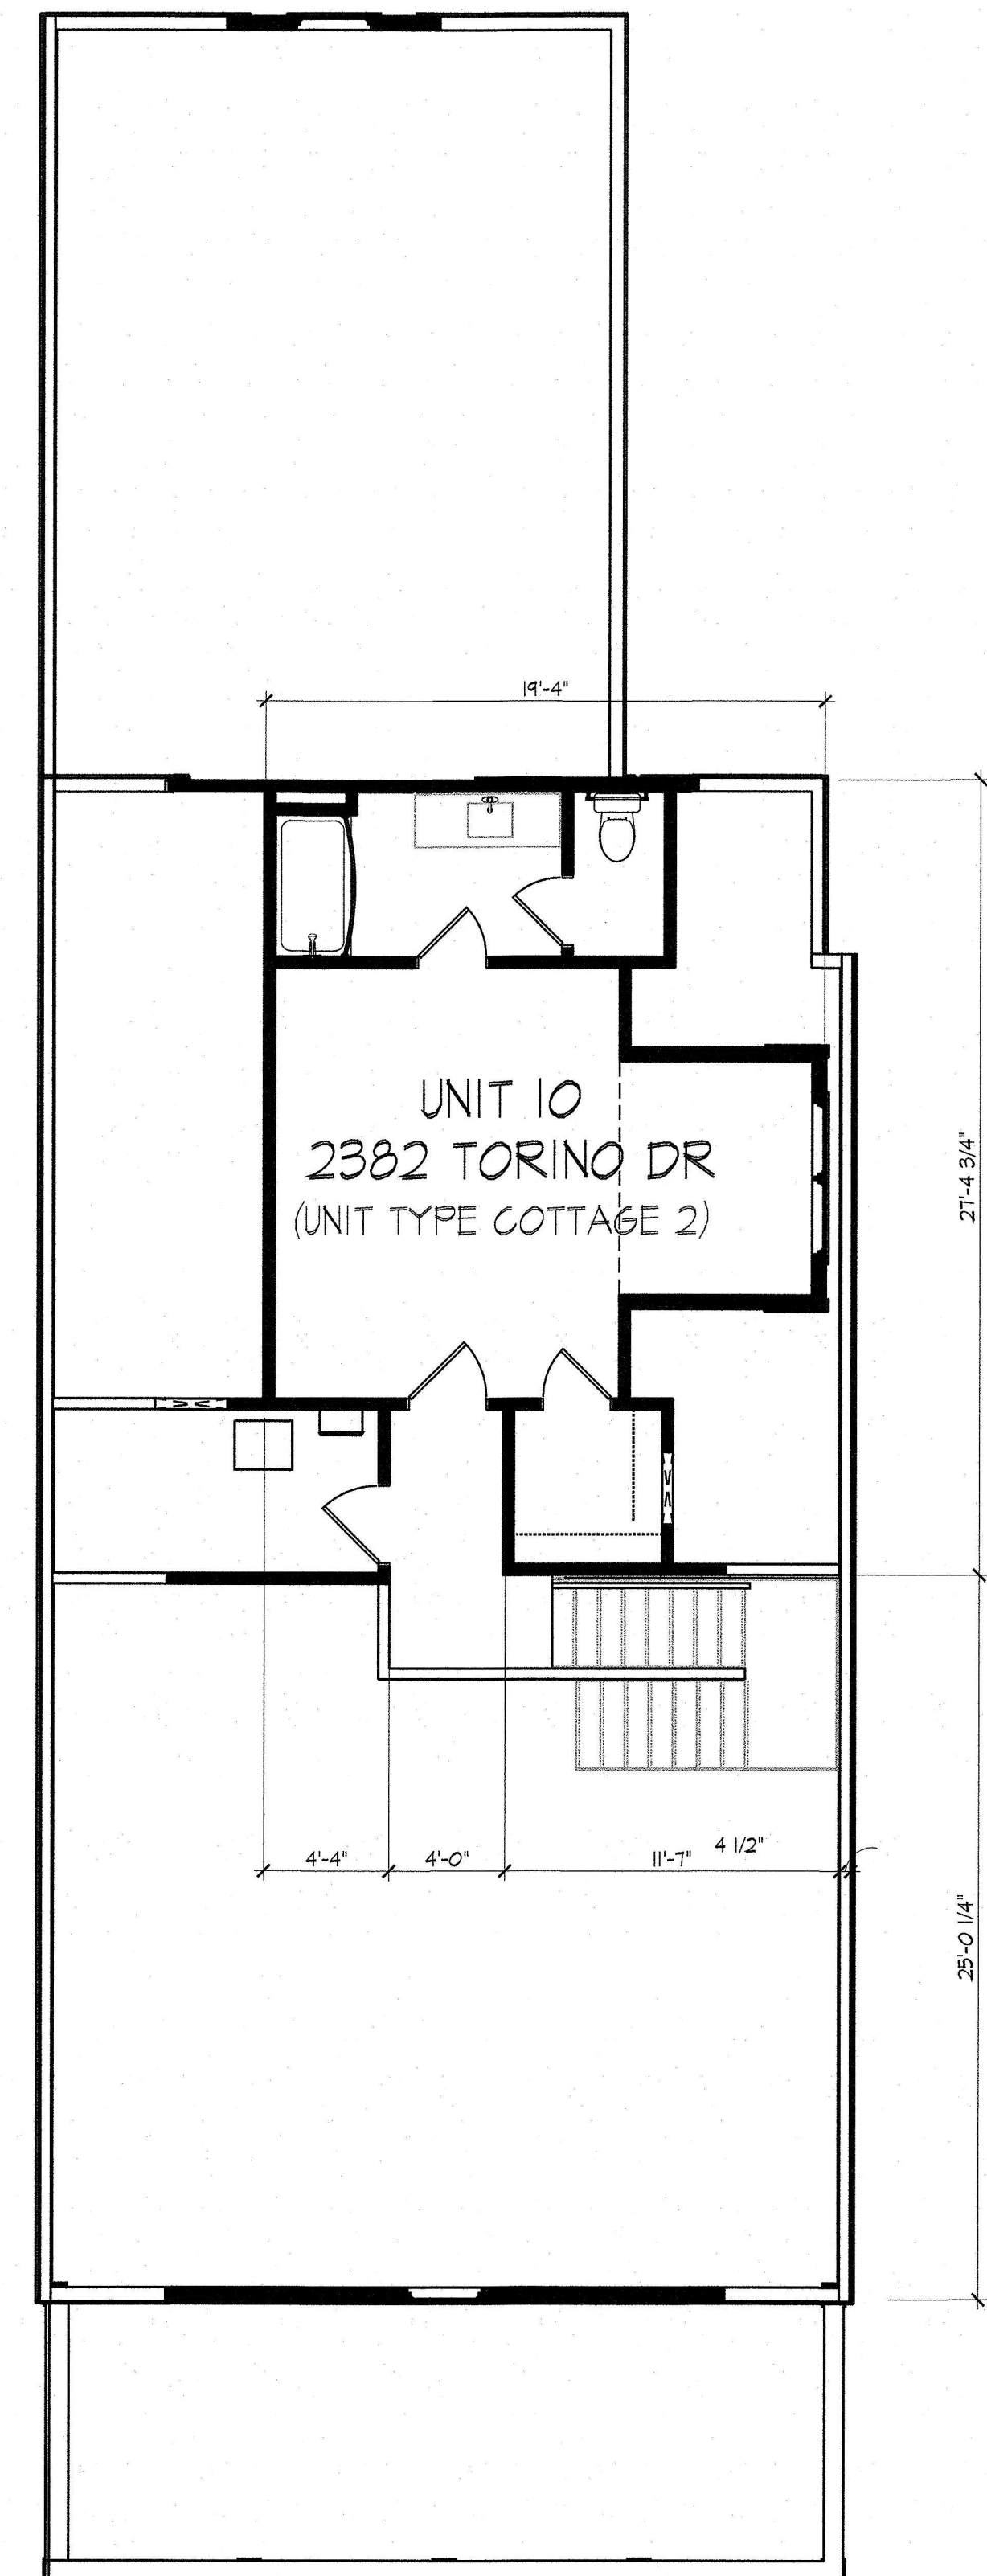

Second Floor Plan

DEAN A. WENZ
ARCHITECTS


323 N ARDMORE ROAD
BEXLEY, OHIO 43209
(614) 239-6868
FAX (614) 239-9868

Fairway Cottages at Catawba Island Club
Unit Owners Association, Inc.
Documentation Drawings
Fifth Amendment

Architect Project Number
2020-046A

Sheet Number

6 of 15

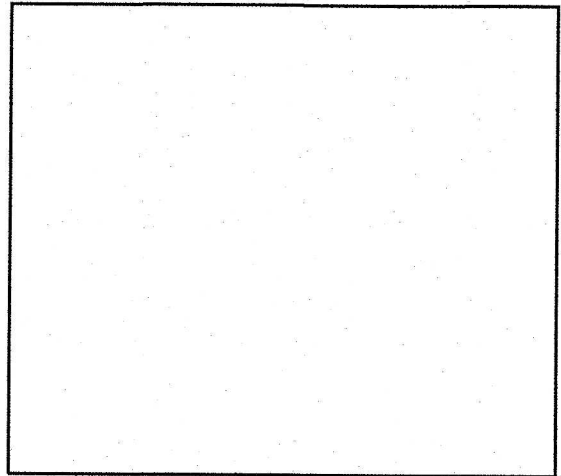

DEAN A. WENZ
ARCHITECTS

323 N ARDMORE ROAD
BEXLEY, OHIO 43209
(614) 239-6868
FAX (614) 239-9868


Fairway Cottages at Catawba Island Club
Unit Owners Association, Inc.
Documentation Drawings
Fifth Amendment

Architect Project Number
2020-046A


Sheet Number
7 of 15




Elevations

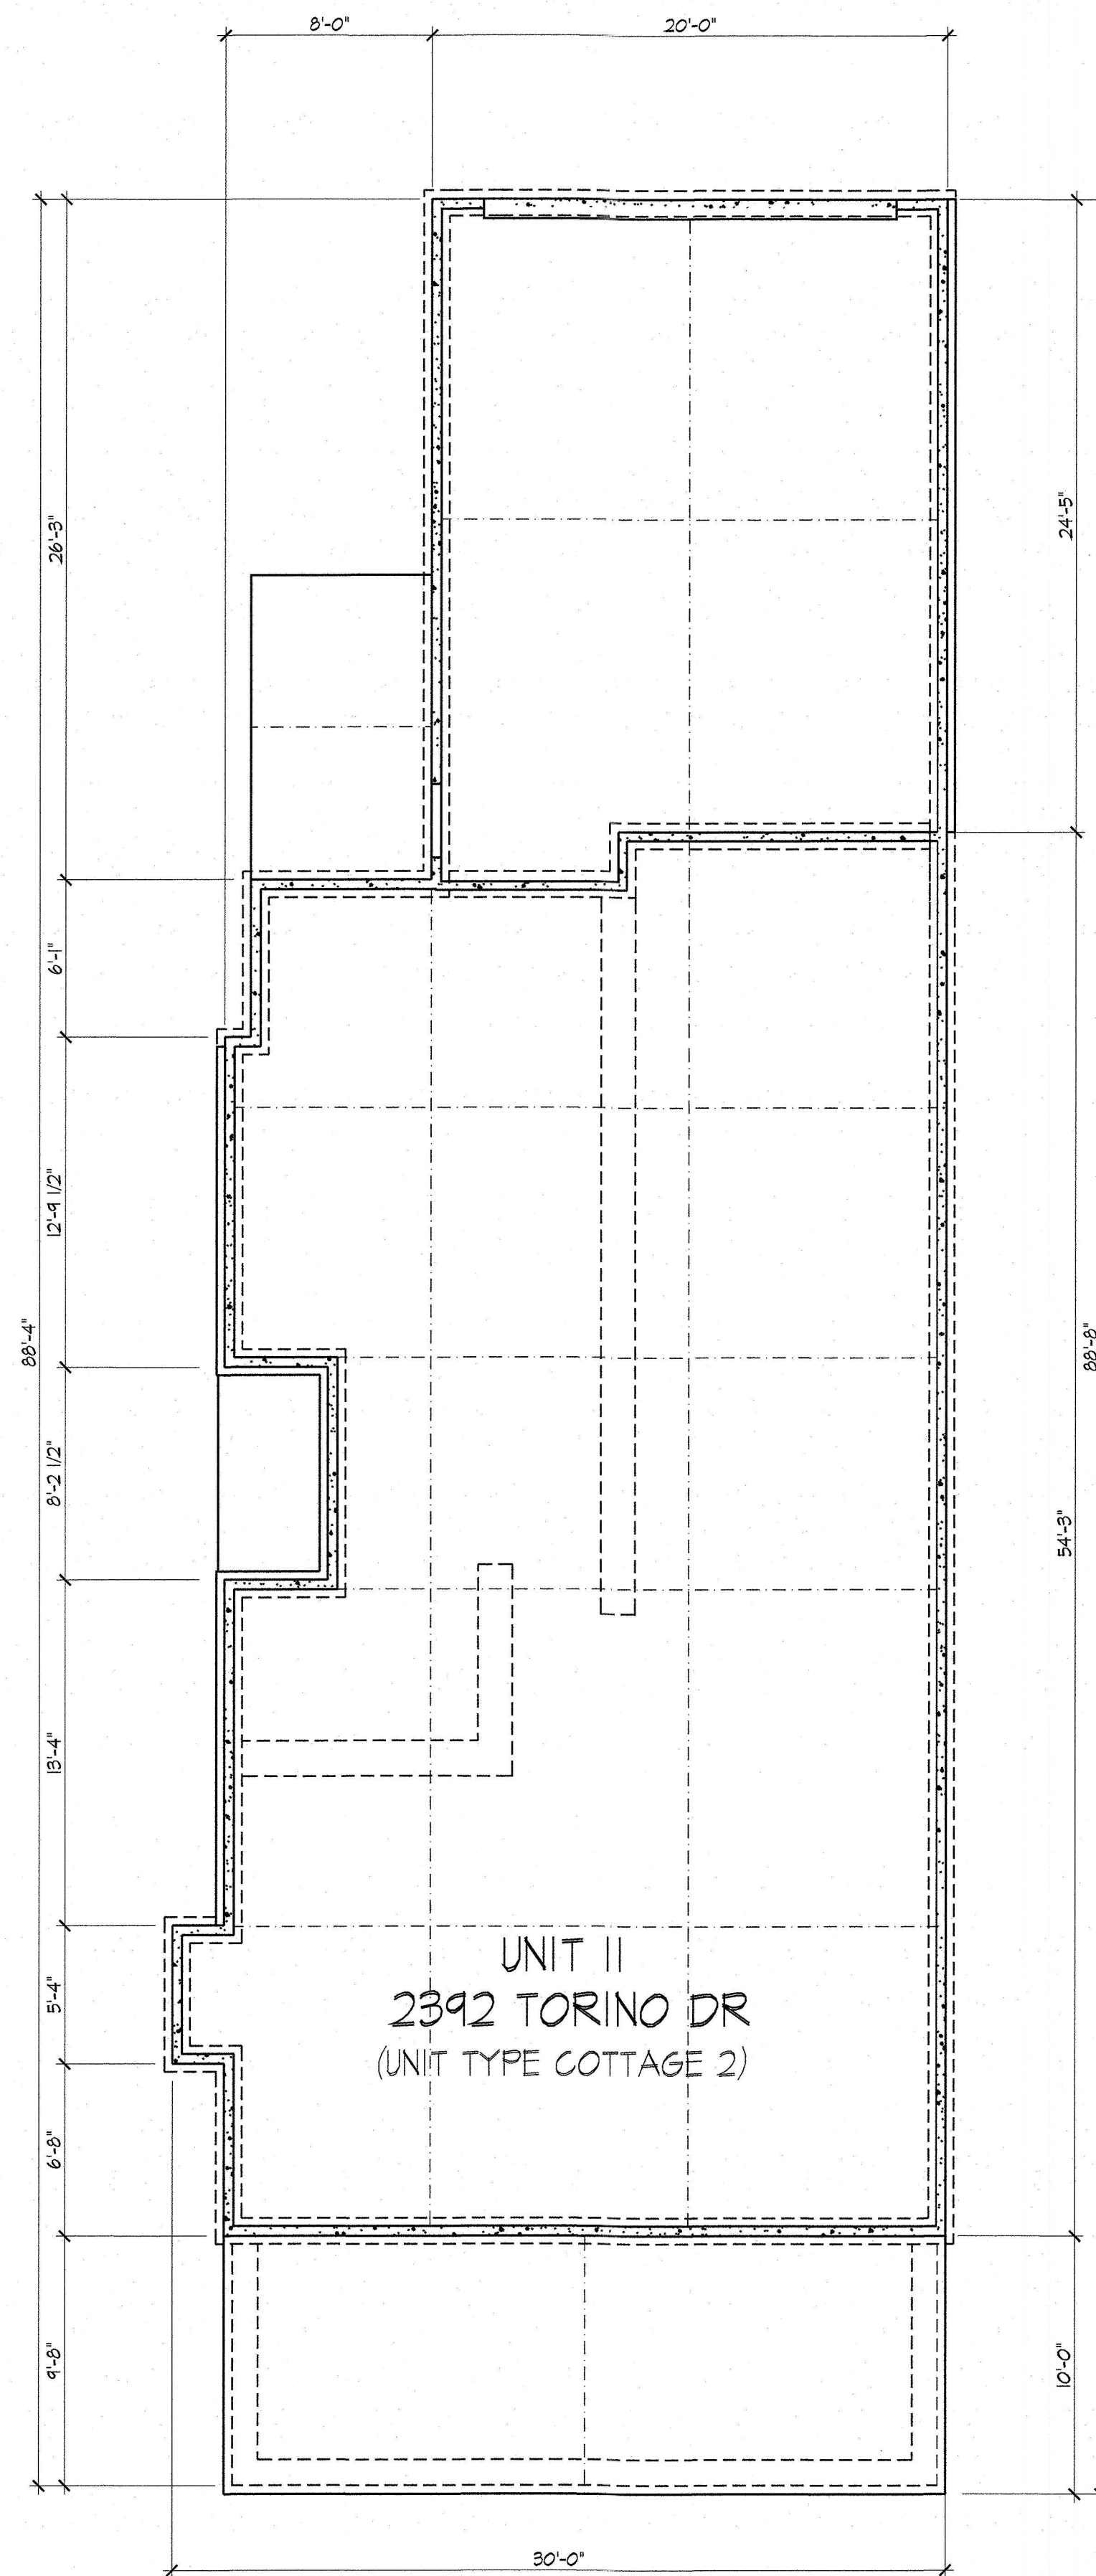

Foundation Plan

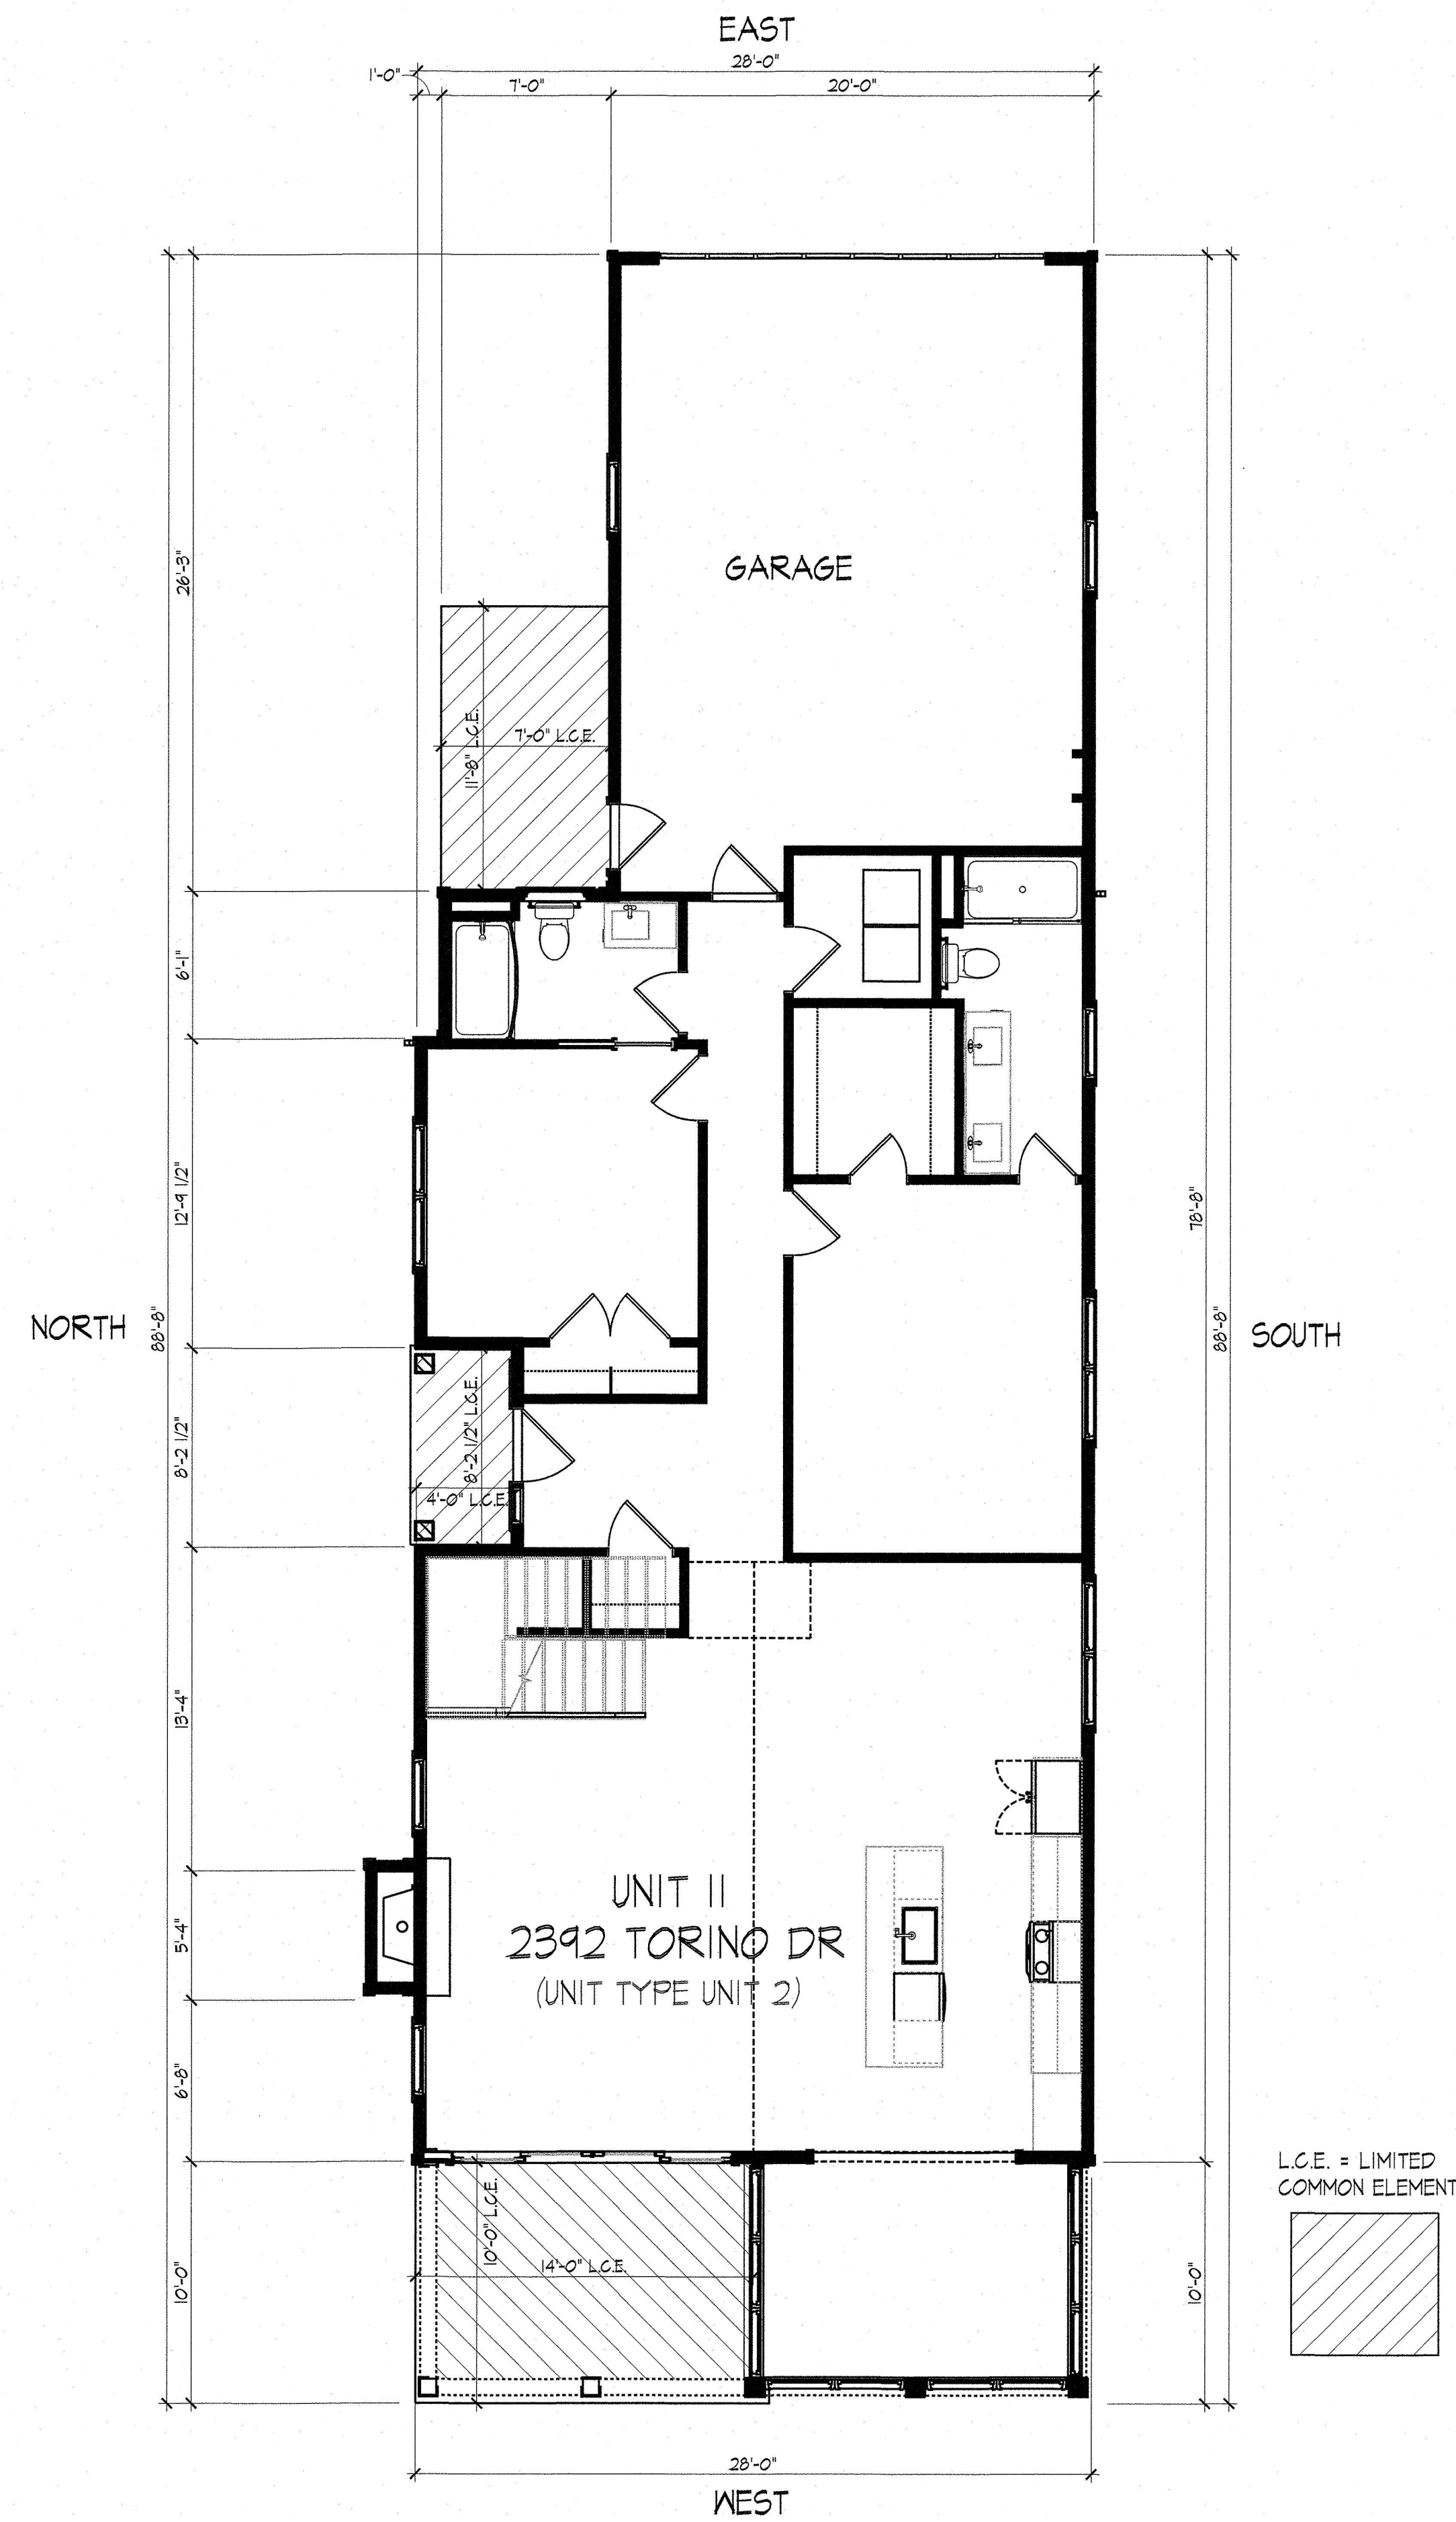

First Floor Plan

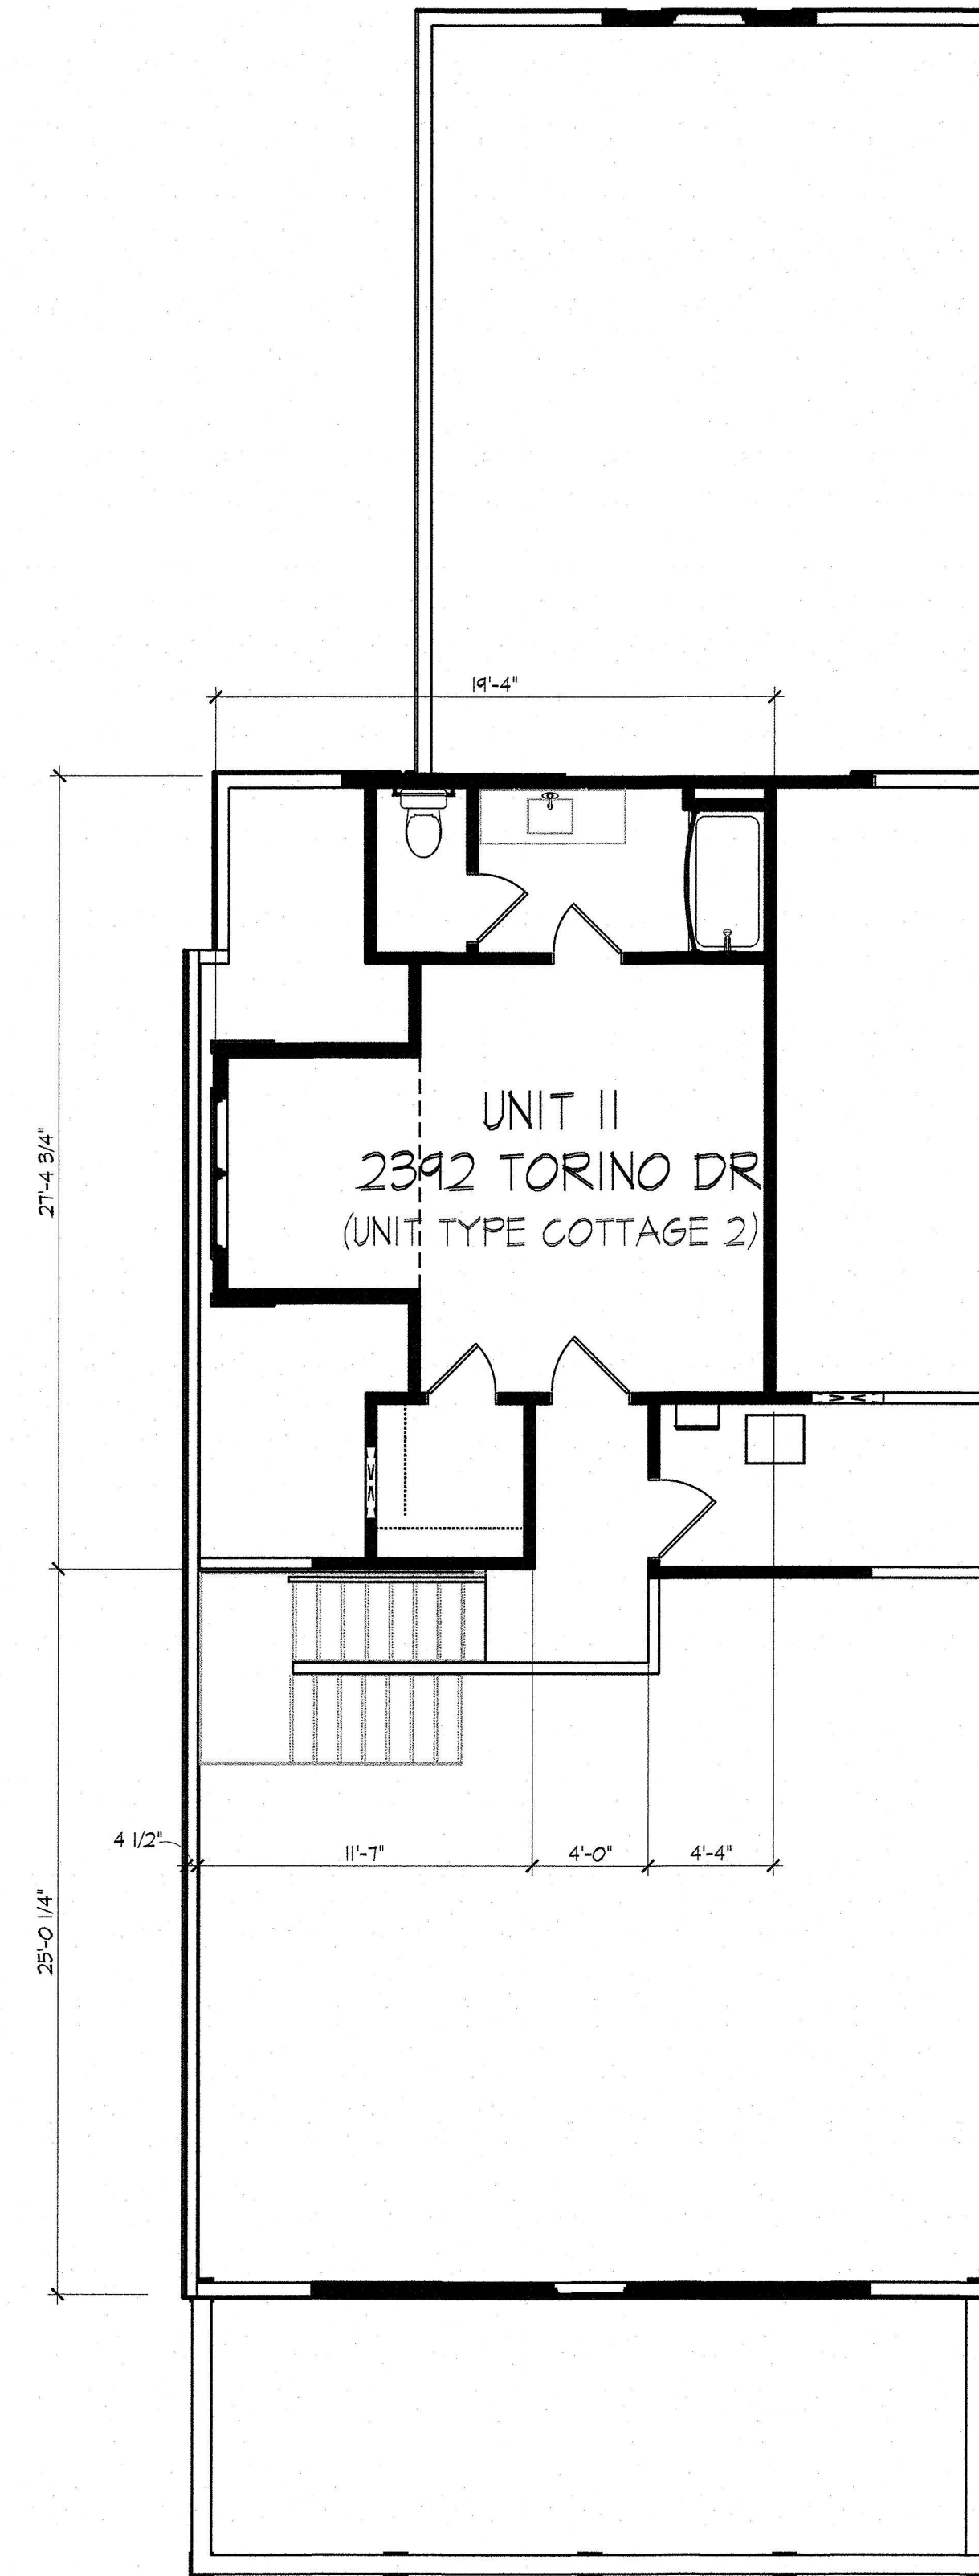

Second Floor Plan

DEAN A. WENZ
ARCHITECTS

323 N ARDMORE ROAD
BEXLEY, OHIO 43209
(614) 239-6868
FAX (614) 239-9868

Fairway Cottages at Catawba Island Club
Unit Owners Association, Inc.
Documentation Drawings
Fifth Amendment

Architect Project Number
2020-046A

Sheet Number
8 of 15




WEST




NORTH

UNIT II
2392 TORINO DR
(UNIT TYPE COTTAGE 2)

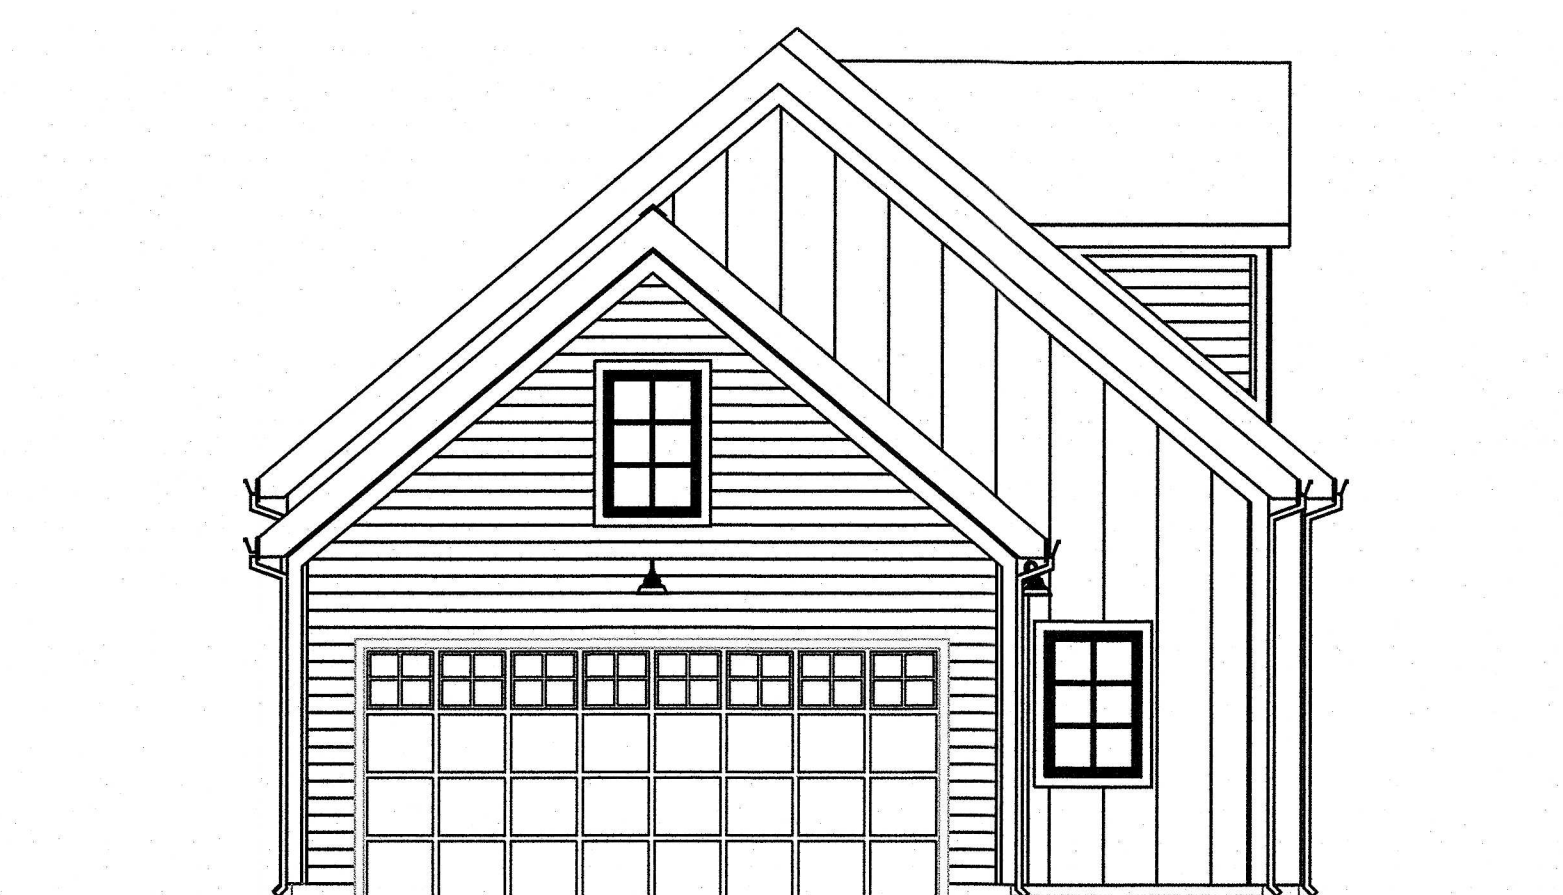

EAST

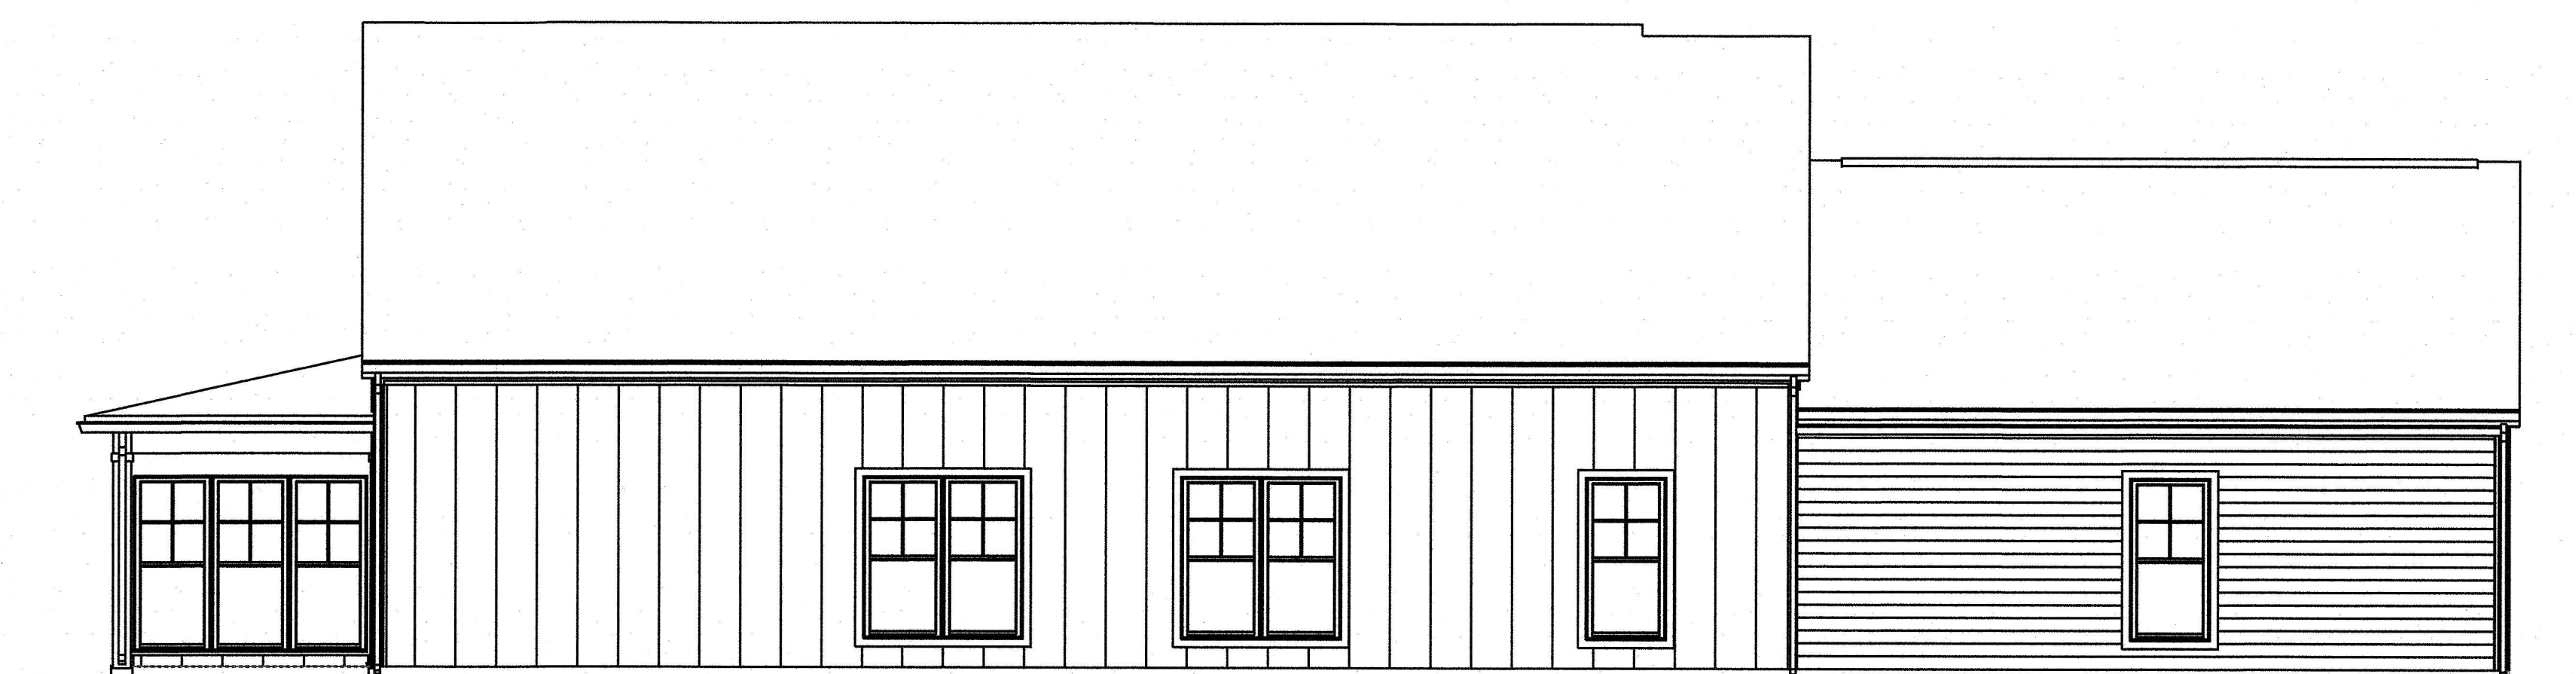

SOUTH

Elevations

DEAN A. WENZ
ARCHITECTS

323 N ARDMORE ROAD
BEXLEY, OHIO 43209
(614) 239-6868
FAX (614) 239-9868

Fairway Cottages at Catawba Island Club
Unit Owners Association, Inc.
Documentation Drawings
Fifth Amendment

Architect Project Number
2020-046A

Sheet Number
9 of 15