



UNIT 45 - Second Floor Plan

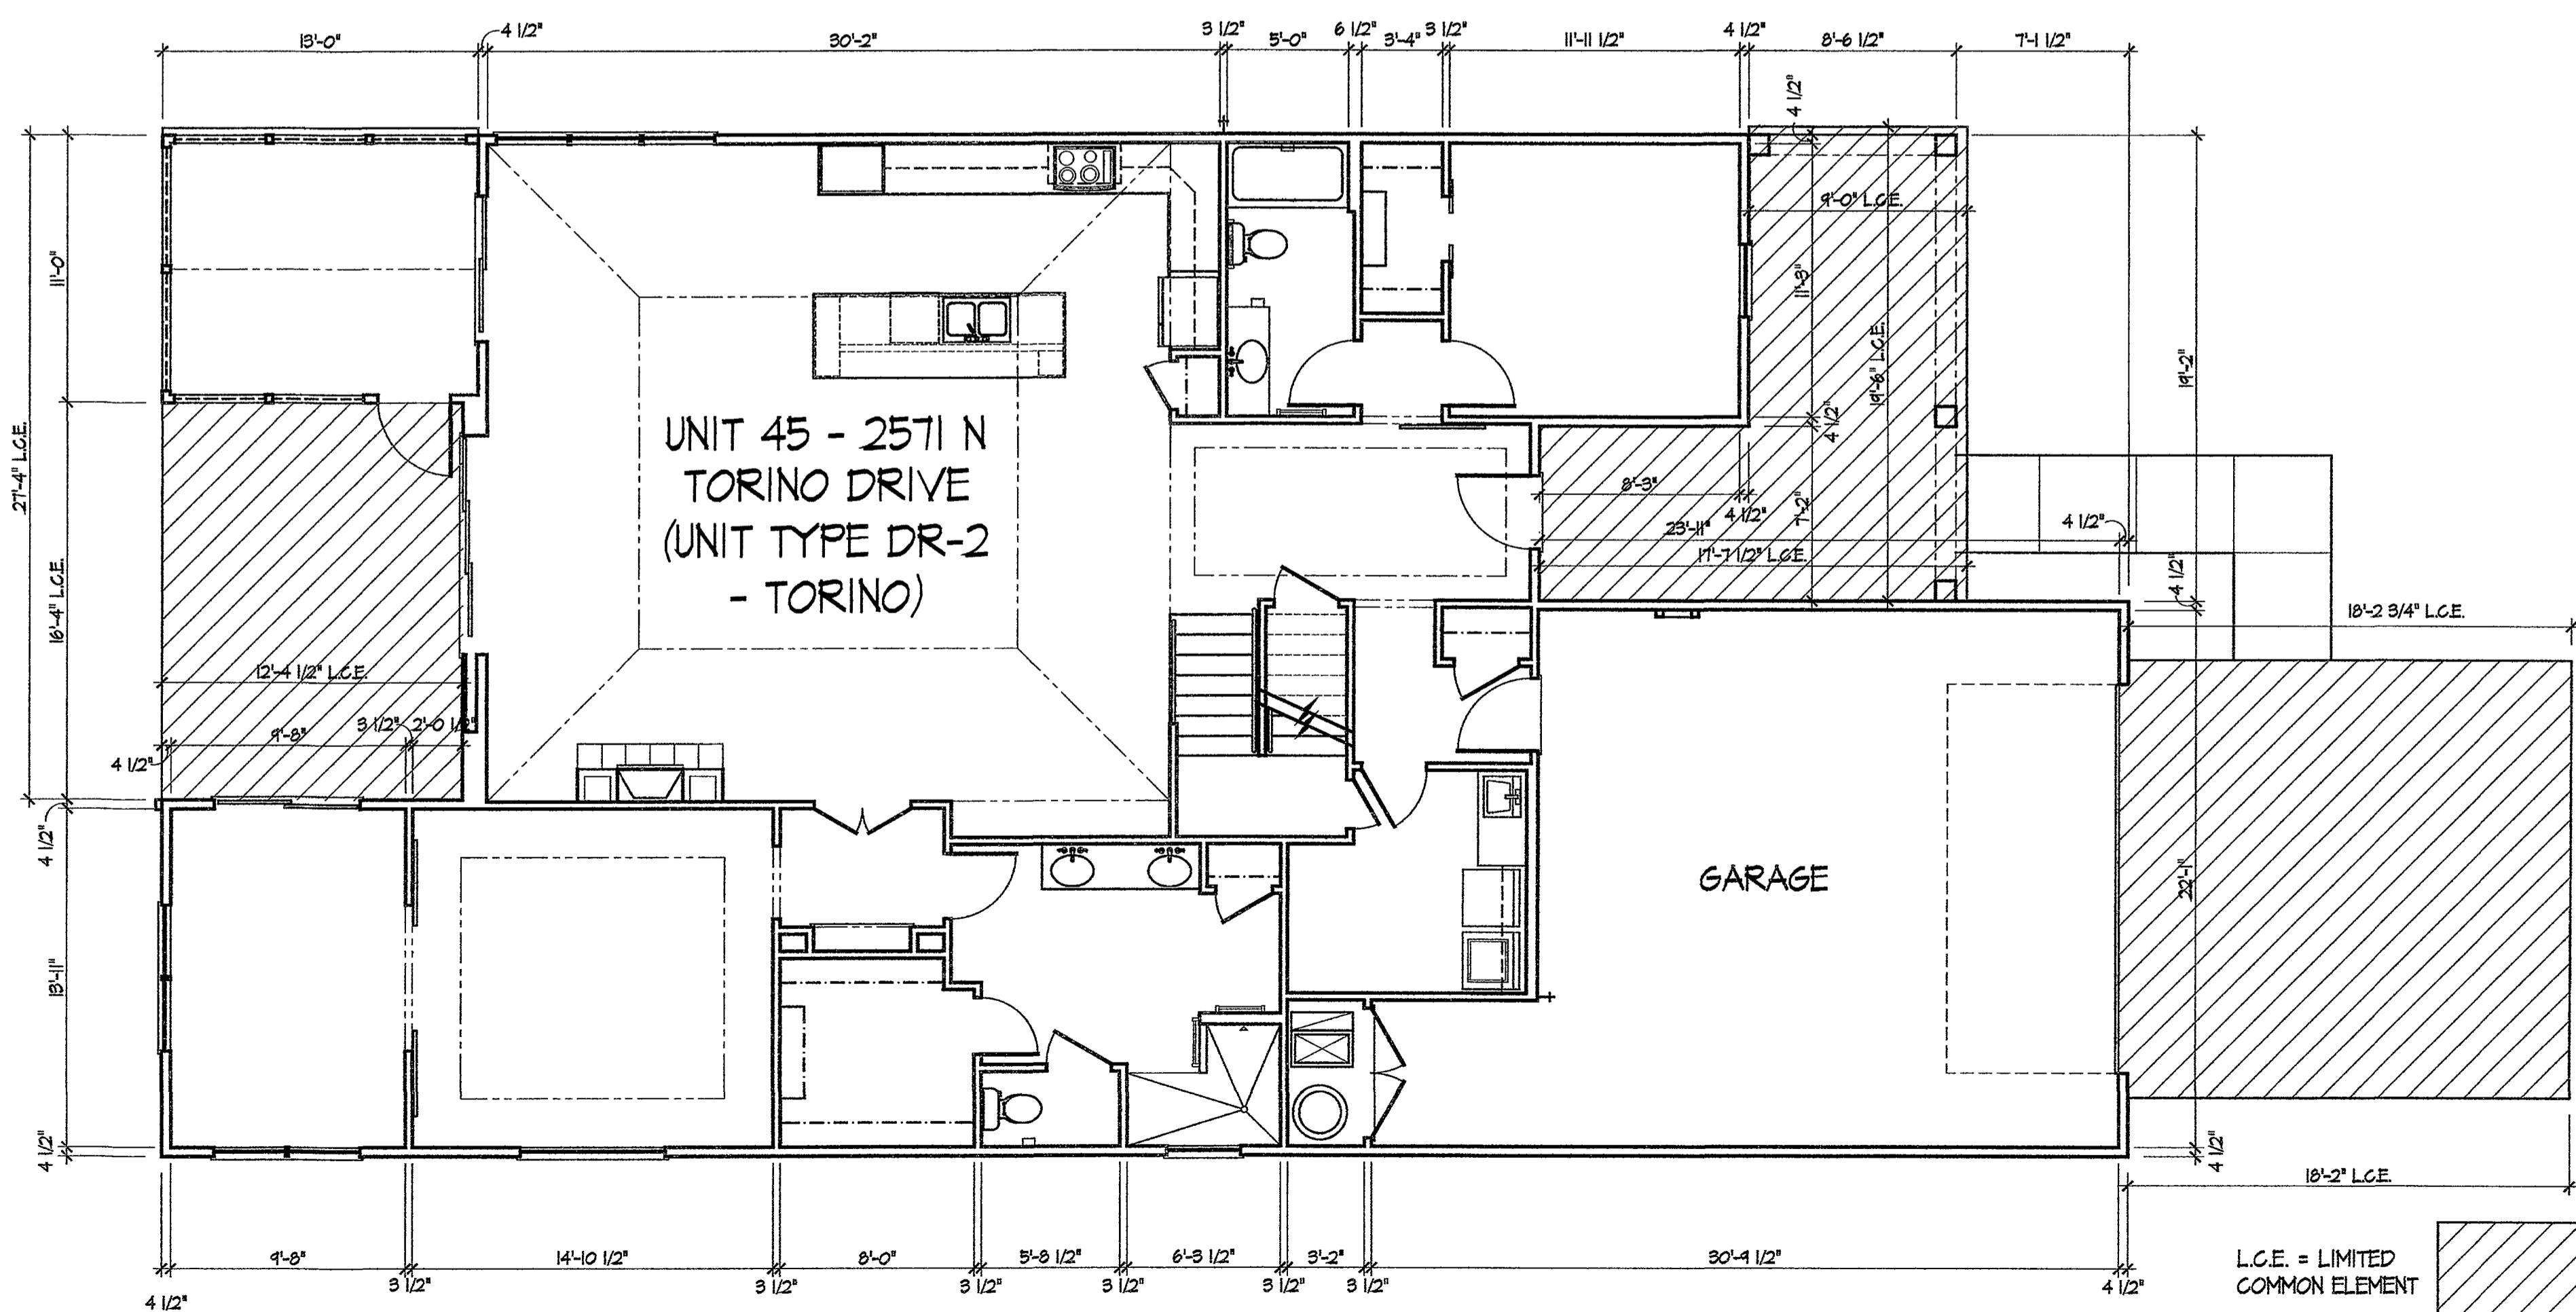

UNIT 45 - First Floor Plan

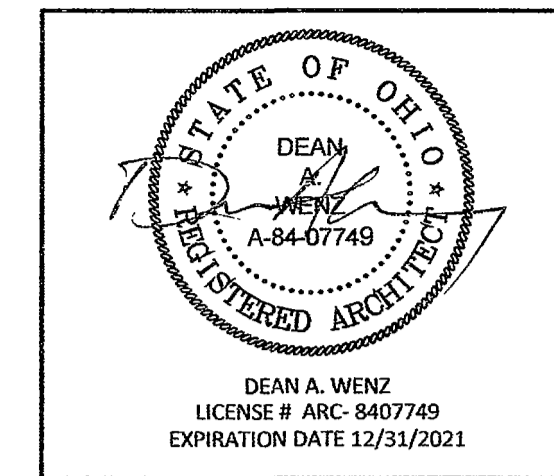

DEAN A. WENZ
ARCHITECTS

2463 E. MAIN STREET
BEXLEY, OHIO 43209
(614) 239-6868
FAX (614) 239-9868


Fairway Estates at Catawba Island Club
Condominium
Fourteenth Amendment

I certify that this drawing, consisting of 8 sheets, accurately shows each building of FAIRWAY ESTATES AT CATAWBA ISLAND CLUB, as constructed with respect to the property shown on this drawing, for the sole purpose of complying with ORC 351.01

By: *Dean A. Wenz* Date: 5/24/2021
Dean A. Wenz - Registered Architect No. ARC-84-07749

Architect Project Number
2015-051A




Sheet Number
3 of 10

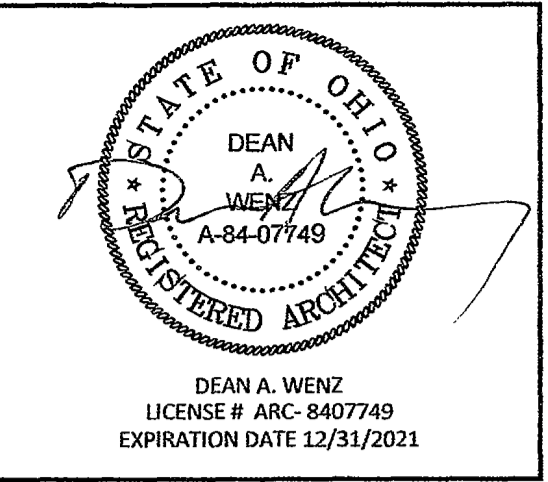


DEAN A. WENZ
ARCHITECTS

2463 E. MAIN STREET
BEXLEY, OHIO 43209
(614) 239-6868
FAX (614) 239-9868

Fairway Estates at Catawba Island Club
Condominium
Fourteenth Amendment

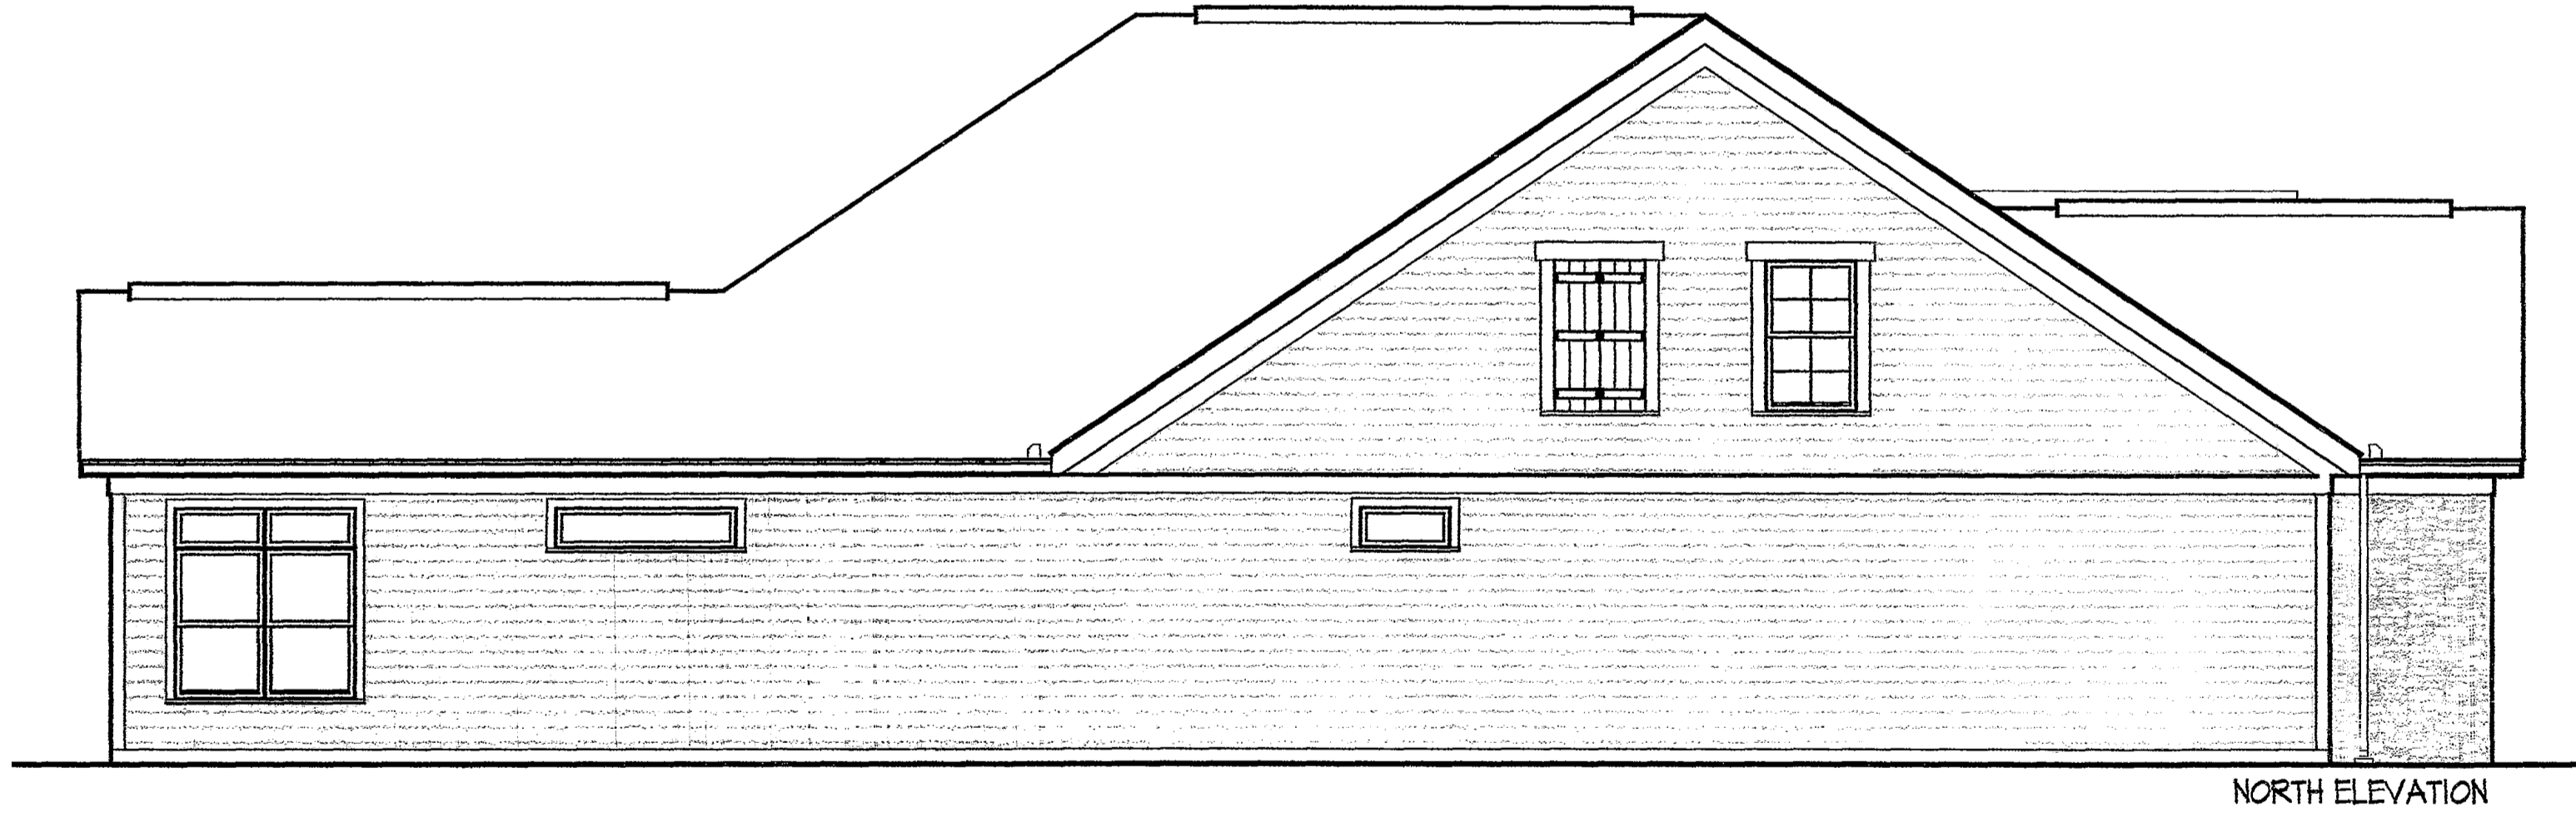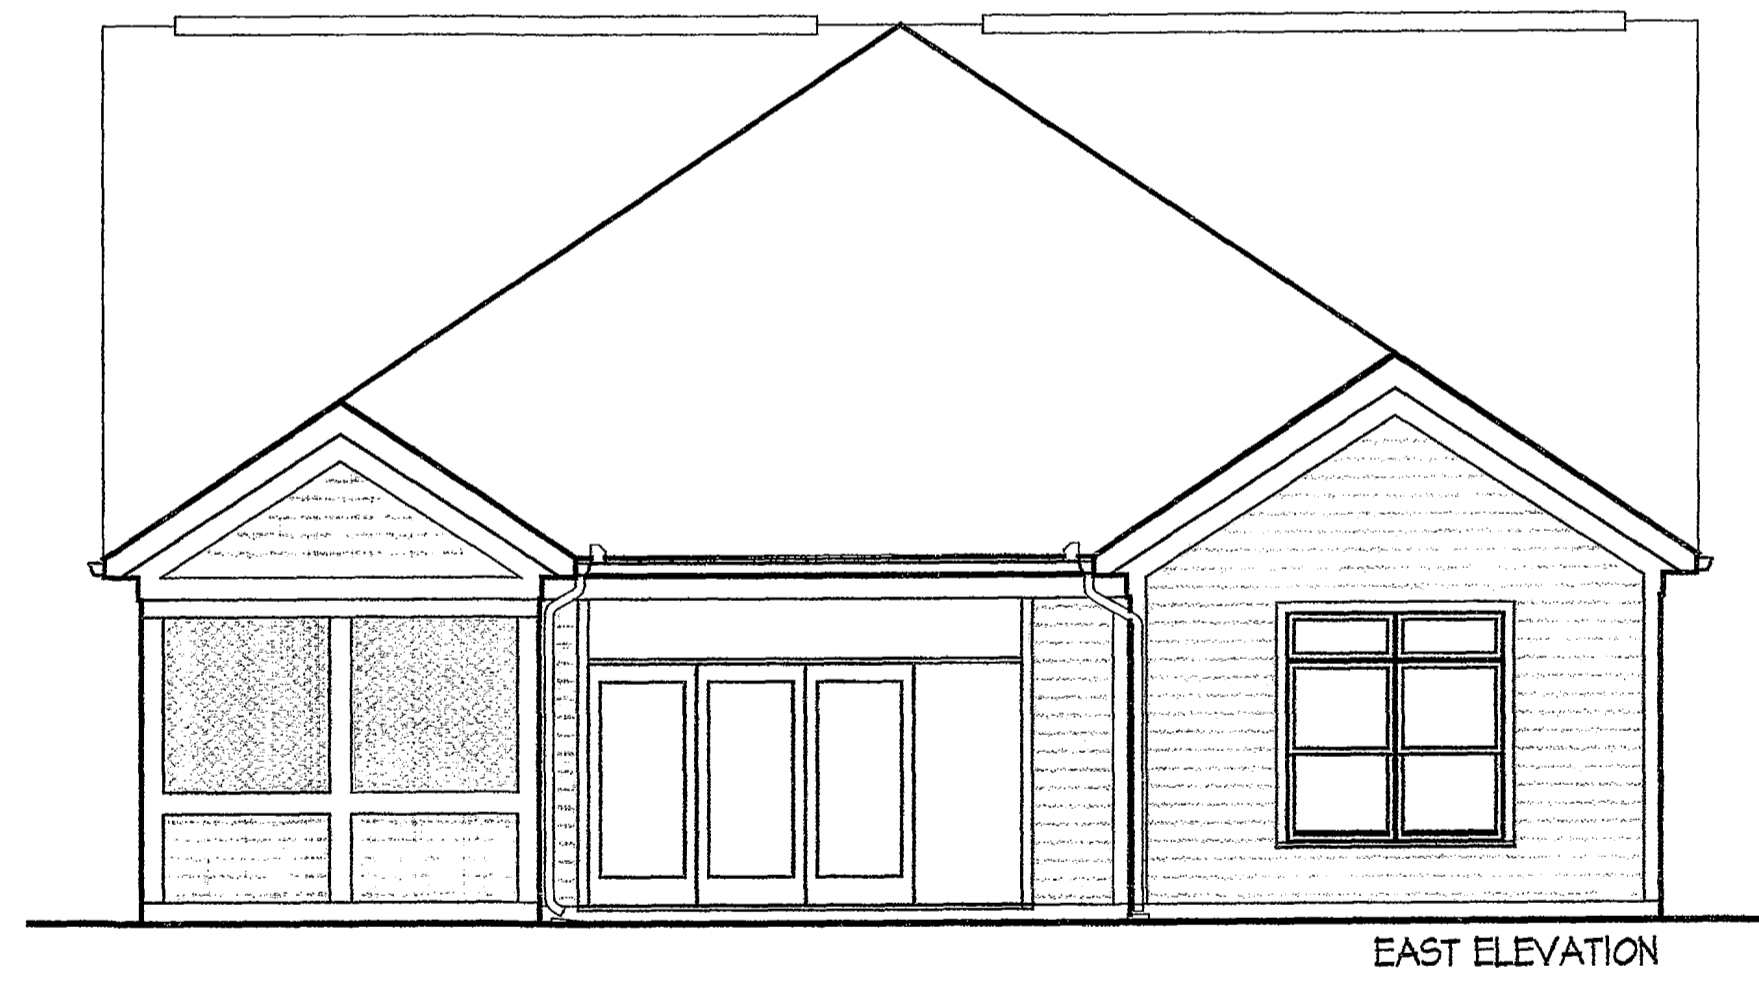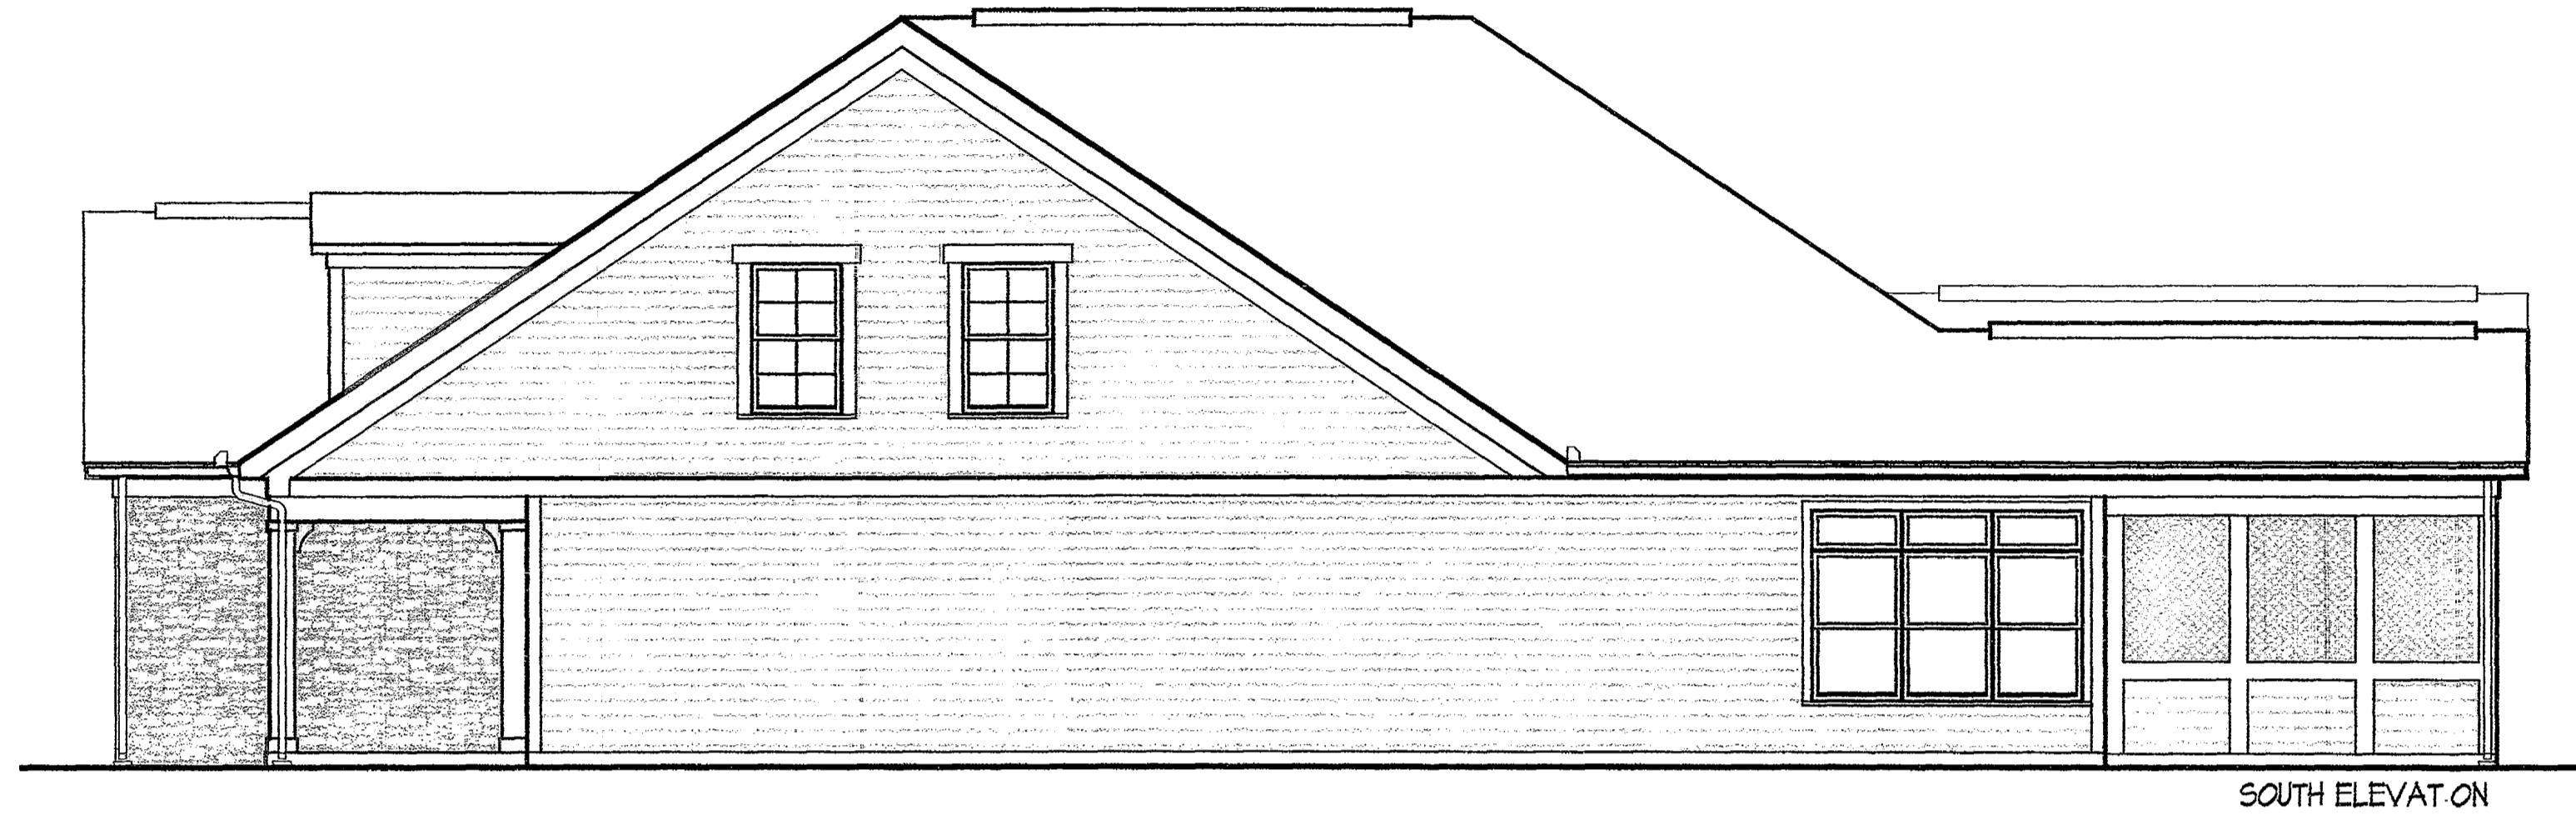


UNIT 45 - Elevations

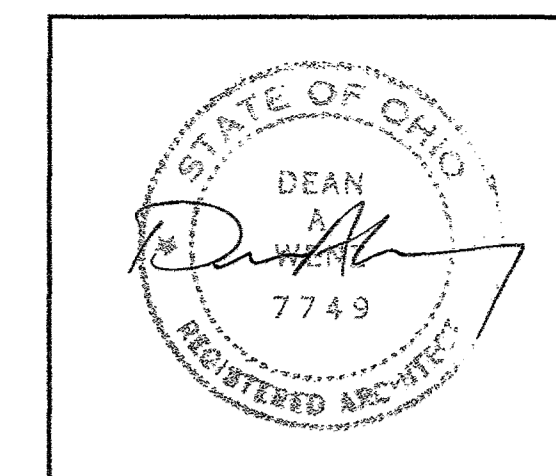


DEAN A. WENZ
ARCHITECTS

2463 E. MAIN STREET
BEXLEY, OHIO 43209
(614) 239-6868
FAX (614) 239-9868

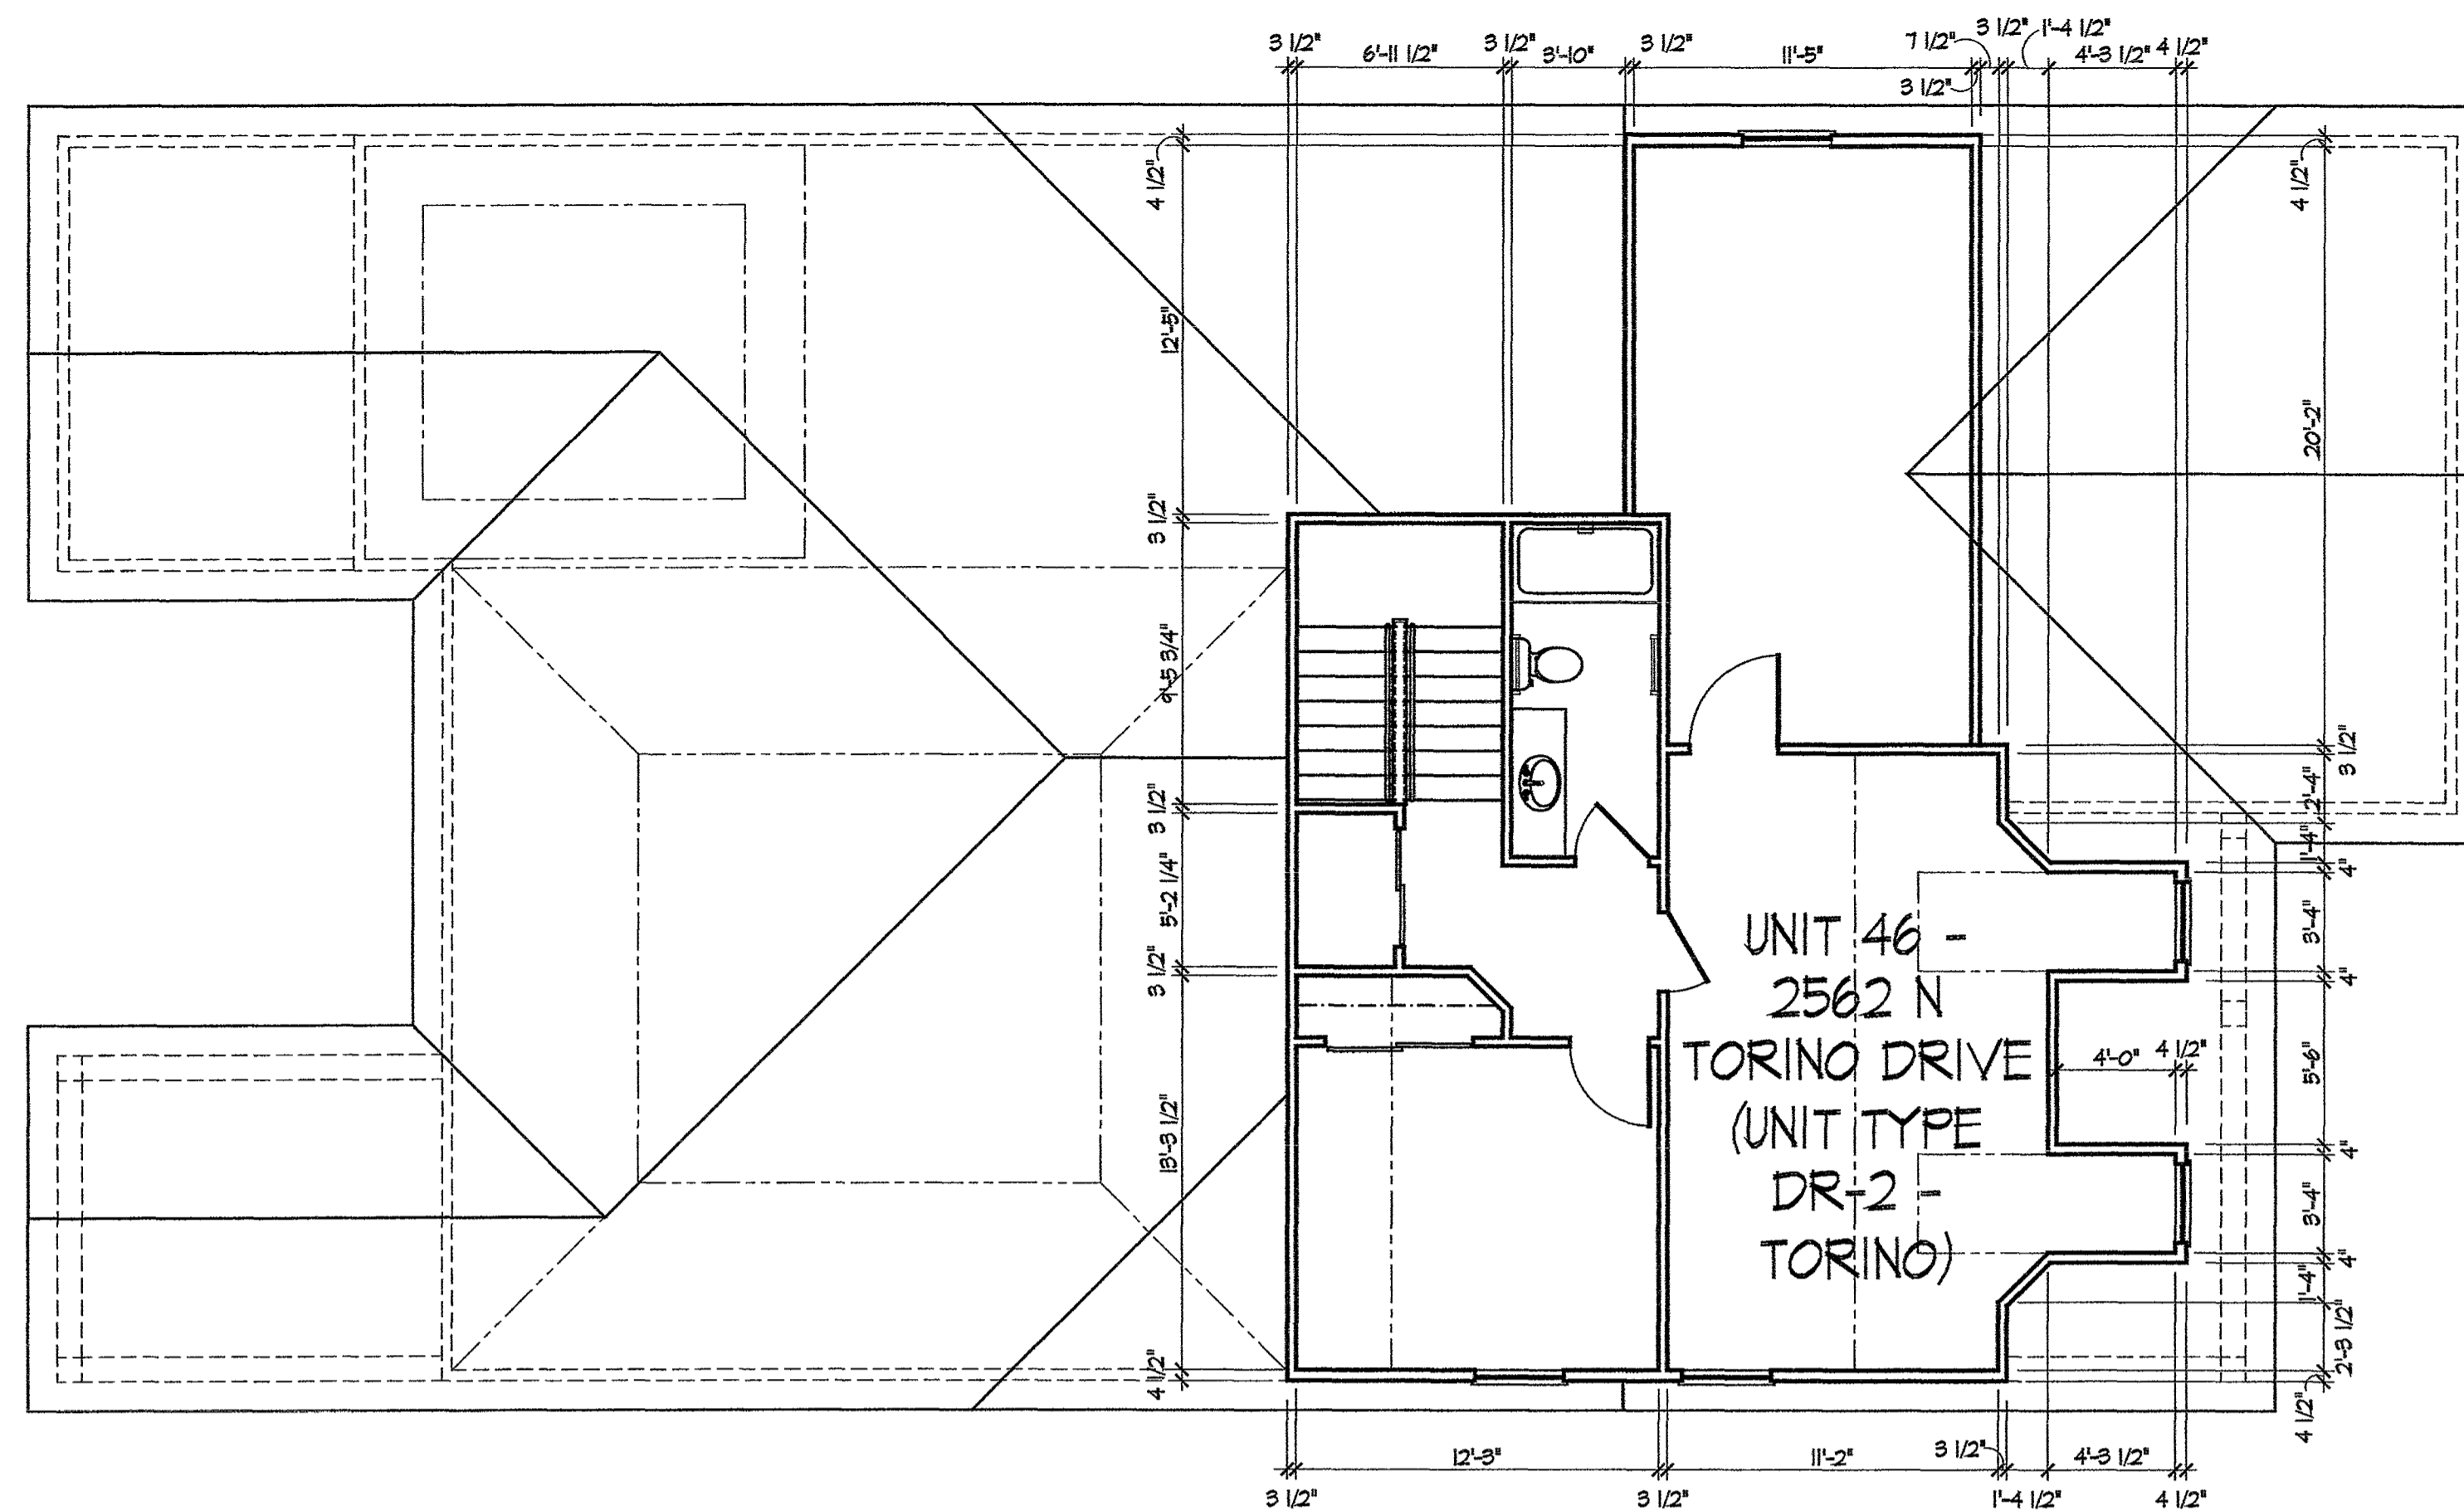

UNIT 46 - Second Floor Plan

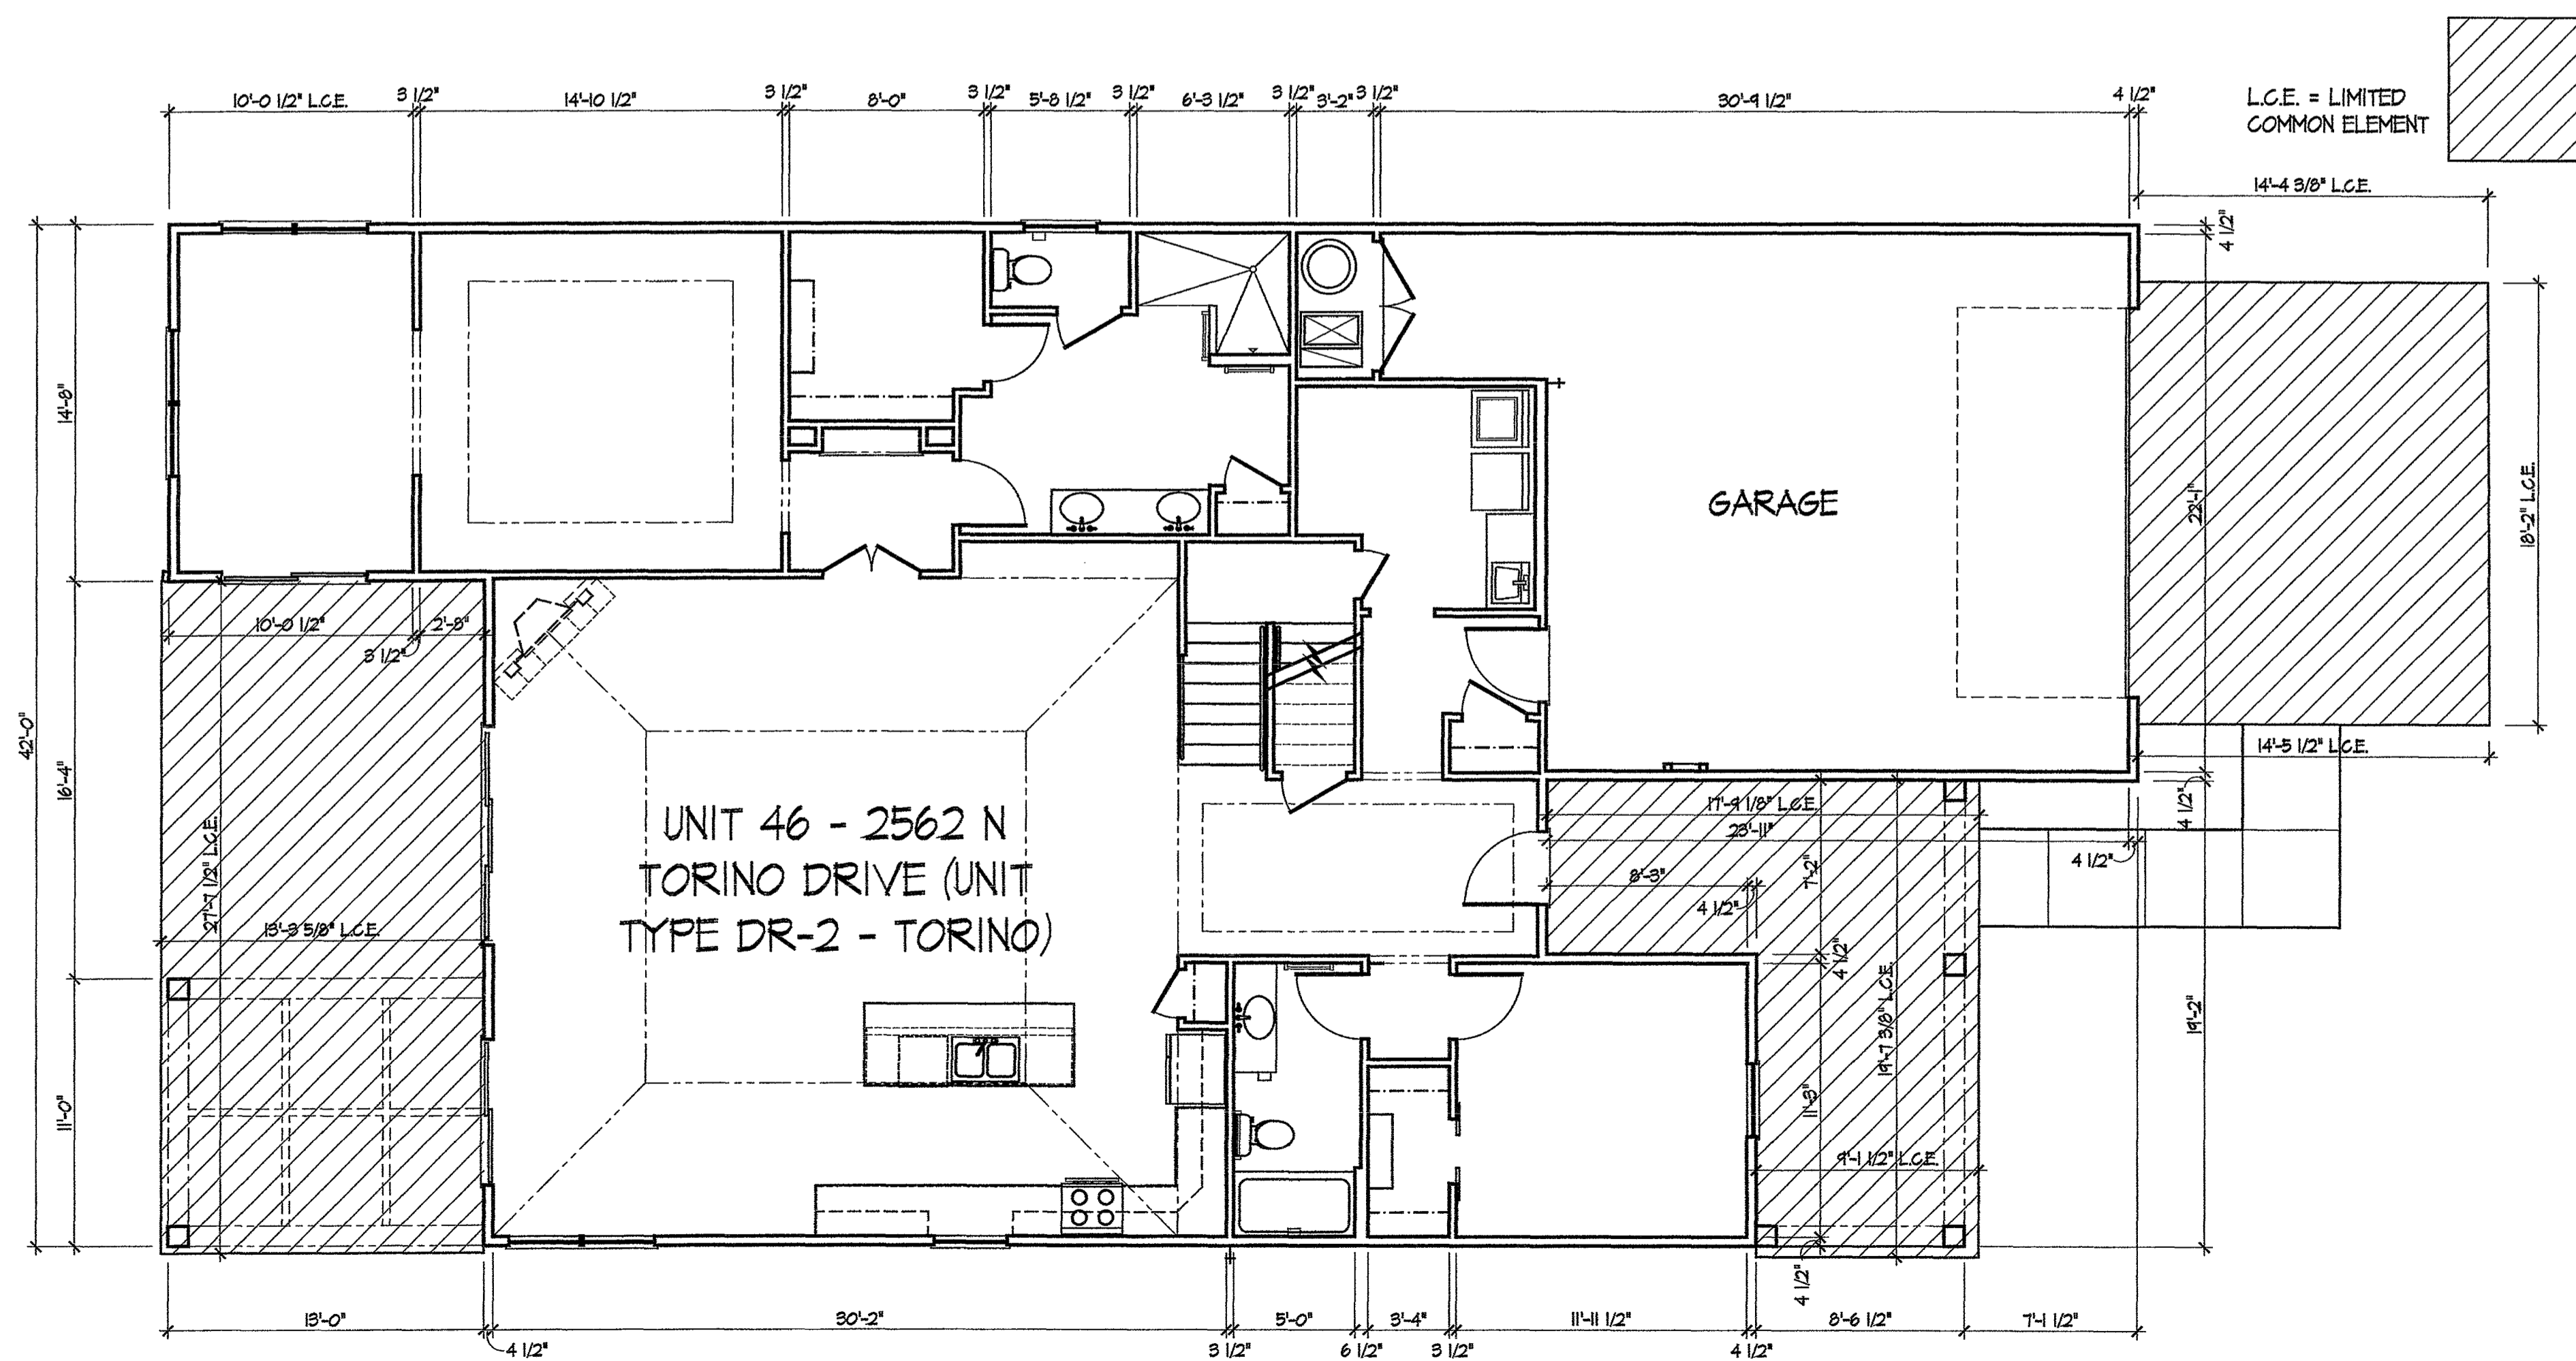


UNIT 46 - First Floor Plan

Fairway Estates at Catawba Island Club
Condominium
Fourteenth Amendment

Architect Project Number
2015-051A

Sheet Number
5 of 10

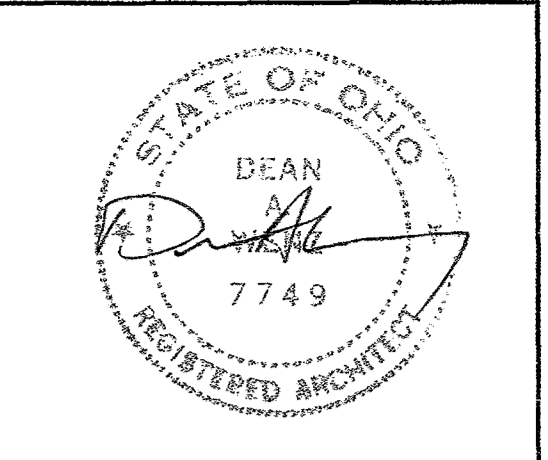


DEAN A. WENZ
ARCHITECTS

2463 E. MAIN STREET
BEXLEY, OHIO 43209
(614) 239-6868
FAX (614) 239-9868

Fairway Estates at Catawba Island Club
Condominium
Fourteenth Amendment




EAST ELEVATION
UNIT 46 - 2562 N TORINO DRIVE
(UNIT TYPE DR-2 - TORINO)

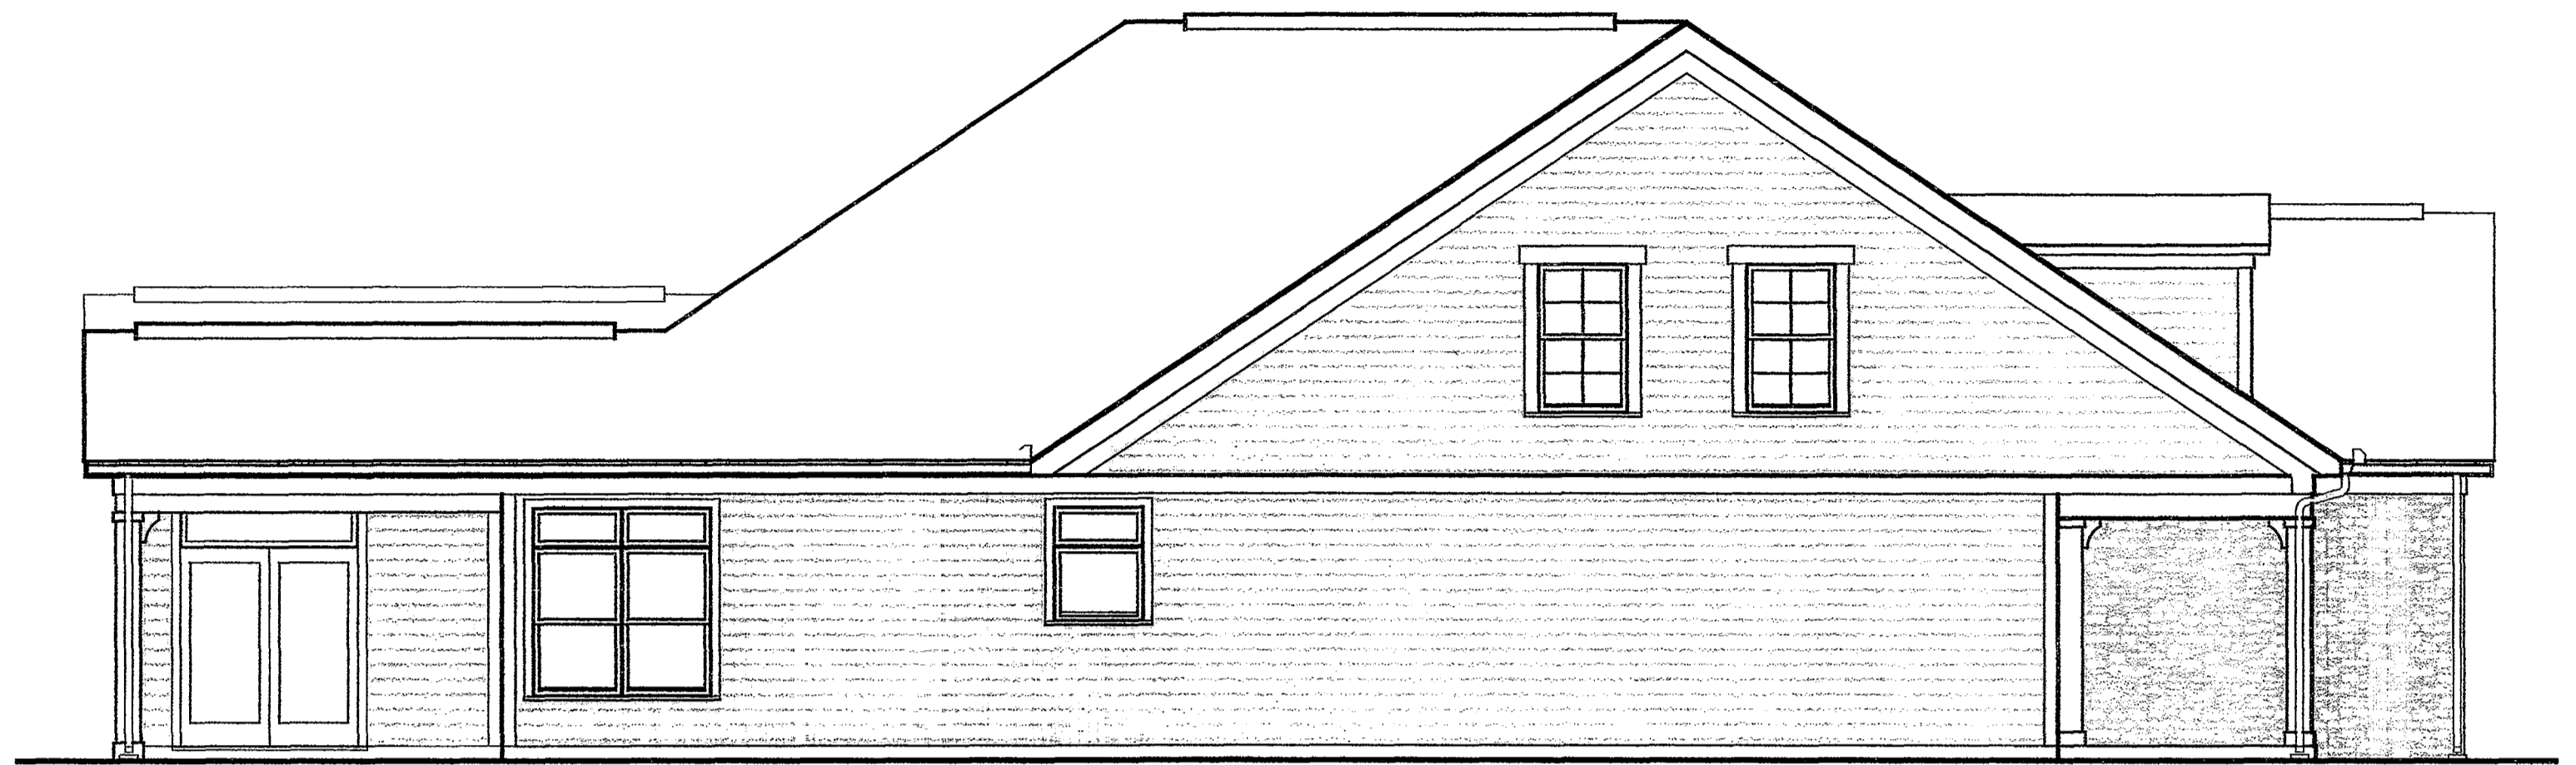

SOUTH ELEVATION




WEST ELEVATION

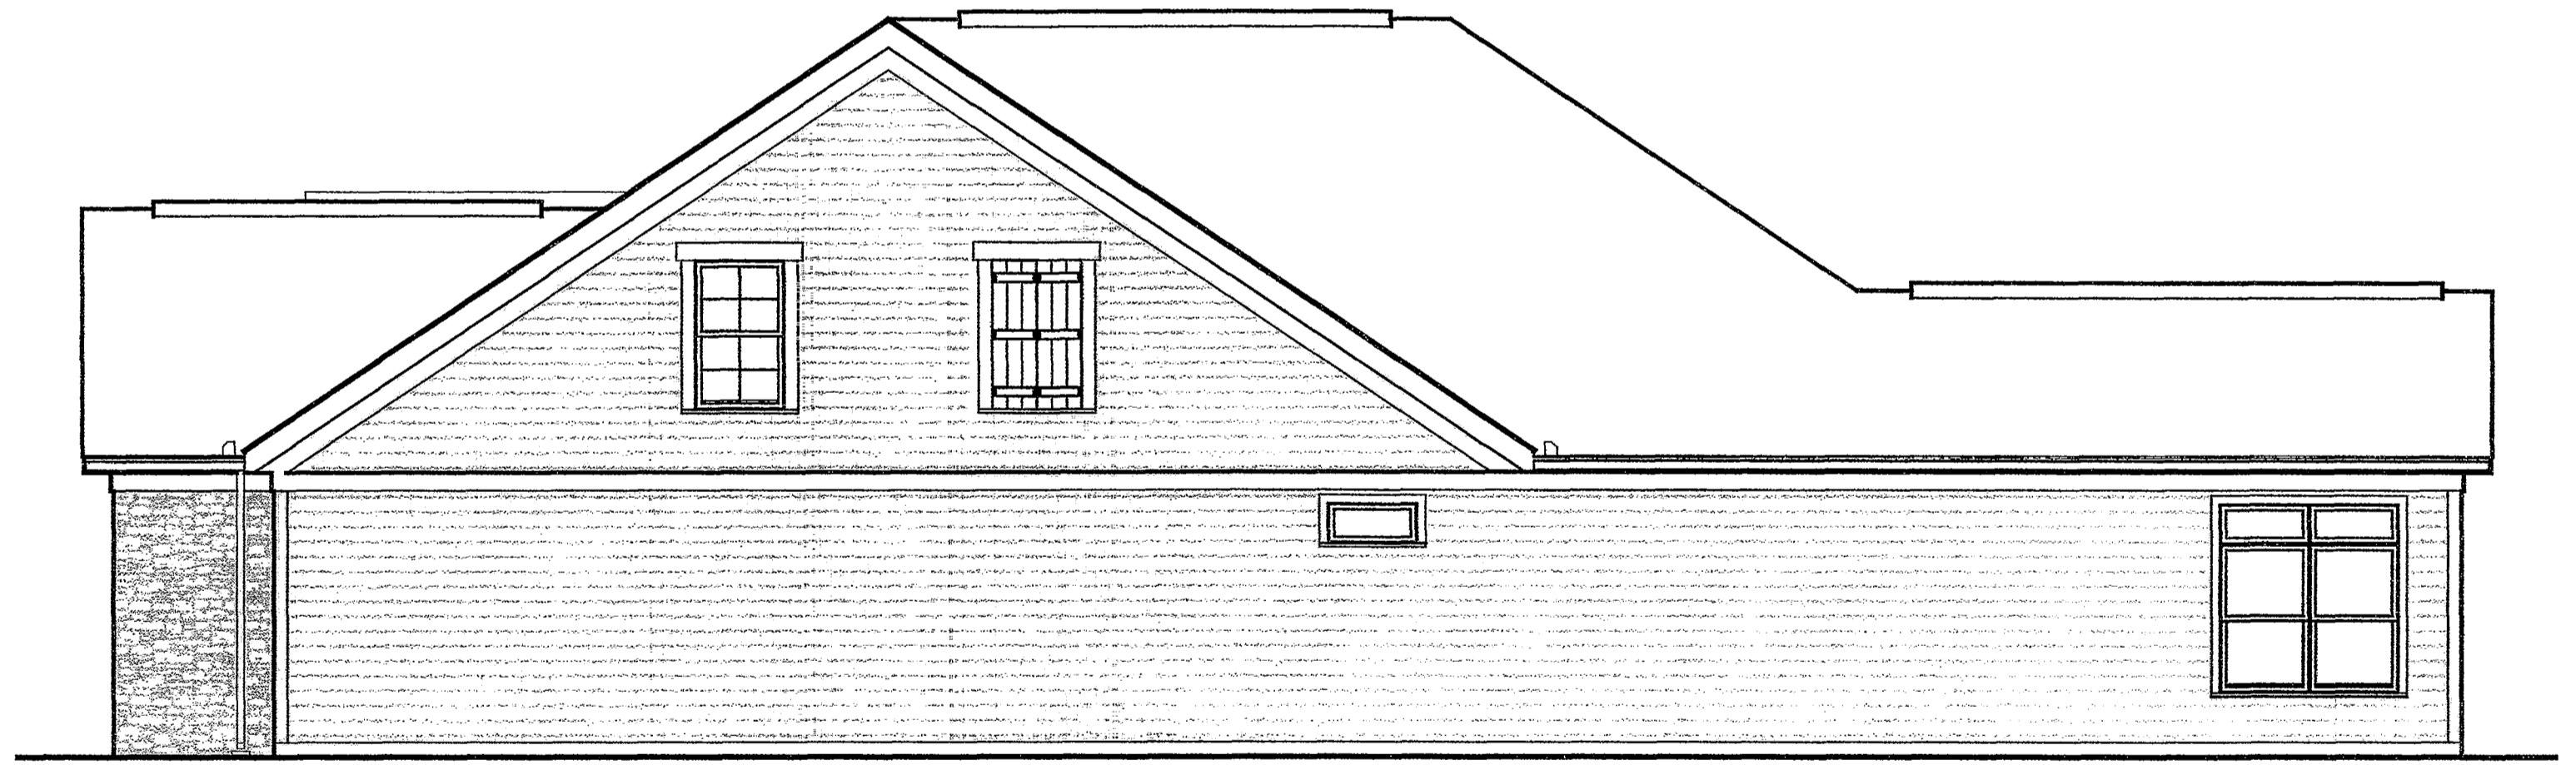

NORTH ELEVATION


UNIT 46 - Elevations

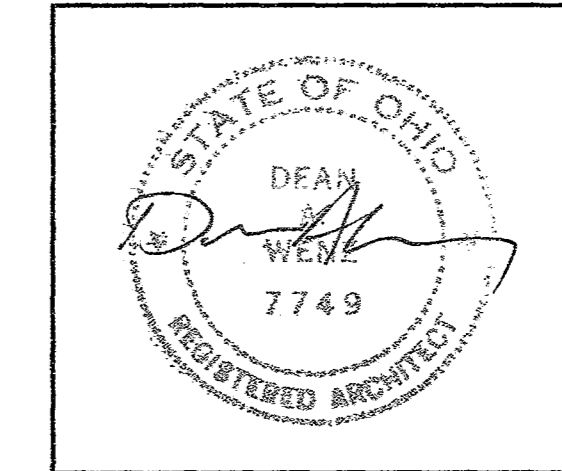


DEAN A. WENZ
ARCHITECTS

2463 E. MAIN STREET
BEXLEY, OHIO 43209
(614) 239-6868
FAX (614) 239-9868

Fairway Estates at Catawba Island Club
Condominium
Fourteenth Amendment

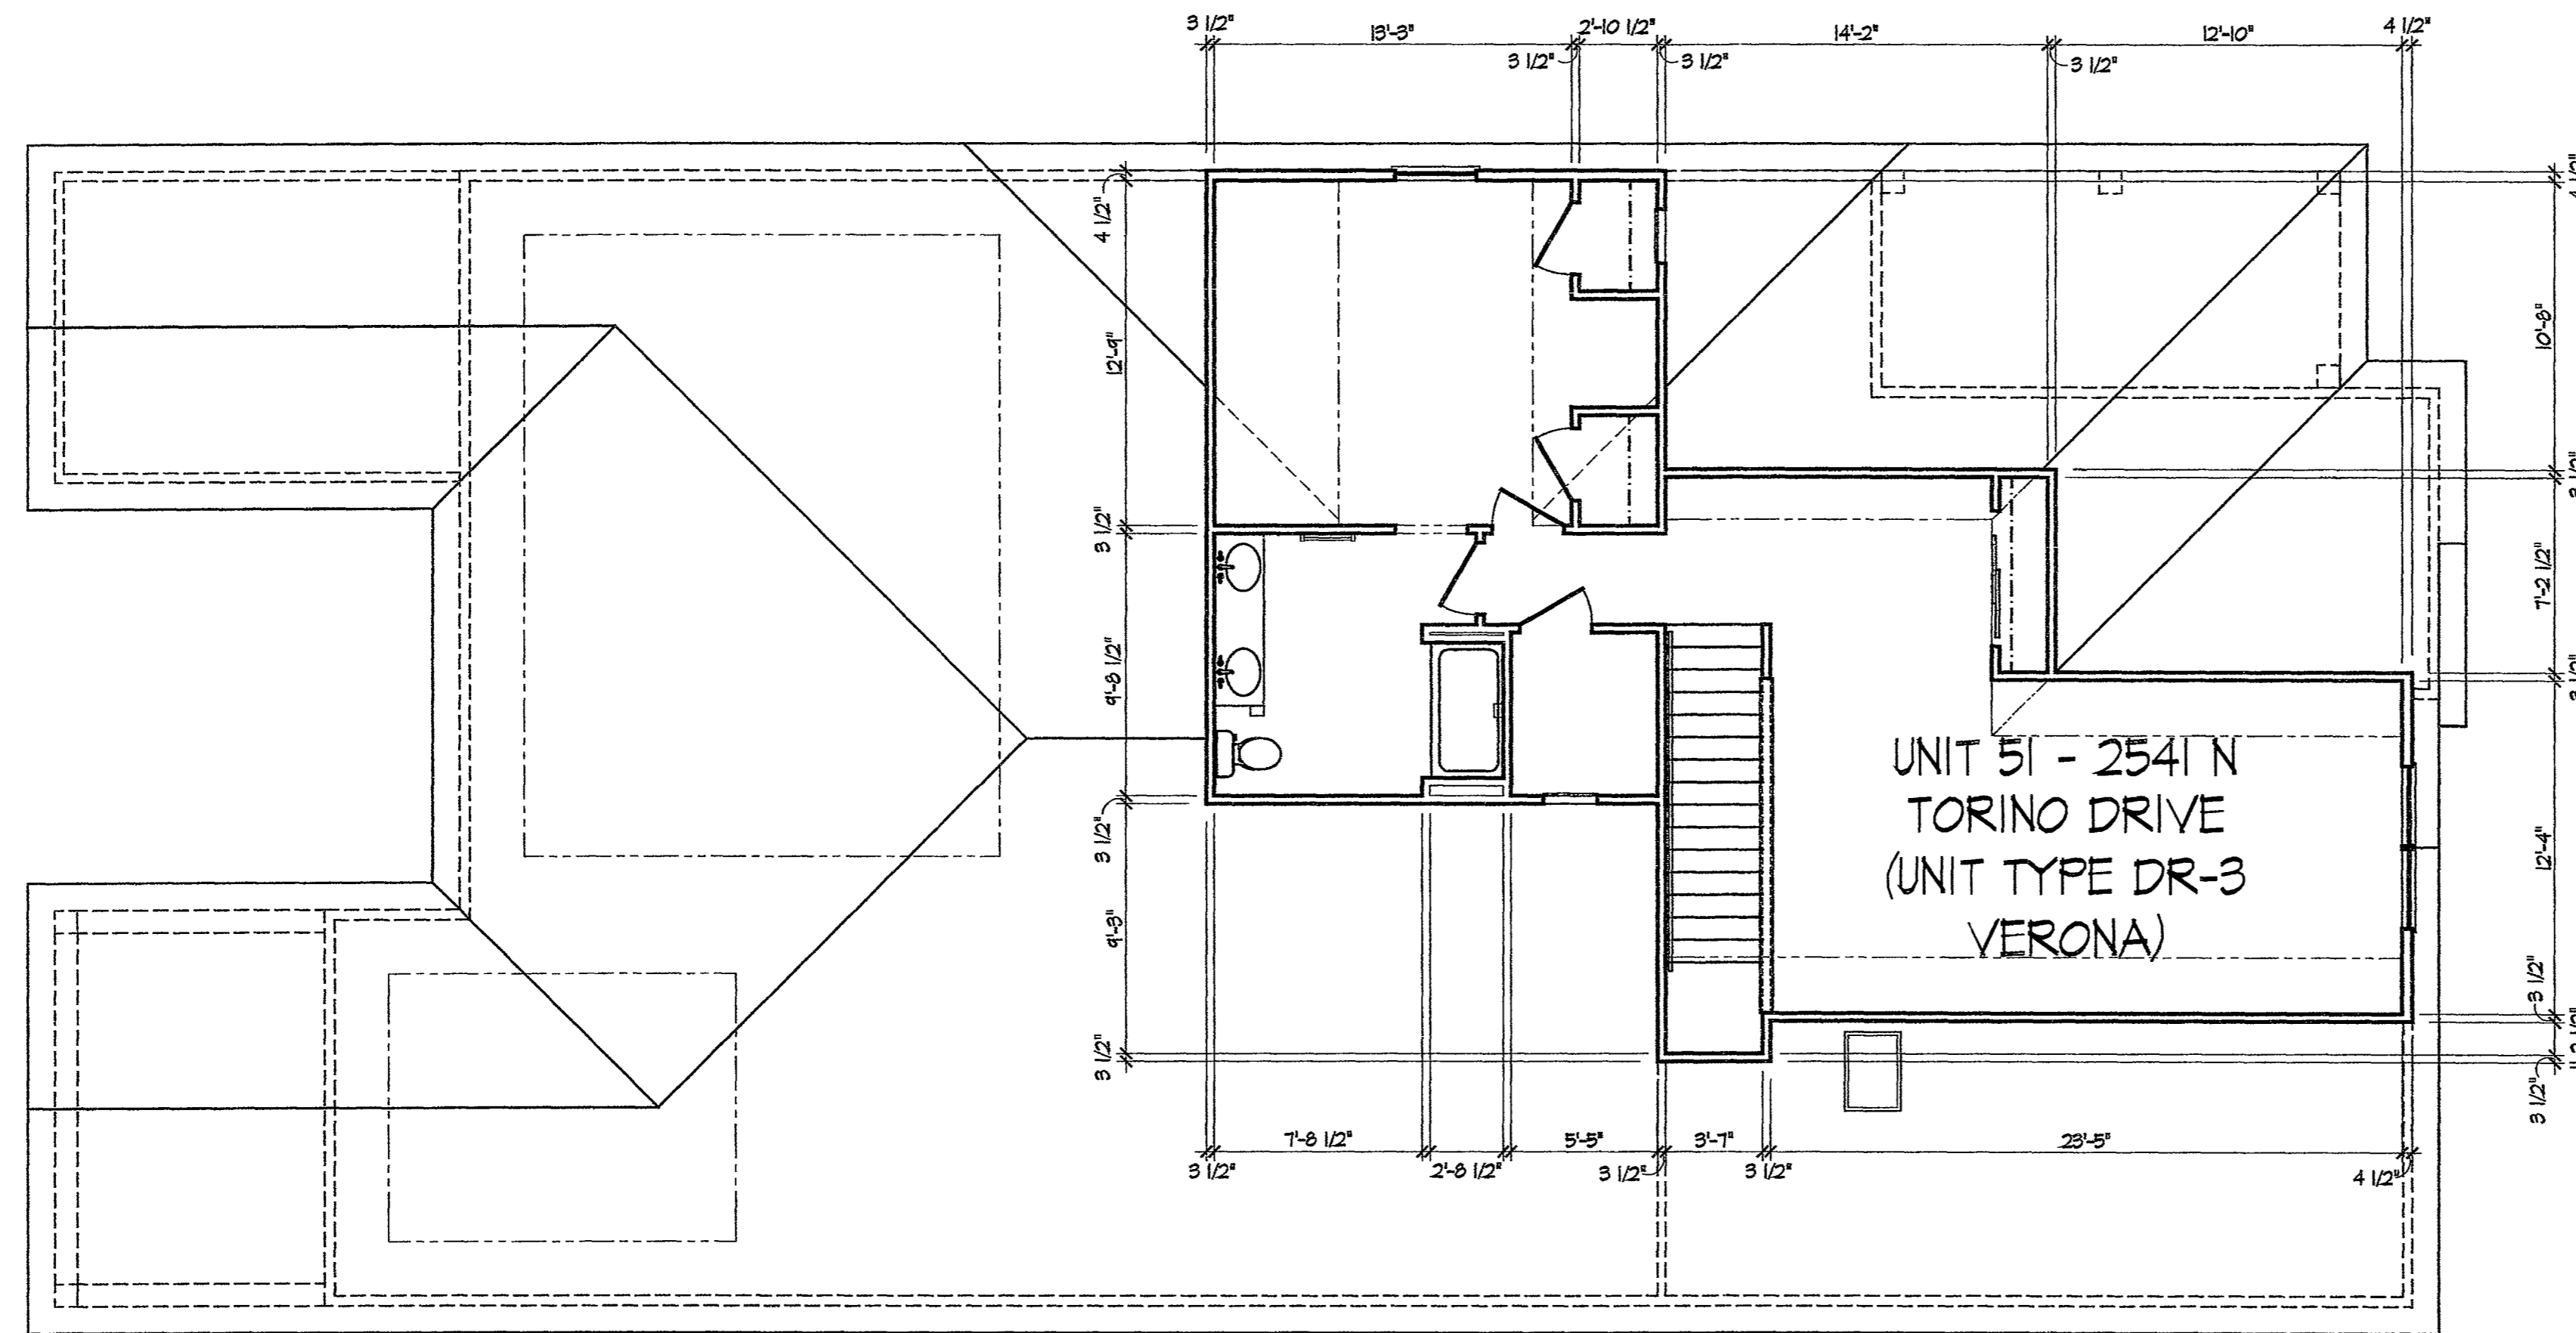


UNIT 51 - Second Floor Plan

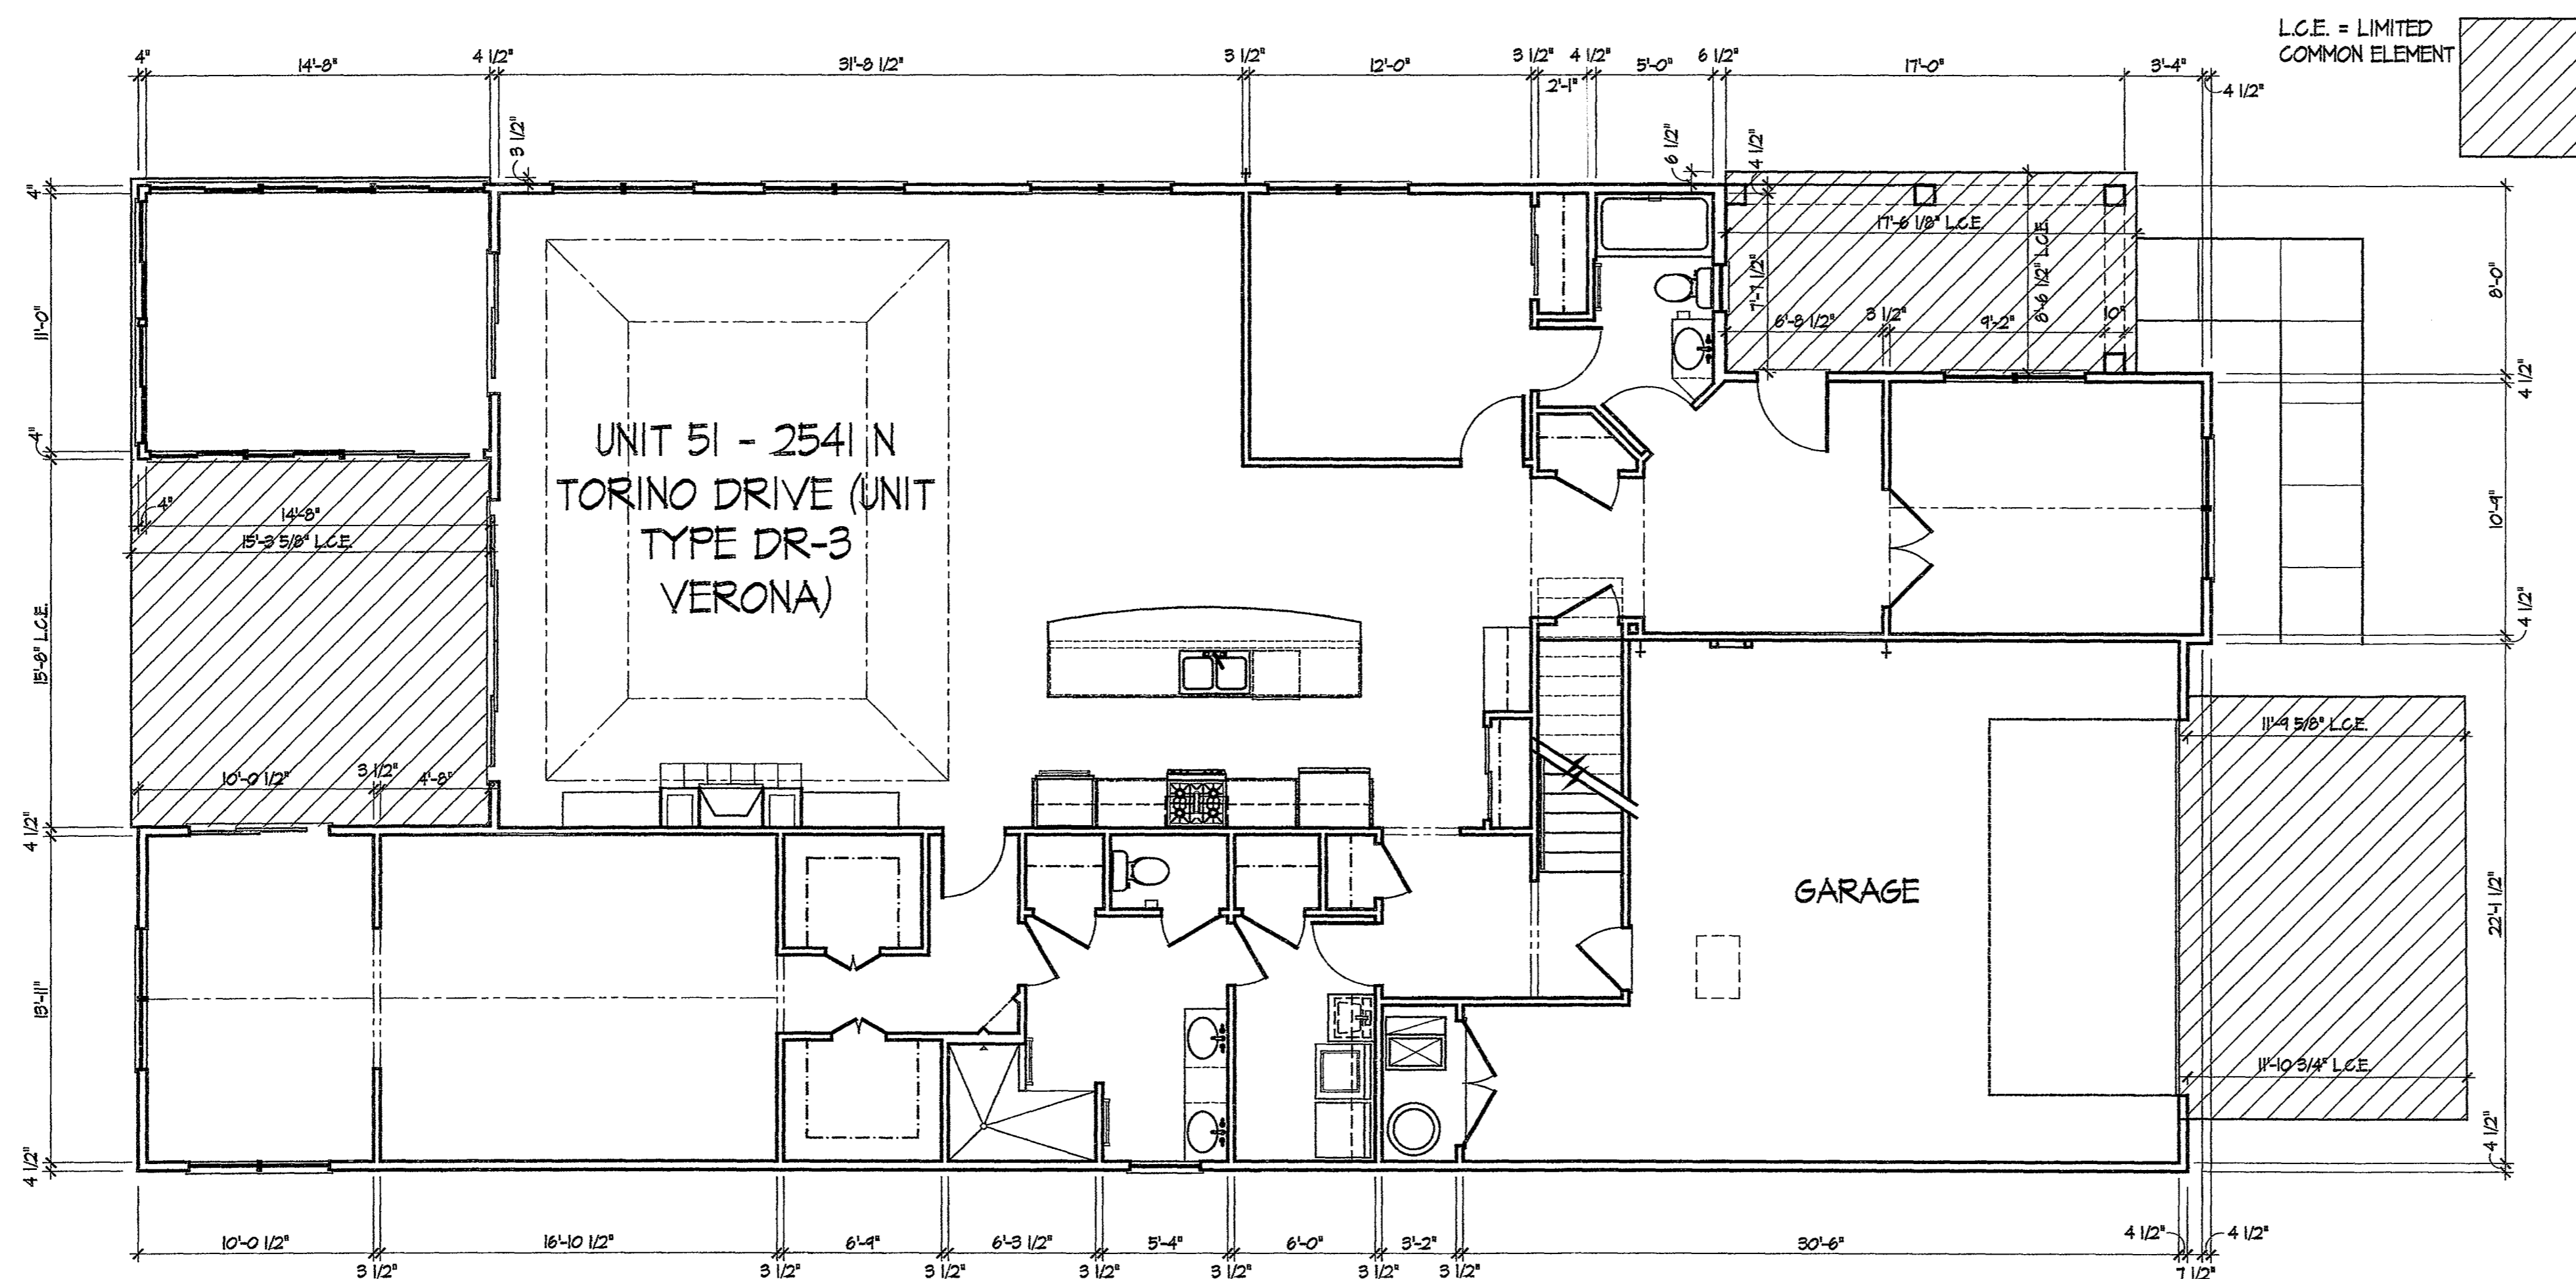

UNIT 51 - First Floor Plan

Architect Project Number
2015-051A

Sheet Number
7 of 10

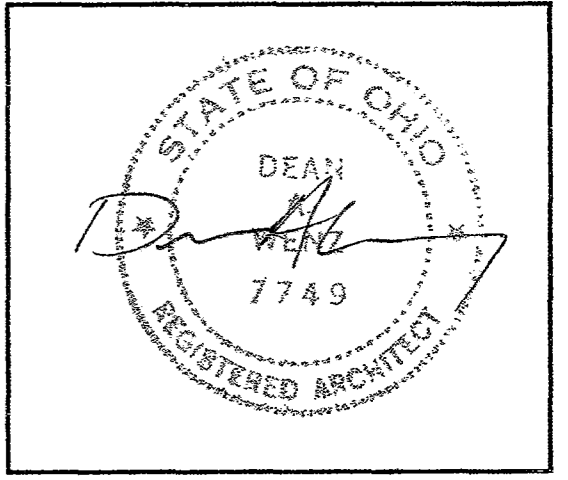

DEAN A. WENZ
ARCHITECTS

2463 E. MAIN STREET
BEXLEY, OHIO 43209
(614) 239-6868
FAX (614) 239-9868

Fairway Estates at Catawba Island Club
Condominium
Fourteenth Amendment




UNIT 51 - 2541 N TORINO DRIVE
(UNIT TYPE DR-3 VERONA)


WEST ELEVATION



SOUTH ELEVATION

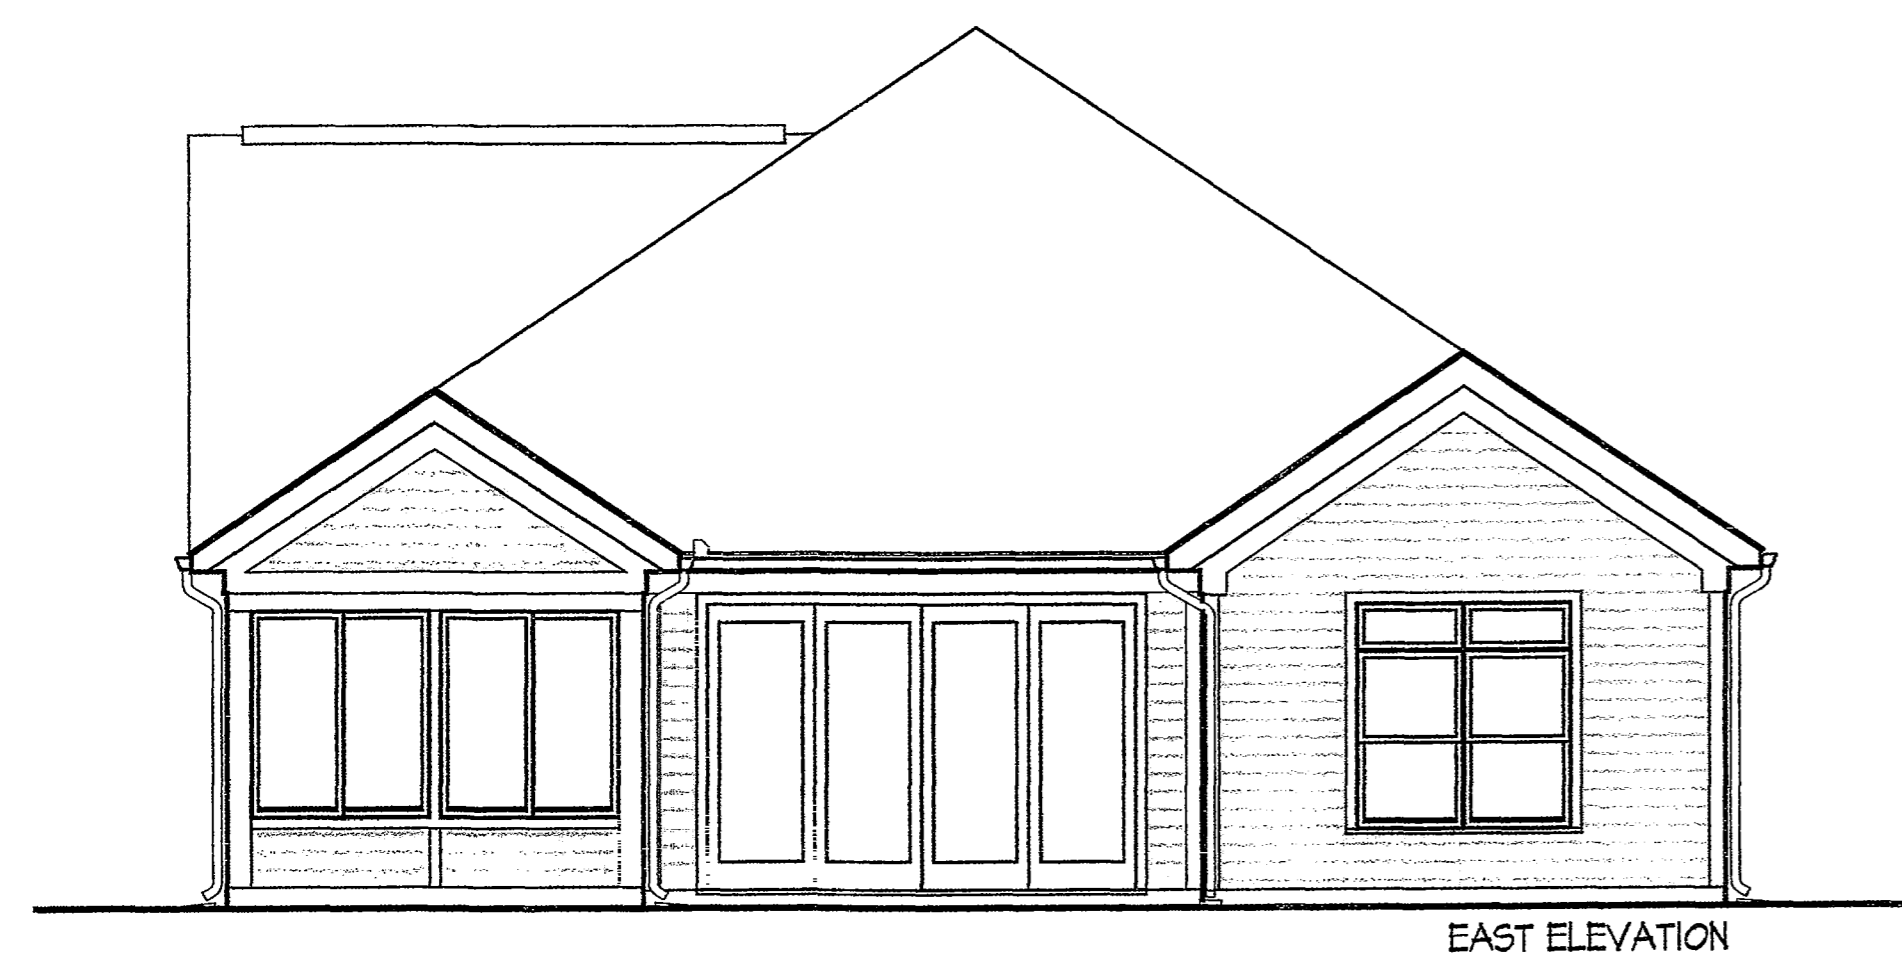


EAST ELEVATION

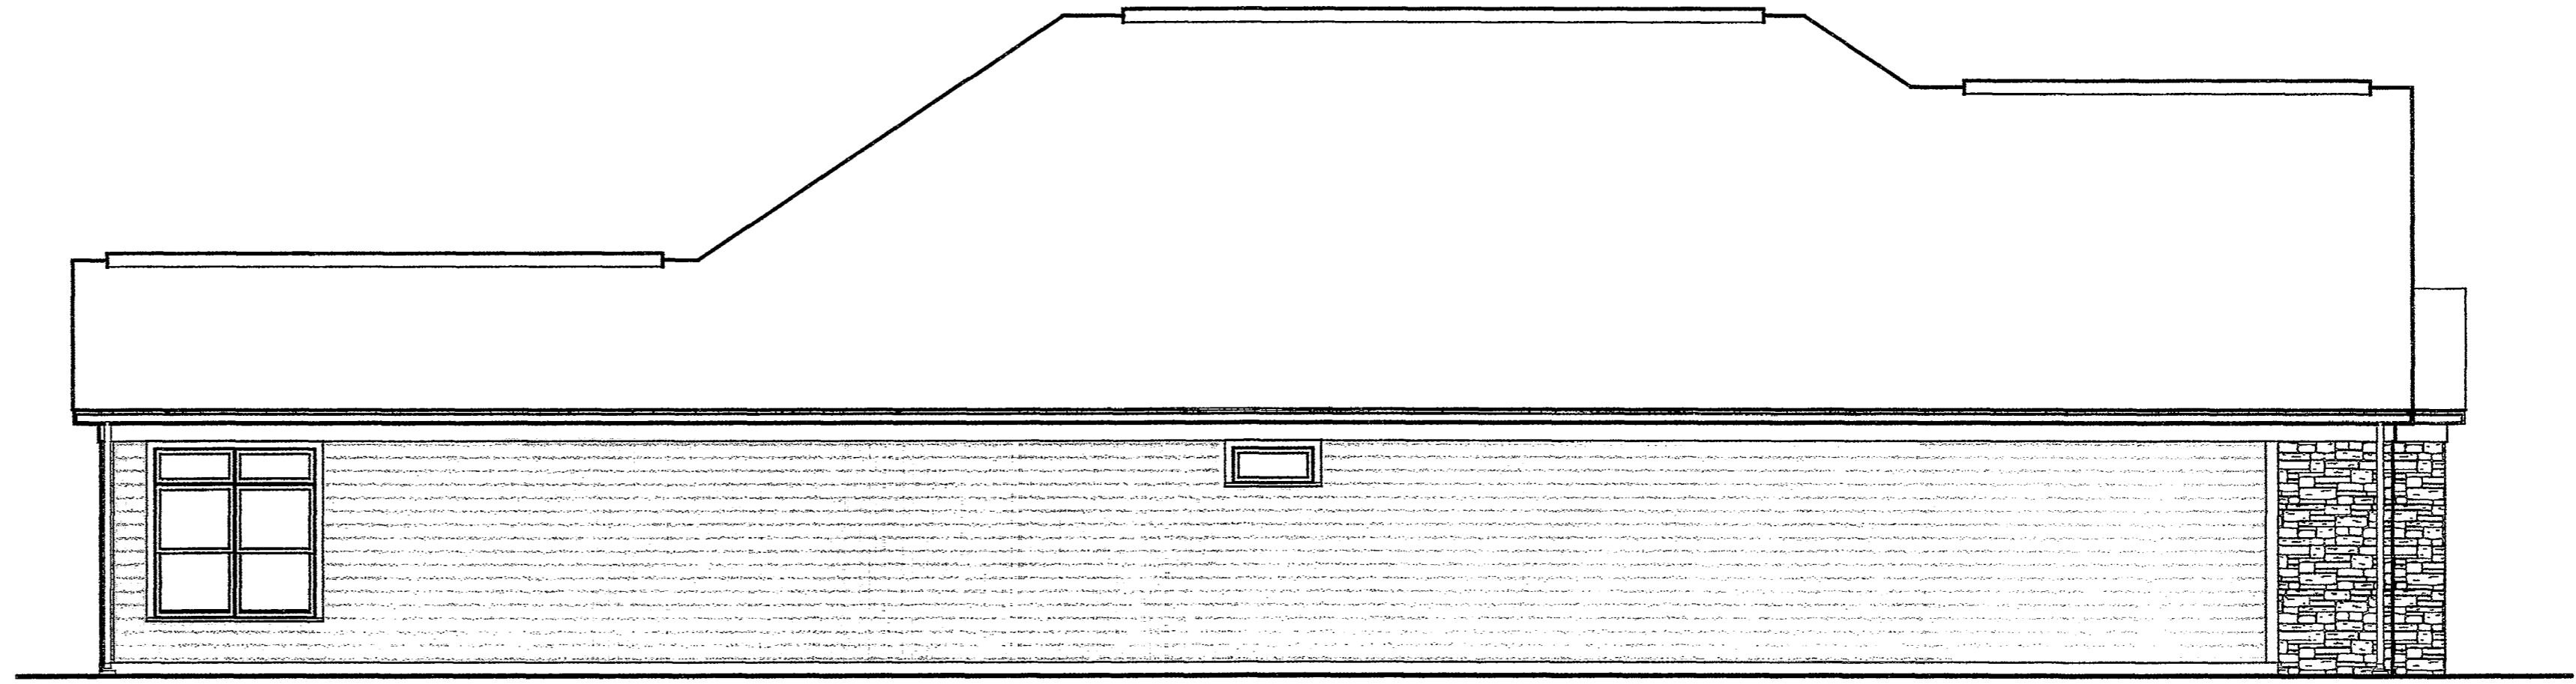

NORTH ELEVATION


UNIT 51 - Elevations

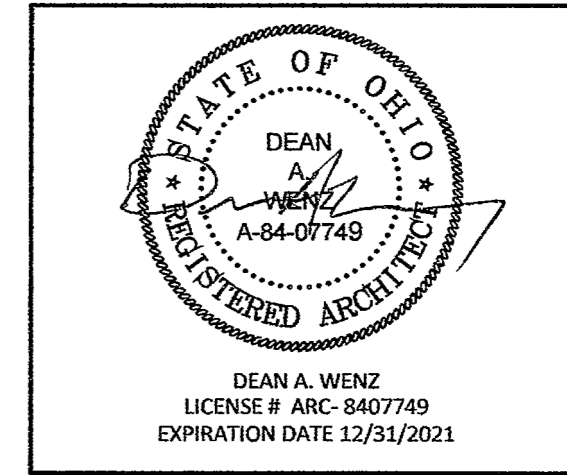


DEAN A. WENZ
ARCHITECTS

2463 E. MAIN STREET
BEXLEY, OHIO 43209
(614) 239-6868
FAX (614) 239-9868

Fairway Estates at Catawba Island Club
Condominium
Fourteenth Amendment

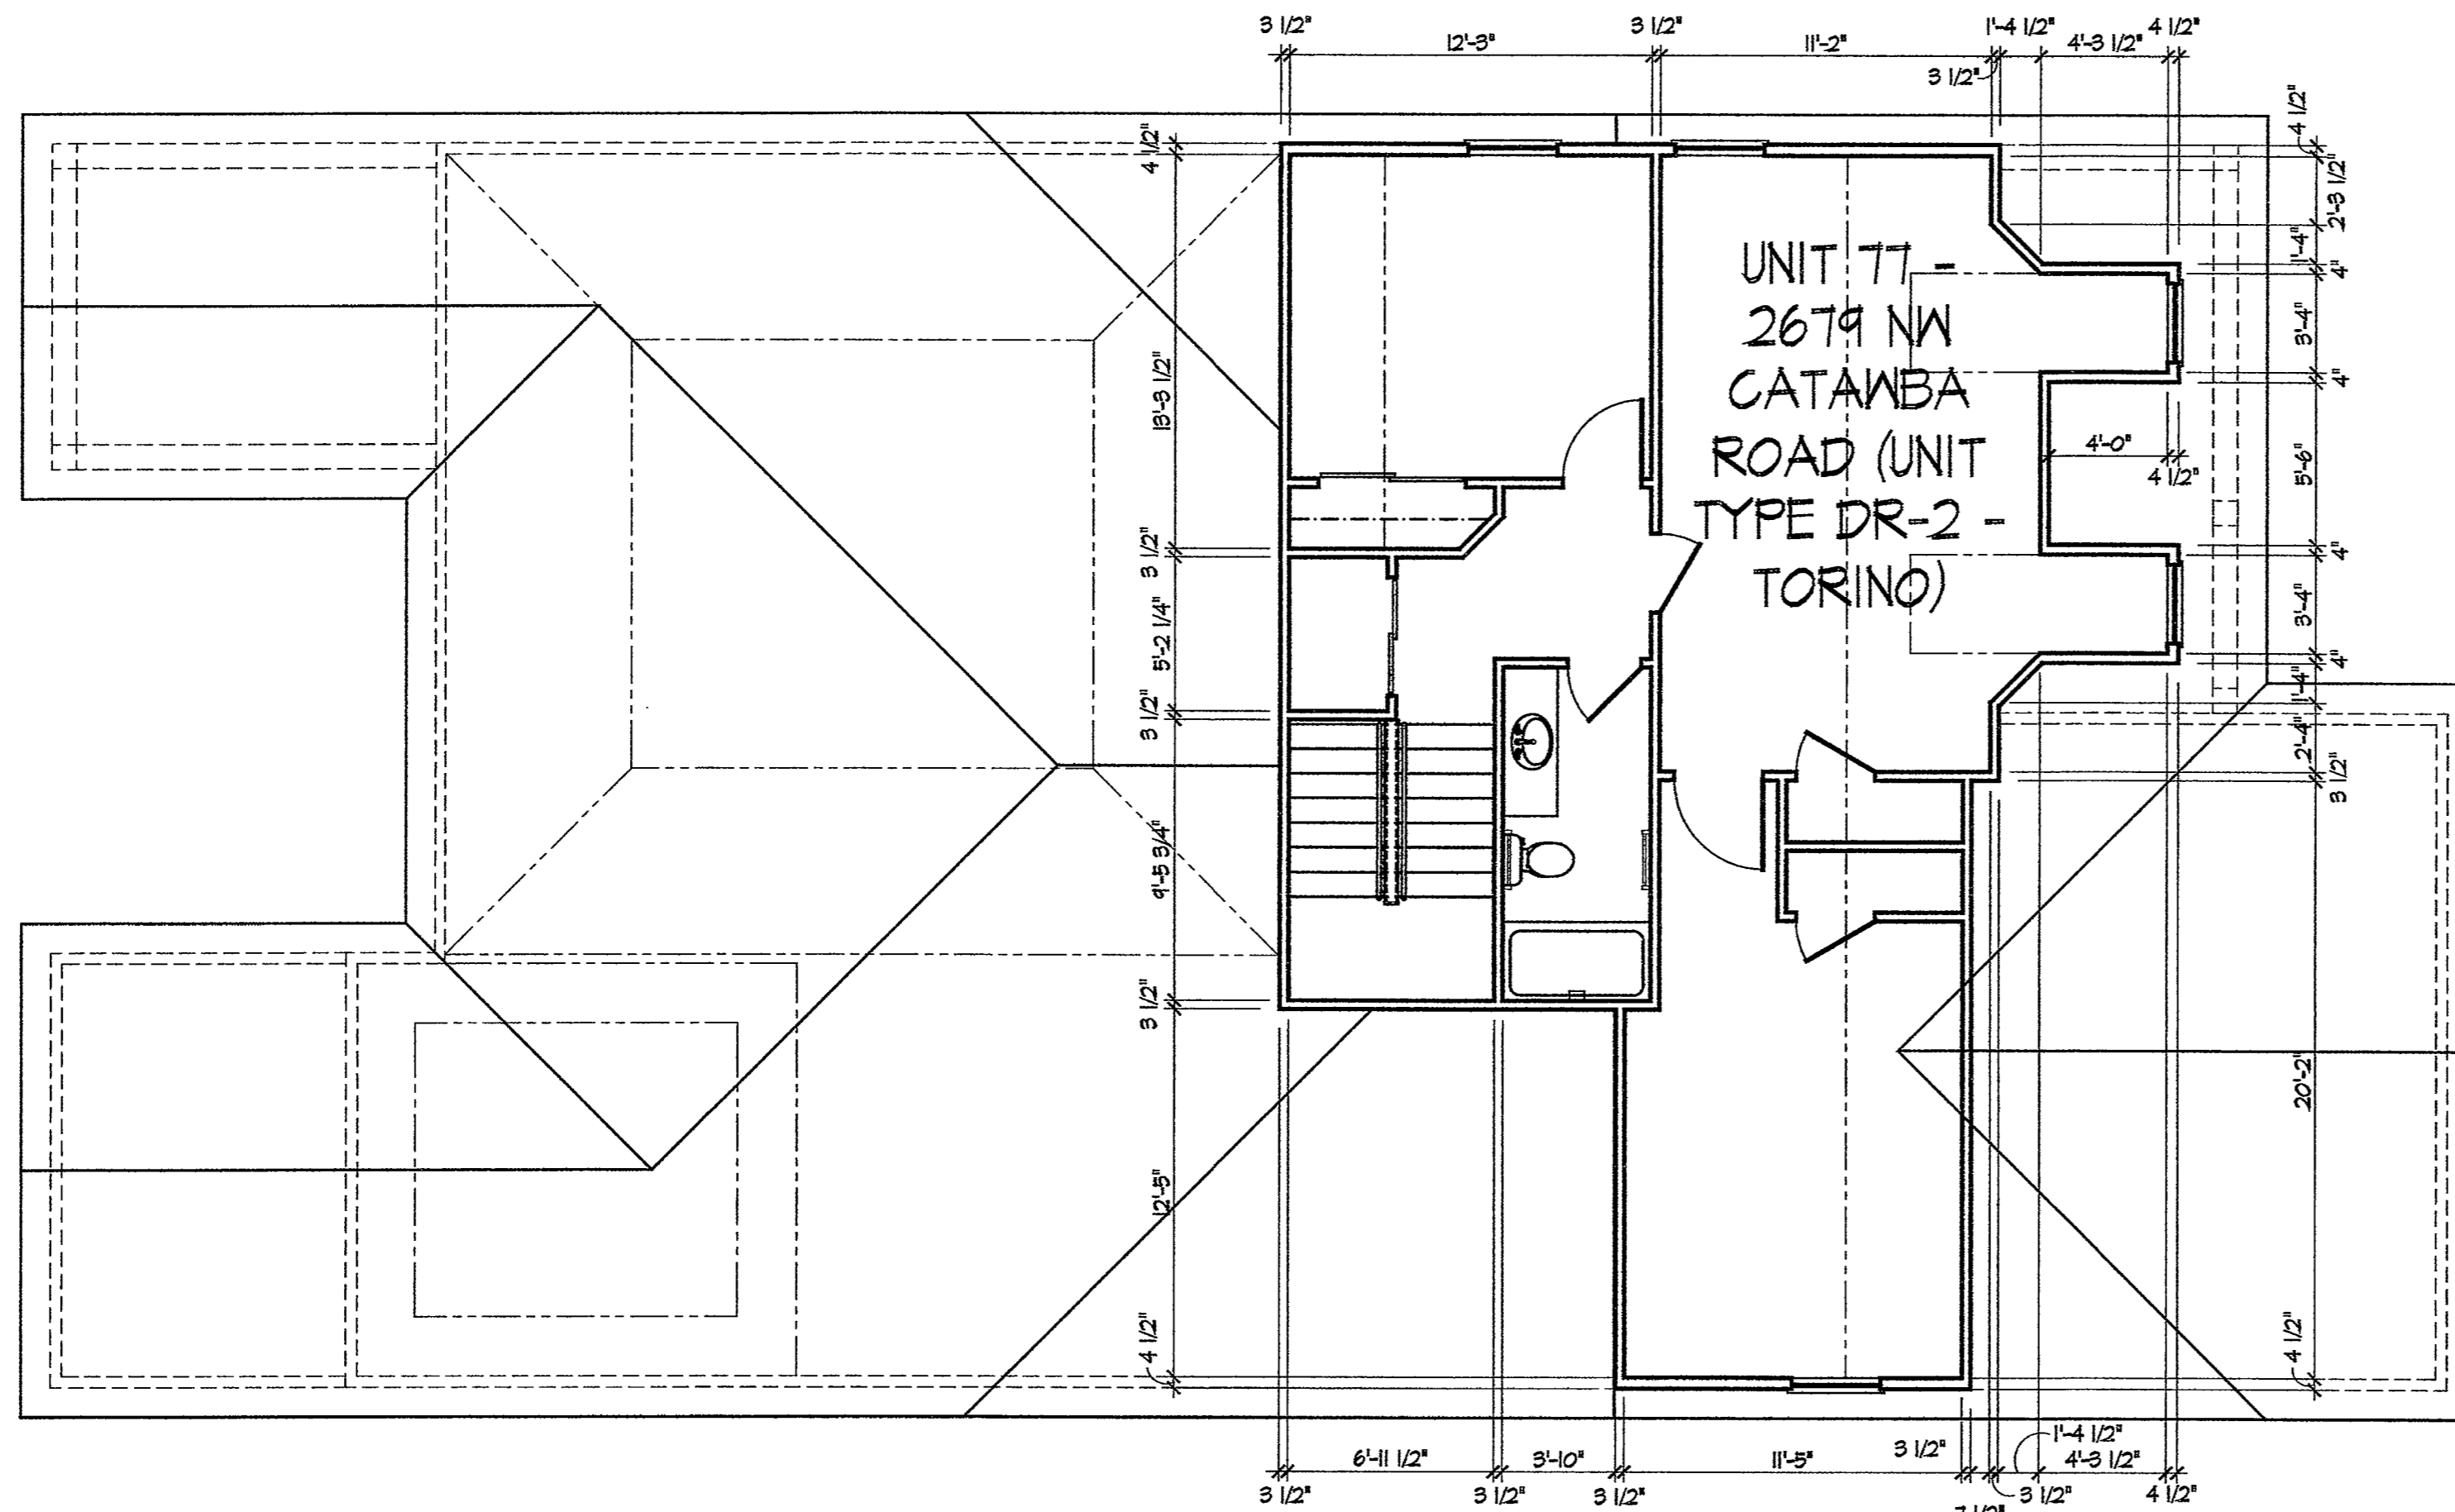


UNIT 77 - Second Floor Plan

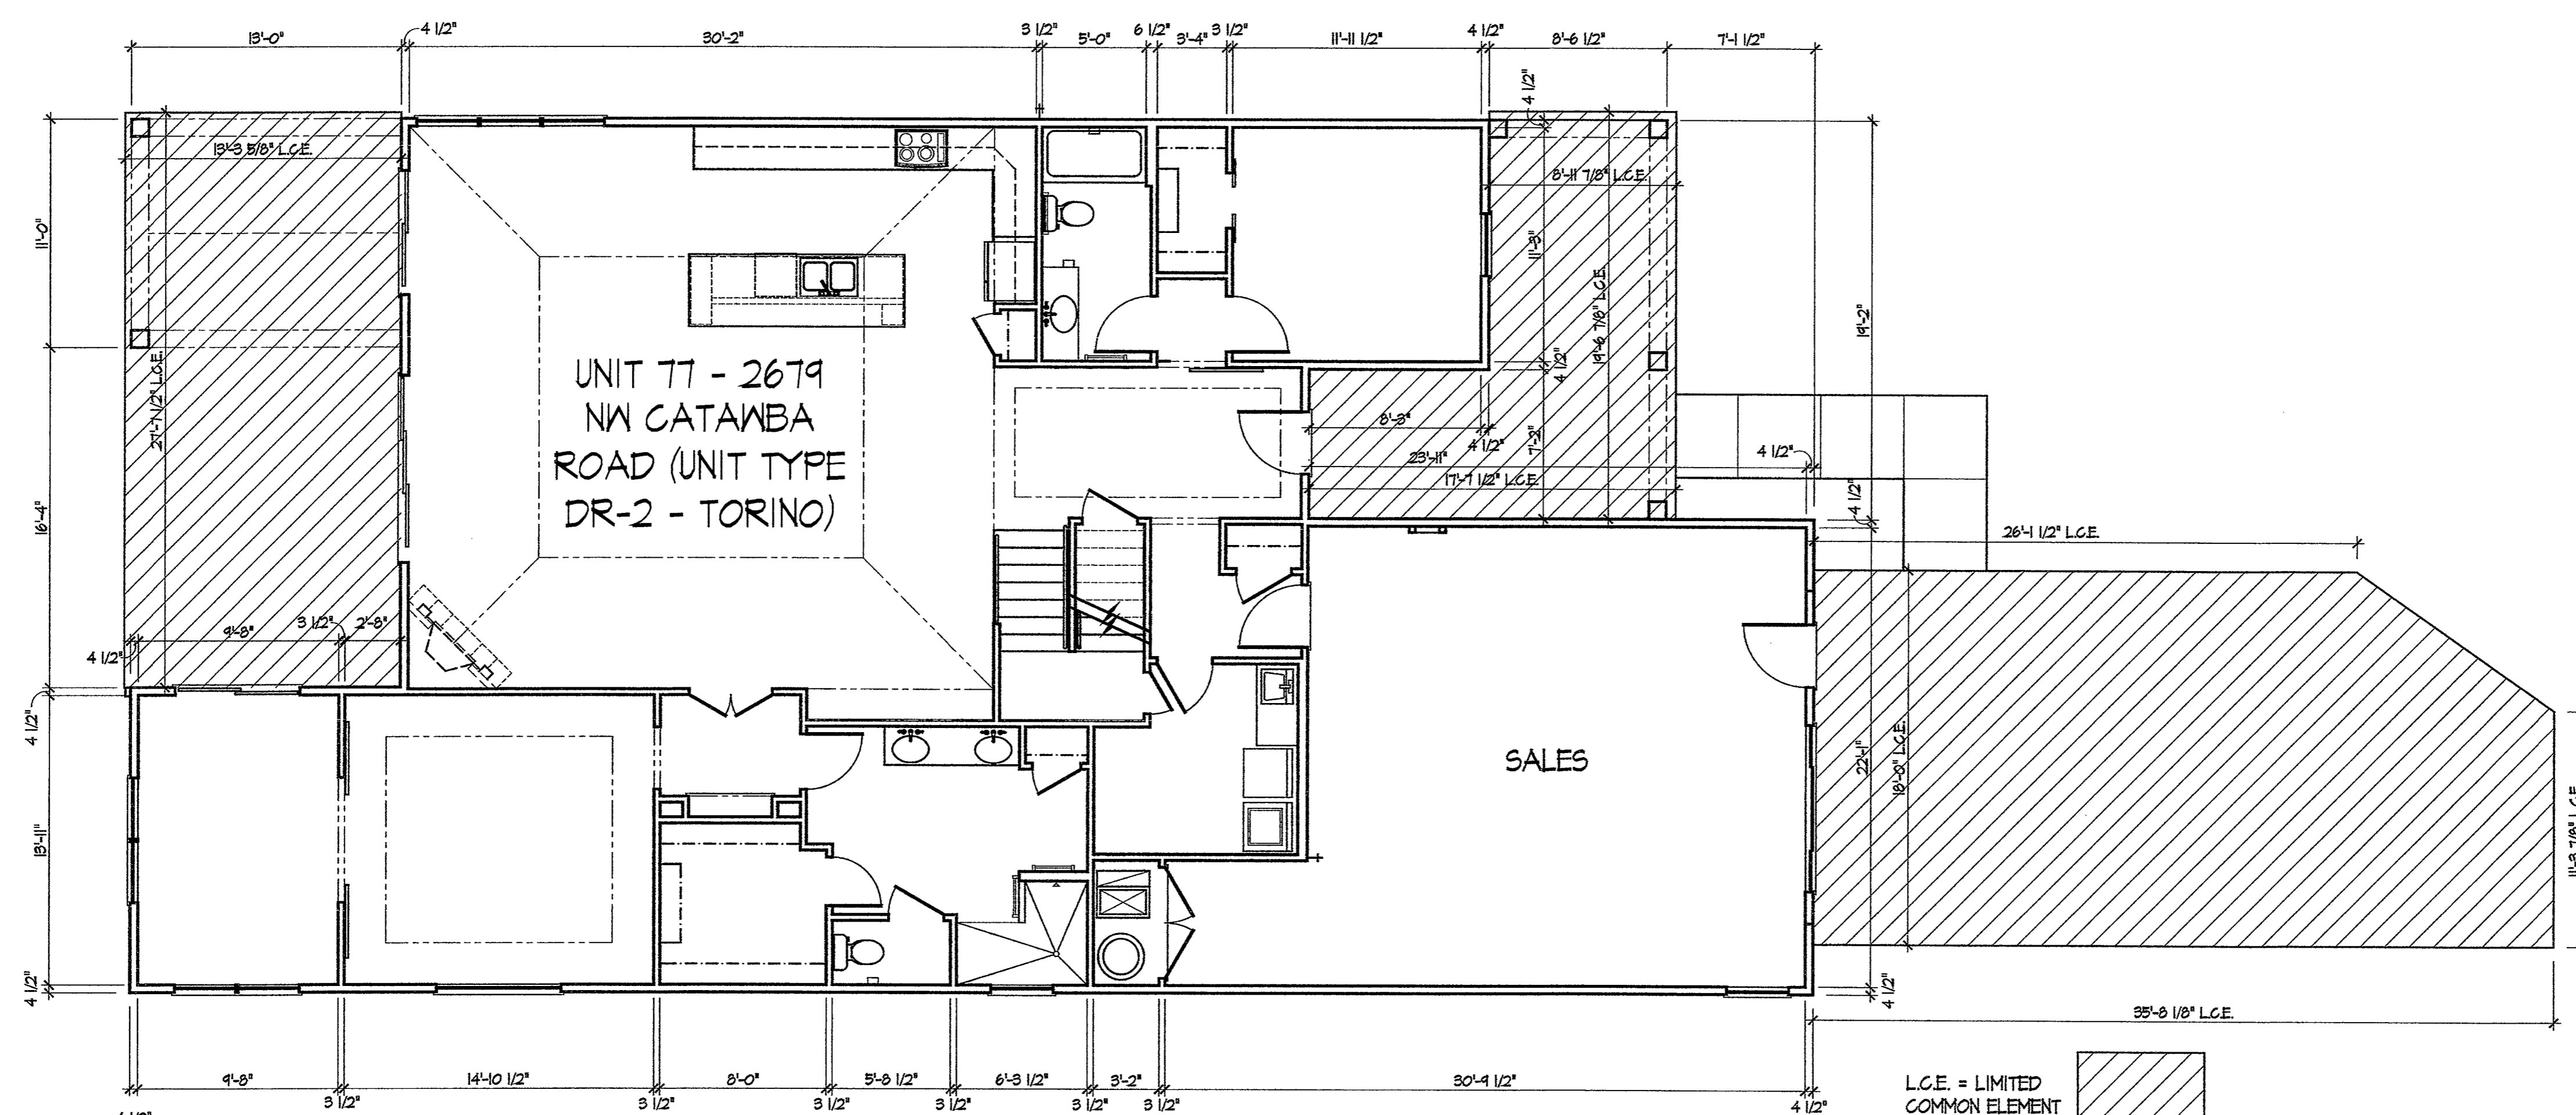

UNIT 77 - First Floor Plan

Architect Project Number
2015-051A


Sheet Number
9 of 10

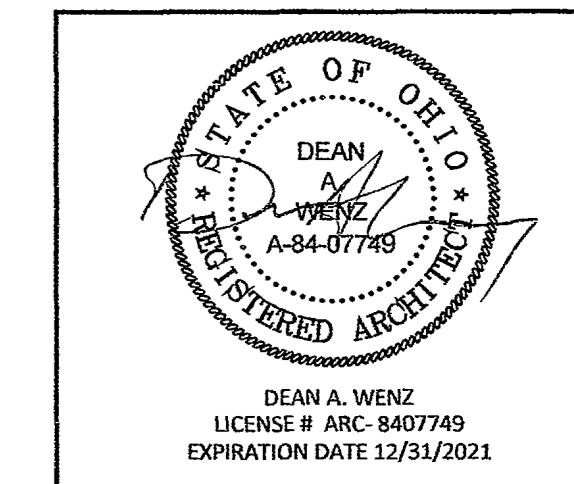



DEAN A. WENZ
ARCHITECTS

2463 E. MAIN STREET
BEXLEY, OHIO 43209
(614) 239-6868
FAX (614) 239-9868

Fairway Estates at Catawba Island Club
Condominium
Fourteenth Amendment

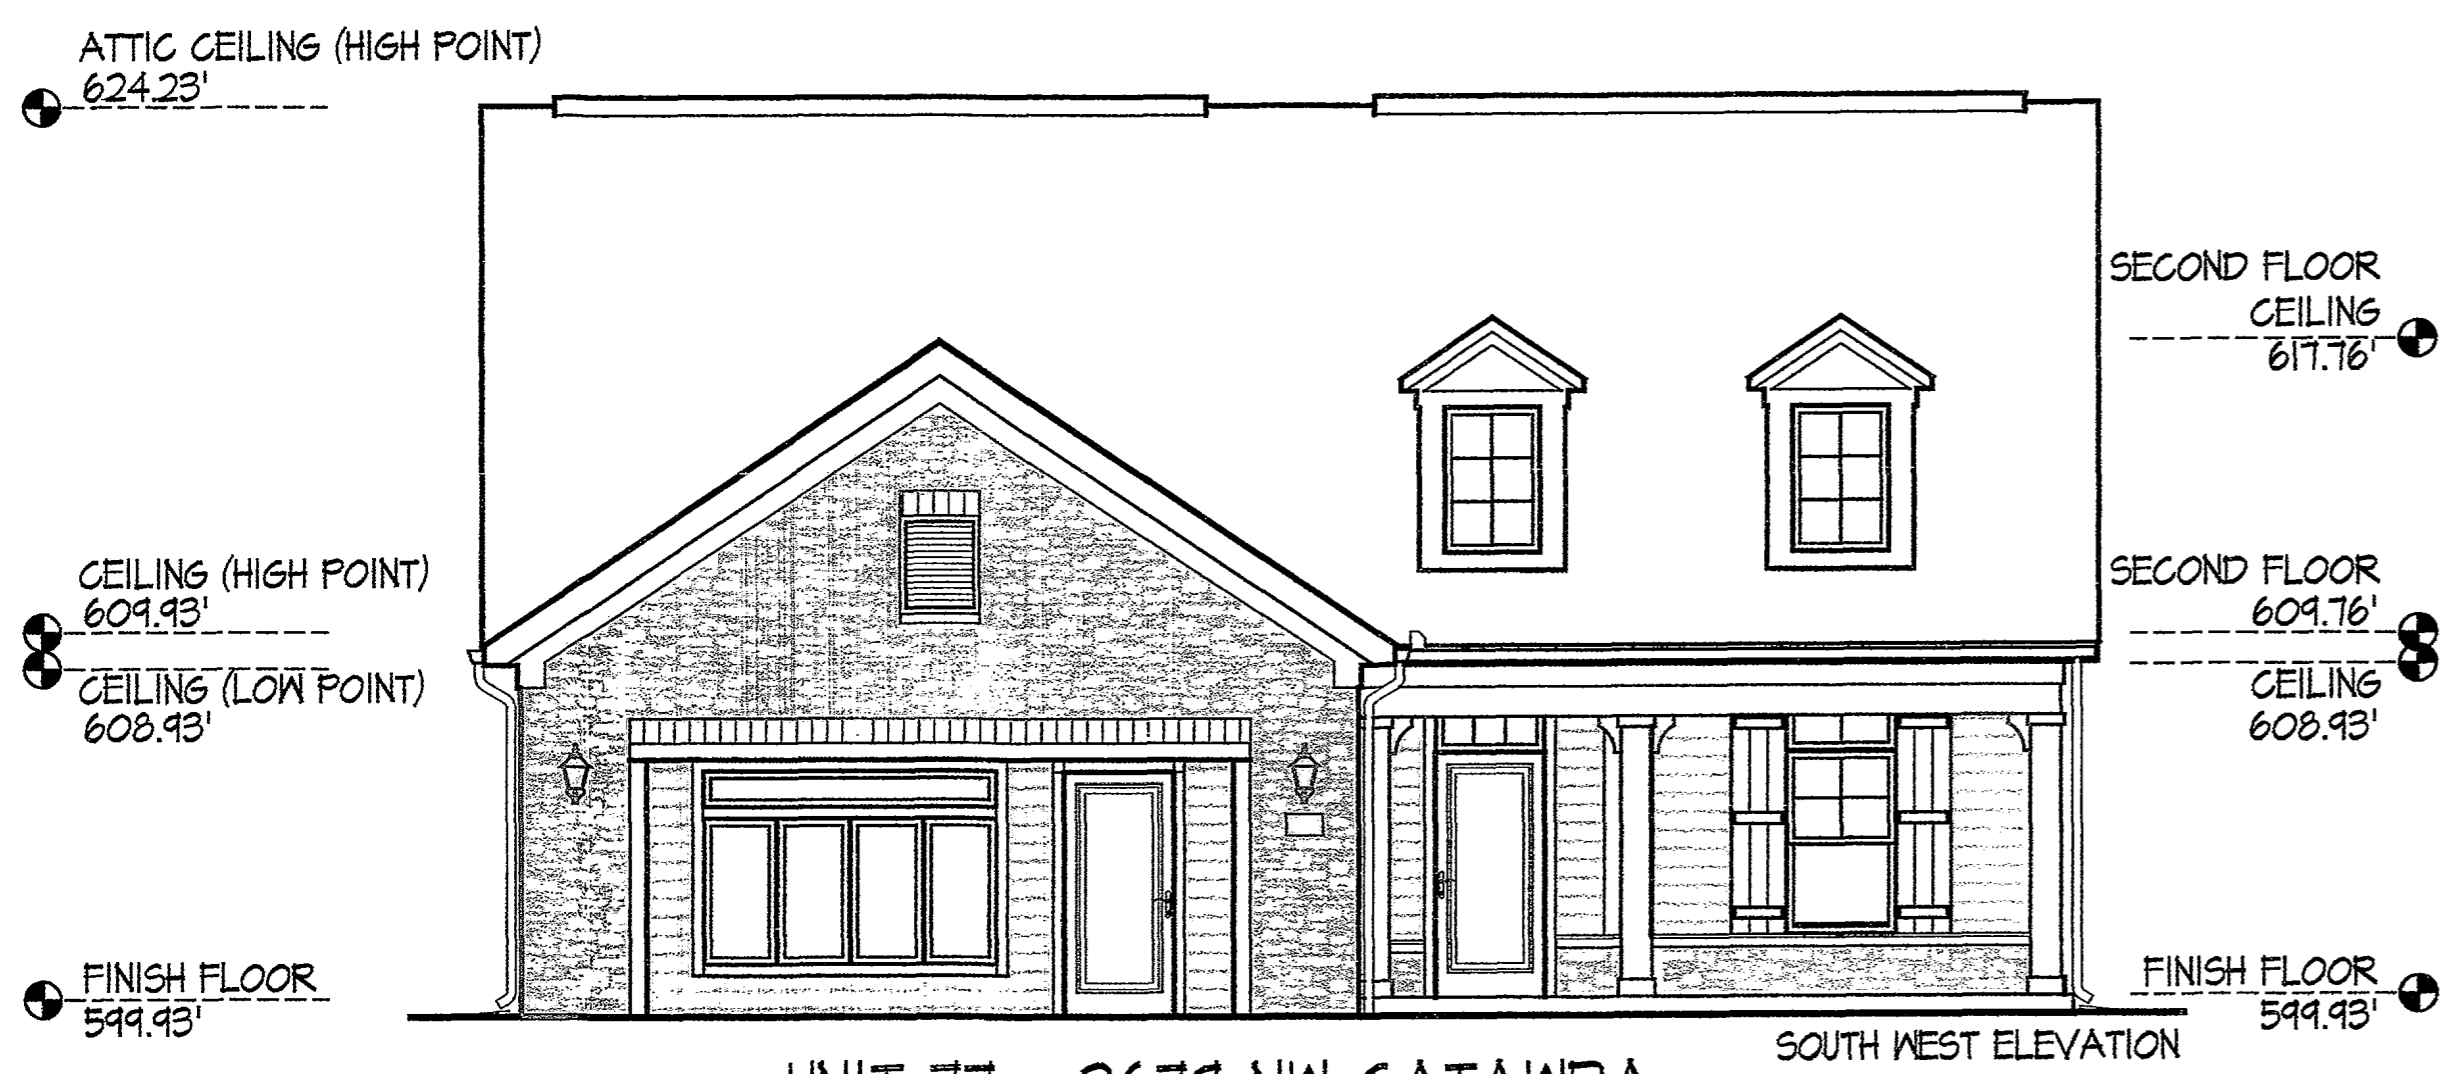

UNIT 77 - 2679 NW CATAWBA
ROAD (UNIT TYPE DR-2 -
TORINO)

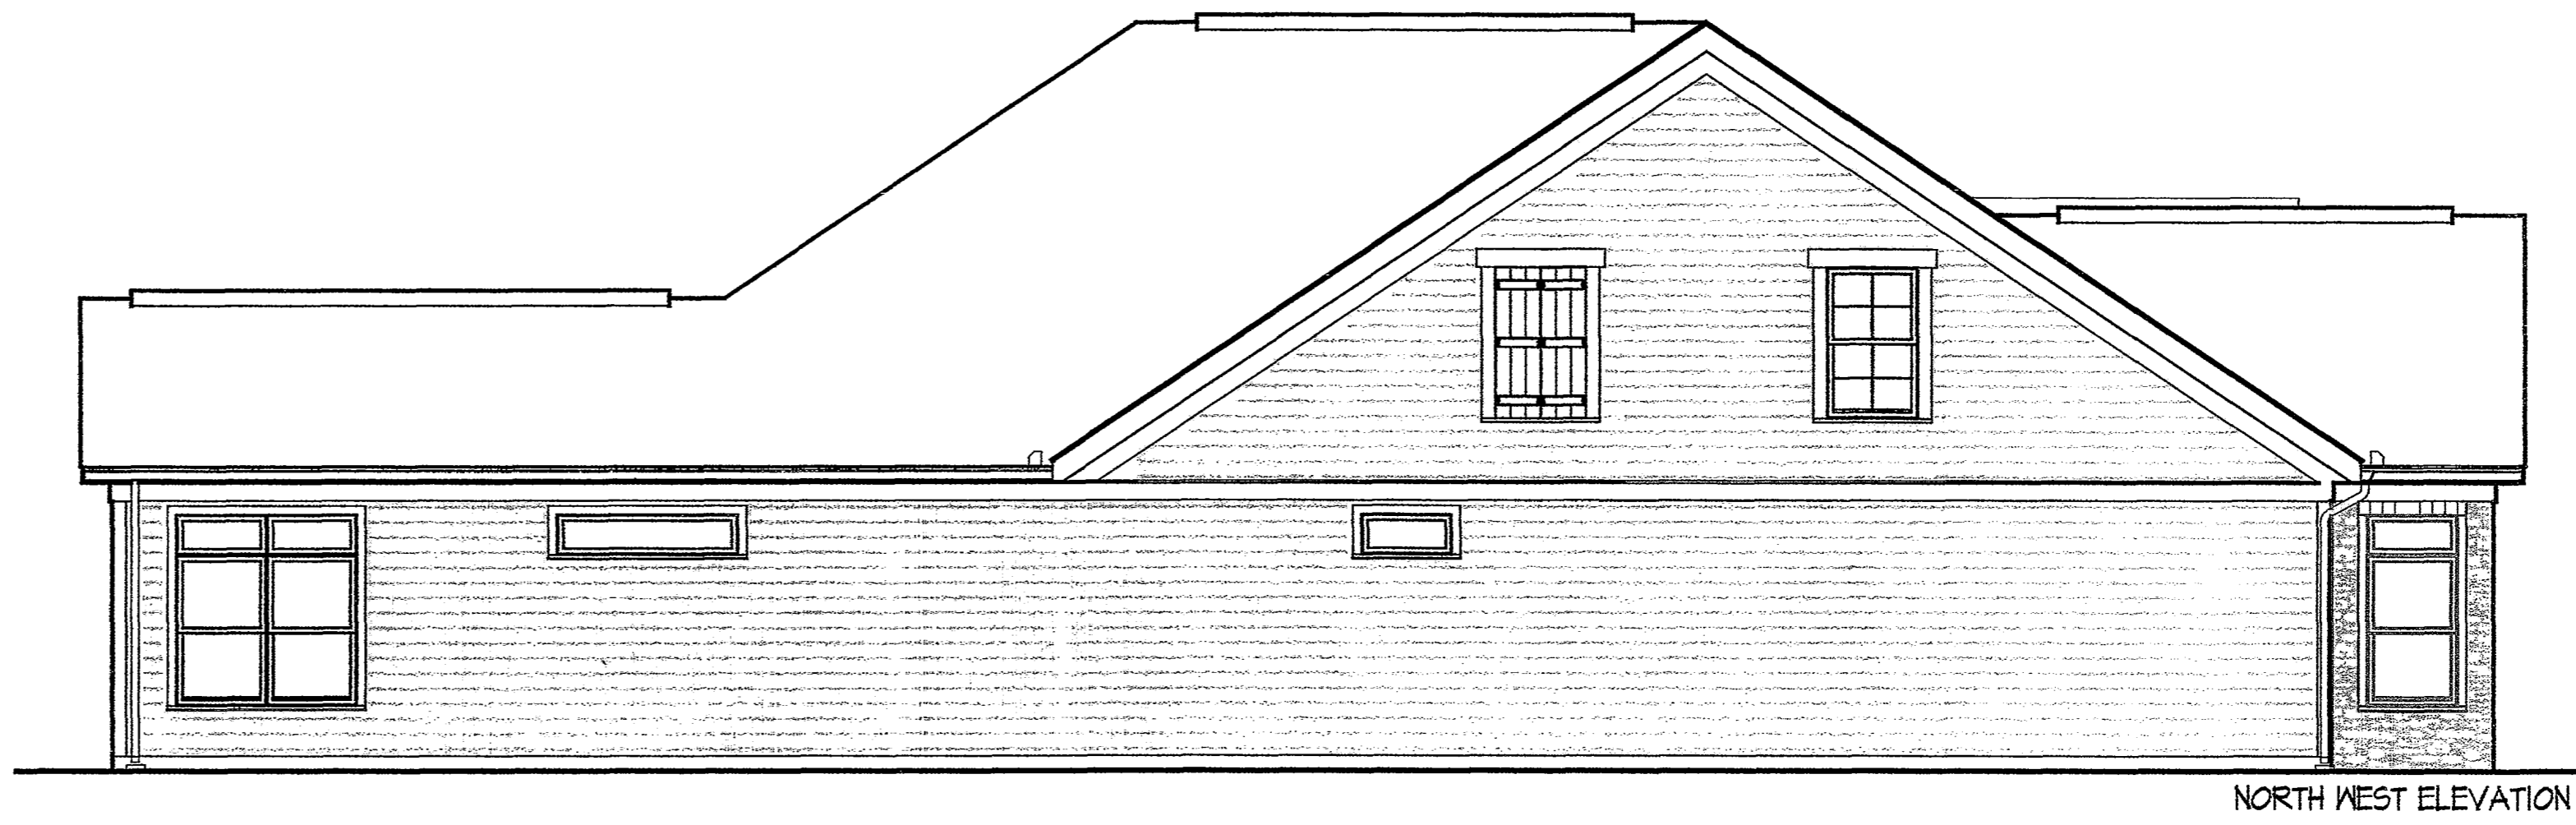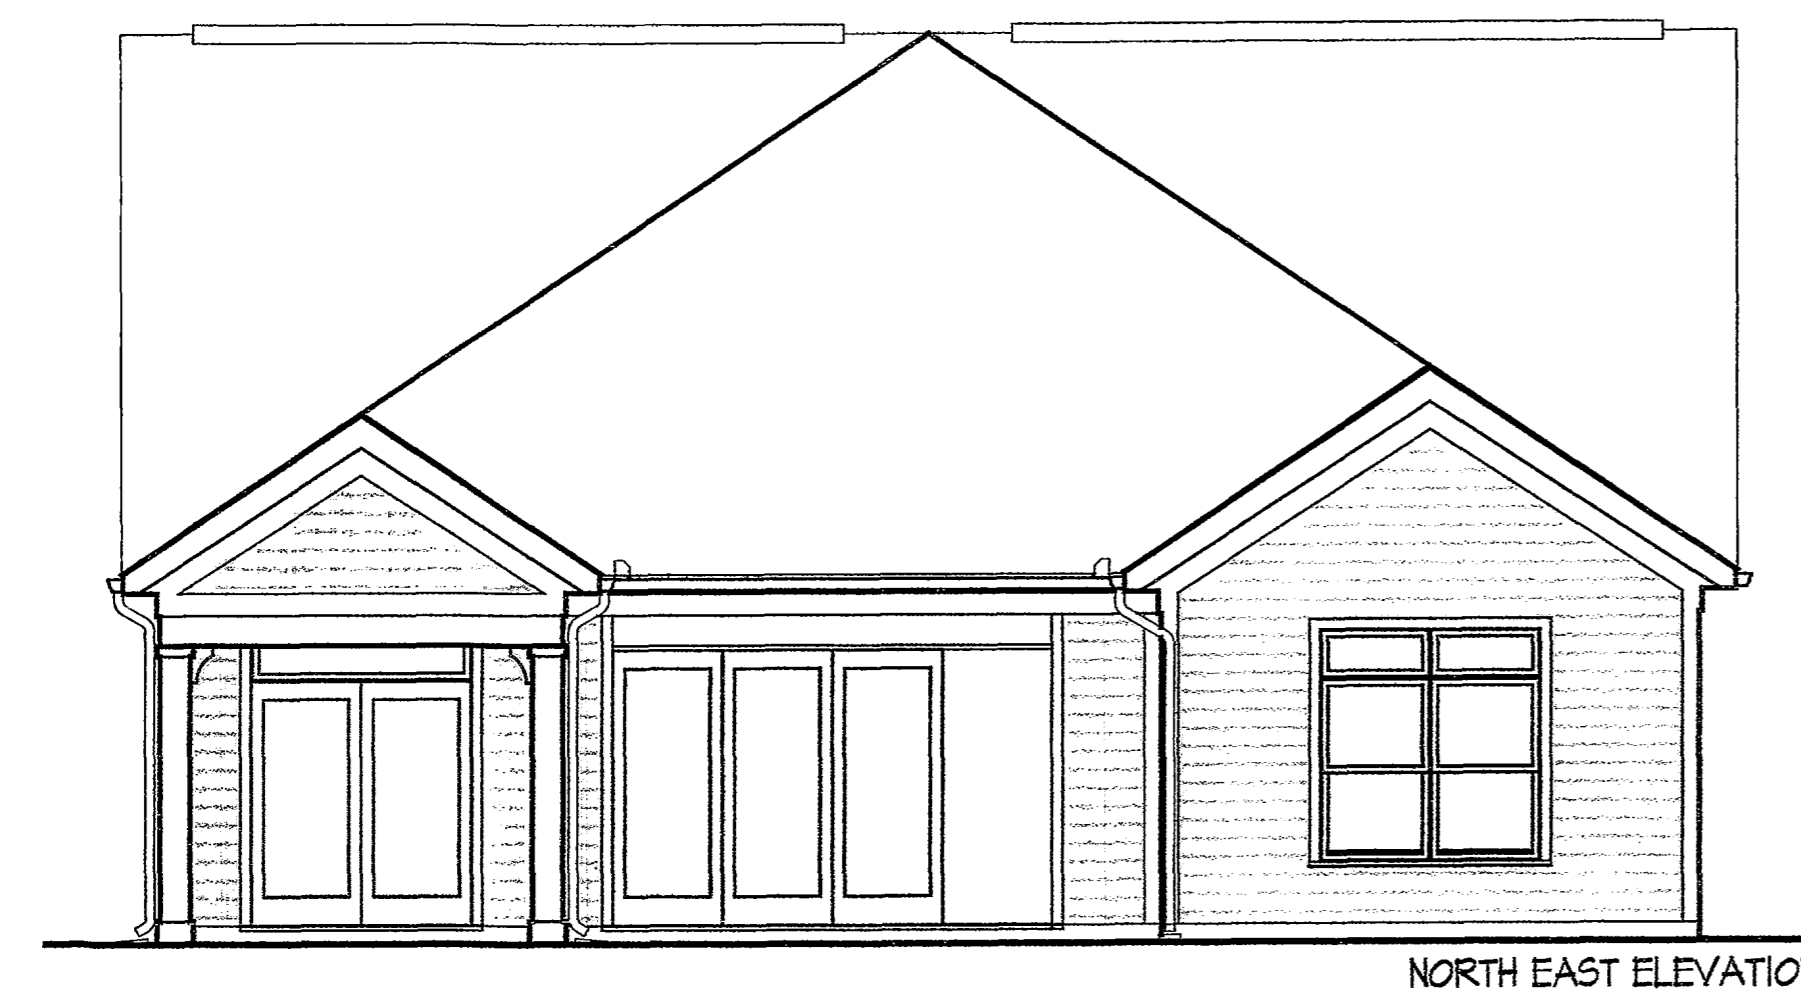

UNIT 77 - Elevations