


BUILDING NO. 38A - First Floor Plan

L.C.E. = LIMITED COMMON ELEMENT



DEAN A. WENZ
ARCHITECTS

2463 E. MAIN STREET
BENTLEY, OHIO 43209
614.239.6868
FAX: 614.239.9868

Fairway Villas at Catawba Island Club
Fifteenth Amendment




I certify that the drawing, consisting of 3 sheets, accurately shows each building of FAIRWAY VILLAGES AT CATAWBA ISLAND CLUB as constructed with respect to the property shown on this drawing, for the sole purpose of complying with ORC 3101.07

Dean A. Wenz Date: 8/19/2011
Dean A. Wenz - Registered Architect by ARC-04-07344

Architect Project Number
2010-014A



Sheet Number
2 of 3

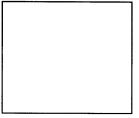

DEAN A. WENZ
ARCHITECTS

2463 E. MAIN STREET
BECKLEY, OHIO 43209
(614) 239-6868
FAX (614) 239-9888

Fairway Villas at Catawba Island Club
Fifteenth Amendment

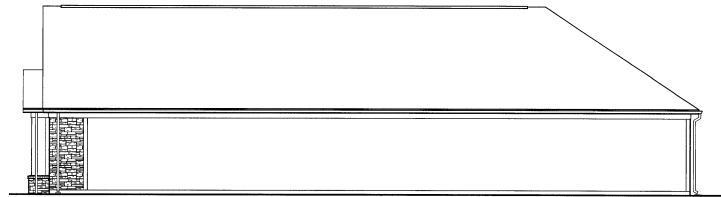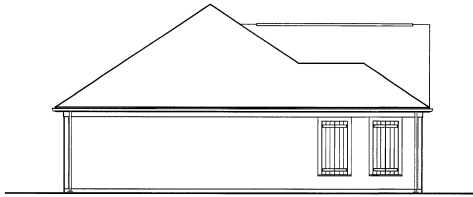

BUILDING NO. 38A - Elevations

Architect Project Number
2010-014A

Sheet Number
3 of 3