

BUILDING NO. 38B - First Floor Plan


DEAN A. WENZ
ARCHITECTS

2463 E. MAIN STREET
BEXLEY, OHIO 43209
(614) 239-6868
FAX (614) 239-9868

**Fairway Villas at Catawba Island Club
Sixteenth Amendment**


I certify that this drawing, consisting of 3 sheets, accurately shows each building of FAIRWAY VILLAS OF CATAWBA ISLAND CLUB, as constructed with respect to the property shown on this drawing, for the sole purpose of complying with ORC 5311.07

By *DAW* Date 10/13/2011
Dean A. Wenz - Registered Architect No/ARC-04-0744

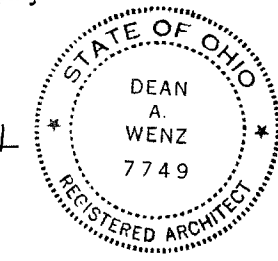

Architect Project Number
2010-014A

Sheet Number
2 of 3


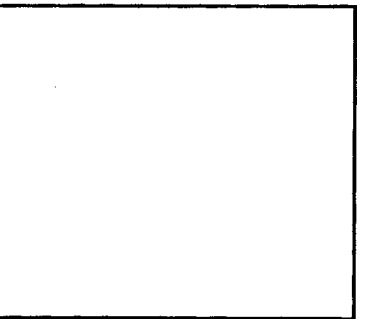


CEILING (HIGH POINT)
605.50'
CEILING (LOW POINT)
604.50'

FINISH FLOOR
545.50'



UNIT 38B - 2794
CANTERBURY CIRCLE

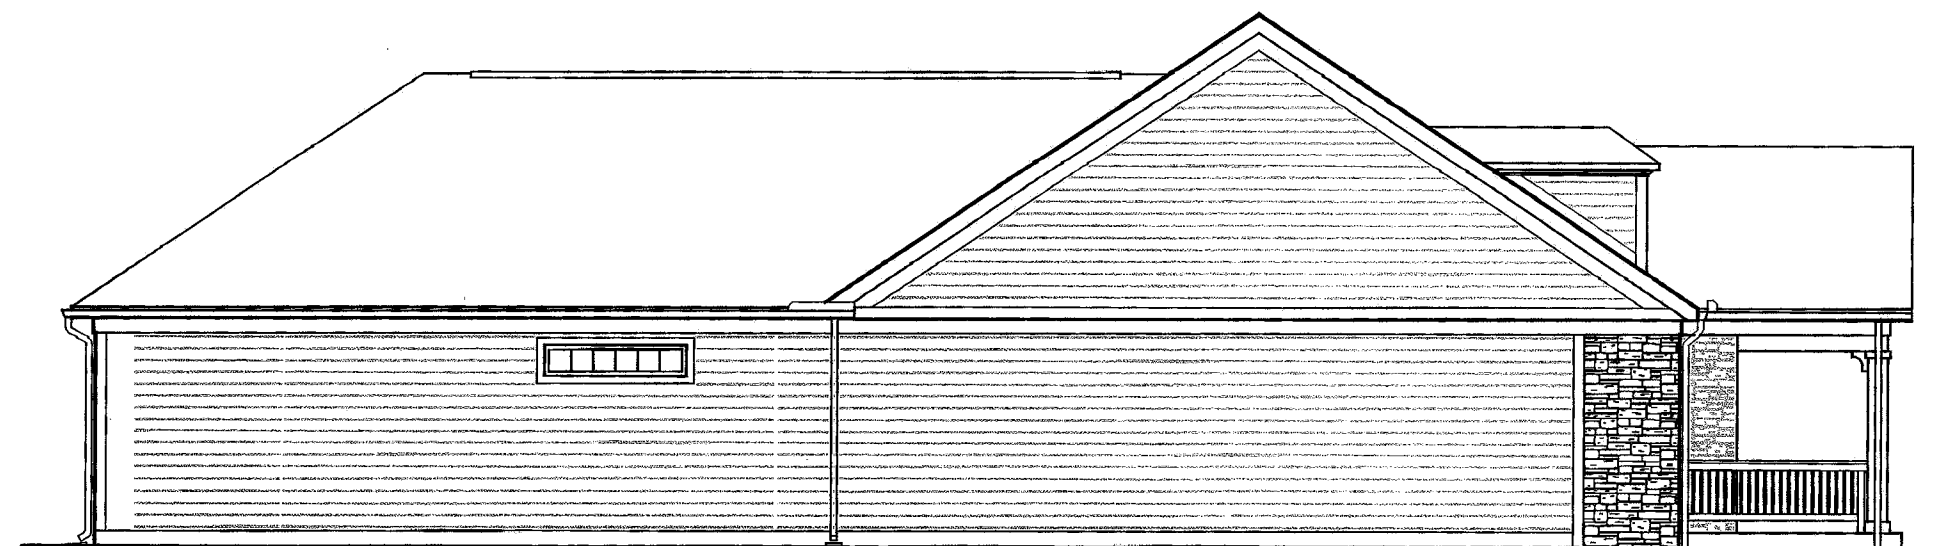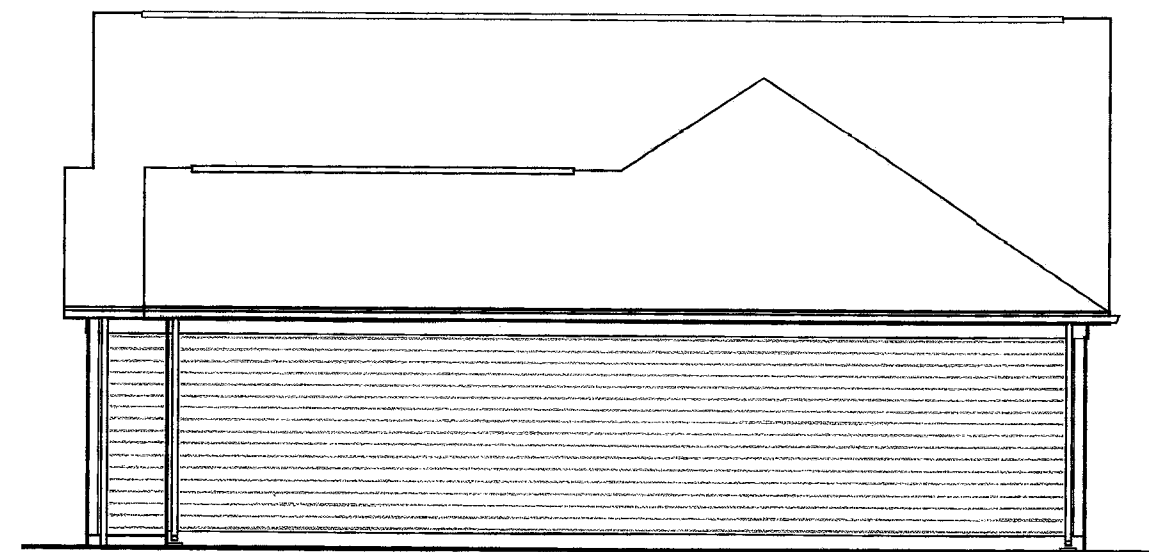

BUILDING NO. 38B - Elevations

DEAN A. WENZ
ARCHITECTS

2463 E. MAIN STREET
BEXLEY, OHIO 43209
(614) 239-6868
FAX (614) 239-9868

Fairway Villas at Catawba Island Club
Sixteenth Amendment