


FLOOR PLAN


CLUBHOUSE
2675 CANTERBURY CIRCLE
SCALE:
0 1 2 3 4 6




LEFT ELEVATION

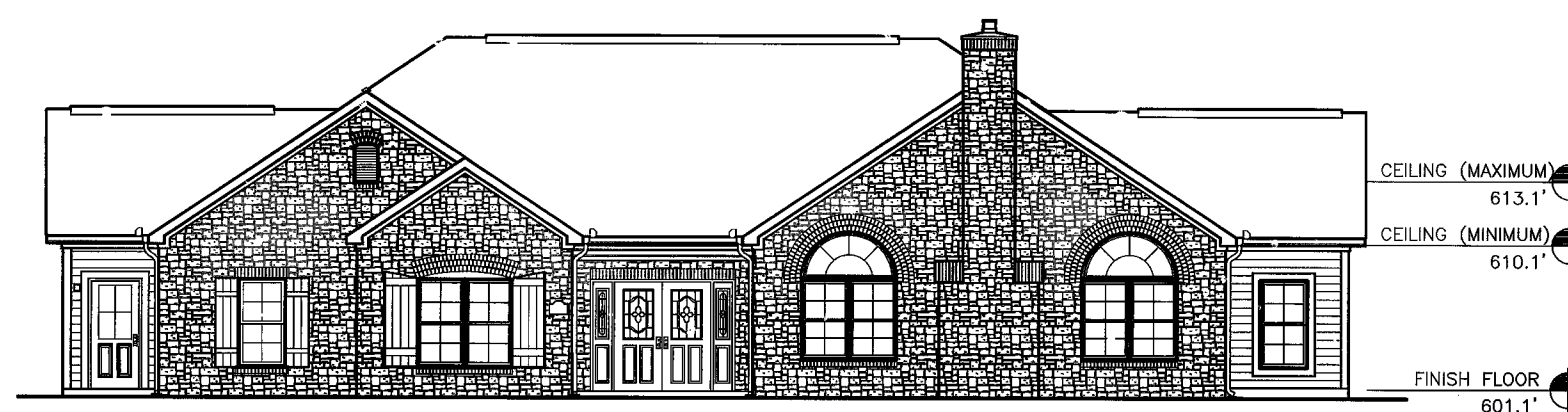


FRONT ELEVATION

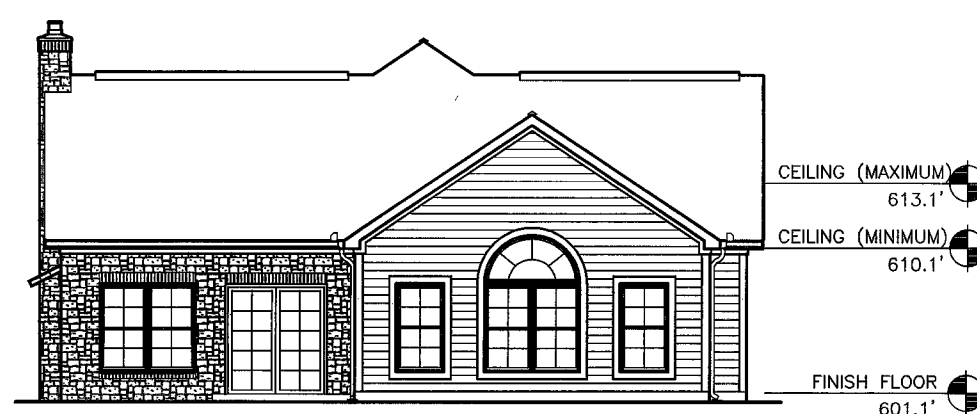

RIGHT ELEVATION

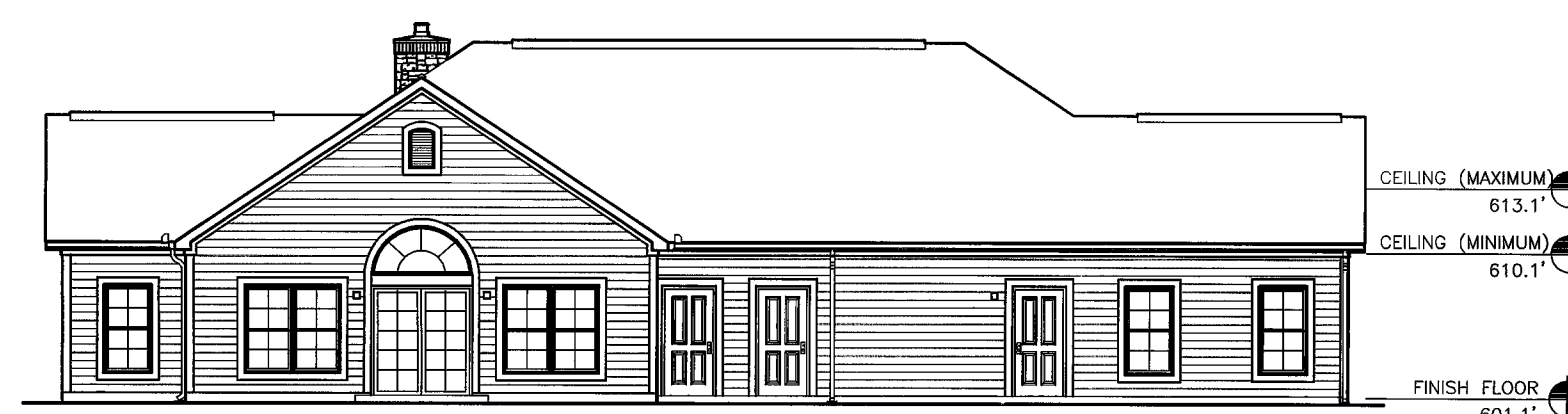

REAR ELEVATION

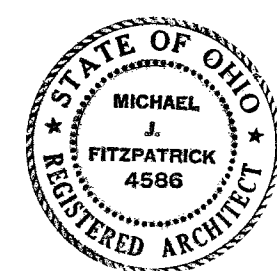


I certify that this drawing, consisting of 11 sheets, accurately shows each building of FAIRWAY VILLAS AT CATAWBA ISLAND CLUB, as constructed with respect to the property shown on this drawing, for the sole purpose of complying with ORC 5311.07

By Michael J. Fitzpatrick - Registered Architect No. 4586 Date 11/29/05

EXHIBIT "C"
Page 3 of 11



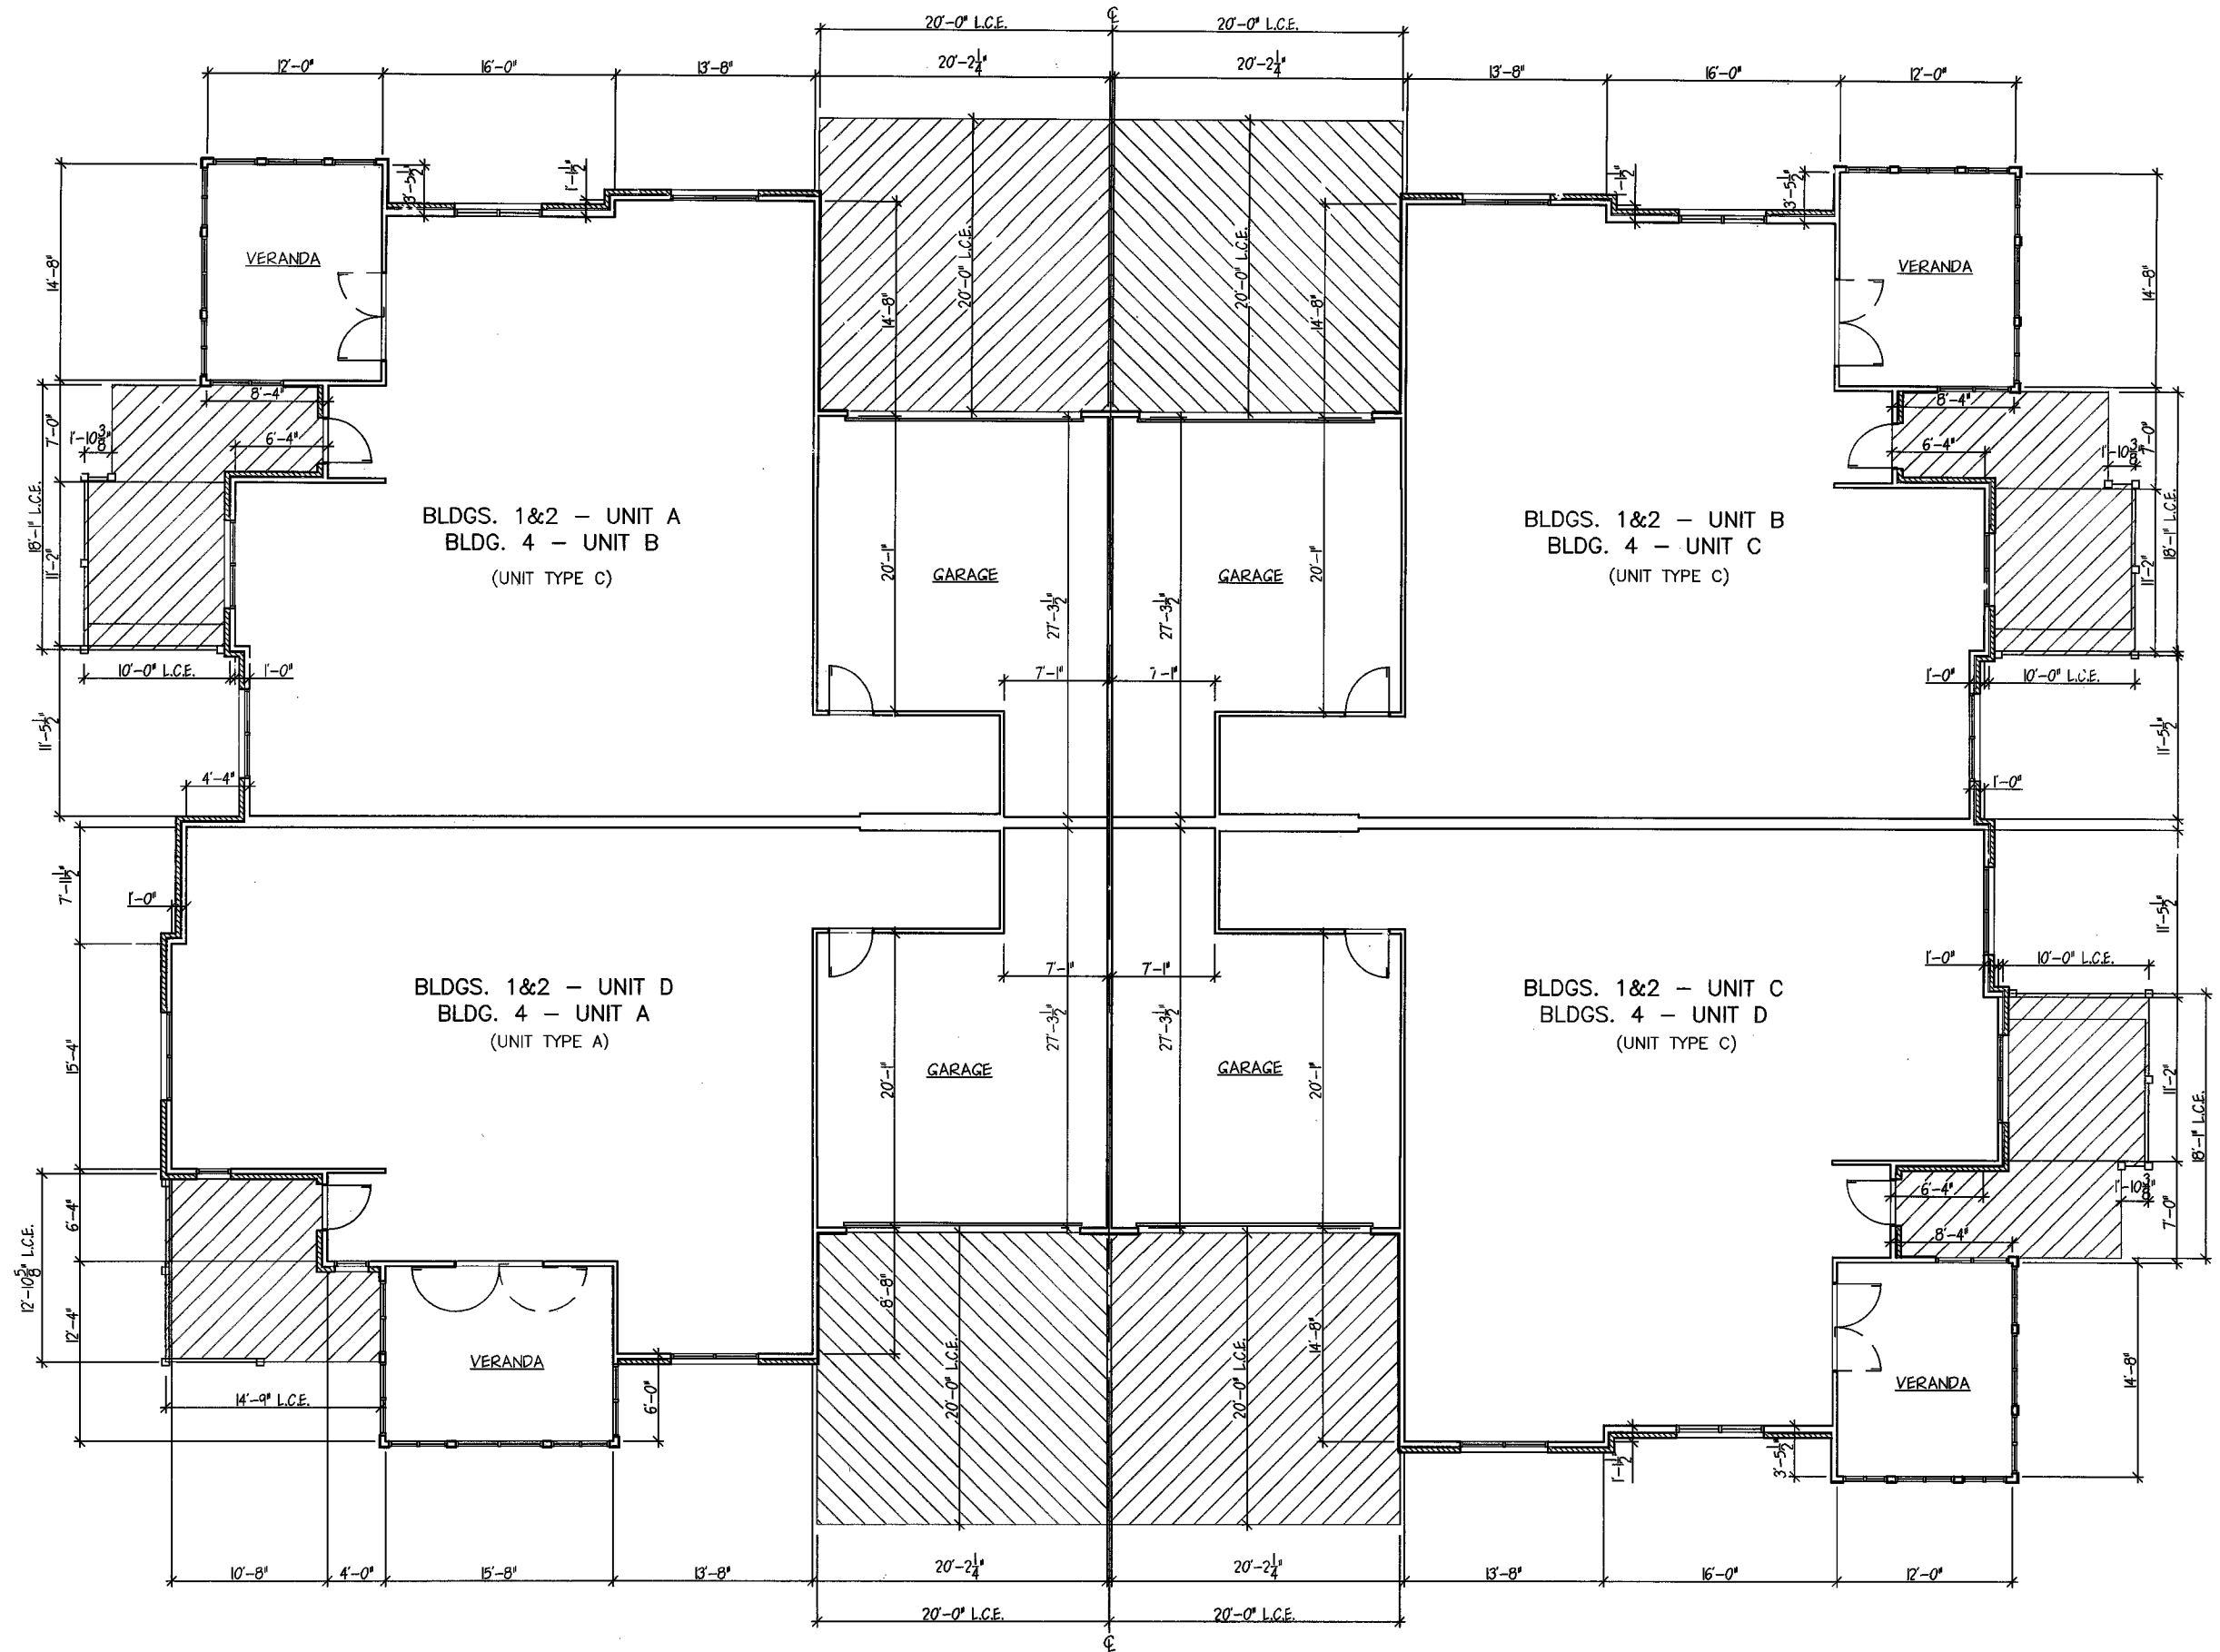

FLOOR PLAN





SCALE:
0 1 2 3 4 6

BUILDING NO. 1-2885 CANTERBURY CIRCLE
 BUILDING NO. 2-2680 CANTERBURY CIRCLE
 BUILDING NO. 4-4700 ABBEY ROAD

NOTE:
 AREAS DESIGNATED THIS: INDICATES LIMITED COMMON ELEMENT PERTAINING TO ADJACENT UNIT
 L.C.E. = LIMITED COMMON ELEMENT

EXHIBIT "C"
 Page 4 of 11



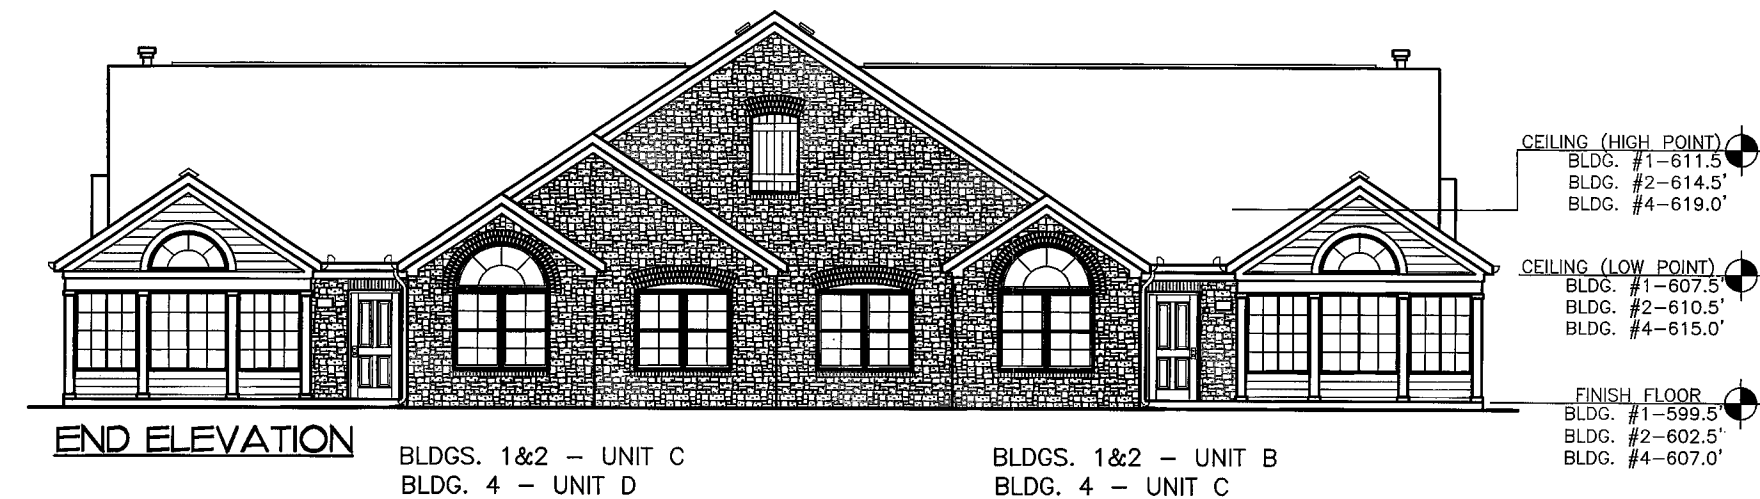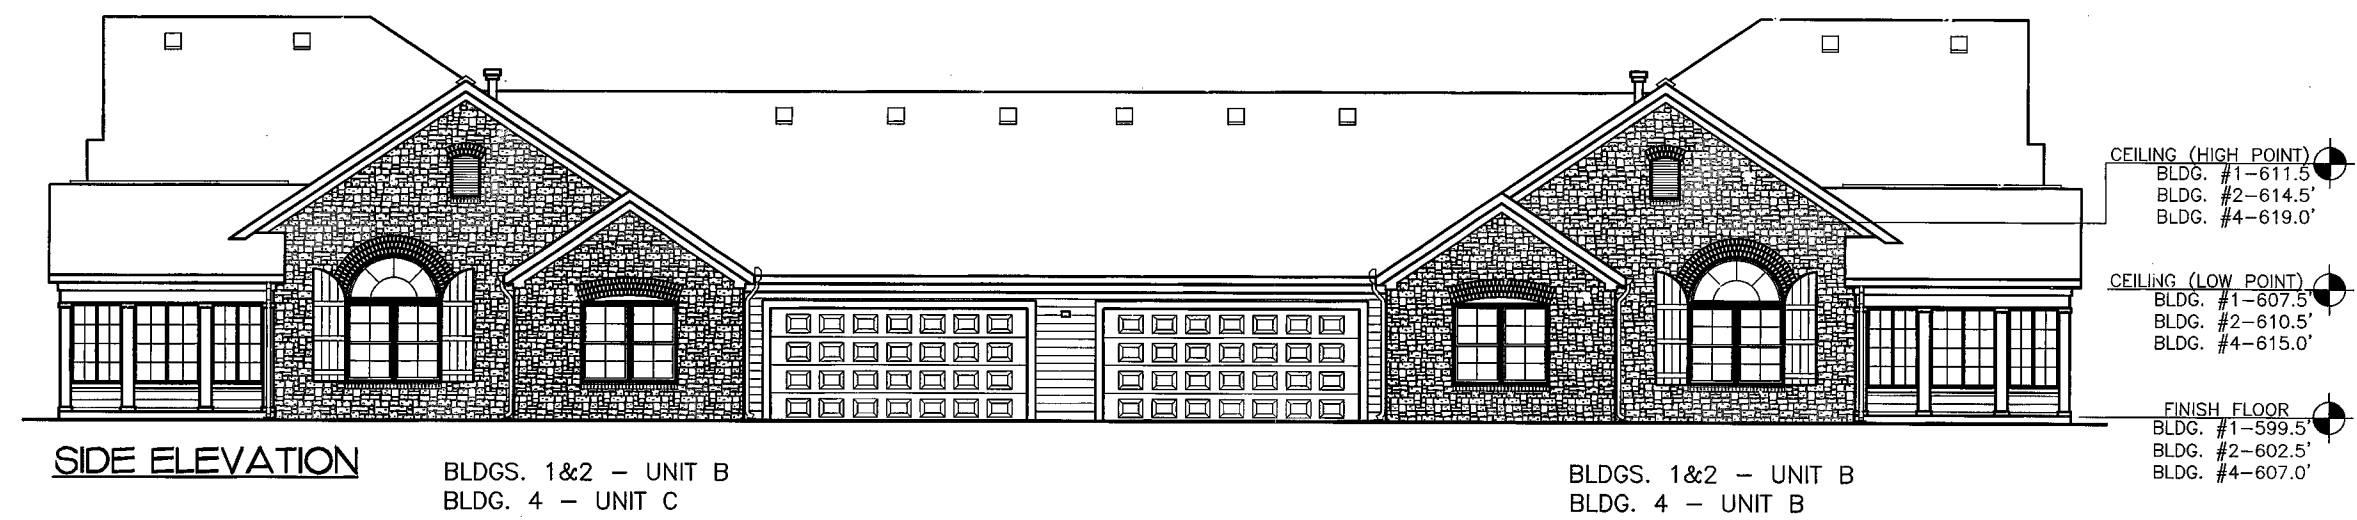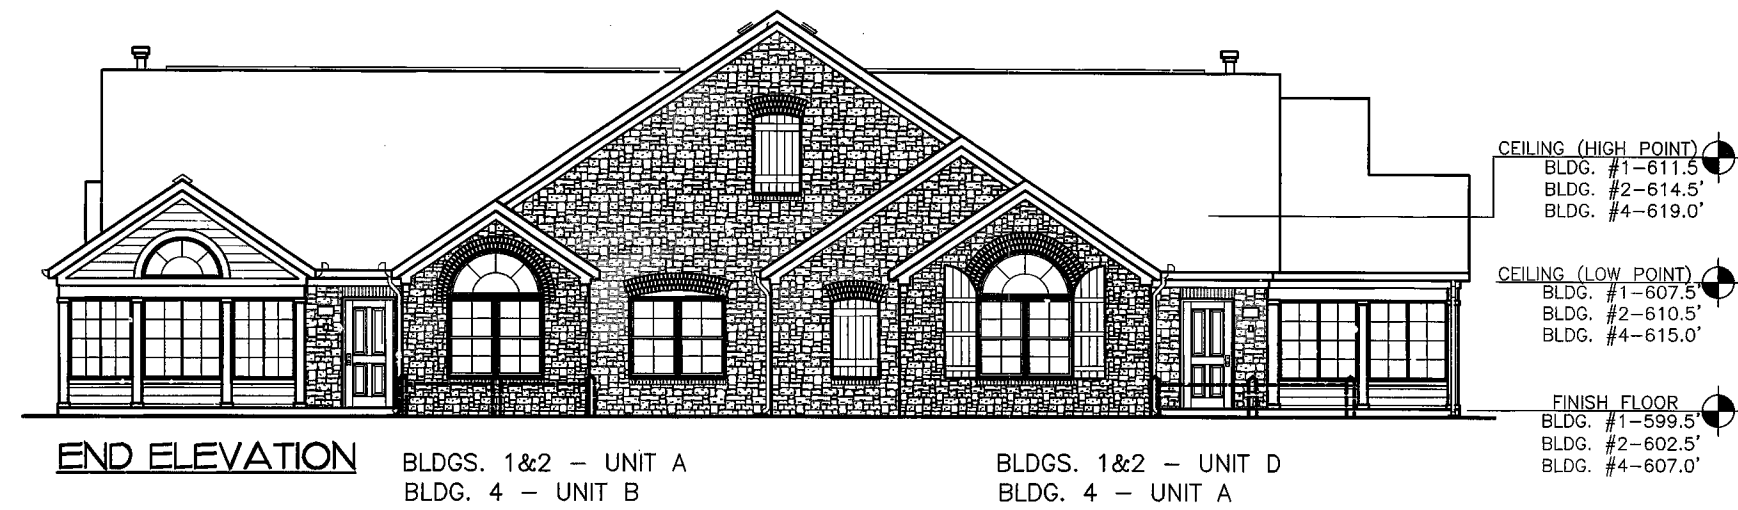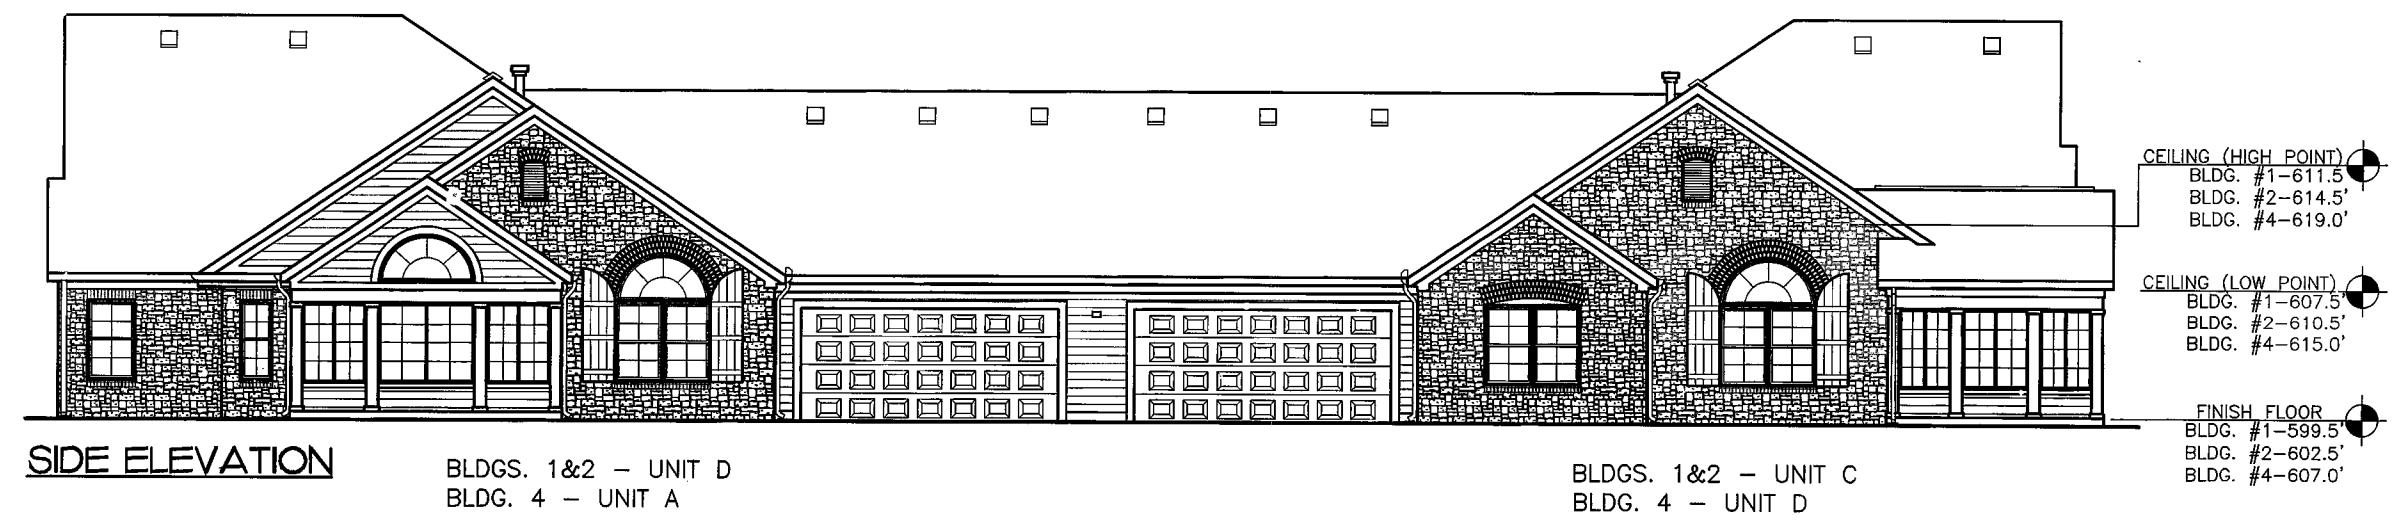


BUILDING NO. 1-2885 CANTERBURY CIRCLE
 BUILDING NO. 2-2680 CANTERBURY CIRCLE
 BUILDING NO. 4-4700 ABBEY ROAD

SCALE:
 0 1 2 3 4 8


EXHIBIT "C"
 Page 5 of 11



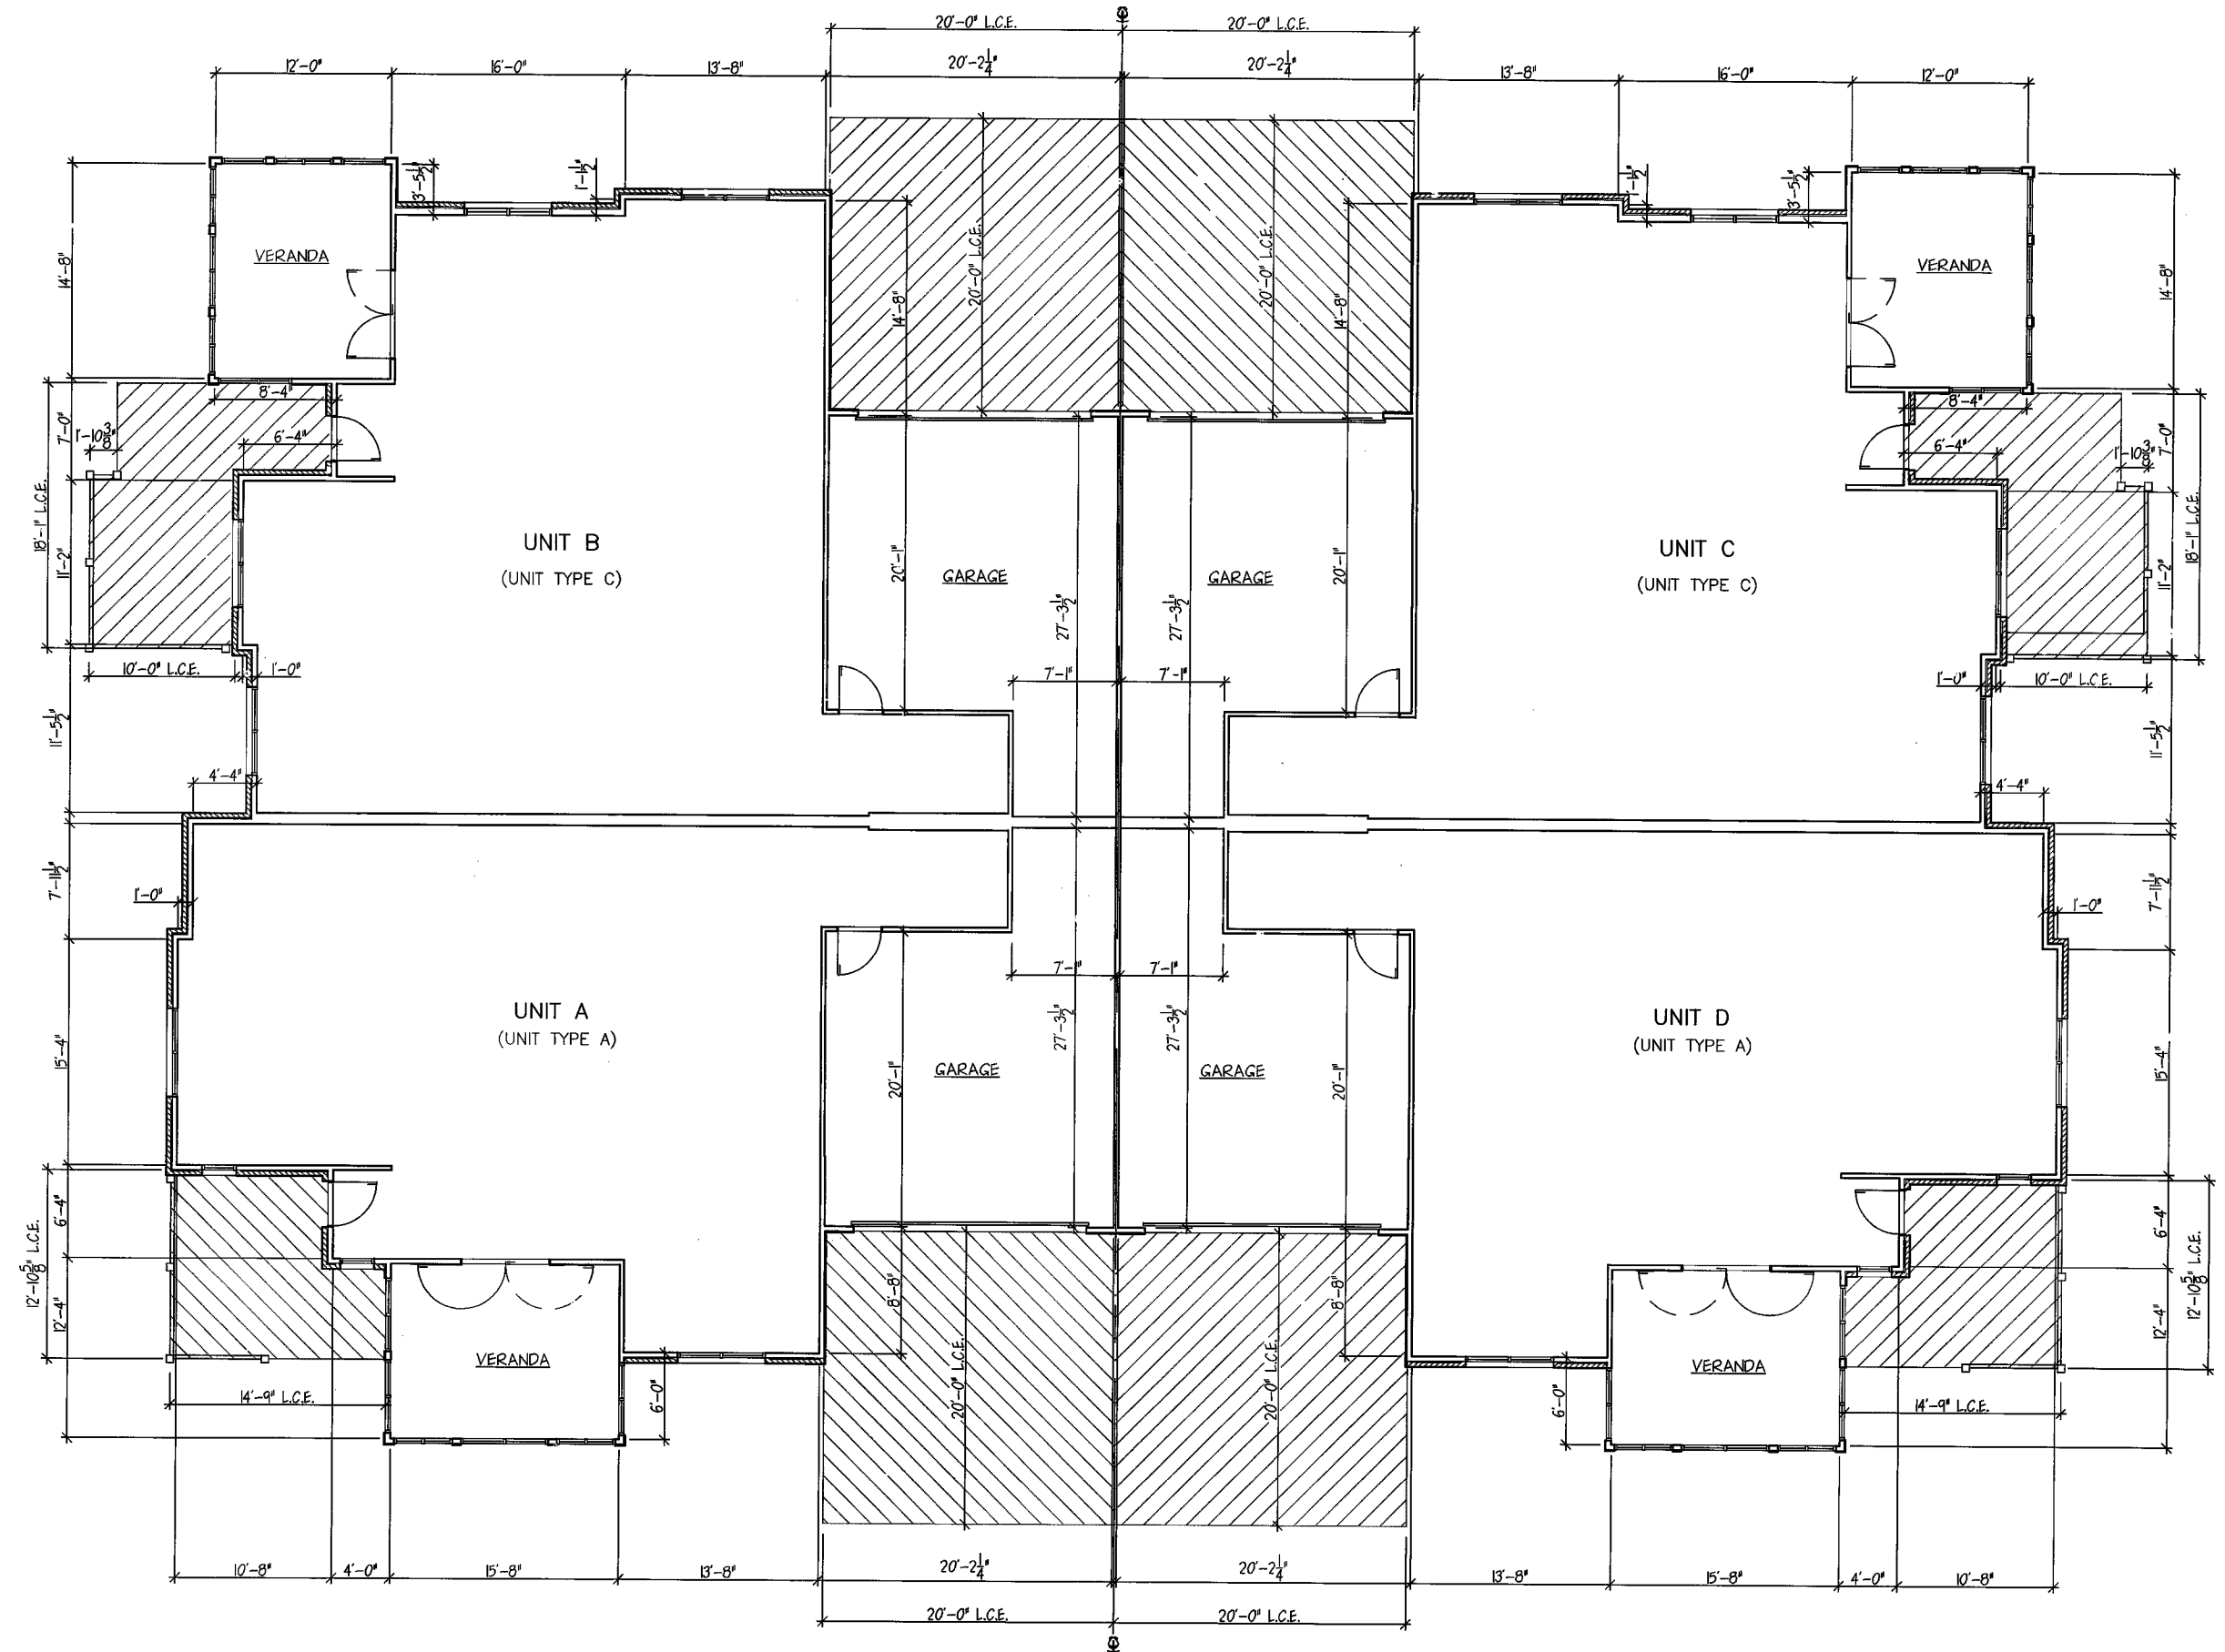

FLOOR PLAN




BUILDING NO. 3-4711 ABBEY ROAD

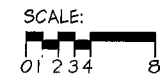

NOTE:
 [Hatched Area Symbol] AREAS DESIGNATED THIS; INDICATES LIMITED COMMON ELEMENT PERTAINING TO ADJACENT UNIT
 L.C.E. = LIMITED COMMON ELEMENT

EXHIBIT "C"
Page 6 of 11



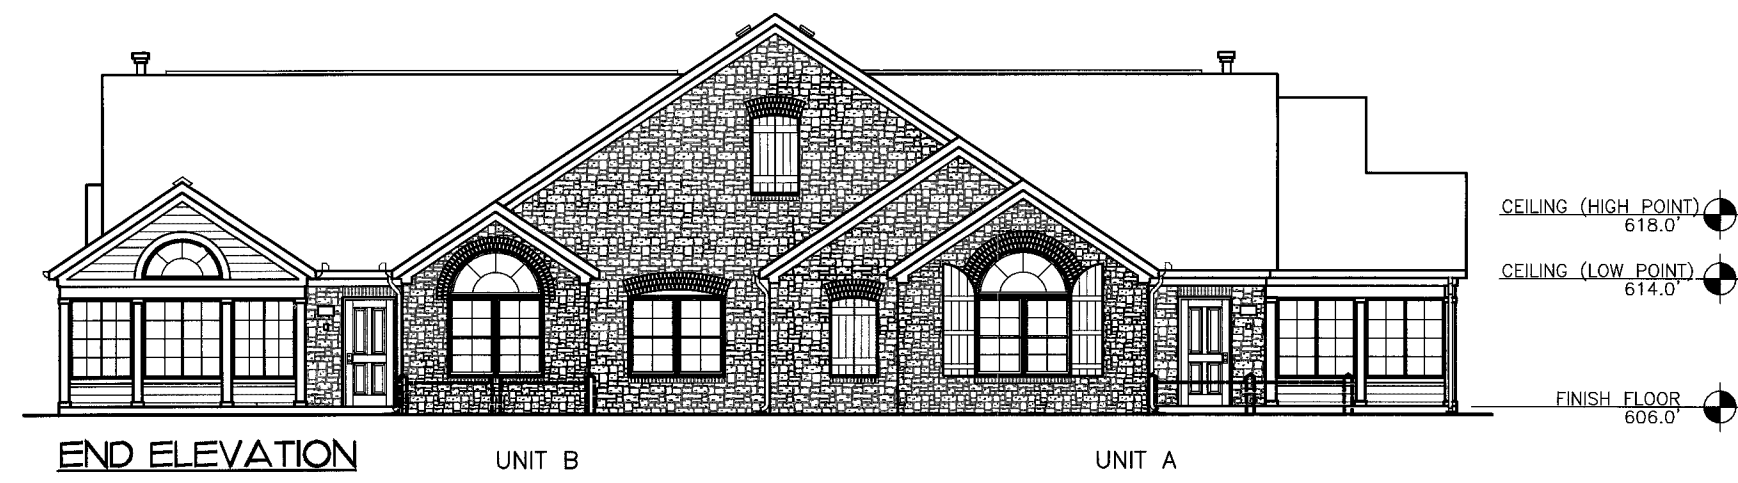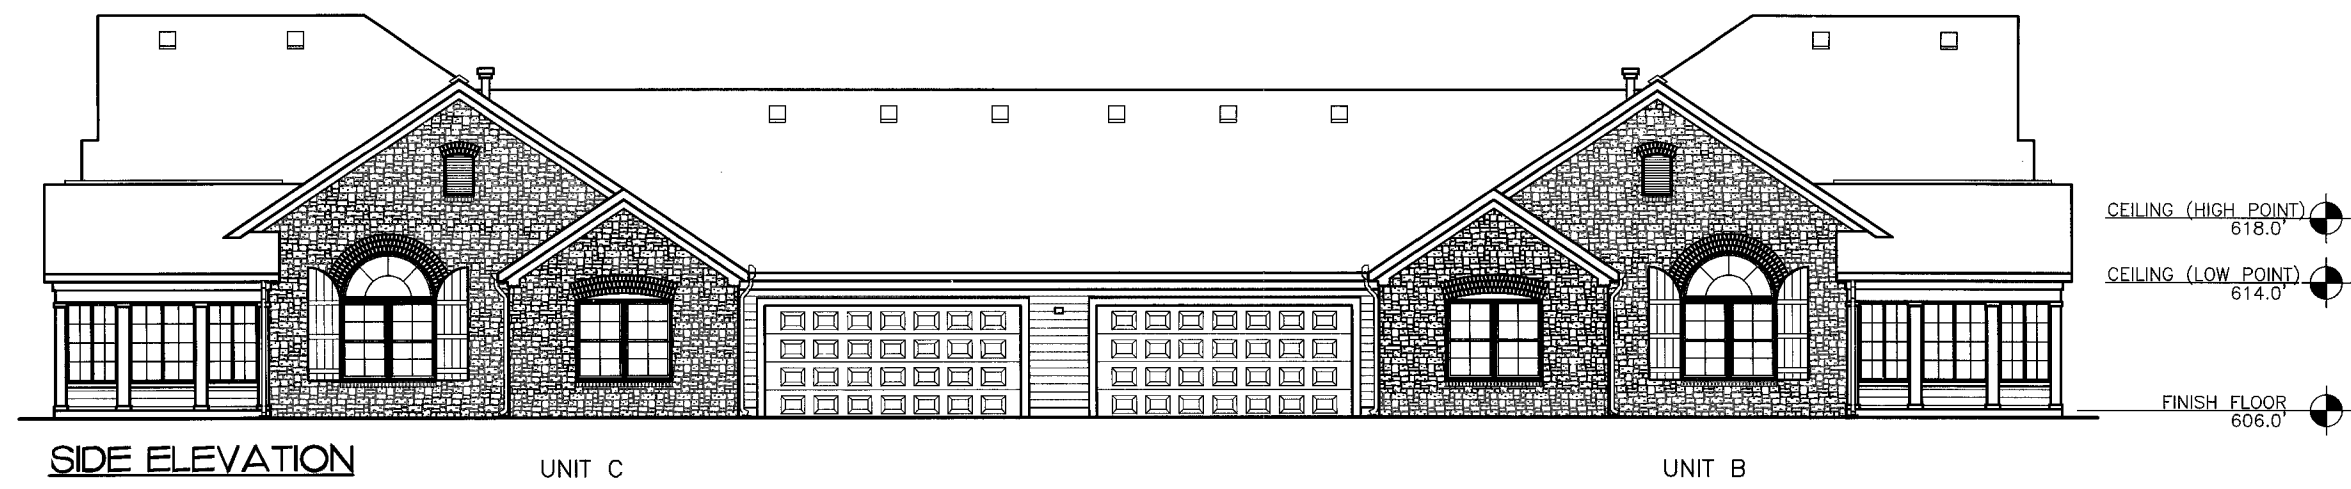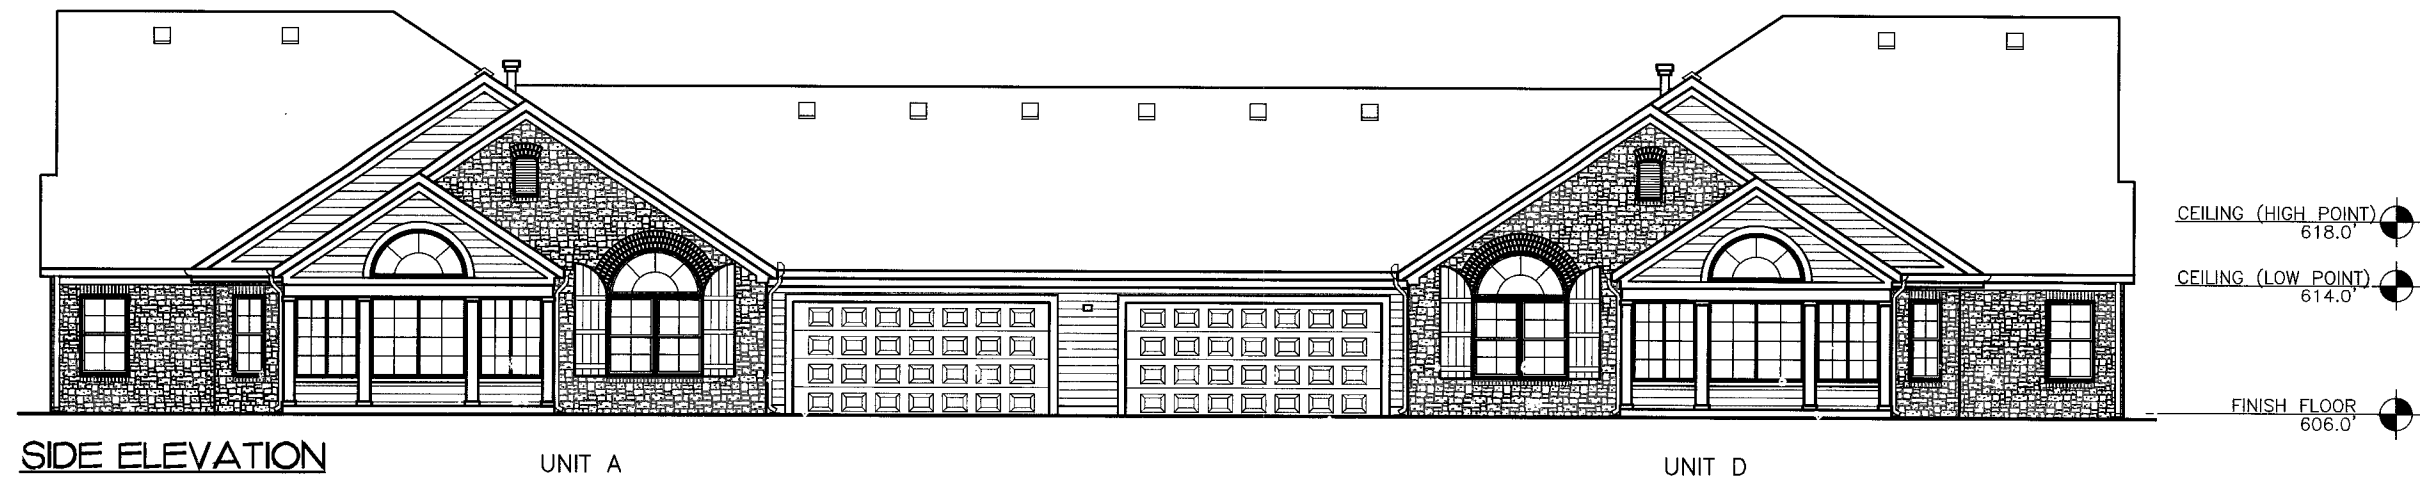


BUILDING NO. 3-4711 ABBEY ROAD


SCALE: 1/8" = 1'-0"

EXHIBIT "C"
Page 7 of 11



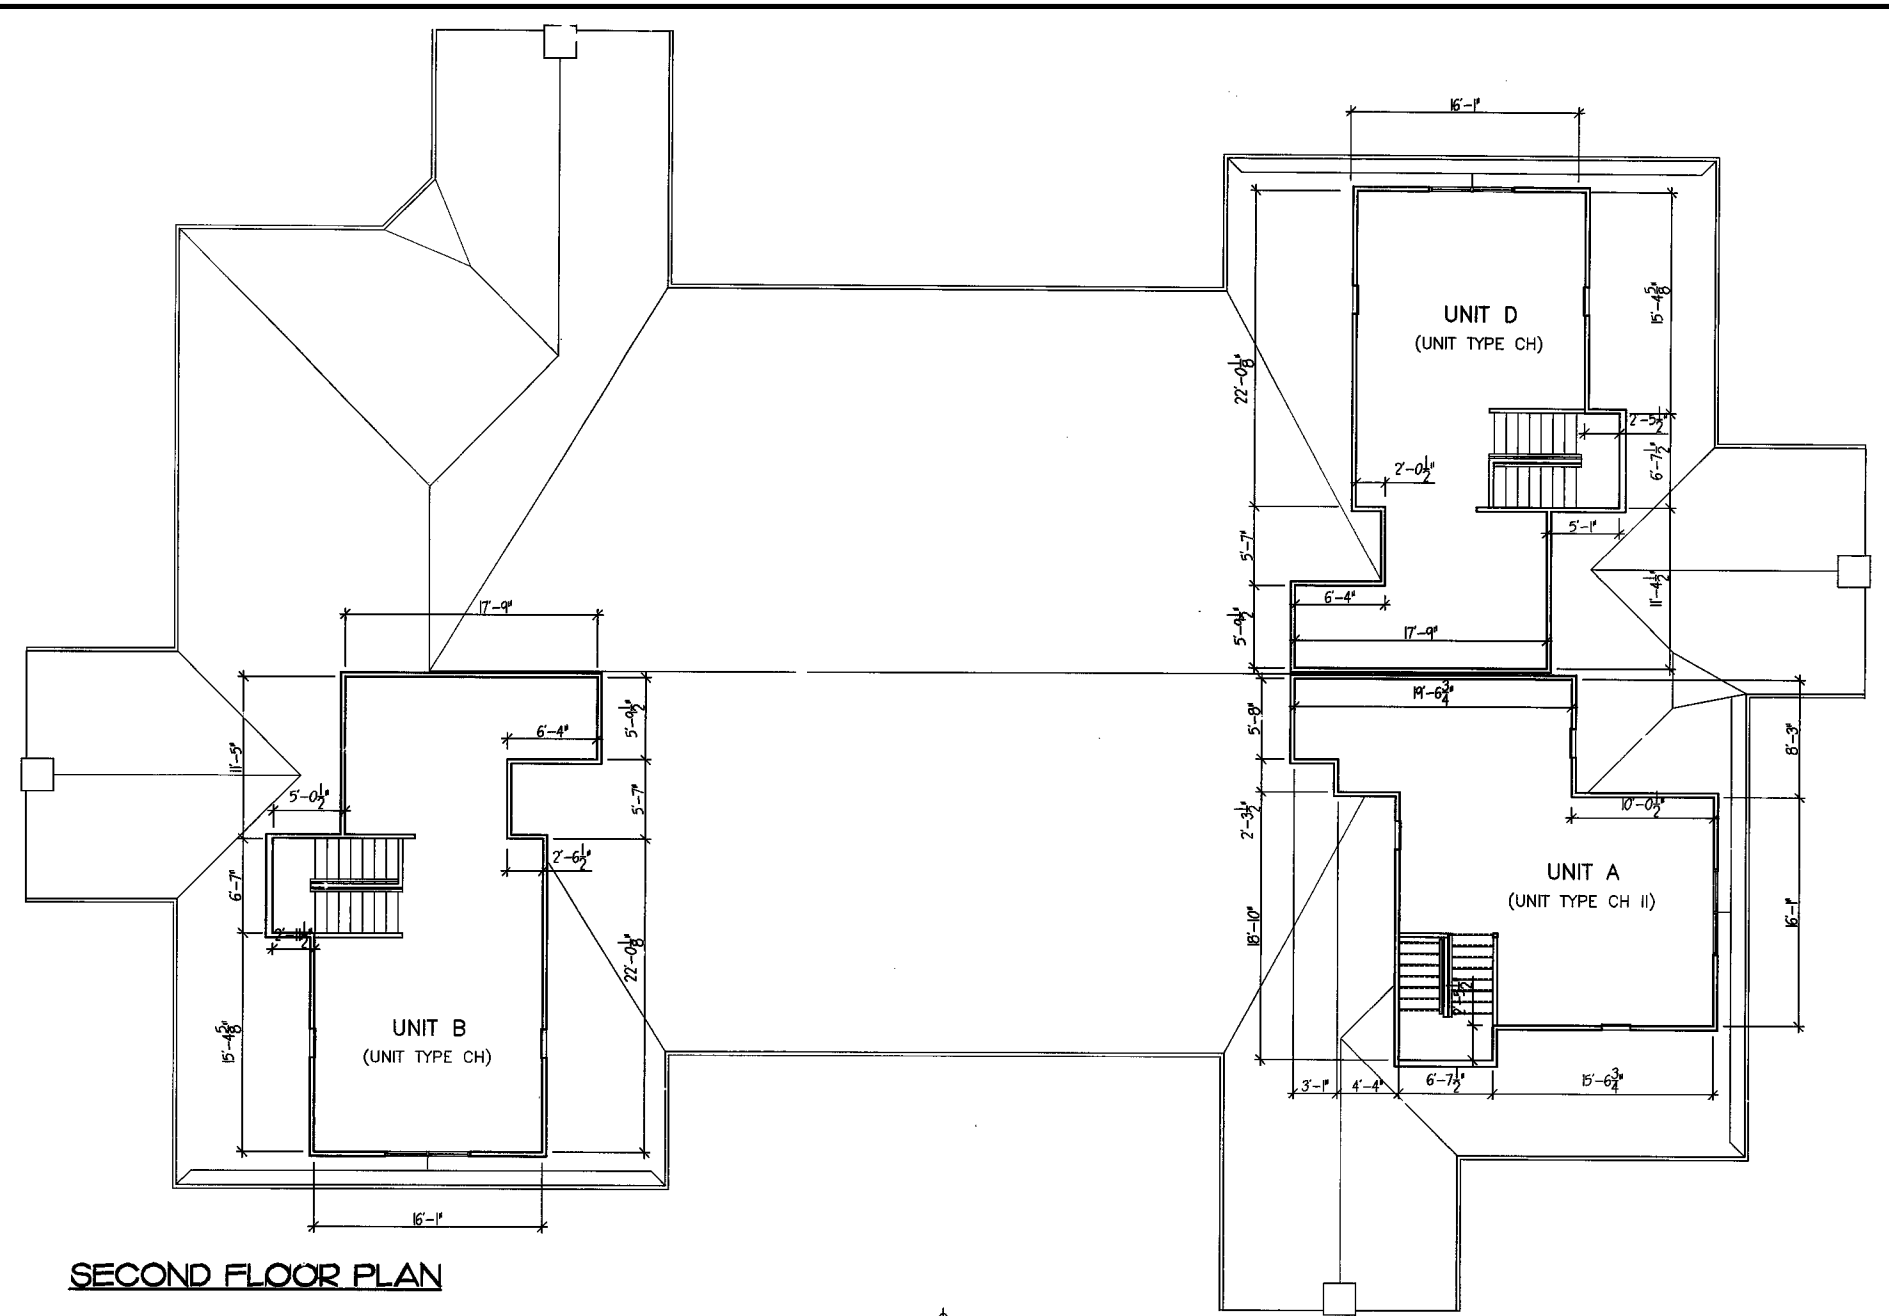

SECOND FLOOR PLAN

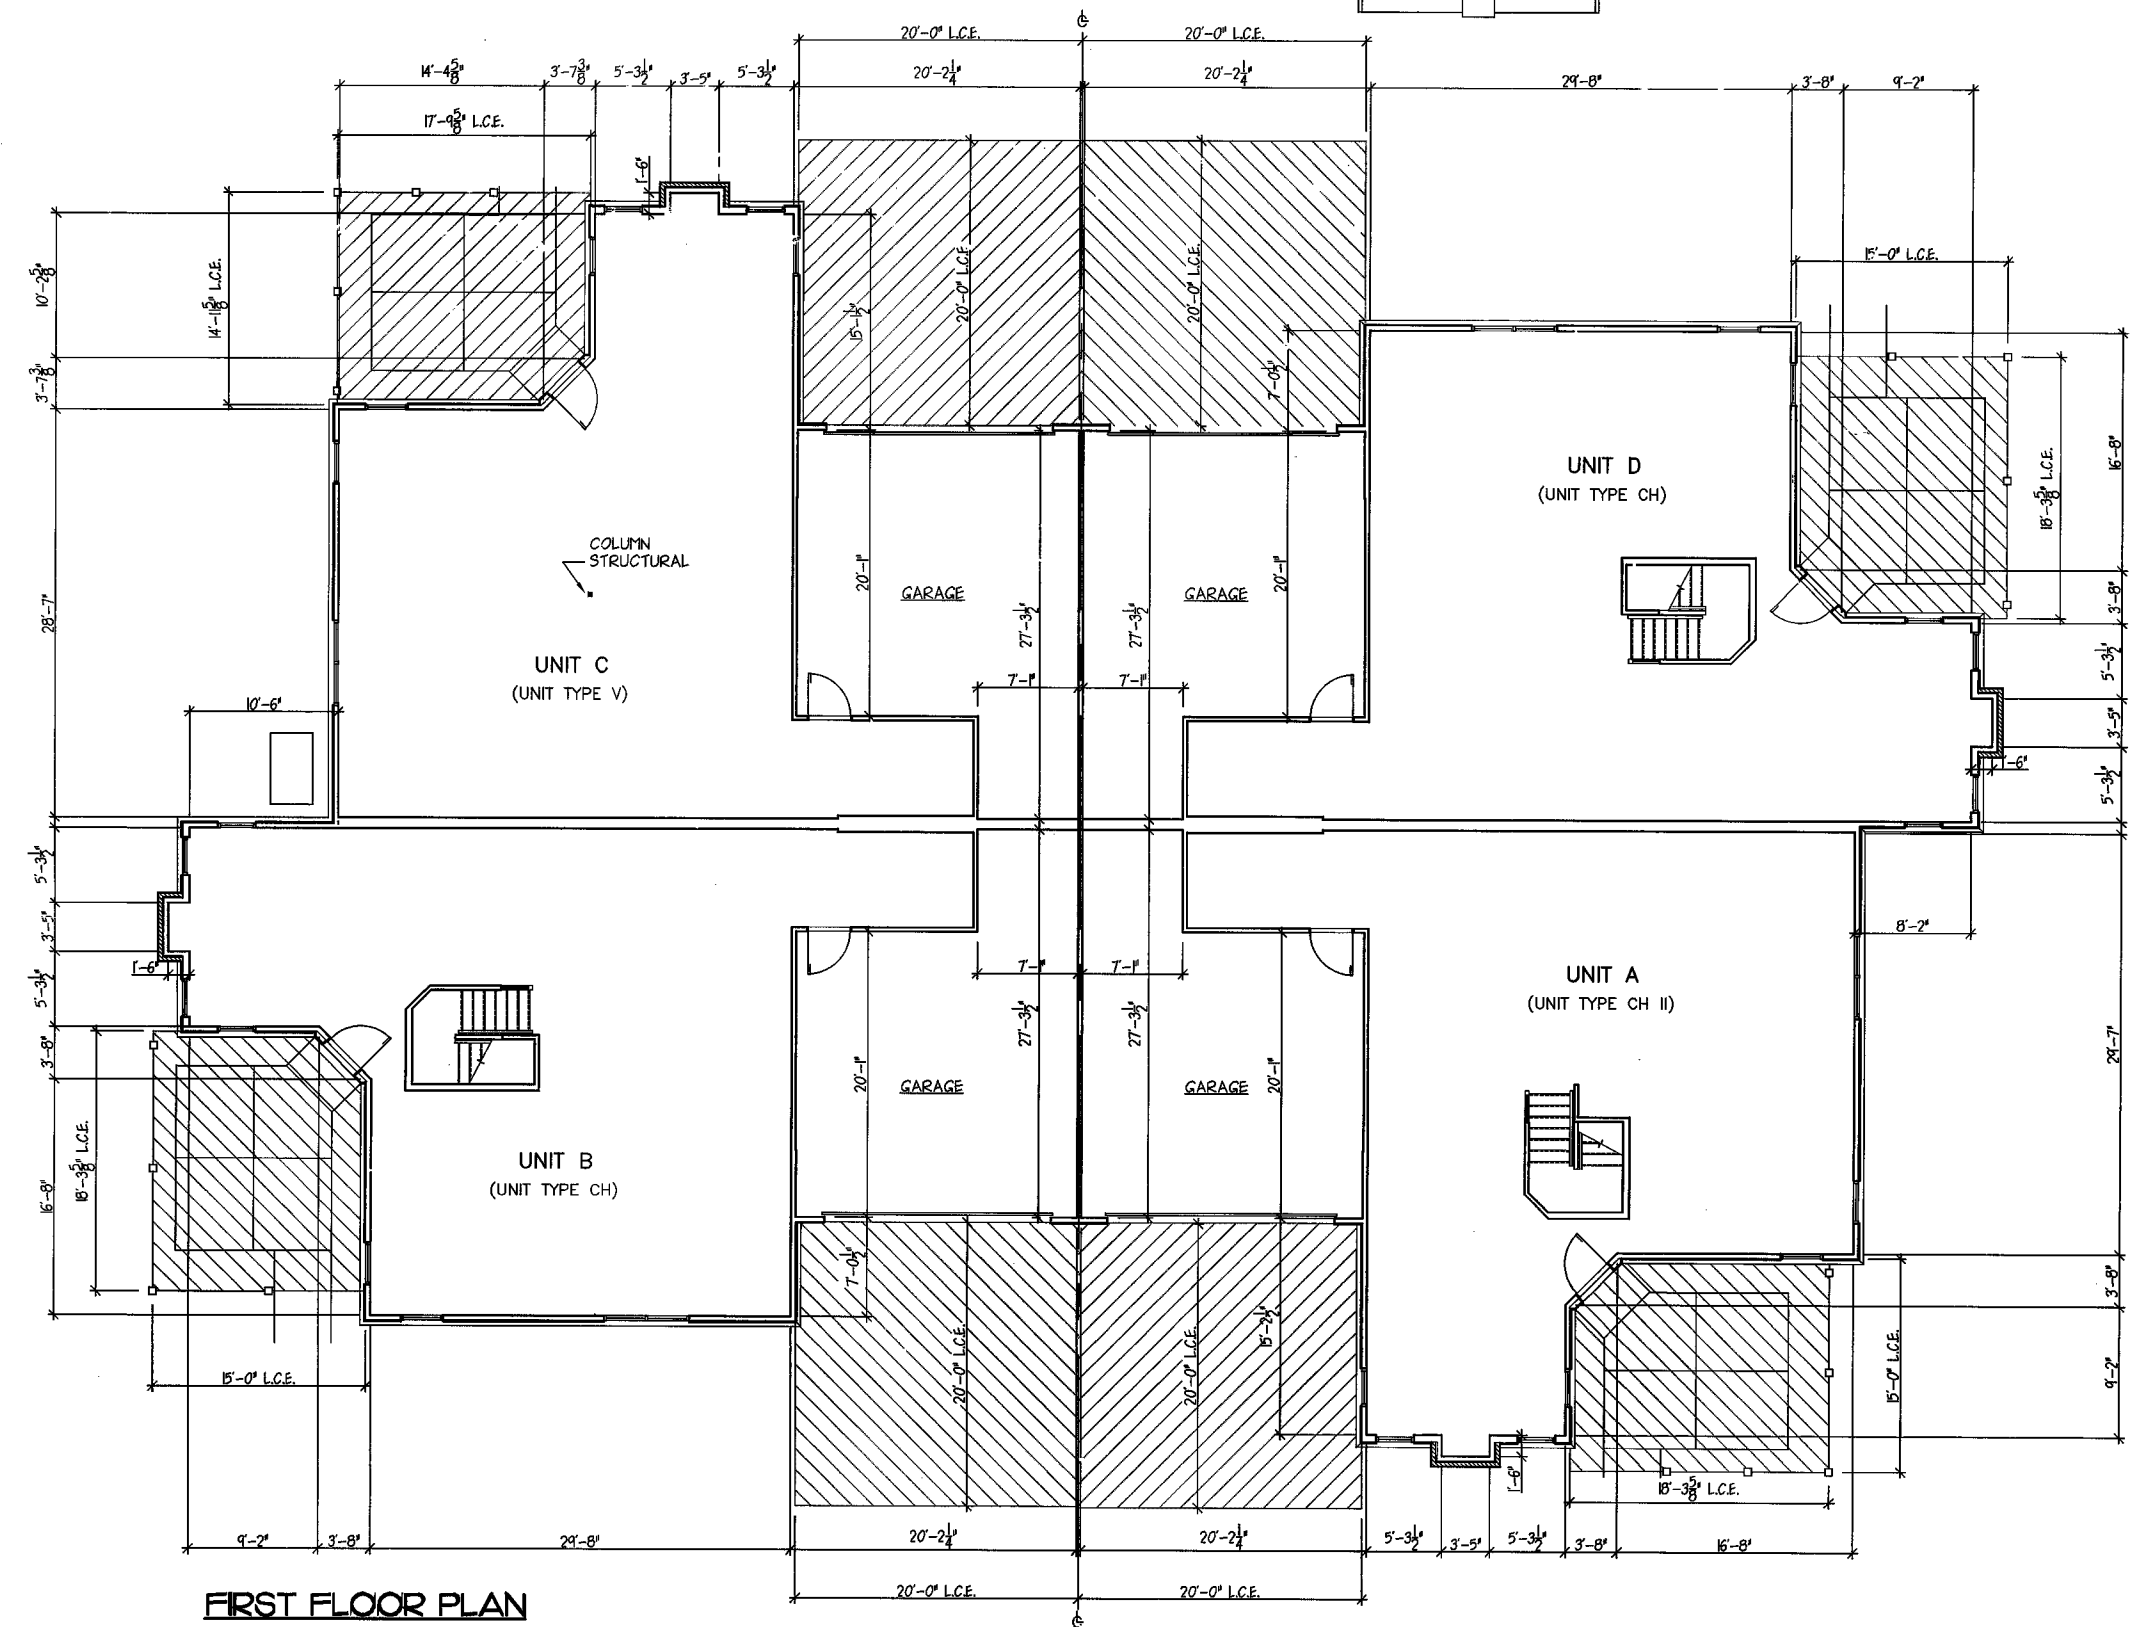

FIRST FLOOR PLAN


NOTE:
 AREAS DESIGNATED THIS INDICATES LIMITED COMMON ELEMENT PERTAINING TO ADJACENT UNIT
 L.C.E. = LIMITED COMMON ELEMENT

SCALE:
 0' 1" 2' 3' 4' 6'

EXHIBIT "C"
 Page 8 of 11

BUILDING NO. 5-2890 CANTERBURY CIRCLE




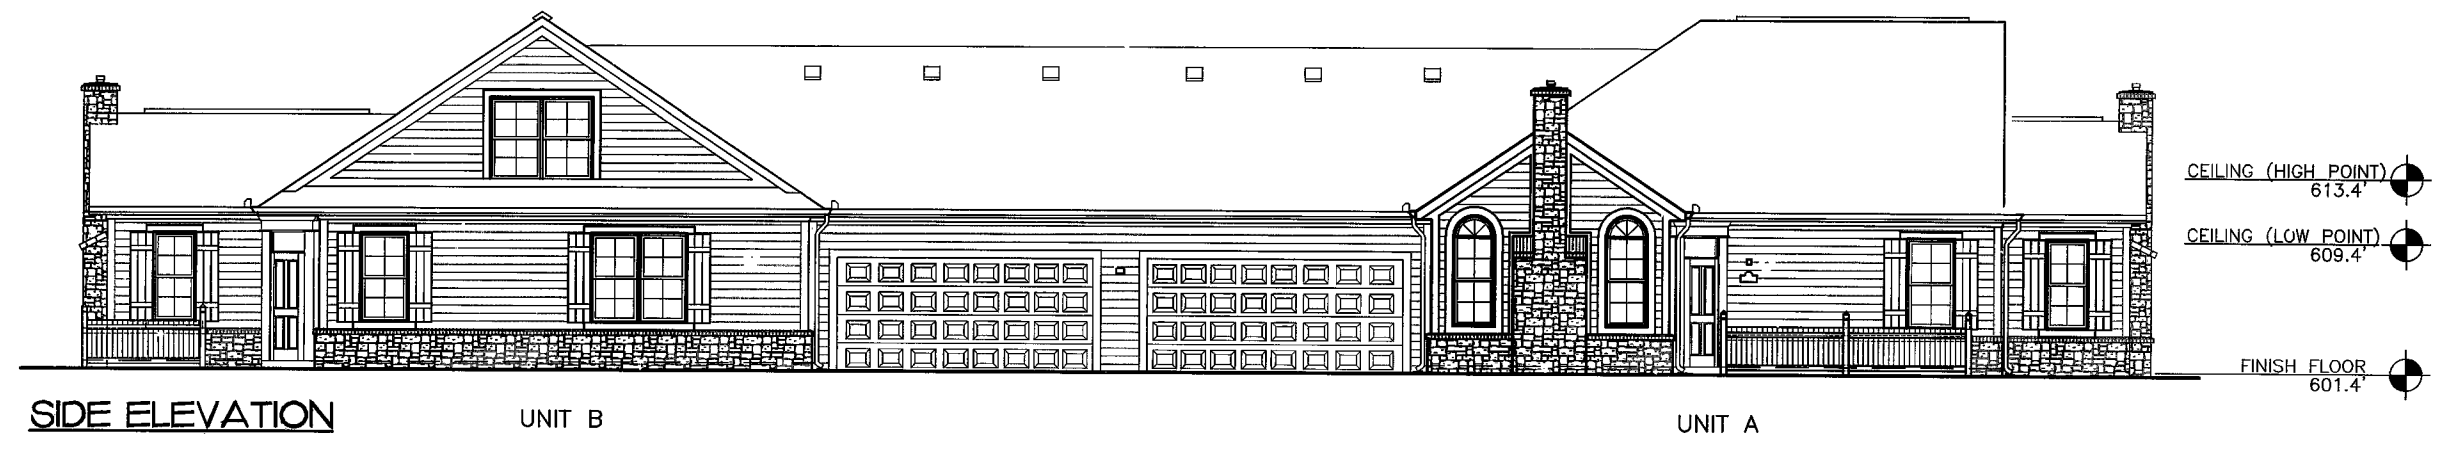

SIDE ELEVATION

UNIT B


UNIT A

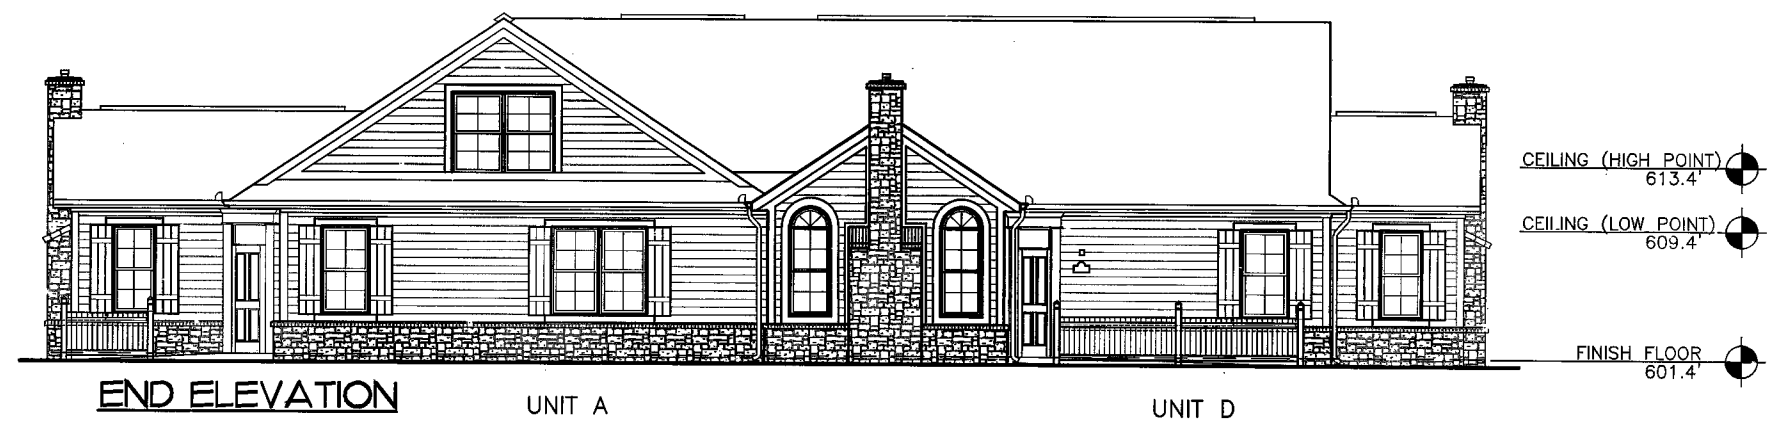

END ELEVATION

UNIT A


UNIT D

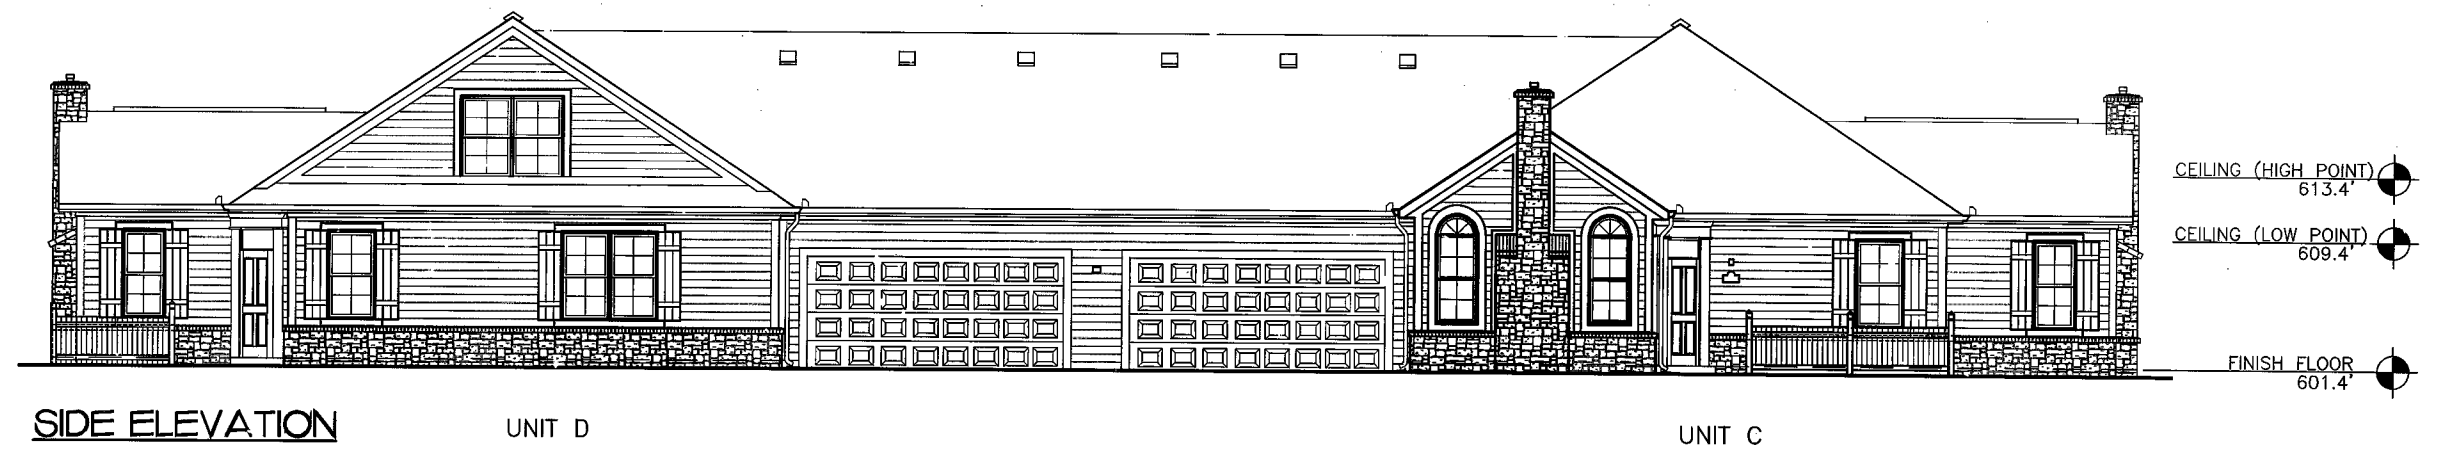

SIDE ELEVATION

UNIT D

UNIT C

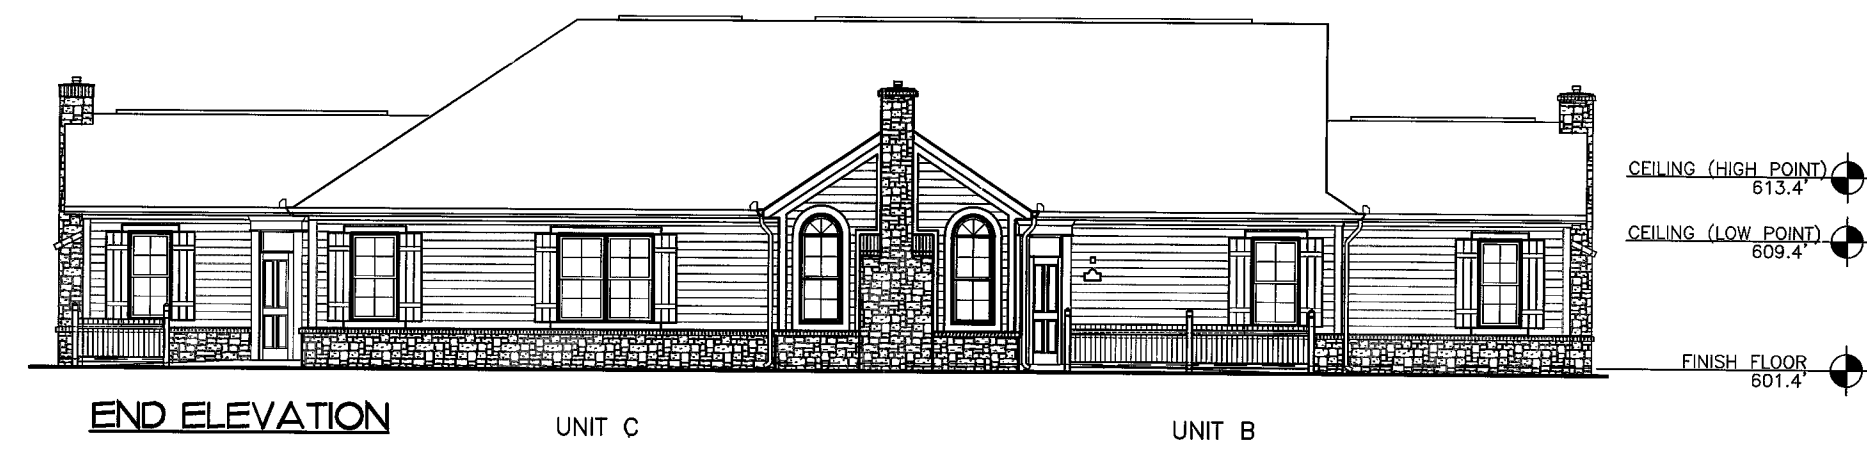

END ELEVATION

UNIT C

UNIT B

EXHIBIT "C"
Page 9 of 11

BUILDING NO. 5-2890 CANTERBURY CIRCLE




THE DRAWINGS
FAIRWAY VILLAS AT
CATAWBA ISLAND CLUB

ARCHITECTURAL ALLIANCE
185 NORTH FIFTH STREET
COLUMBIA, SC 29201
TEL: 803.744.4600
FAX: 803.744.4600
E-MAIL: ma@alliance.com




Project Number
A4157cp

Sheet Number
9 of 11

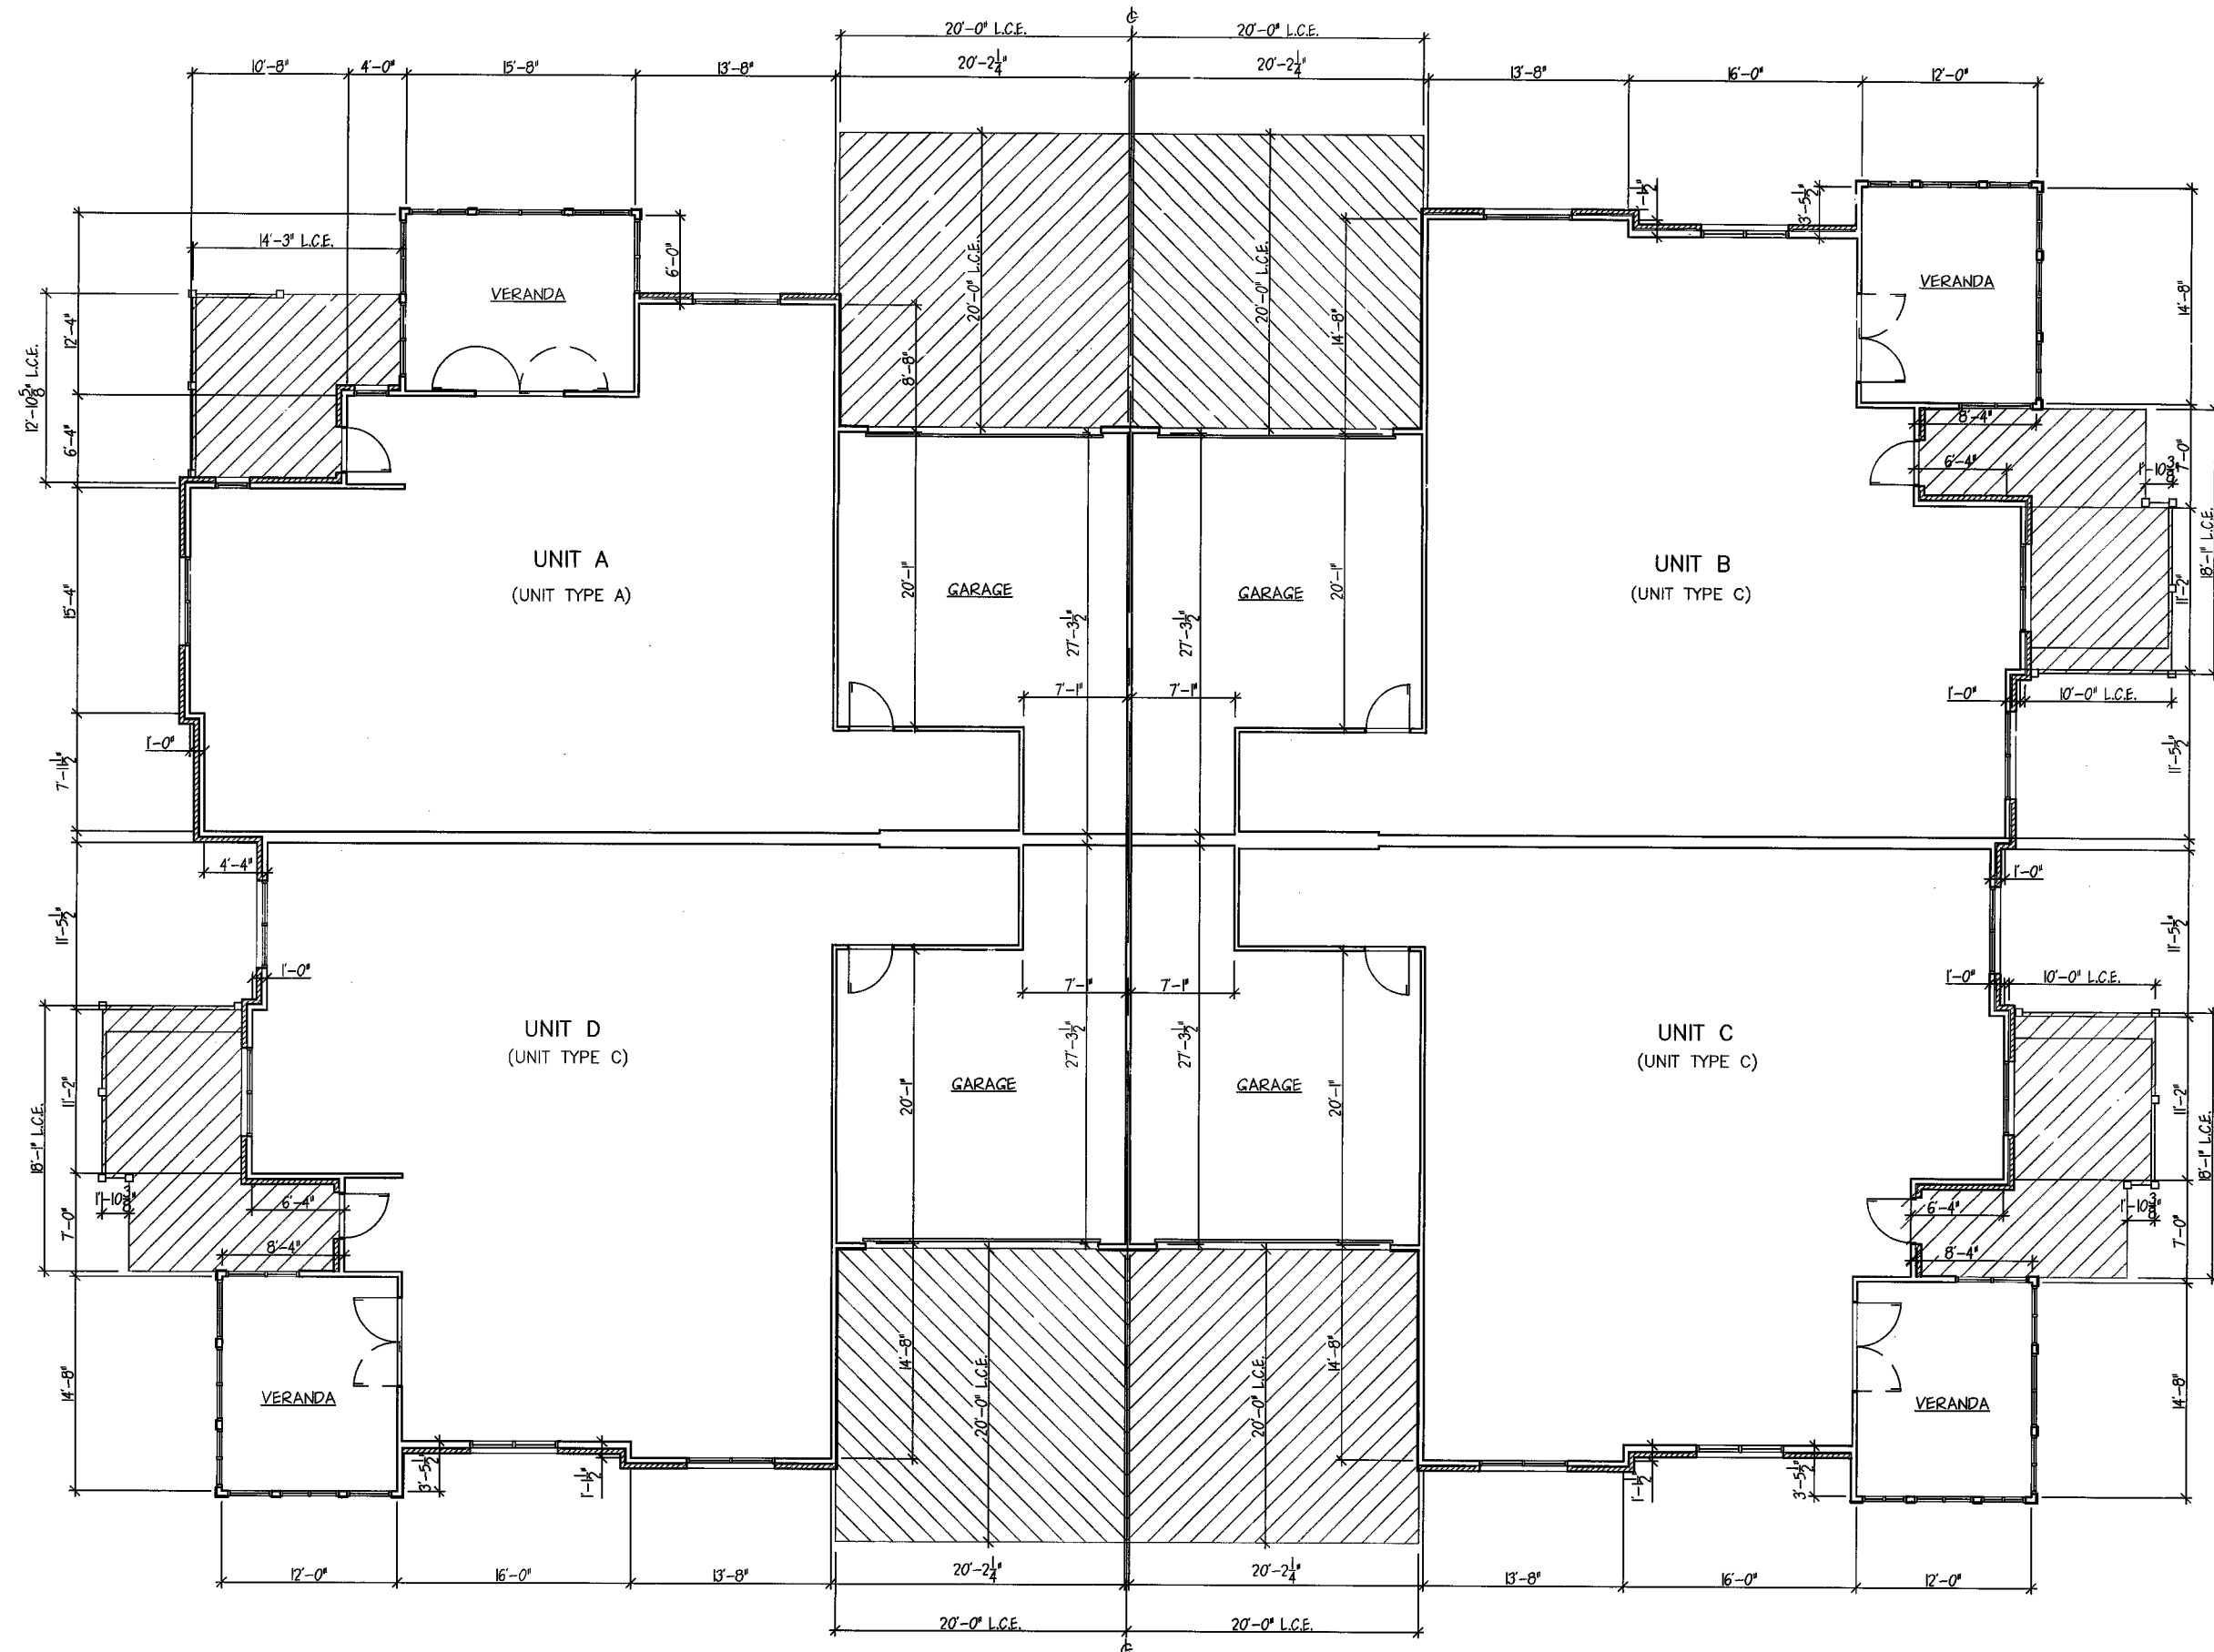

FLOOR PLAN





BUILDING NO. 30 - 2685 CANTERBURY CIRCLE

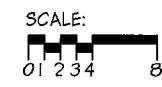

NOTE:
 AREAS DESIGNATED THUS: INDICATES LIMITED COMMON ELEMENT PERTAINING TO ADJACENT UNIT
 L.C.E. = LIMITED COMMON ELEMENT

EXHIBIT "C"
Page 10 of 11



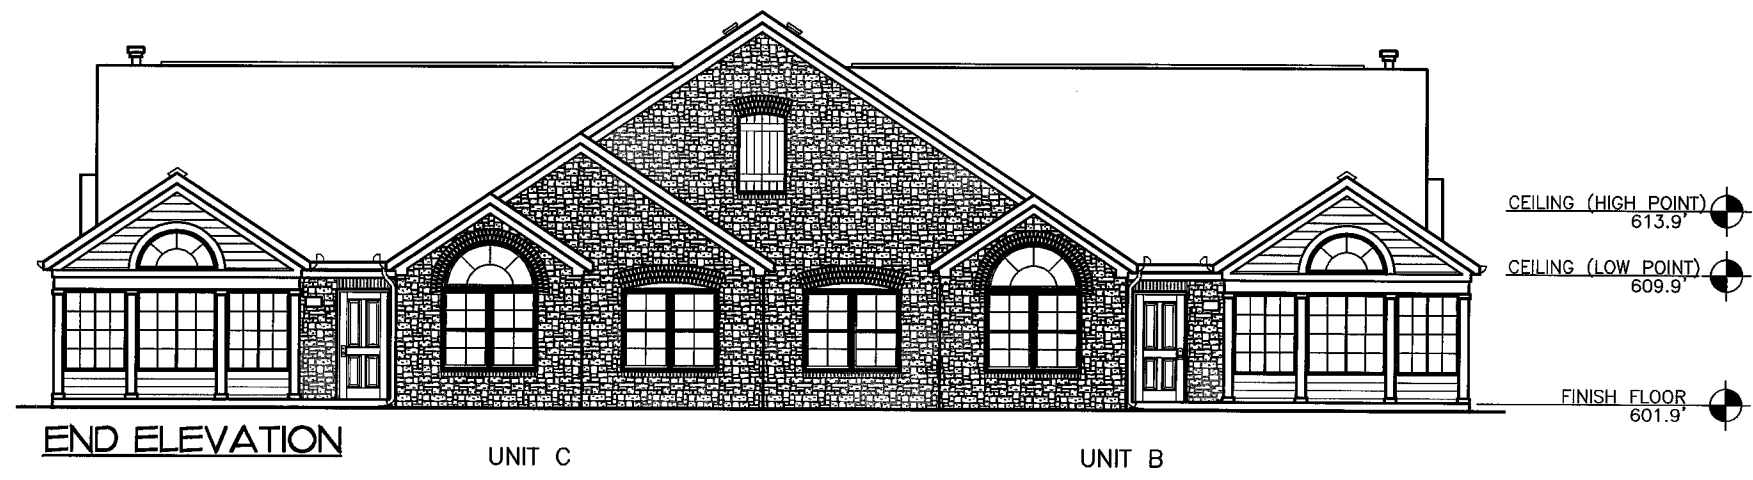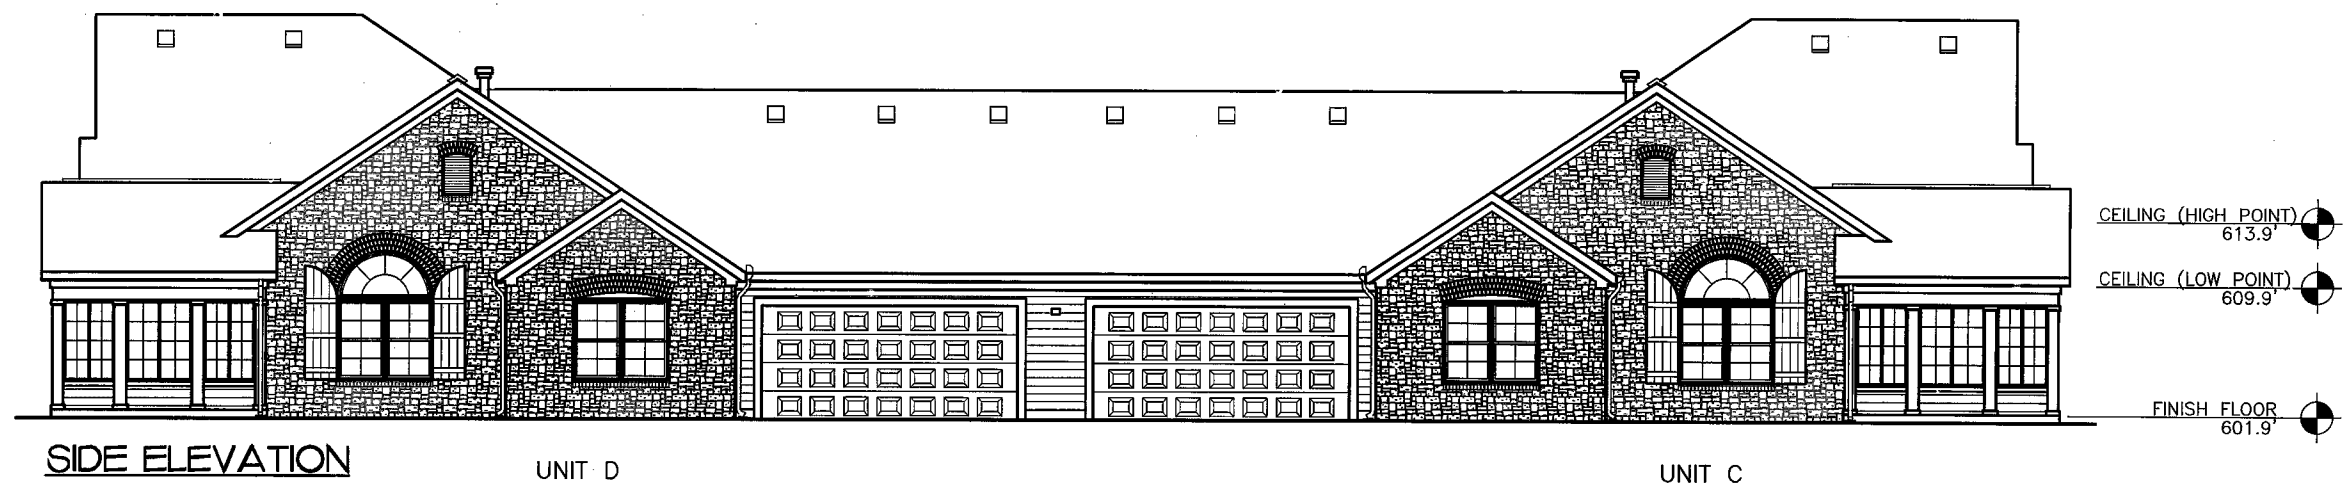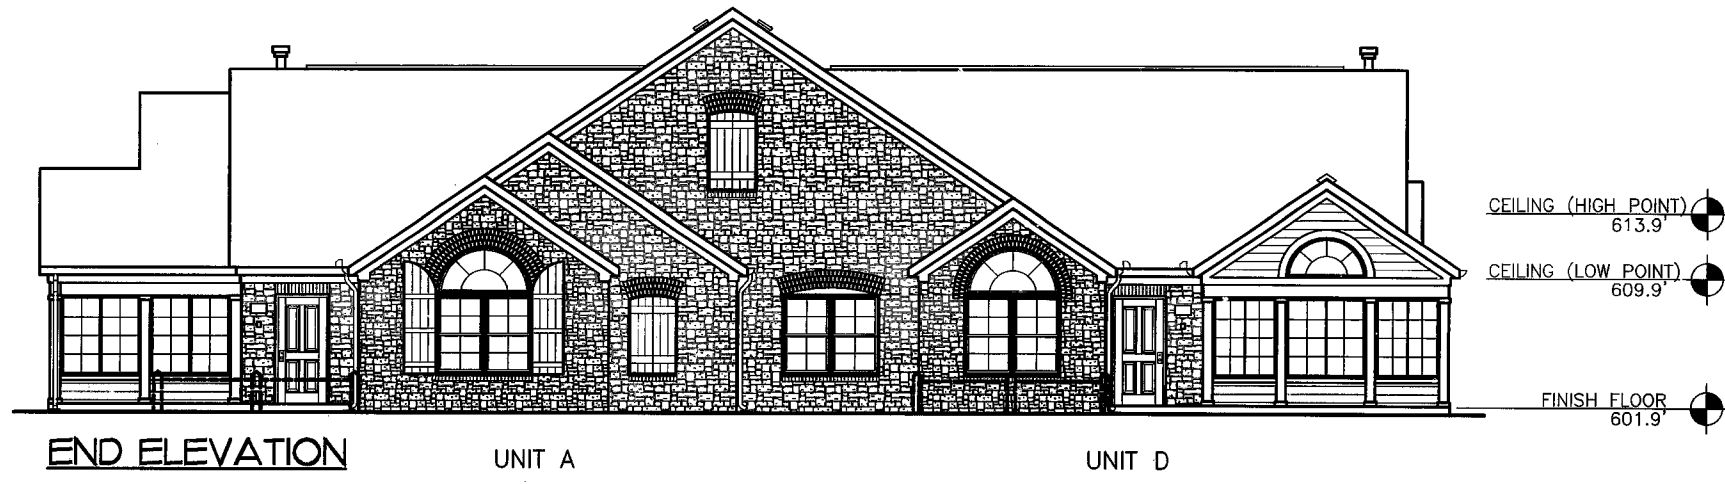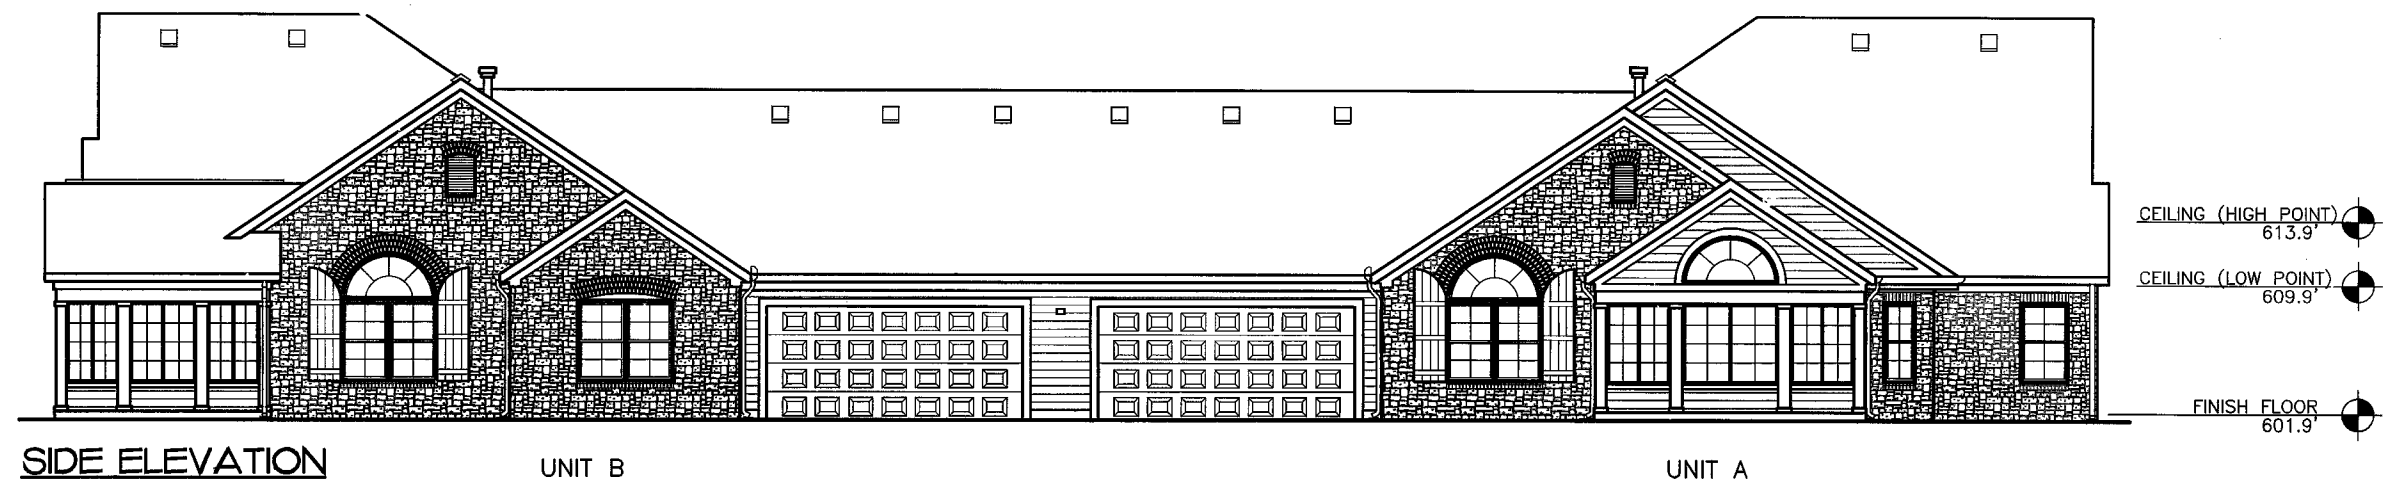

BUILDING NO. 30-2685 CANTERBURY CIRCLE

SCALE: 0' 2 3/4" = 1'

EXHIBIT "C"
Page 11 of 11

THE DRAWINGS
FAIRWAY VILLAS AT
CATAWBA ISLAND CLUB

ARCHITECTURAL ALLIANCE
188 NORTH FIFTH STREET
COLUMBUS, OHIO 43228
614.881.7700 FAX: 614.881.7700
E-MAIL: aa@archall.com



Project Number
A4157cp

Sheet Number
11 of 11