



UNIT 23 FRONT




UNIT 23 REAR

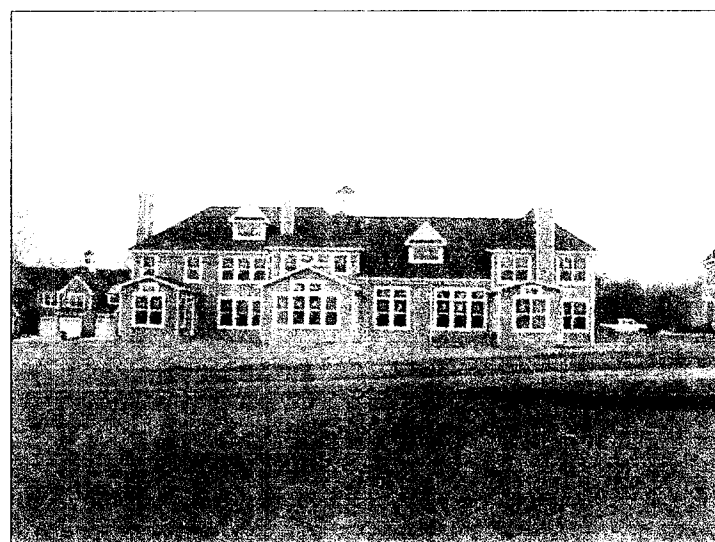

UNIT 22 FRONT

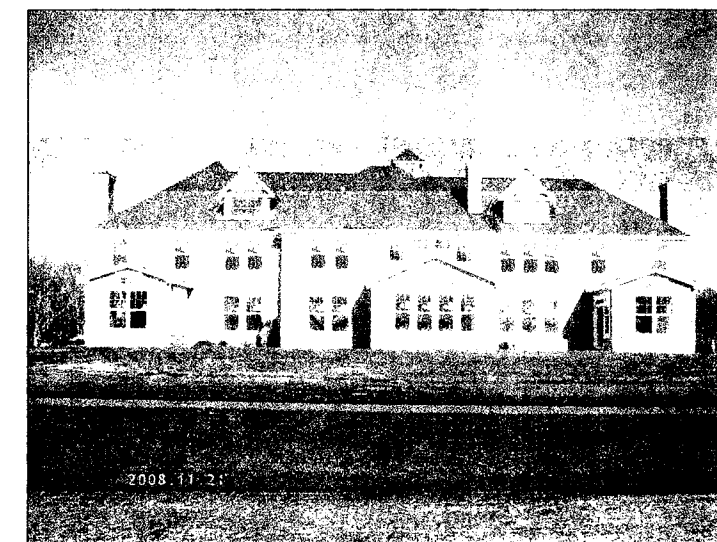

UNIT 22 REAR

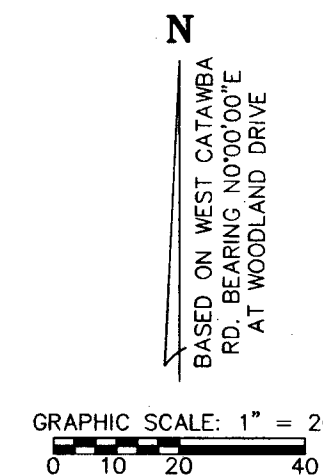

UNIT HEIGHTS:
 (DISTANCES FROM FLOOR TO CEILING)
 GARAGE AREA: 9.5'
 GROUND FLOOR:
 LIVING SPACES BELOW SECOND FLOOR: 9.0'
 LIVING SPACES OPEN TO ABOVE: 18.0'
 BEDROOM SPACES: 12.0'
 BATHROOM AND STORAGE SPACES: 8.0'
 SECOND FLOOR: 8.0'

SHEET INDEX	SHEET
SITE/SURVEY	1
SITE/BUILDINGS-LOCATIONS	1
BUILDING ELEVATIONS	2

REVISIONS		

HARBOR'S EDGE AT CATAWBA ISLAND CLUB CONDO #4 PH. 2
 OF PART OF CATAWABA ISLAND TWP., SECTION 3, ORIGINAL LOT 5, OF THE WESTERN RESERVE, OTTAWA COUNTY, OHIO

THE HENRY G. REITZ ENGINEERING COMPANY
 4214 ROCKY RIVER DRIVE
 CLEVELAND, OHIO 44135
 PHONE: (216) 251-3033

2
2
 JANUARY 2009