





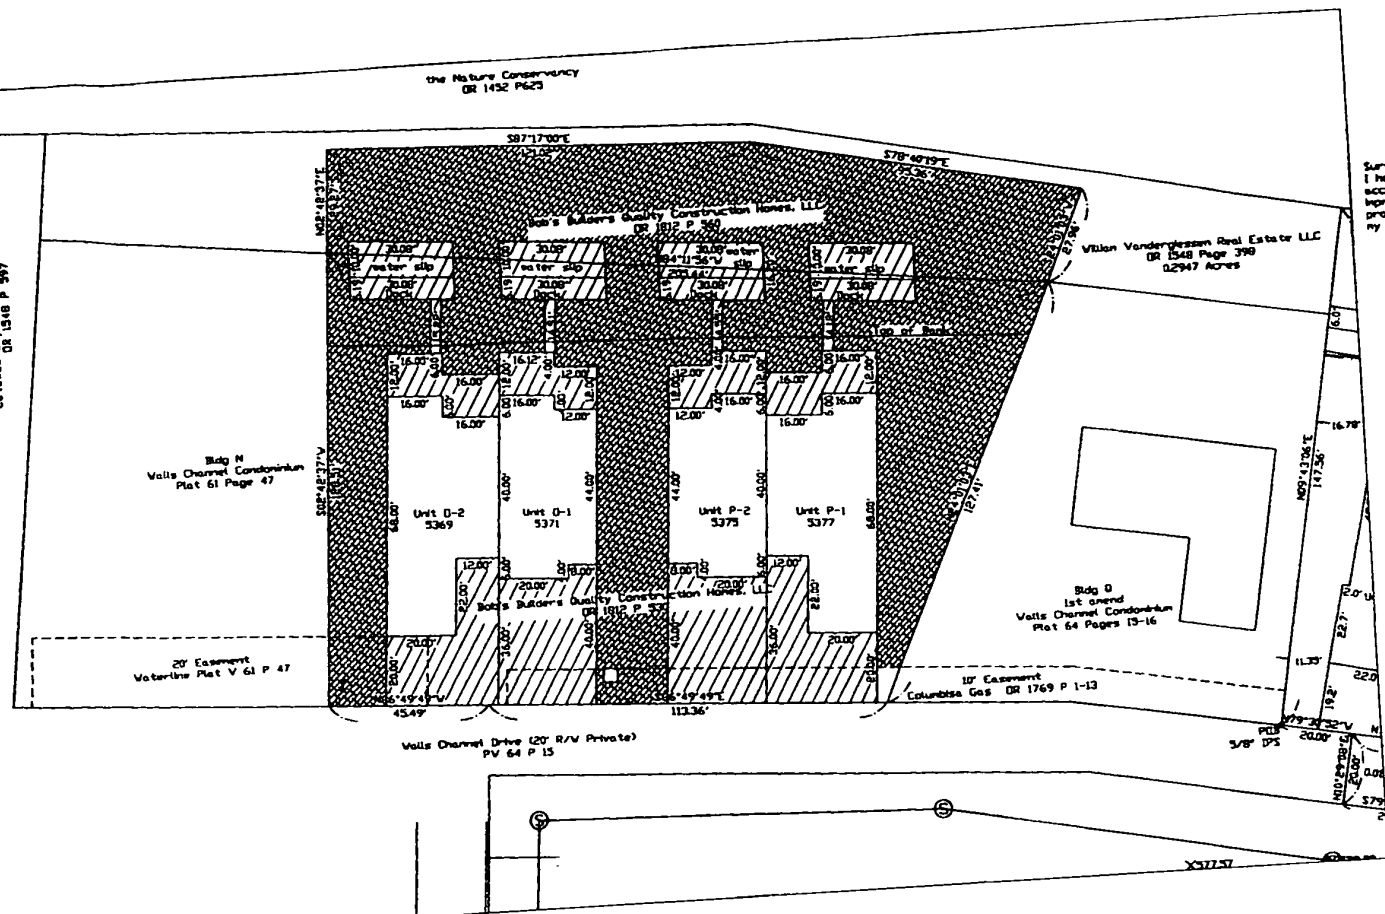
# Walls Channel Condominium Fifth Amendment

Graphic Scale: 1"=20'

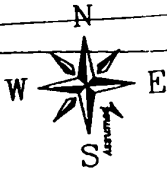

- Legend
-  Common Element
  -  Limited Common Element
  -  Unit

Estimate Bayadden Lake Murres  
DR 1518 P 587



Surveyor's Certificate  
I hereby declare  
accuracy reflects  
improvements and  
provided by Mr. T  
my knowledge and

  
Carl M. F.