


# OTTAWA COUNTY BENCHMARK DATA SHEET

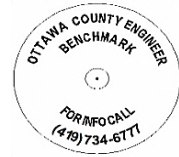

## CLA 53-0.0

Township	Section	Town	Range	Type of Monument
CLAY	5	T6N	R13E	3 1/4" Domed Bronze Disk in Concrete (OCE Spec. BM-1)
<b>Set By</b>	<b>Shot By</b>	<b>Calculated</b>	<b>Calculated By</b>	<b>Published</b>
OCE / OCHD	J. Allen	March 8, 2012	M. J. Wittman, P.S.	March 16, 2012

### Location


Northwest corner of the intersection of Reiman Rd., T.R. #53 & Camper Rd., T.R. #4

### Vertical Control

Vertical Datum	Method	Elevation (U.S. Survey Feet)
NAVD 88	GPS	634.40

### Horizontal Control

Horizontal Datum	Zone	Northing	Easting
NAD 83 CORS 96	OHIO NORTH 3401	669,404.705	1,728,023.858
<b>Method</b>	<b>Latitude</b>	<b>Longitude</b>	
GPS / CORPSCON	41° 30' 02.54510" N	83° 22' 40.45700" W	
<b>Geoid</b>	<b>Scale Factor</b>	<b>Convergence</b>	
GEOID 09	0.999967651	- 00° 34' 36.26322"	

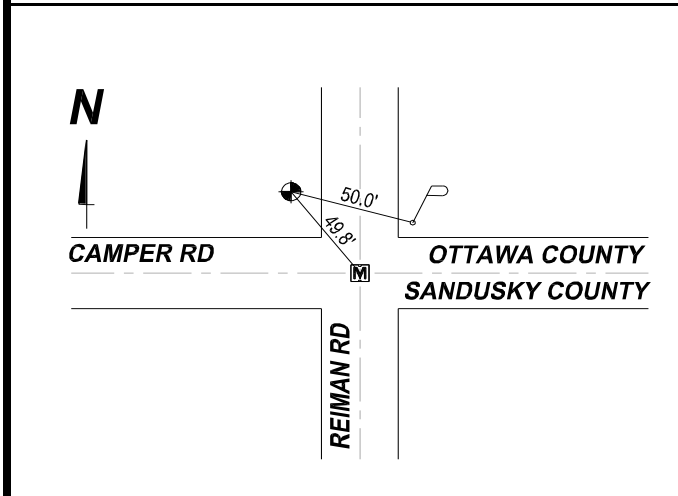

**NOTES:**

1. Monument set: August 16, 2011
2. Data Collected: 1-31-12, 2-7-12, 2-16-12