


OTTAWA COUNTY BENCHMARK DATA SHEET

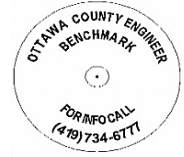

CLA 7-3.0

Township	Section	Town	Range	Type of Monument
CLAY	26	T7N	R13E	3 1/4" Domed Bronze Disk in Concrete (OCE Spec. BM-1)
Set By	Shot By	Calculated	Calculated By	Published
OCE / OCHD	J. Allen	March 8, 2012	M. J. Wittman, P.S.	March 16, 2012

Location


Northeast corner of the intersection of Martin-Williston Rd., T.R. #7 & Holts-East Rd., T.R. #40

Vertical Control

Vertical Datum	Method	Elevation (U.S. Survey Feet)
NAVD 88	GPS	610.15

Horizontal Control

Horizontal Datum	Zone	Northing	Easting
NAD 83 CORS 96	OHIO NORTH 3401	680,100.686	1,738,776.132
Method	Latitude	Longitude	
GPS / CORPSCON	41° 31' 49.26234" N	83° 20' 20.50649	
Geoid	Scale Factor	Convergence	
GEOID 09	0.999971694	- 00° 33' 04.32268"	

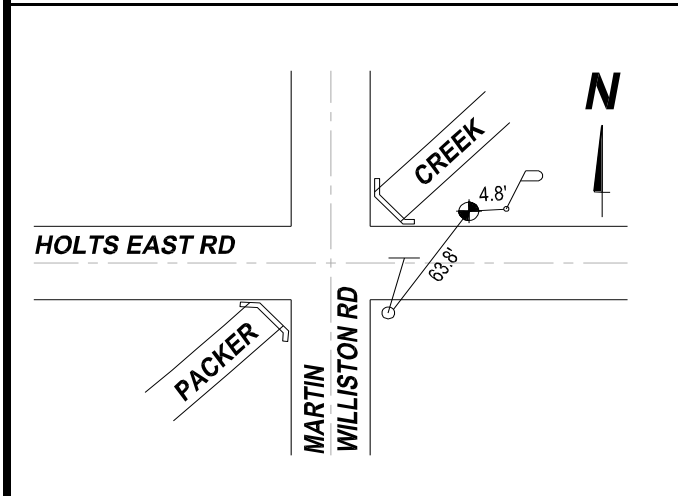

NOTES:

1. Monument set: August 16, 2011
2. Data Collected: 1-31-12, 2-9-12, 2-17-12