

OTTAWA COUNTY ENGINEERS OFFICE

REFERENCE NO. 1-6-13-C
NE CORNER POST SECTION 1
CLAY TWP.
SHEET 1 OF 1.

ROUTE: C-213 NISSEN RD.
@ S-163 STATE ROUTE 163

TOWNSHIP: CLAY

SECTION: 1

T 6 NR 13 E.

PERSONNEL:
M. WITTMAN, P.S.
J.D. BARNES


NORTHING:

EASTING:

DATUM:

DATE / WEATHER / TEMP:

APRIL 22, 2007
SUNNY S
80° F

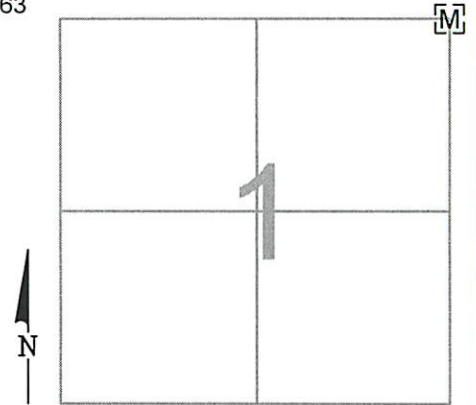

MONUMENT INFORMATION

MONUMENT TYPE: FD 1-1/4" IRON PIN IN MON BOX
ON SURFACE - BELOW:
LEFT - CL PAV'T - RIGHT:

MISC. INFORMATION

8-26-71: FD 8-1/2" x 8-1/2" x 14-1/2" STONE 16"
BELOW SURFACE - SET IRON PIN IN MONUMENT
BOX PER OTTAWA COUNTY STONE RECORDS

PHOTO OF STONE NOT AVAILABLE

