

OTTAWA COUNTY ENGINEERS OFFICE

REFERENCE NO. 1-6-13-E
CENTER POST SECTION 1
CLAY TWP.
SHEET 1 OF 1.

ROUTE: T-56 FULKERT RD.

TOWNSHIP: CLAY

SECTION: 1

T 6 N R 13 E.

PERSONNEL:
M. WITTMAN, P.S.
J.D. BARNES


NORTHING:

EASTING:

DATUM:

DATE / WEATHER / TEMP:

APRIL 24, 2007
SUNNY NE
62° F

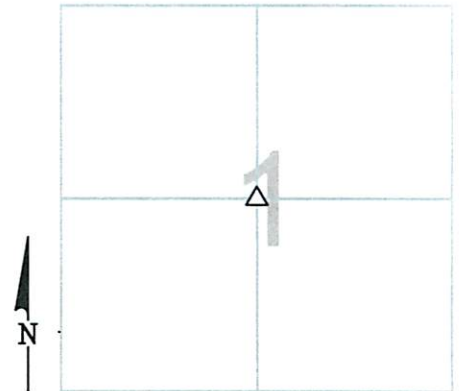

MONUMENT INFORMATION

MONUMENT TYPE: FD STONE
ON SURFACE - BELOW: 0.54'
LEFT - CL PAV'T - RIGHT:

TRIANGULAR STONE 6" x 4" W/ SLANT PIN OVER
AND ACCESSORY STONES SURROUNDING



MISC. INFORMATION

REMOVED SLANT PIN AND ACCESSORY STONES

STONE TOO SHALLOW FOR PIN

SET DRILL HOLE IN STONE

APRIL 24, 2007

SET MONUMENT BOX OVER
STONE

