

# OTTAWA COUNTY ENGINEERS OFFICE

REFERENCE NO. 1-6-13-F  
E QUARTER POST SECTION 1  
HARRIS TWP.  
SHEET 1 OF 1.

ROUTE: C-213 NISSEN RD.  
TOWNSHIP: CLAY  
SECTION: 1  
T 6 NR 13 E.


PERSONNEL:  
M. WITTMAN, P.S.  
J.D. BARNES

NORTHING:

EASTING:

DATE / WEATHER / TEMP:  
APRIL 23, 2007  
SUNNY  
57° F


DATUM:

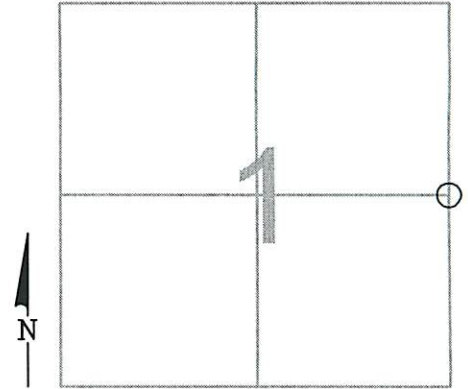

## MONUMENT INFORMATION

MONUMENT TYPE: FD 1-1/4" Ø IRON PIN  
ON SURFACE - BELOW: 4"  
LEFT - CL PAV'T - RIGHT: 7'

FOUND OLD STYLE (BURCH CORP) MONUMENT  
BOX FLANGE, REST OF MONUMENT BOX WAS  
GONE.

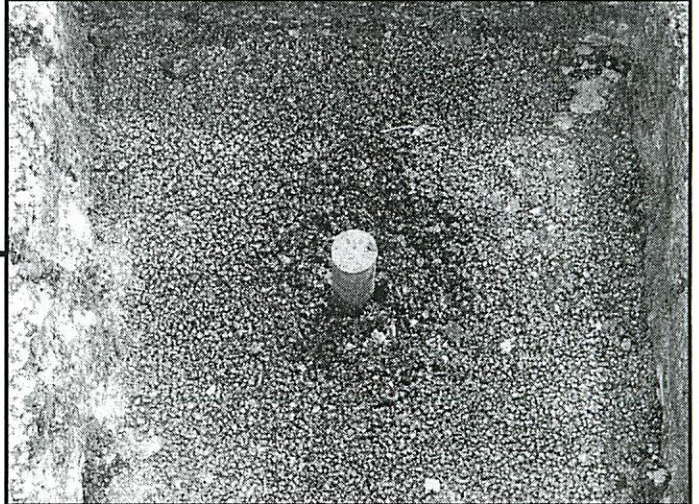

## MISC. INFORMATION

IRON PIN WAS SET IN A MONUMENT BOX  
8-26-1971 PER OTTAWA COUNTY STONE  
RECORD.

SET DRILL HOLE IN CENTER OF PIN

APRIL 23, 2007

SET MONUMENT BOX  
OVER IRON PIN

