

# OTTAWA COUNTY ENGINEERS OFFICE

REFERENCE NO. 1-6-13-G  
SW CORNER SECTION 1  
CLAY TWP.  
SHEET 1 OF 1.

ROUTE: T-214 OPFER LENTZ RD.  
@ T-4 CAMPER RD.

TOWNSHIP: CLAY

SECTION: 1

T 6 NR 13 E.


NORTHING:

EASTING:

DATUM:


PERSONNEL:  
M. WITTMAN, P.S.  
J. ALLEN

DATE / WEATHER / TEMP:  
APRIL 21, 2008  
SUNNY  
60° F

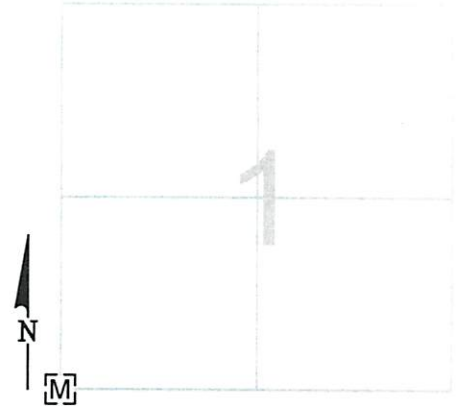

## MONUMENT INFORMATION

MONUMENT TYPE: FD. 1" SQUARE IRON PIN W/  
DRILL HOLE IN MONUMENT BOX  
ON SURFACE - BELOW:  
LEFT - CL PAV'T - RIGHT: 3.0'

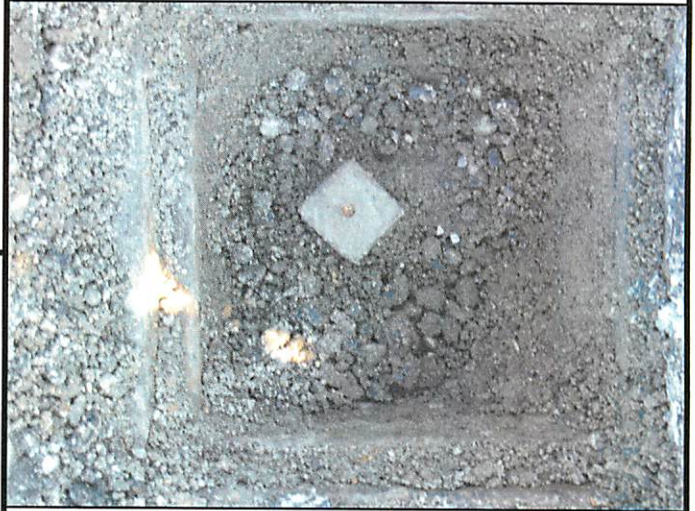

## MISC. INFORMATION

