

OTTAWA COUNTY ENGINEERS OFFICE

REFERENCE NO. 11-6-13-A
NW CORNER SECTION 11
CLAY TWP.
SHEET 1 OF 1.

ROUTE: T-7 MARTIN-WILLISTON RD.
@ T-4 CAMPER RD.



TOWNSHIP: CLAY


SECTION: 11

T 6 NR 13 E.

NORTHING:

EASTING:

DATUM:

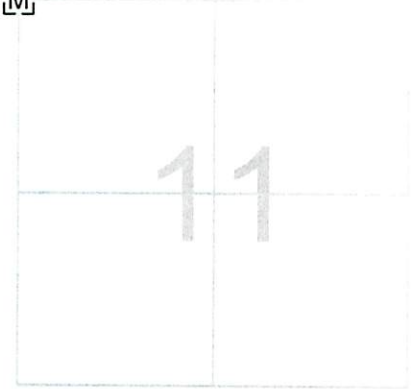

PERSONNEL:
J. ALLEN
M. ULLRICH
S. ULLRICH

DATE / WEATHER / TEMP:
AUGUST 28, 2008
CLOUDY
65° F

MONUMENT INFORMATION

MONUMENT TYPE: FD. 1 $\frac{1}{8}$ " IRON PIN W/ DRILL
HOLE IN MONUMENT BOX
ON SURFACE - BELOW: 0.26'
LEFT - CL PAV'T - RIGHT: 1.0'



MISC. INFORMATION

