

OTTAWA COUNTY ENGINEERS OFFICE

REFERENCE NO. 11-6-13-C
NE CORNER SECTION 11
CLAY TWP.
SHEET 1 OF 1.

ROUTE: T-214 OFFER LENTZ RD.
@ T-4 CAMPER RD.

TOWNSHIP: CLAY

SECTION: 11

T 6 NR 13 E.


NORTHING:

EASTING:

DATUM:

PERSONNEL:
M. WITTMAN, P.S.
J. ALLEN

DATE / WEATHER / TEMP:
APRIL 21, 2008
SUNNY
60° F

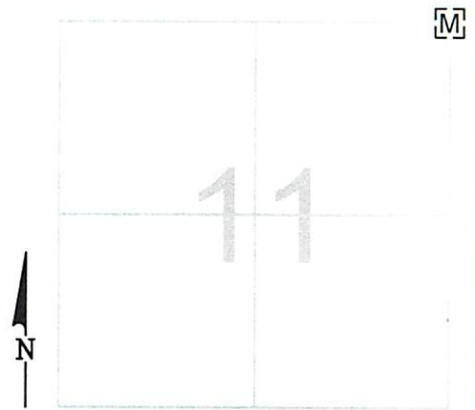

MONUMENT INFORMATION

MONUMENT TYPE: FD. 1" SQUARE IRON PIN W/
DRILL HOLE IN MONUMENT BOX
ON SURFACE - BELOW:
LEFT - CL PAV'T - RIGHT: 3.0'



MISC. INFORMATION

