

OTTAWA COUNTY ENGINEERS OFFICE

REFERENCE NO. 11-6-13-D
WEST QUARTER POST SEC. 11
CLAY TWP.
SHEET 1 OF 1.

ROUTE: T-7 MARTIN-WILLISTON RD.

TOWNSHIP: CLAY

SECTION: 11

T 6 NR 13 E.

PERSONNEL:

J. ALLEN
M. ULLRICH
S. ULLRICH

NORTHING:


EASTING:

DATUM:

DATE / WEATHER / TEMP:

AUGUST 28, 2008
CLOUDY
65° F

[M]

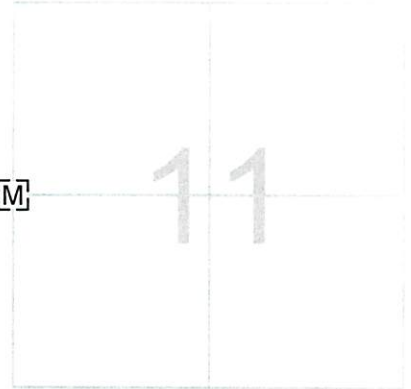

MONUMENT INFORMATION

MONUMENT TYPE: FD. 1" Ø IRON PIN IN
MONUMENT BOX
ON SURFACE - BELOW: 0.43'
LEFT - CL PAV'T - RIGHT: 1.0



MISC. INFORMATION

