

OTTAWA COUNTY ENGINEERS OFFICE

REFERENCE NO. 11-6-13-F
 EAST QUARTER POST SEC. 11
 CLAY TWP.
 SHEET 1 OF 1.

ROUTE: T-214 OPFER-LENTZ RD.

TOWNSHIP: CLAY

SECTION: 11

T 6 NR 13 E.

PERSONNEL:
 M. WITTMAN, P.S.
 J. ALLEN


NORTHING:

EASTING:

DATE / WEATHER / TEMP:

JULY 5, 2016
 SUNNY
 76° F - HUMID

DATUM:

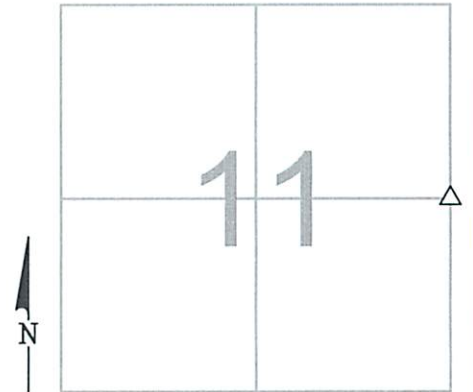

MONUMENT INFORMATION

MONUMENT TYPE: FD RED GRANITE STONE
 ON SURFACE - BELOW: 1.44'
 LEFT - CL PAV'T - RIGHT: 0.60'

4" X 4-1/2" RECTANGULAR STONE. USED CENTER
 OF STONE.



MISC. INFORMATION

FD RR SPIKE WITH PUNCH MARK ON SURFACE,
 TIED W/ X-TIES AND DUG FOR STONE. FD RR
 SPIKE WAS 0.02' EAST AND 0.02' SOUTH OF POINT
 USED ON STONE.

JULY 5, 2016

SET 1" SQUARE IRON PIN
 IN MONUMENT BOX OVER
 STONE

