


OTTAWA COUNTY ENGINEERS OFFICE

REFERENCE NO. 11-6-13-H
 SOUTH QUARTER POST SEC. 11
 CLAY TWP.
 SHEET 1 OF 1.

ROUTE: T-50 WITTY RD.
 TOWNSHIP: CLAY
 SECTION: 11
 T 6 NR 13 E.

PERSONNEL:
 M. WITTMAN, P.S.
 J. ALLEN
 B. BRADY
 M. HEINTZ

NORTHING:
 EASTING:
 DATUM:

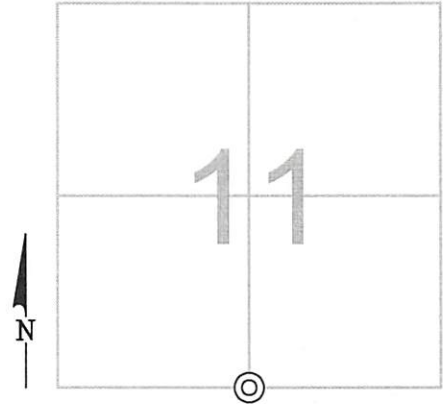

DATE / WEATHER / TEMP:
 APRIL 30, 2024
 SUNNY W
 70° F

MONUMENT INFORMATION

MONUMENT TYPE: FD. IRON PIN IN CLAY TILE
ON SURFACE - BELOW:
 LEFT - CL PAV'T - RIGHT: 0.35'

 FD. 1" SQ. IRON PIN IN CONCRETE IN CLAY TILE



MISC. INFORMATION

FD. 1" SQ. IRON PIN AT SURFACE THAT APPEARED TO BE HIT BY SNOWPLOWS. SHOT DRILL HOLE IN TOP OF PIN AND DUG TO DETERMINE LENGTH OF PIN. FOUND CLAY TILE FILLED WITH CONCRETE 0.35' DOWN. PIN DID NOT APPEAR TO BE BENT. CUT TOP 3" OF PIN OFF AND RESET DRILL HOLE. PLACED MONUMENT BOX OVER PIN IN CLAY TILE.

APRIL 30, 2024
 SET MONUMENT BOX OVER
 1" SQUARE IRON PIN IN
 CONCRETE IN CLAY TILE

