

OTTAWA COUNTY ENGINEERS OFFICE

REFERENCE NO. 12-6-13-G
 SW CORNER POST SEC. 12
 CLAY TWP.
 SHEET 1 OF 1.

PERSONNEL:
 M. WITTMAN, P.S.
 J. ALLEN

DATE / WEATHER / TEMP:
 JULY 1, 2016
 SUNNY - W-SW
 77° F

ROUTE: T-214 OPFER-LENTZ RD.
 @ T-50 WITTY RD.

TOWNSHIP: CLAY


SECTION: 12

T 6 NR 13 E.

NORTHING:

EASTING:

DATUM:

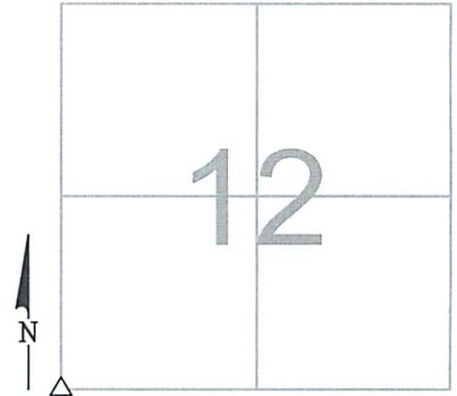

MONUMENT INFORMATION

MONUMENT TYPE: FD 8" x 11" HARDHEAD STONE
 ON SURFACE - BELOW: 1.36'
 LEFT - CL PAV'T - RIGHT: OPFER-LENTZ RD.
 LEFT - CL PAV'T - RIGHT: 2.00' (WITTY RD.)

IRREGULAR SHAPED STONE WITH DRILL HOLE.
 USED DRILL HOLE.



MISC. INFORMATION

FD RR SPIKE 0.24' BELOW SURFACE, TIED W/
 X-TIES AND DUG FOR STONE. RR SPIKE WAS 0.01'
 EAST AND 0.01' SOUTH OF DRILL HOLE.

JULY 1, 2016

SET 1" SQUARE IRON PIN
 IN MONUMENT BOX OVER
 STONE

