


OTTAWA COUNTY ENGINEERS OFFICE

REFERENCE NO. 12-6-13-H
 SOUTH QUARTER POST SEC. 12
 CLAY TWP.
 SHEET 1 OF 1.

ROUTE: T-50 WITTY RD.
 TOWNSHIP: CLAY
 SECTION: 12
 T 6 NR 13 E.

PERSONNEL:
 M. WITTMAN, P.S.
 J. ALLEN
 B. BRADY
 M. HEINTZ

NORTHING:
 EASTING:
 DATUM:

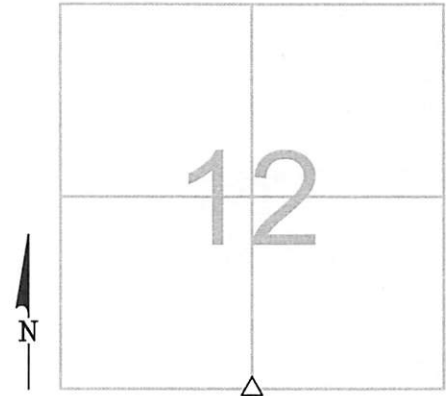

DATE / WEATHER / TEMP:
 APRIL 30, 2024
 SUNNY W-SW
 65° F

MONUMENT INFORMATION

MONUMENT TYPE: FD. POINTED SANDSTONE
 ON SURFACE - BELOW: 1.25'
LEFT - CL PAV'T - RIGHT: 0.90'

FD. 5-1/2" X 7" POINTED LIMESTONE
 USED POINT ON STONE



MISC. INFORMATION

FD. MAG SPIKE ON SURFACE, TIED W/ GPS AND
 DUG FOR STONE OF RECORD. USED HIGH POINT
 ON STONE WHICH MATCHED RECORD DISTANCE
 OF 56.15' TO A FD. IRON PIN TO THE EAST. SET 1"
 SQUARE IRON PIN IN MONUMENT BOX OVER HIGH
 POINT OF STONE. FD. MAG SPIKE WAS 0.13' EAST
 AND 0.03' NORTH OF POINT USED ON STONE.

APRIL 30, 2024

SET 1" SQUARE IRON PIN
 IN MONUMENT BOX OVER
 STONE

