

OTTAWA COUNTY ENGINEERS OFFICE

REFERENCE NO. 19-7-13-B
 NORTH QUARTER POST SEC. 19
 CLAY TWP.
 SHEET 1 OF 1.

ROUTE: STATE ROUTE #795

TOWNSHIP: CLAY

SECTION: 19


T 7 NR 13 E.

PERSONNEL:
 M. WITTMAN, P.S.
 J. ALLEN
 J. O'DONNELL, P.S. - ODOT
 D. TODD - ODOT

NORTHING:

EASTING:

DATUM:

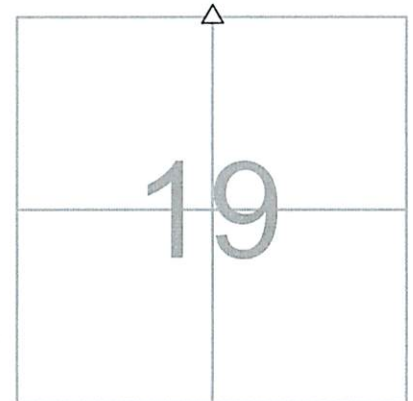

DATE / WEATHER / TEMP:
 NOVEMBER 22, 2016
 SUNNY
 35° F

MONUMENT INFORMATION

MONUMENT TYPE: 6" x 4" POINTED HARDHEAD
 ON SURFACE - BELOW: 2.05'
 LEFT - CL PAV'T - RIGHT: 1.50'

USED CENTER OF HIGH RIDGE ON STONE.



MISC. INFORMATION

FD MAG SPIKE ON SURFACE, TIED WITH GPS AND
 DUG FOR STONE. FD GOLF BALLS AND RR SPIKES
 ON WAY TO STONE. POINT USED ON STONE WAS
 0.08' SOUTH AND 0.02' WEST OF SURFACE MAG
 SPIKE. SET 1" SQUARE IRON PIN IN ROUND ODOT
 MONUMENT BOX OVER STONE.

NOVEMBER 22, 2016

SET 1" SQUARE IRON PIN IN
 ROUND ODOT MONUMENT BOX
 OVER STONE

