


OTTAWA COUNTY ENGINEERS OFFICE

REFERENCE NO. 19-7-13-D
 WEST QUARTER POST SEC. 19
 CLAY TWP.
 SHEET 1 OF 1.

ROUTE: C-2 FOSTORIA RD.
 TOWNSHIP: CLAY
 SECTION: 19
 T 7 NR 13 E.

PERSONNEL:
 M. WITTMAN, P.S.
 J. ALLEN
 B. BRADY
 M. HEINTZ
 A. STAIB - WOOD CO.

NORTHING:
 EASTING:
 DATUM:

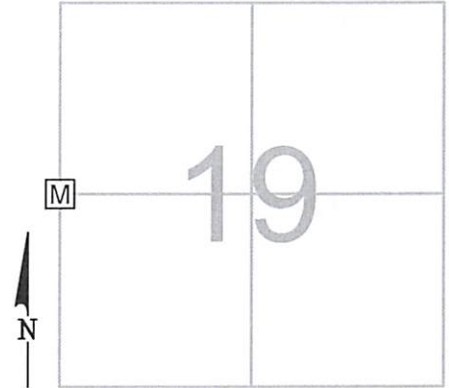

DATE / WEATHER / TEMP:
 MAY 8, 2024
 SUNNY W
 67° F

MONUMENT INFORMATION

MONUMENT TYPE: SET IRON PIN
 ON SURFACE - BELOW:
 LEFT - CL PAV'T - RIGHT: 2.00'

 SET 5/8" Ø IRON PIN IN MONUMENT BOX



MISC. INFORMATION

STONE PER 1939 W.P.A BOOKS. ALL TIES WERE GONE.
 CALCULATED POINT PER I.L. STINEBAUGH SURVEY DATED
 6-23-1896 AND SINGLE PROPORTIONATE MEASUREMENT. DUG 3'
 N/S X 4' E/W HOLE 16" DOWN TO CLAY, PRODDED ANOTHER 2'
 DOWN ON A 5" GRID, NO STONE FOUND. SET 5/8" Ø IRON PIN IN
 MONUMENT BOX A CALCULATED POINT. PIN IN 1.58' EAST OF
 COUNTY LINE.

THIS IS A CLOSING CORNER

MAY 8, 2024

SET 5/8" Ø IRON PIN IN
 MONUMENT BOX OVER
 STONE

