

OTTAWA COUNTY ENGINEERS OFFICE

REFERENCE NO. 19-7-13-F
EAST QUARTER POST SEC. 19
CLAY TWP.
SHEET 1 OF 1.

ROUTE: T-54 BILLMAN RD.

TOWNSHIP: CLAY

SECTION: 19

T 7 NR 13 E.

PERSONNEL:

J. ALLEN
M. ULLRICH
S. ULLRICH


NORTHING:

EASTING:

DATUM:


DATE / WEATHER / TEMP:

AUGUST 29, 2008
CLOUDY
77° F

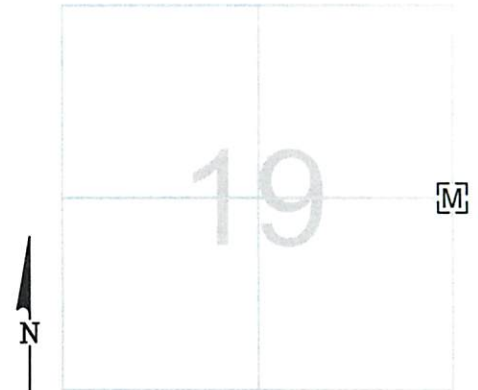

MONUMENT INFORMATION

MONUMENT TYPE: FD. 1" Ø IRON PIN W/ DRILL
HOLE IN MONUMENT BOX
ON SURFACE - BELOW: 0.56'
LEFT - CL PAV'T - RIGHT: 0.50'

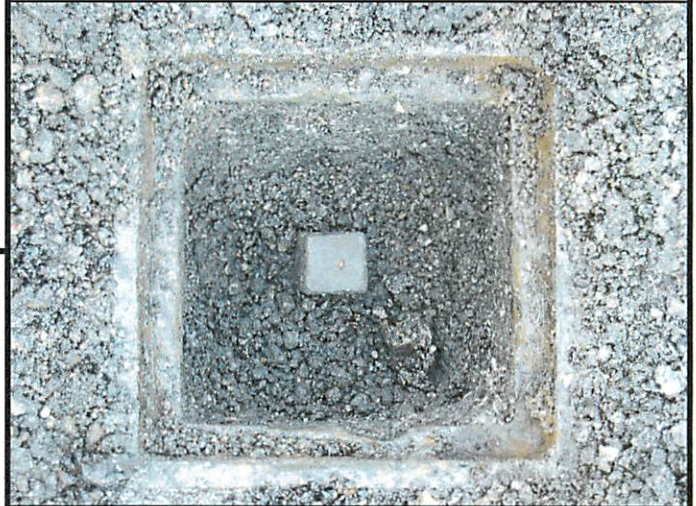

MISC. INFORMATION

SET 5/8" IRON PIN
W/ "OCE"
REFERENCE CAP

SET 5/8" IRON PIN
W/ "OCE"
REFERENCE CAP

