

OTTAWA COUNTY ENGINEERS OFFICE

REFERENCE NO. 19-7-13-G
 SOUTHWEST CORNER SEC. 19
 CLAY TWP.
SHEET 1 OF 1.

ROUTE: C-2 FOSTORIA RD.
 @ T-65 HELLWIG RD.

TOWNSHIP: CLAY

SECTION: 19

T 7 **NR** 13 **E.**


PERSONNEL:

M. WITTMAN, P.S.
 J. ALLEN
 B. BRADY
 T. FOCHT
 A. STAIB - WOOD CO.

NORTHING:

EASTING:

DATUM:

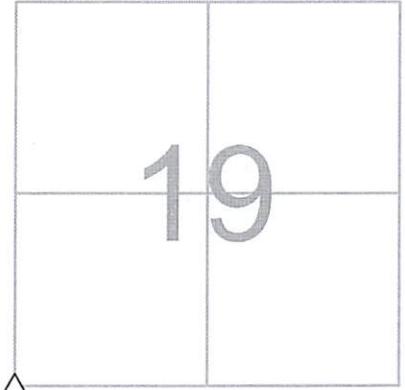

DATE / WEATHER / TEMP:

MAY 7, 2024
 SUNNY NE
 63° F

MONUMENT INFORMATION

MONUMENT TYPE: FD DOMED GRANITE STONE
 ON SURFACE - BELOW: 1.50'
LEFT - CL PAV'T - RIGHT: 5.9' (FOSTORIA RD.)
LEFT - CL PAV'T - RIGHT: X.XX' (HELLWIG RD.)

11" X 10" DOMED GRANITE STONE. USED HIGH
 POINT ON DOME OF STONE.



MISC. INFORMATION

FD HARROW TOOTH 0.47' BELOW SURFACE, TIED W/
 GPS AND DUG FOR STONE. HARROW TOOTH WAS
 0.30' WEST AND 0.05' NORTH OF POINT USED ON
 STONE. SET IRON PIN IN MONUMENT BPX OVER
 POINT USED. IRON PIN IS 0.27' WEST OF COUNTY
 LINE.

THIS IS A CLOSING CORNER.

MAY 7, 2024

SET 1" SQUARE IRON PIN
 IN MONUMENT BOX OVER
 STONE

