

# OTTAWA COUNTY ENGINEERS OFFICE

**REFERENCE NO.** 2-6-13-C  
 NE CORNER POST SEC. 2  
 CLAY TWP.  
**SHEET** 1 OF 1.

**ROUTE:** STATE ROUTE #163  
 @ T-214 OFFER-LENTZ RD.

**TOWNSHIP:** CLAY


**SECTION:** 2

**T** 6 **NR** 13 **E.**

**NORTHING:**

**EASTING:**

**DATUM:**

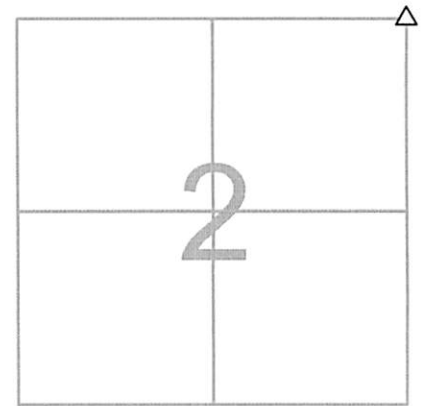

**PERSONNEL:**

M. WITTMAN, P.S.  
 M. BROUGH, C. MILLER  
 R. NUHFER, P.S. - ODOT  
 D. HOHMAN, P.S. - ODOT  
 T. ROUSOS - ODOT

**DATE / WEATHER / TEMP:**

MAY 1, 2013  
 SUNNY - SE  
 70° F

MONUMENT INFORMATION

MONUMENT TYPE: FD 7" X 7" BROKEN LIMESTONE  
 ON SURFACE - BELOW: 1.40'  
LEFT - CL PAV'T - RIGHT: 1.10' (SR 163) 5.5' L (CL T-213)

USED FAINT "X" IN HIGH POINT OF STONE, SET  
 DRILL HOLE IN CENTER OF "X"



MISC. INFORMATION

FD PK AND SHINER ON SURFACE, TIED W/ X-TIES AND DUG  
 FOR STONE. FD PK AND WAHSER 0.25' BELOW SURFACE.  
 FD PK NAIL 0.39' BELOW SURFACE, 0.03' SOUTH AND 0.01' E  
 OF SURFACE NAIL. SURFACE NAIL WAS 0.65' SOUTH AND  
 0.55' WEST OF "X" IN STONE.

8-28-13: SET 1" Ø X 12" LONG IRON PIN IN FLOODED SAND  
 IN 6" Ø PVC IN MONUMENT BOX WITH ODOT AND SHELLY  
 CO. ASSISTANCE.

AUGUST 28, 2013

SET 1" Ø IRON PIN IN  
 MONUMENT BOX  
 OVER STONE

