

OTTAWA COUNTY ENGINEERS OFFICE

REFERENCE NO. 2-6-13-D
WEST QUARTER POST SEC. 2
CLAY TWP.
SHEET 1 OF 1.

ROUTE: T-7 MARTIN-WILLISTON RD.
@ T-56 FULKERT RD.

TOWNSHIP: CLAY

SECTION: 2

T 6 NR 13 E.


NORTHING:

EASTING:

DATUM:

PERSONNEL:
M. WITTMAN, P.S.
J. ALLEN

DATE / WEATHER / TEMP:
NOVEMBER 29, 2012
SUNNY - SW
38° F

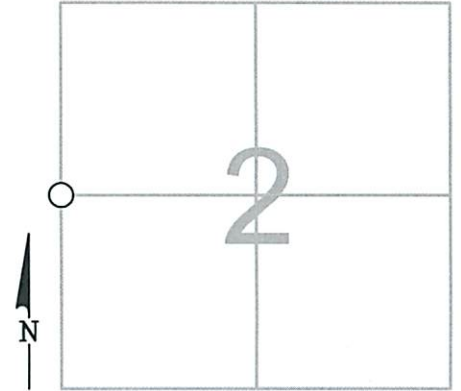

MONUMENT INFORMATION

MONUMENT TYPE: FD. 7/8" HEX DRILL BIT
ON SURFACE - BELOW: 0.73'
LEFT - CL PAV'T - RIGHT: 0.60'

DRILL BIT PER COUNTY RECORDS



MISC. INFORMATION

FD. PK NAIL 0.05' BELOW SURFACE, TIED W/ X-TIES
AND DUG. FD. 7/8" HEX DRILL BIT W/ HOLE 0.73'
BELOW SURFACE. HEX BIT WAS 0.09' E AND 0.03' N
OF PK NAIL. TIED DRILL BIT W/ X-TIES AND DUG FOR
STONE PER 1939 WPA BOOK. DUG TO CLAY AND
PRODDED AROUND DRILL BIT ANOTHER 3' DOWN
AND FOUND NOTHING, DRILL BIT WAS STILL SOLID.

